


THIS LOT GRADING PLAN HAS BEEN REVIEWED BY METROPOLITAN CONSULTING INC. FOR CONFORMANCE WITH THE APPROVED SUBDIVISION GRADING DESIGN. THE PROPOSED GRADES ON THIS PLAN ARE IN GENERAL CONFORMITY WITH THE APPROVED GRADING PLAN AS IT RELATES TO THIS LOT AND ADJACENT LOTS. WHERE THE BASEMENT FLOOR OR OTHER FOUNDATION ELEVATIONS ARE PROPOSED AT A DIFFERENT ELEVATION THAN THAT SHOWN ON THE APPROVED SUBDIVISION PLANS THE SEWER LATERALS HAVE BEEN REVIEWED AND WE ARE SATISFIED THAT THE MINIMUM GRADES FOR THESE LATERALS CAN BE MAINTAINED IN ACCORDANCE WITH THE REQUIREMENTS OF THE O.B.C. AND CITY DESIGN CRITERIA. NOTE: THIS CERTIFICATION DOES NOT REPLACE THE BUILDER'S RESPONSIBILITY TO EXPOSE THE SEWER LATERALS AND CONFIRM ELEVATIONS PRIOR TO EXCAVATING FOR THE FOUNDATION. BY USE OF THIS PLAN THE BUILDER AGREES THAT THEY SHALL BE RESPONSIBLE FOR IMMEDIATELY REPORTING TO METROPOLITAN CONSULTING ANY DISCREPANCY OR VARIATION BETWEEN THE LATERAL INFORMATION AND GRADES DEPICTED ON THIS PLAN AND THE CONDITIONS FOUND IN THE FIELD.

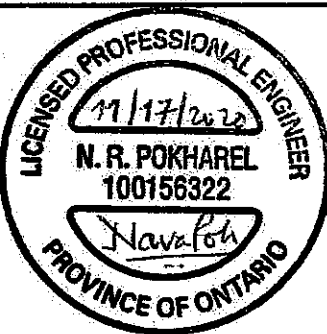

It is the builder's complete responsibility to ensure that all plans submitted for approval fully comply with the Architectural Guidelines and all applicable regulations and requirements including zoning provisions and any provisions in the subdivision agreement. The Control Architect is not responsible in any way for examining or approving the (lotting) plans or working drawings with respect to any zoning or building code or permit matter or that any house can be properly built or located on its lot.

This is to certify that these plans comply with the applicable Architectural Design Guidelines approved by the City of Hamilton.

JOHN G. WILLIAMS LTD., ARCHITECT
ARCHITECTURAL CONTROL REVIEW
AND APPROVAL

APPROVED BY:
DATE: DEC 07, 2020

This stamp certifies compliance with the applicable Design Guidelines only and bears no further professional responsibility.

CITY OF HAMILTON
Building Division

Permit No. 21-
21-103832

THESE STAMPED DRAWINGS SHALL BE AVAILABLE ON SITE

THE OWNER AND/OR CONTRACTOR SHALL COMPLY WITH
THE ONTARIO BUILDING CODE AND ALL OTHER APPLICABLE LAW

These drawings and/or specifications have been reviewed by

FOR CHIEF BUILDING OFFICIAL DATE: MAR 18/21


CITY OF HAMILTON
BUILDING DIVISION
Planning & Development Department

JAN 28 2021

REC'D BY: _____ DATE: _____
REF'D TO: _____ DATE: _____

MASONRY VENEER REQUIRED
ON SIDES OF STAIRS

GRANITE RIDGE TRAIL

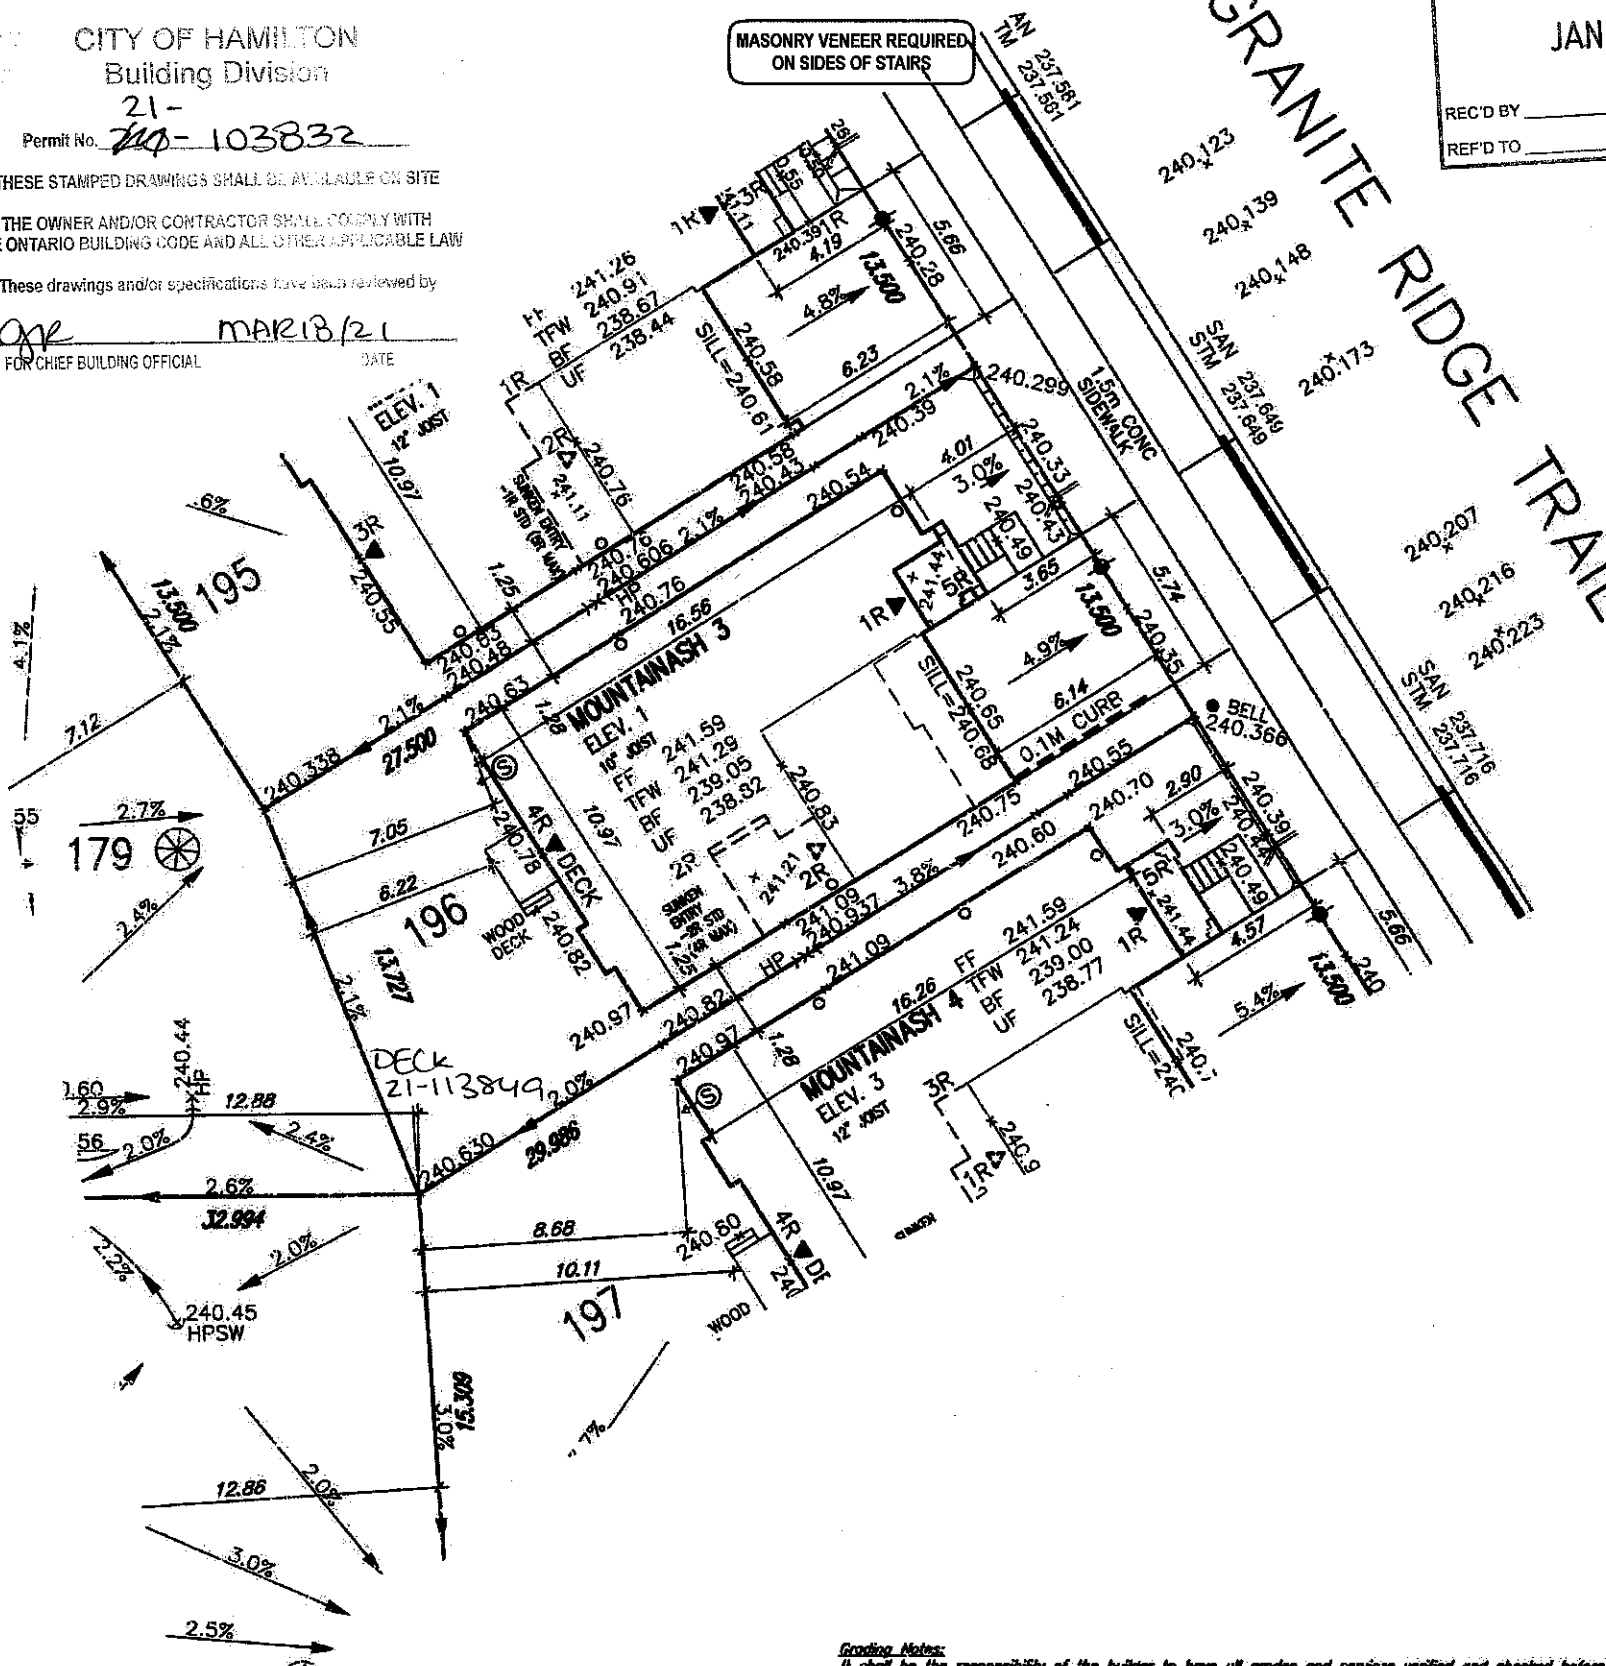

LOT 196		
LOT No.	LOT WIDTH (M) (@ 8.0m)	LOT AREA (M ²)
196	13.50	388.03

Grading Notes:

It shall be the responsibility of the builder to have all grades and services verified and checked before construction by an approved grading engineer. These grades and the placement of storm and sanitary services off the street are to meet the requirements of this municipality having jurisdiction.

VA3 Design Inc. is to be notified promptly of any discrepancies at least 1 (one) week prior to excavation commences in order that the building can be re-sited. Failure to observe these conditions may require expensive remedial action that will not be the responsibility of or cost to VA3 Design Inc. Foundation wall shall be poured to a minimum of 6" above approved grades.

Finished grade lines as indicated on the house prototype are for reference only and do not necessarily depict finish grading conditions of any particular lot.

These drawings are to be read in conjunction with municipal approved site engineering drawings prepared by Metrolan Consulting Inc.

NOTE: SUMP PUMP REQUIRED. SUMP PUMPS CONNECTED TO STORM SEWER ARE REQUIRED AS PER THE APPROVED SITE ENGINEERING DRAWINGS. REFER TO DRAWINGS PREPARED BY METROPOLITAN CONSULTING INC. SHEET W14017-N1.

NOTE: REFER TO LANDSCAPE DRAWINGS FOR ALL FENCING TYPES, HEIGHTS AND LOCATIONS. CONTRACTOR TO VERIFY PRIOR TO INSTALLATION.

PROPOSED VALVE	NO. OF RISERS
LIGHT POLE	FINISHED FLOOR ELEVATION
WATER SERVICE	FINISHED MAIN LEVEL ELEVATION
DOUBLE STN/SAN. CONNECTION	UNDERSIDE FOOTING ELEVATION
SINGLE STN/SAN. CONNECTION	FIN. BASEMENT FLOOR SLUG
CATCH BASIN	TOP OF FOUNDATION WALL
CABLE TELEVISION PEDestal	UNDERSIDE FOOTING AT REAR
BELL PEDestal	UNDERSIDE FOOTING AT FRONT
	UNDERSIDE FOOTING AT SIDE
	WALK OUT DECK
	W.O.B. WALK OUT BASEMENT
	REVERSE PLAN

STREET SIGN	PROVIDE 3/4" DIA. CLEAR STONE IN THIS AREA
MAIL BOX	THIS LOT CONTAINS ENGINEERED FILL
RETAINING WALL	AIR CONDITIONER REQUIRED
CHAIN LINK FENCE (SEE LANDSCAPE PLAN)	RAIN WATER DOWNSPOUT LOCATION (DISCHARGE OVER SPLASHPAD)
ACACIAL FENCE (SEE LANDSCAPE PLAN)	SIDE WINDOW LOCATION
WOOD SCREEN FENCE (SEE LANDSCAPE PLAN)	OPT. DOOR LOCATION
HYDRO SERVICE LATERAL	EXTERIOR DOOR LOCATION
HYDRO METER	REDUCE SIDE YARD
GAS METER	
EMBANKMENT (3:1 SLOPE unless otherwise noted)	



no.	description	date	by
9			
8			
7			
6			
5			
4			
3			
2			
1	ISSUED FOR PERMIT.	NOV 06/20	GW

qualification information	signature	24483
Richard Vink		ECN
registration information	signature	42858
VA3 Design Inc.		ECN

VA3 DESIGN
255 Consumers Rd Suite 120
Toronto ON M2J 1R4
416.630.2255 / 416.630.4782
va3design.com

Greenpark.
project name: RUSSELL GARDENS PHASE 3
city: HAMILTON
date: SEPT. 2020
drawn by: GW
checked by: _____
scale: 1:250
LOT SITING/GRADING
19014-RG3-SITE-LAYOUTS

lot/block no.	196
registered plan no.	62M-1266
project no.	19014
drawing no.	1