

Purchasers: DMITRI, M KAZANTSEV & VIKTORIJA KAZANTSEVA Property: 153

Telephone Res. / Bus: /

Project: Russell Gardens Building Ltd.

Decor Advisor: Candace Forza

Model and Elevation: Mountainash Two (4 Bedroom) Elev 3

Lock Date: 20-Apr-21

5-Mar-21

Plan #: 62M-1266

Layout Changes: ☒ Yes ☐ NoSketch Attached: ☒ Yes ☐ No

Exterior Colour Scheme:

1. Cabinetry

Style and Colour

Cabinetry Revision

Kitchen / Breakfast *	PERIMETER - SONATA SATIN SNOW *** ISLAND - SONATA FOSSIL	VK	DK	446SA
Laundry Room	ELISSE			Standard
Powder Room	MONACO 350 PLATINUM SILVER			431SA
Master Ensuite Bathroom	MONACO 350 PLATINUM SILVER			431SA
Ensuite Bath - Bedroom 2/3	EVEREST WHITE			447SA
Ensuite Bath - Bedroom 4	EVEREST WHITE			447SA
	N/A			N/A
	N/A			N/A
	N/A			N/A

Appliances:

Built In Appliances ☒ Yes ☐ NoSlide In Stove ☐ Yes ☒ No

Dishwasher Cabinet

☐ Closed ☒ Open41" Upper Cabinets ☒ Yes ☐ No

Please NOTE: Standard Cabinet Height is 30"

Stove Opening

NOTE: If not specified, opening will be set to builder's standard opening of approximately 30" width

Fridge Opening

NOTE: If not specified, opening will be set to builder's standard opening of approximately 37" width x 74" height

** Refer to Construction Summary

2. Counters

	Counter	Edge
Kitchen / Breakfast	LAMINATE-CARRARA BIANCO 6696-46	
Laundry Room	N/A	
Powder Room	LAMINATE-PALOMA POLAR 6698-46	
Master Ensuite Bathroom	LAMINATE-PALOMA POLAR 6698-46	
Ensuite Bath - Bedroom 2/3	LAMINATE-CARRARA BIANCO 6696-46	
Ensuite Bath - Bedroom 4	LAMINATE-CARRARA BIANCO 6696-46	
	N/A	
	N/A	
	N/A	


** Refer to Construction Summary

Initials:

VK

DK

RUSSELL GARDENS
LOT 153

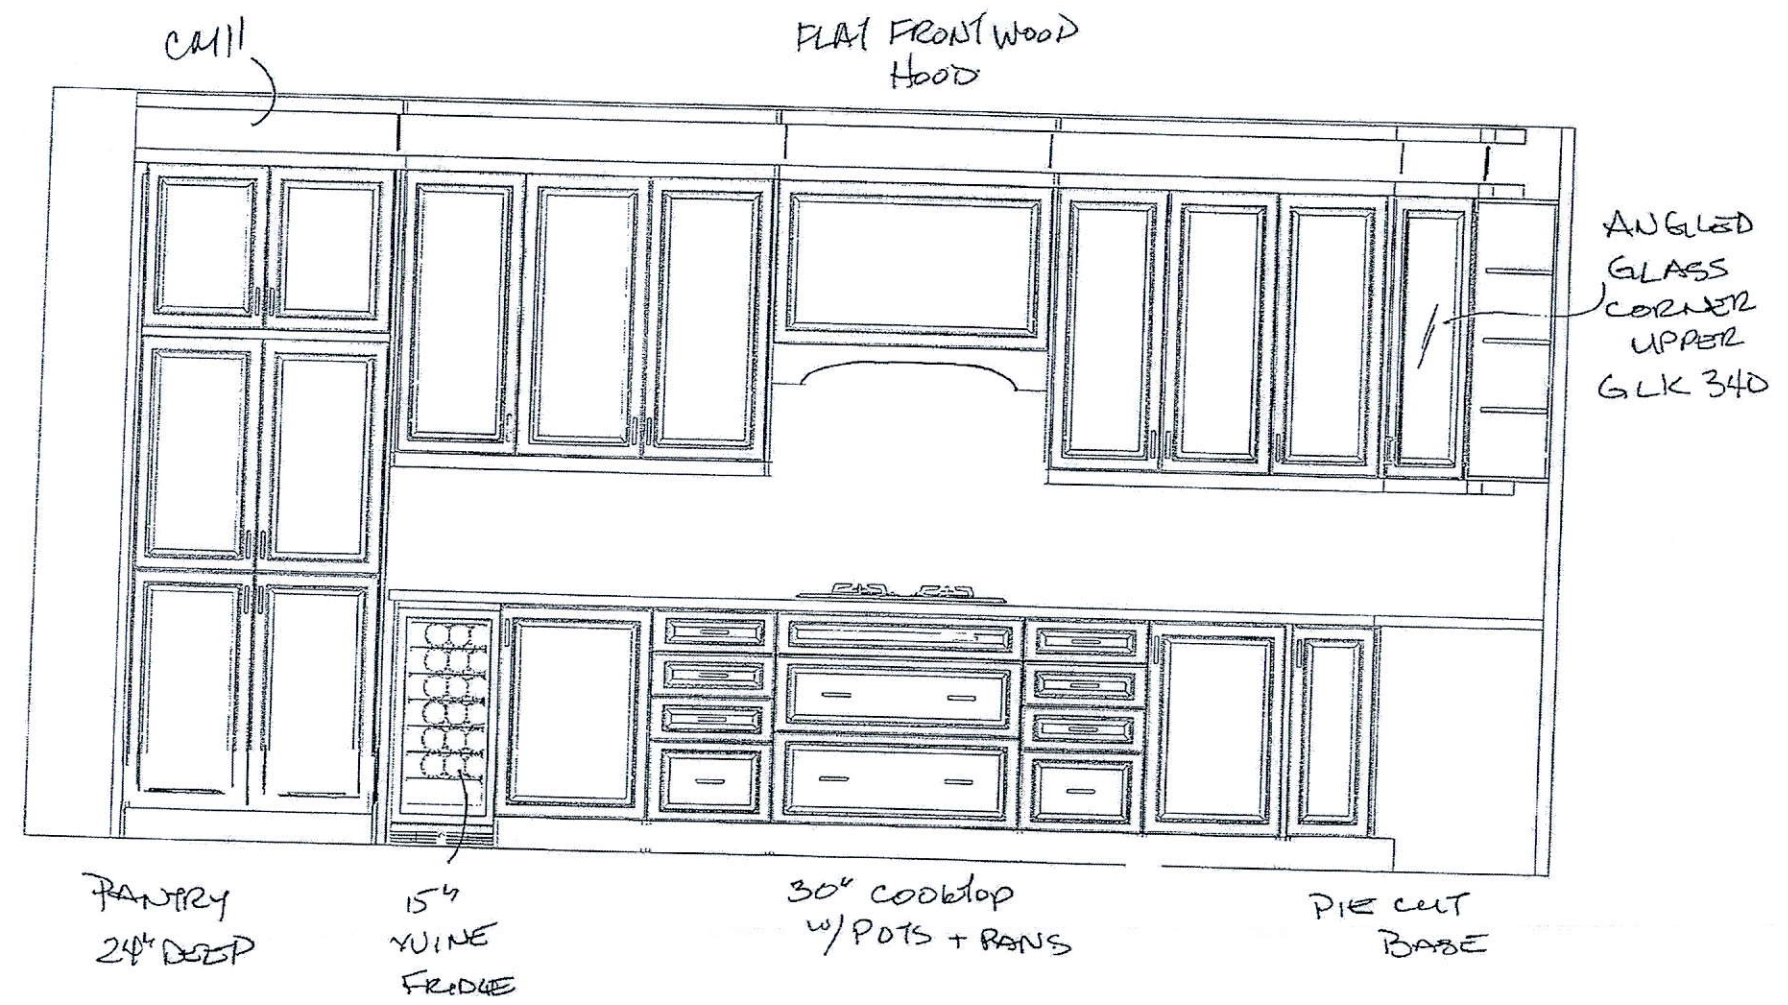


DK

VK

RUSSELL GARDENS

LOT 153

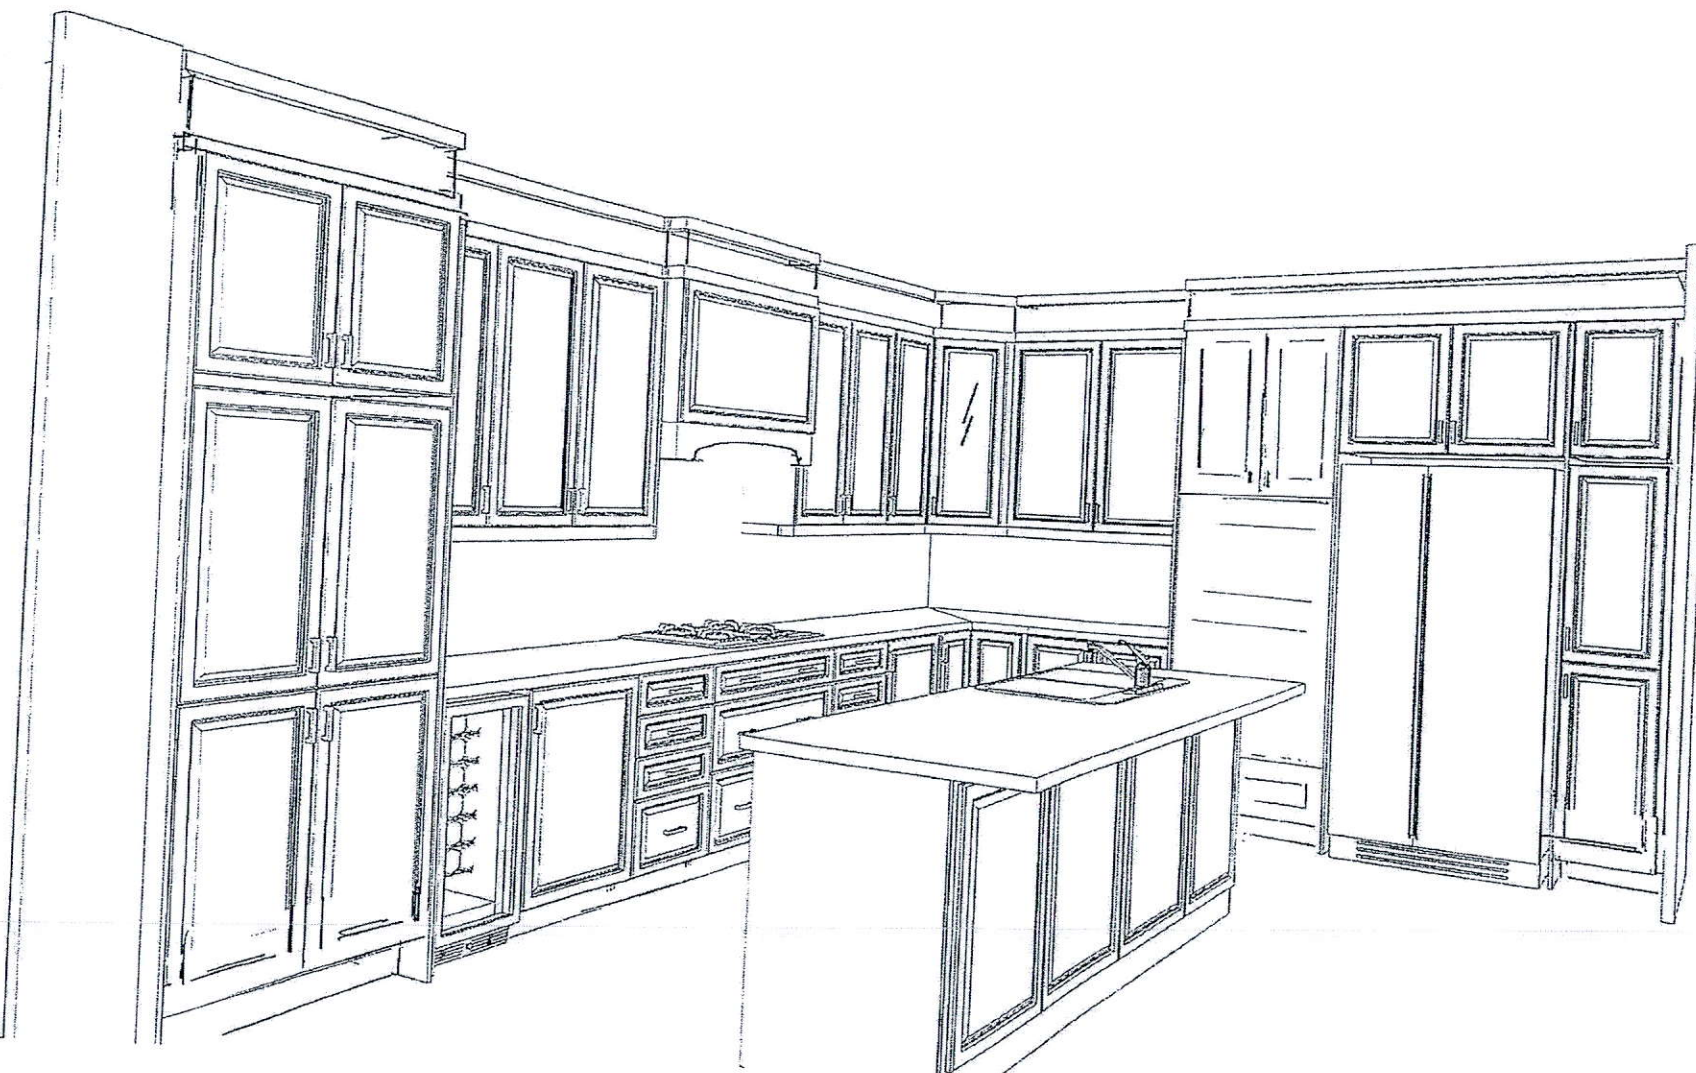

DK

VK

RUSSELL GARDENS
LOT 153



DK

VK

RUSSELL GARDENS

LOT 153

GLASS
DOOR
GLK 340

CHILL

GLASS
ANGLED
CORNER
UPPER



PIE CUT
BASE


MICRO/OVEN
COMBO
FLUSH INSTALL

PANTRY
24" DEEP

DK

DK

RUSSELL GARDENS
LOT 153

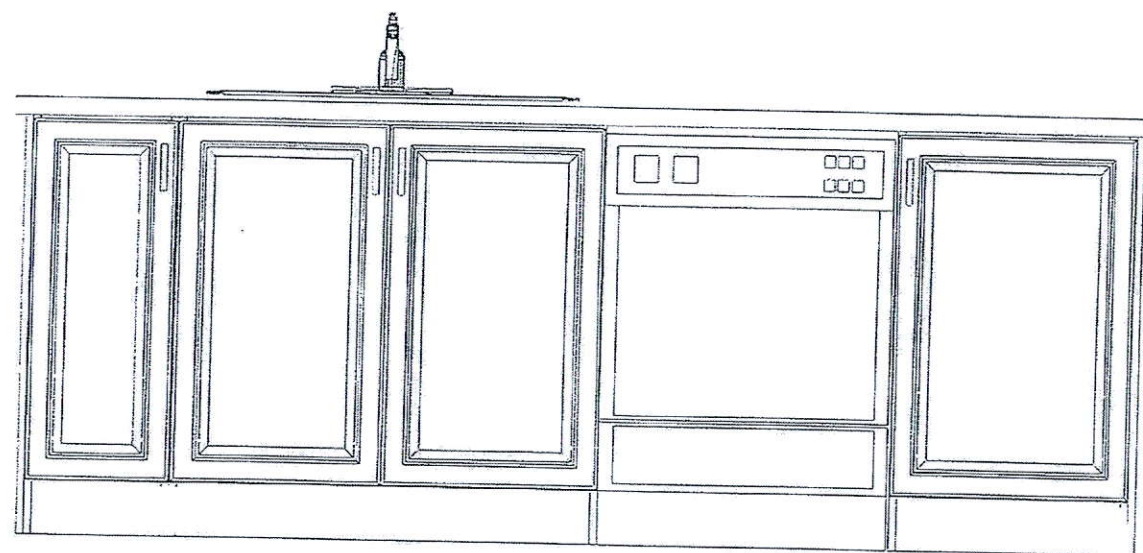

ISLAND - FACING STOVE

DK

VK