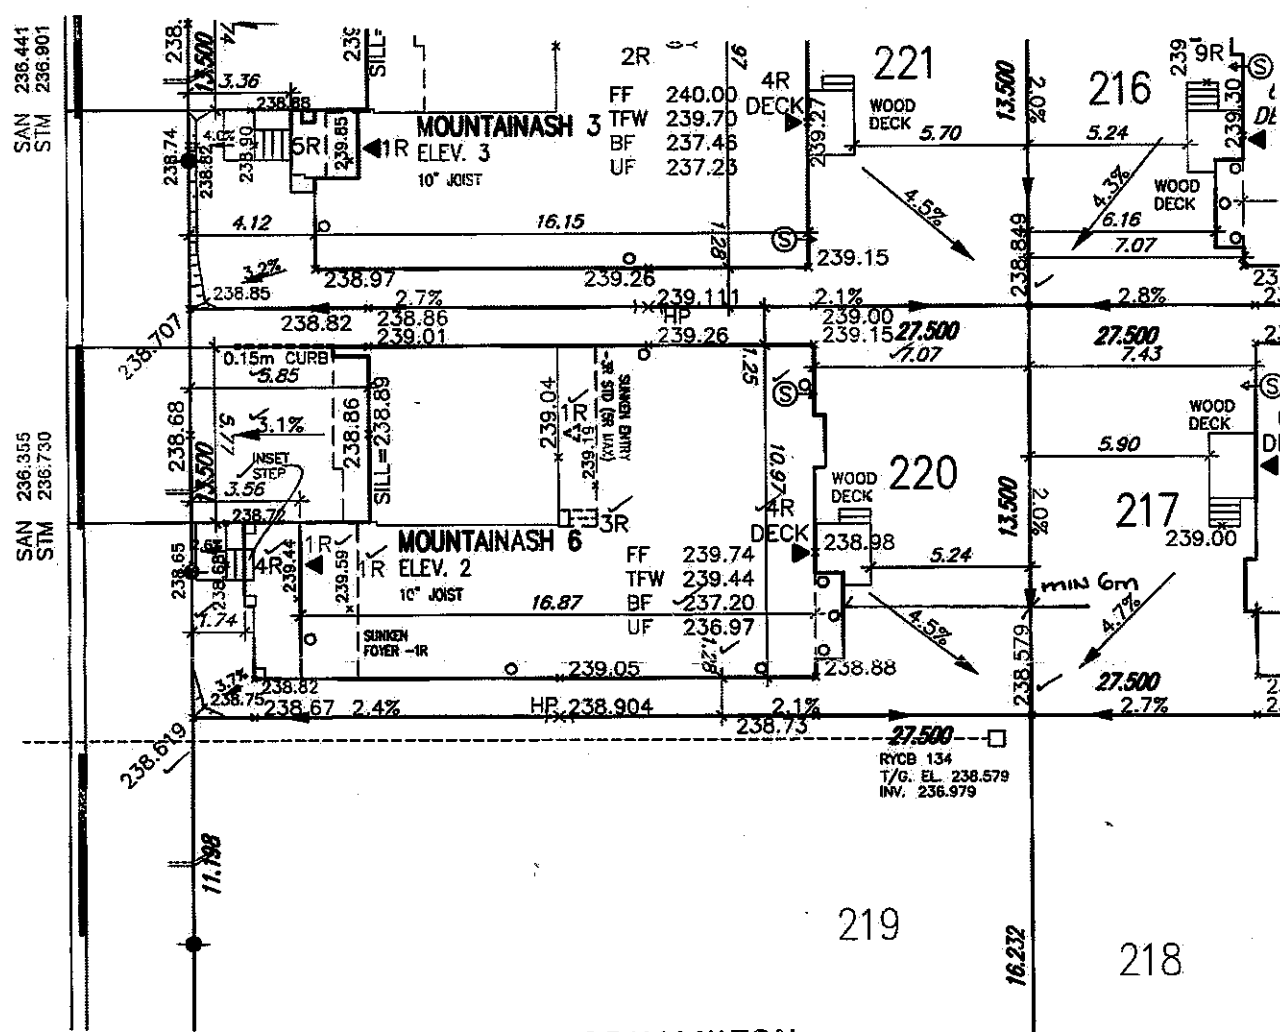
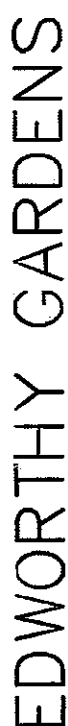


This is to certify that these plans comply with the applicable Architectural Design Guidelines approved by the City of HAMILTON.

IAN 26 2021

REC'D BY _____ DATE _____
REF'D TO _____ DATE _____

Permit No. 21-103443

These drawings and/or specifications have been reviewed by
 4/29/21
 FOR CHIEF BUILDING OFFICIAL DATE

These drawings are to be read in conjunction with municipal approved site engineering drawings prepared by Metropolitan Consulting Inc.

LOT 220		
LOT No.	LOT WIDTH (M) (@ 6.0m)	LOT AREA (M ²)
220	✓ 13.50	✓ 371.25

lot/block no. 220 registered plan no. 62M-1266	
project no. 19014	
SITING/GRADING file name 4-RGS-SITE-LAYOUTS - Nov 6 2020 - 4:34 PM	drawing no. 1

All design specifications, related documents and devices are the copyright property of V3 DESIGN. Reproduction of this property in whole or in part is strictly prohibited without V3 DESIGN's written permission.