

STRIP FOOTINGS FOR SINGLES AND SEMIS UP TO 2 STOREY

120 KPa NATIVE SOIL

20"x6" CONCRETE STRIP FOOTINGS BELOW FOUNDATION WALLS.
24"x8" CONCRETE STRIP FOOTINGS BELOW PARTY WALLS.

90 KPa ENGINEERED FILL SOIL

24"x8" CONCRETE STRIP FOOTINGS WITH REINFORCING BELOW FOUNDATION WALLS.
30"x8" CONCRETE STRIP FOOTINGS WITH REINFORCING BELOW PARTY WALLS.

100 KPa NATIVE SOIL

22"x8" CONCRETE STRIP FOOTINGS BELOW FOUNDATION WALLS.
28"x10" CONCRETE STRIP FOOTINGS BELOW PARTY WALLS
OR
28"x8" CONCRETE STRIP FOOTINGS WITH REINFORCING BELOW PARTY WALLS

GENERAL NOTE:

ASSUMED 120/100 KPa NATIVE SOIL BEARING CAPACITY OR 90 KPa
FOR ENGINEERED FILL. TO BE VERIFIED ON SITE. REFER TO ENGINEERED FILL
FOOTING DETAIL FOR REINFORCEMENT.

(REFER TO ENG. FILL FOOTING DETAIL)

PAD FOOTING

120 KPa NATIVE SOIL

F1 = 42"x42"x18" CONCRETE PAD
F2 = 36"x36"x16" CONCRETE PAD
F3 = 30"x30"x12" CONCRETE PAD
F4 = 24"x24"x12" CONCRETE PAD
F5 = 16"x16"x8" CONCRETE PAD

90 KPa ENGINEERED FILL SOIL

F1 = 48"x48"x20" CONCRETE PAD
F2 = 40"x40"x16" CONCRETE PAD
F3 = 34"x34"x14" CONCRETE PAD
F4 = 28"x28"x12" CONCRETE PAD
F5 = 18"x18"x8" CONCRETE PAD

100 KPa NATIVE SOIL

F1 = 40"x46"x20" CONCRETE PAD
F2 = 38"x38"x16" CONCRETE PAD
F3 = 32"x32"x14" CONCRETE PAD
F4 = 26"x26"x12" CONCRETE PAD
F5 = 17"x17"x8" CONCRETE PAD

(REFER TO FLOOR PLAN FOR UNUSUAL SIZE PADS NOT ON CHART)

NOTE:

WHEN VENEER CUT IS GREATER THAN 26" A 10" POURED CONC. FOUNDATION WALL IS REQUIRED.

NOTE:

ALL GARAGE SLABS, PORCH SLABS, STAIRS (EXPOSED CONC. FLAT WORK) TO BE 32 MPa
WITH 5-8% AIR ENTRAINMENT.

BRICK VENEER LINTELS:

WL1 = 3' 1/2" x 3' 1/2" x 1/4" (90x90x6) + 2'-2" x 8" SPR.
WL2 = 4' x 3' 1/2" x 5/16" (100x90x8) + 2'-2" x 8" SPR.
WL3 = 5' x 3' 1/2" x 5/16" (125x90x8) + 2'-2" x 10" SPR.
WL4 = 6' x 3' 1/2" x 3/8" (150x90x10) + 2'-2" x 12" SPR.
WL5 = 6' x 4' x 3/8" (150x100x10) + 2'-2" x 12" SPR.

WL6 = 5' x 3' 1/2" x 5/16" (125x90x8) + 2'-2" x 12" SPR.
WL7 = 5' x 3' 1/2" x 5/16" (125x90x8) + 3'-2" x 10" SPR.
WL8 = 5' x 3' 1/2" x 5/16" (125x90x8) + 3'-2" x 12" SPR.
WL9 = 6' x 4' x 3/8" (150x100x10) + 3'-2" x 12" SPR.

WOOD LINTELS:

WB1 = 2'-2" x 8" SPRUCE BEAM
WB2 = 3'-2" x 8" SPRUCE BEAM
WB3 = 2'-2" x 10" SPRUCE BEAM
WB4 = 3'-2" x 10" SPRUCE BEAM
WB5 = 2'-2" x 12" SPRUCE BEAM
WB6 = 3'-2" x 12" SPRUCE BEAM
WB7 = 5'-2" x 12" SPRUCE BEAM
WB10 = 4'-2" x 8" SPRUCE BEAM
WB11 = 4'-2" x 10" SPRUCE BEAM

STEEL LINTELS:

L1 = 3' 1/2" x 3' 1/2" x 1/4" (90 x 90 x 6)
L2 = 4' x 3' 1/2" x 5/16" (100 x 90 x 8)
L3 = 5' x 3' 1/2" x 5/16" (125 x 90 x 8)
L4 = 6' x 3' 1/2" x 3/8" (150 x 90 x 10)
L5 = 6' x 4' x 3/8" (150 x 100 x 10)
L6 = 7' x 4' x 3/8" (180 x 100 x 10)


LAMINATED VENEER LUMBER (LVL BEAMS)

LVL1A = 1-1 3/4" x 7 1/4" (1-45x184)
LVL1 = 2-1 3/4" x 7 1/4" (2-45x184)
LVL2 = 3-1 3/4" x 7 1/4" (3-45x184)
LVL3 = 4-1 3/4" x 7 1/4" (4-45x184)
LVL4A = 1-1 3/4" x 9 1/2" (1-45x240)
LVL4 = 2-1 3/4" x 9 1/2" (2-45x240)
LVL5 = 3-1 3/4" x 9 1/2" (3-45x240)
LVL5A = 4-1 3/4" x 9 1/2" (4-45x240)
LVL6A = 1-1 3/4" x 11 7/8" (1-45x300)
LVL6 = 2-1 3/4" x 11 7/8" (2-45x300)
LVL7 = 3-1 3/4" x 11 7/8" (3-45x300)
LVL7A = 4-1 3/4" x 11 7/8" (4-45x300)
LVL8 = 2-1 3/4" x 14" (2-45x356)
LVL9 = 3-1 3/4" x 14" (3-45x356)

Door Schedule

| NO. | WIDTH | HEIGHT 8' TO 9' CEILINGS | HEIGHT 10' OR MORE CEILINGS | TYPE |
|-----|--------|--------------------------------|-----------------------------------|-------------------------|
| 1 | 2'-10" | 6'-8" (865x2033) | 8'-0" (865x2439) | INSULATED ENTRANCE DOOR |
| 1a | 2'-8" | 6'-8" (815x2033) | 8'-0" (815x2439) | INSULATED FRONT DOORS |
| 2 | 2'-8" | 6'-8" (815x2033) | 8'-0" (815x2439) | WOOD & GLASS DOOR |
| 3 | 2'-8" | 6'-8" x 1-3/4" (815x2033x45) | 8'-0" x 1-3/4" (815x2439x45) | EXTERIOR SLAB DOOR |
| 4 | 2'-8" | 6'-8" x 1-3/8" (815x2033x35) | 8'-0" x 1-3/8" (815x2439x35) | INTERIOR SLAB DOOR |
| 5 | 2'-6" | 6'-8" x 1-3/8" (760x2033x35) | 8'-0" x 1-3/8" (760x2439x35) | INTERIOR SLAB DOOR |
| 6 | 2'-2" | 6'-8" x 1-3/8" (660x2033x35) | 8'-0" x 1-3/8" (660x2439x35) | INTERIOR SLAB DOOR |
| 7 | 1'-6" | 6'-8" x 1-3/8" (460x2033x35) | 8'-0" x 1-3/8" (460x2439x35) | INTERIOR SLAB DOOR |
| 8 | 3'-0" | 6'-8" x 1-3/8" (915x2033x35) | 8'-0" x 1-3/8" (915x2439x35) | INTERIOR SLAB DOOR |


2-2"x6" STUD WALL NAILED TOGETHER AND SPACED @12" O.C.
FULL HT C/W SOLID BLOCKING 4'-0" O.C. VERTICAL AND 7/16"
EXT. PLYWOOD SHEATHING.

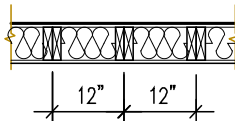

MAXIMUM HEIGHT OF WALL FOR THIS DETAIL IS 18'-0" AND
MAXIMUM SUPPORTED LENGTH OF TRUSS IS 40'-0"

TWO STOREY HEIGHT WALL DETAIL

2 - 1 1/2" x 5 1/2" TIMBERSTRAND (LSL) 1.5E STUD WALL GLUED
AND NAILED TOGETHER AND SPACED MAX. @10" O.C. FULL HT
C/W SOLID BLOCKING MAX. 8'-0" O.C. VERTICAL AND 7/16" EXT.
OSB SHEATHING.

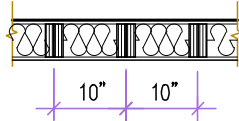

MAXIMUM HEIGHT OF WALL FOR THIS DETAIL IS 20'-2" AND
MAXIMUM SUPPORTED LENGTH OF TRUSS IS 40'-0"

TWO STOREY HEIGHT WALL DETAIL

AREA CALCULATIONS EL-1A

| | | |
|------------------------|---|--------------|
| FIRST FLOOR AREA | = | 847 Sq. Ft. |
| SECOND FLOOR AREA | = | 1043 Sq. Ft. |
| TOTAL FLOOR AREA | = | 1890 Sq. Ft. |
| ADD OPEN AREAS | = | 0 Sq. Ft. |
| ADD FIN. BASEMENT AREA | = | 0 Sq. Ft. |
| GROSS FLOOR AREA | = | 1890 Sq. Ft. |
| GROUND FLOOR COVERAGE | = | 847 Sq. Ft. |
| GARAGE COVERAGE / AREA | = | 212 Sq. Ft. |
| PORCH COVERAGE / AREA | = | 71 Sq. Ft. |
| COVERAGE W/ PORCH | = | 1130 Sq. Ft. |
| COVERAGE W/O PORCH | = | 1059 Sq. Ft. |
| | = | 98.38 Sq. m. |

AREA CALCULATIONS EL-2A

| | | |
|------------------------|---|---------------|
| FIRST FLOOR AREA | = | 847 Sq. Ft. |
| SECOND FLOOR AREA | = | 1043 Sq. Ft. |
| TOTAL FLOOR AREA | = | 1890 Sq. Ft. |
| ADD OPEN AREAS | = | 0 Sq. Ft. |
| ADD FIN. BASEMENT AREA | = | 0 Sq. Ft. |
| GROSS FLOOR AREA | = | 1890 Sq. Ft. |
| GROUND FLOOR COVERAGE | = | 847 Sq. Ft. |
| GARAGE COVERAGE / AREA | = | 212 Sq. Ft. |
| PORCH COVERAGE / AREA | = | 50 Sq. Ft. |
| COVERAGE W/ PORCH | = | 1109 Sq. Ft. |
| | = | 103.03 Sq. m. |
| COVERAGE W/O PORCH | = | 1059 Sq. Ft. |
| | = | 98.38 Sq. m. |

AREA CALCULATIONS EL-3A

| | | |
|------------------------|---|---------------|
| FIRST FLOOR AREA | = | 847 Sq. Ft. |
| SECOND FLOOR AREA | = | 1057 Sq. Ft. |
| TOTAL FLOOR AREA | = | 1904 Sq. Ft. |
| ADD OPEN AREAS | = | 0 Sq. Ft. |
| ADD FIN. BASEMENT AREA | = | 0 Sq. Ft. |
| GROSS FLOOR AREA | = | 1904 Sq. Ft. |
| GROUND FLOOR COVERAGE | = | 847 Sq. Ft. |
| GARAGE COVERAGE / AREA | = | 212 Sq. Ft. |
| PORCH COVERAGE / AREA | = | 50 Sq. Ft. |
| COVERAGE W/ PORCH | = | 1109 Sq. Ft. |
| | = | 103.03 Sq. m. |
| COVERAGE W/O PORCH | = | 1059 Sq. Ft. |
| | = | 98.38 Sq. m. |

AREA CALCULATIONS EL-1B

| | | |
|------------------------|---|---------------|
| FIRST FLOOR AREA | = | 847 Sq. Ft. |
| SECOND FLOOR AREA | = | 1047 Sq. Ft. |
| TOTAL FLOOR AREA | = | 1894 Sq. Ft. |
| ADD OPEN AREAS | = | 0 Sq. Ft. |
| ADD FIN. BASEMENT AREA | = | 0 Sq. Ft. |
| GROSS FLOOR AREA | = | 1894 Sq. Ft. |
| GROUND FLOOR COVERAGE | = | 847 Sq. Ft. |
| GARAGE COVERAGE / AREA | = | 212 Sq. Ft. |
| PORCH COVERAGE / AREA | = | 71 Sq. Ft. |
| COVERAGE W/ PORCH | = | 1130 Sq. Ft. |
| | = | 104.98 Sq. m. |
| COVERAGE W/O PORCH | = | 1059 Sq. Ft. |
| | = | 98.38 Sq. m. |

AREA CALCULATIONS EL-2B

| | | |
|------------------------|---|---------------|
| FIRST FLOOR AREA | = | 847 Sq. Ft. |
| SECOND FLOOR AREA | = | 1047 Sq. Ft. |
| TOTAL FLOOR AREA | = | 1894 Sq. Ft. |
| ADD OPEN AREAS | = | 0 Sq. Ft. |
| ADD FIN. BASEMENT AREA | = | 0 Sq. Ft. |
| GROSS FLOOR AREA | = | 1894 Sq. Ft. |
| GROUND FLOOR COVERAGE | = | 847 Sq. Ft. |
| GARAGE COVERAGE / AREA | = | 212 Sq. Ft. |
| PORCH COVERAGE / AREA | = | 50 Sq. Ft. |
| COVERAGE W/ PORCH | = | 1109 Sq. Ft. |
| | = | 103.03 Sq. m. |
| COVERAGE W/O PORCH | = | 1059 Sq. Ft. |
| | = | 98.38 Sq. m. |

AREA CALCULATIONS EL-3B

| | | |
|------------------------|---|---------------|
| FIRST FLOOR AREA | = | 847 Sq. Ft. |
| SECOND FLOOR AREA | = | 1048 Sq. Ft. |
| TOTAL FLOOR AREA | = | 1895 Sq. Ft. |
| ADD OPEN AREAS | = | 0 Sq. Ft. |
| ADD FIN. BASEMENT AREA | = | 0 Sq. Ft. |
| GROSS FLOOR AREA | = | 1895 Sq. Ft. |
| GROUND FLOOR COVERAGE | = | 847 Sq. Ft. |
| GARAGE COVERAGE / AREA | = | 212 Sq. Ft. |
| PORCH COVERAGE / AREA | = | 50 Sq. Ft. |
| COVERAGE W/ PORCH | = | 1109 Sq. Ft. |
| | = | 103.03 Sq. m. |
| COVERAGE W/O PORCH | = | 1059 Sq. Ft. |
| | = | 98.38 Sq. m. |

SEMI LOTS

PEYTON 1

ELEVATION 1,2 & 3

A1 PACKAGE

O.REG. 332/12

STRUDET INC.



FOR STRUCTURE ONLY

THE CONTRACTOR SHALL CHECK AND VERIFY ALL DIMENSIONS AND
CONDITIONS ON SITE BEFORE PROCEEDING WITH CONSTRUCTION.
ANY DISCREPANCIES SHALL BE REPORTED TO JARDIN DESIGN GROUP
INC. PRIOR TO COMMENCEMENT OF WORK.

JARDIN DESIGN GROUP INC. IS NOT RESPONSIBLE FOR THE ACCURACY
OF SURVEY, STRUCTURAL OR ENGINEERING INFORMATION SHOWN ON
THESE DRAWINGS OR FOR CONSTRUCTION STARTED PRIOR TO THE
ISSUANCE OF A BUILDING PERMIT. REFER TO THE APPROPRIATE
ENGINEERING DRAWINGS BEFORE PROCEEDING WITH WORK.

AS CONSTRUCTED INVENTS MUST BE VERIFIED PRIOR TO POURING
FOOTINGS.

JARDIN DESIGN GROUP INC. HAS NOT BEEN RETAINED TO CARRY OUT
GENERAL REVIEW OF THE WORK AND ASSUMES NO RESPONSIBILITY
FOR THE FAILURE OF THE CONTRACTOR OR SUB CONTRACTOR TO
CARRY OUT THE WORK IN ACCORDANCE WITH THE CONTRACT
DOCUMENTS.

THIS DRAWING IS AN INSTRUMENT OF SERVICE. IS PROVIDED BY AND IS
THE PROPERTY OF JARDIN DESIGN GROUP INC. THIS DRAWING IS NOT
TO BE SCALED.

| | | |
|---|---------------|-----------------------------------|
| 7 | | |
| 6 | | |
| 5 | | |
| 4 | | |
| 3 | JULY 2, 2020 | ISSUED FOR BUILDING PERMIT |
| 2 | JUNE 25, 2020 | ISSUED FOR PRE-COORDINATION STAGE |
| 1 | JUNE 2, 2020 | ISSUED FOR BROCHURE |

No: DATE: WORK DESCRIPTION:

jardin
DESIGN GROUP INC
64 JARDIN DR. SUITE 3A
VAUGHAN ONT. L4K 3P3
TEL: 905 660-3377 FAX: 905 660-3713
EMAIL: info@jardindesign.ca

The undersigned has reviewed and takes responsibility
for this design and has the qualifications and meets the
requirements set out in the Ontario Building Code to be
a designer

QUALIFICATION INFORMATION
Required unless design is exempt under Division C, Subsection
3.2.5 of the building code

Walter Botter 21031

NAME SIGNATURE BCIN

REGISTRATION INFORMATION
Required unless design is exempt under Division C, Subsection
3.2.4 of the building code

jardin design group inc. 27763

FIRM NAME BCIN

TITLE SHEET

LAMPONE INVESTMENTS INC.
CITY OF MARKHAM



| | | |
|-----------|-------------|----------|
| MODEL: | T | ---- |
| SCALE: | 3/16"=1'-0" | |
| PROJ. No. | 20-03 | DWG. No. |
| | | 0 |

CITY OF **MARKHAM**
BUILDING STANDARDS DIVISION
REVIEWED FOR COMPLIANCE WITH THE ONTARIO BUILDING
CODE AND THE APPLICABLE ZONING BY-LAW




Date: 02/10/21

**ALL CONSTRUCTION SHALL COMPLY WITH
THE ONTARIO BUILDING CODE**

NO PERSON SHALL CONSTRUCT OR DEMOLISH A BUILDING OR
CAUSE A BUILDING TO BE CONSTRUCTED EXCEPT IN ACCORDANCE
WITH THESE CERTIFIED BUILDING PERMIT DOCUMENTS, THE
BUILDING CODE ACT AND THE BUILDING CODE.

NOTE: THE PROPOSED DEVELOPMENT IS SUBJECT TO COMPLIANCE
WITH ALL APPLICABLE PROVISIONS OF THE ZONING BY-LAW AND
ALL OTHER APPLICABLE LAWS INCLUDING THE PROVISIONS OF A
SITE PLAN AND / OR SUBDIVISION AGREEMENT WHICH MAY OR MAY
NOT BE REGISTERED ON TITLE

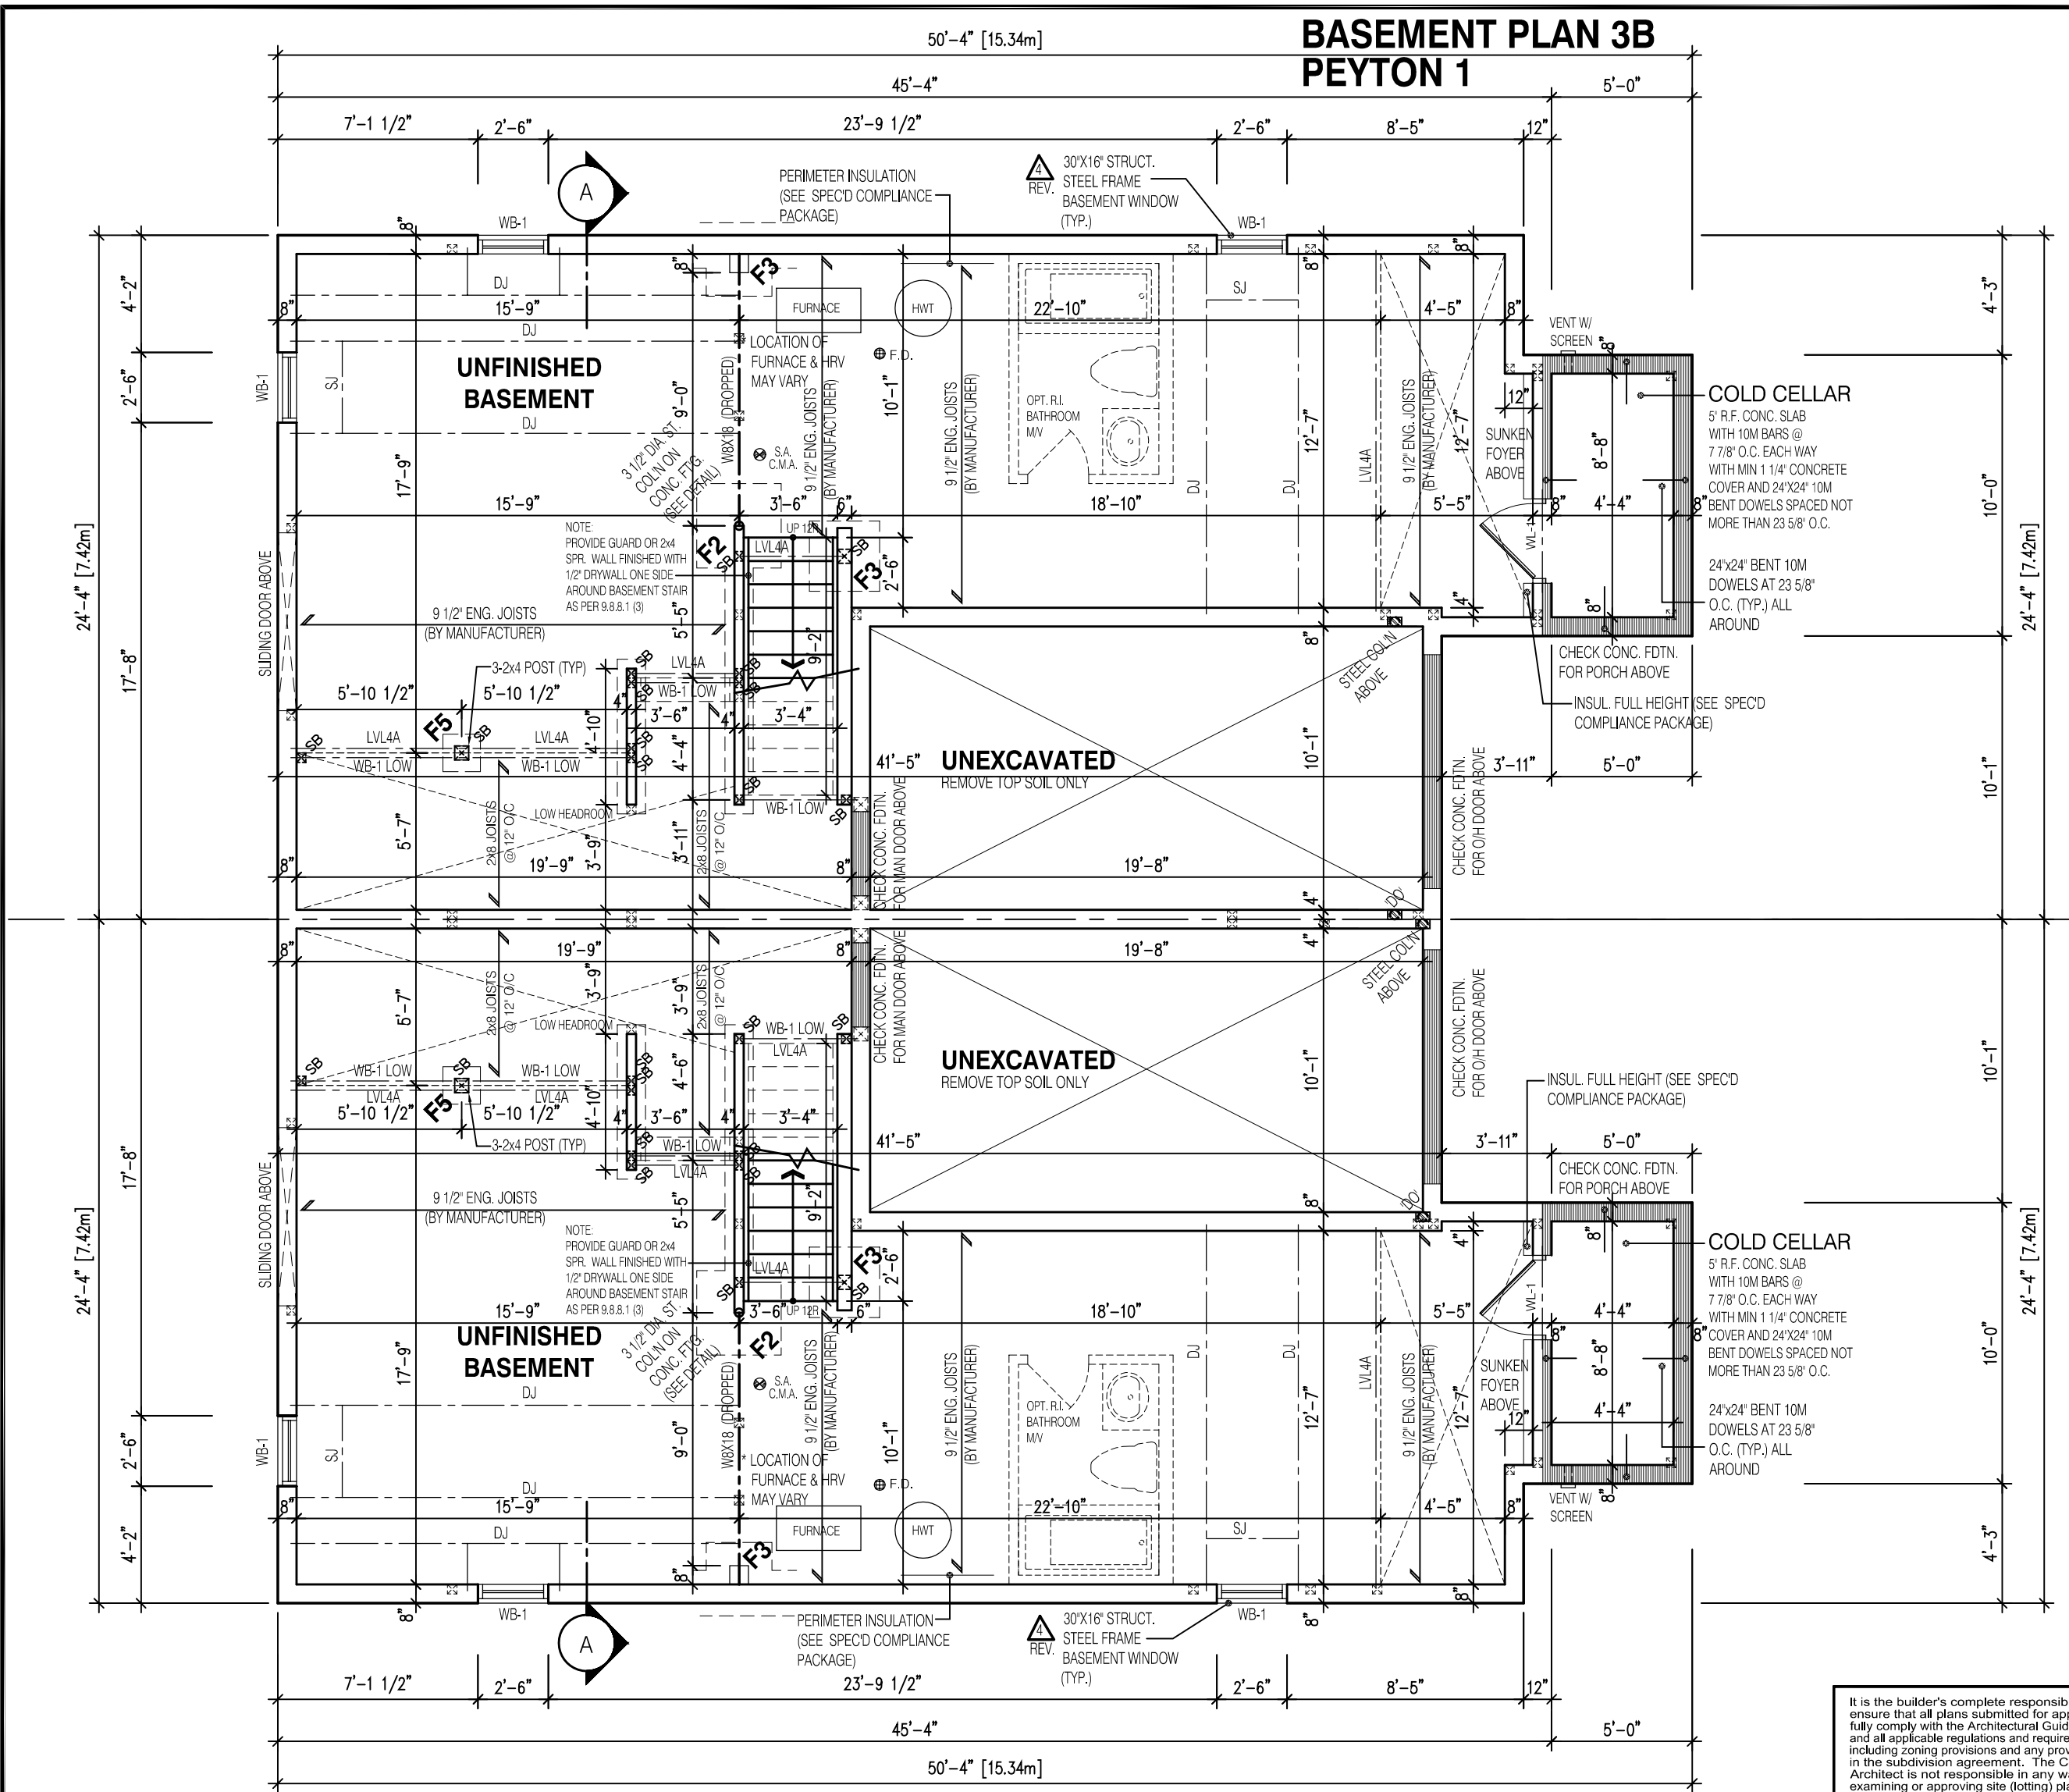

| | | | |
|--|--|---|--|
| NOTE: SPACE CONVENTIONAL FLOOR JOISTS @ 12" O.C. BELOW ALL CERAMIC TILE AREAS. PROVIDE 1 ROW BRIDGING FOR SPANS OF 5'-7"; 2 ROWS FOR SPANS GREATER THAN 7' | NOTE: REFER TO SHEET NO. 0-1 FOR LINTEL, BEAMS AND DOOR SIZE | NOTE: SUBFLOOR TO BE 5/8" PLYWOOD ON THIS LEVEL | LEGEND: BUILDING FACE < THAN 4'-0" (1.2m) (45 MIN. FIRE RATING REQ'D) INDICATES SOLID BEARING REQUIRED OR POINT LOAD FROM ABOVE STL. PLATE FOR STEEL COLN ABOVE LAMINATED VENEER LUMBER S.J. SINGLE JOIST D.J. DOUBLE JOIST T.J. TRIPLE JOIST REPEAT NOTE SHOWER WEEPERS |
| NOTE: THESE DRAWINGS ARE TO BE READ IN CONJUNCTION WITH ENGINEER APPROVED FLOOR TRUSS LAYOUT BY MANUFACTURER. | | NOTE: ALL FLOORS TO BE NAILED AND GLUED ON THIS LEVEL | |

BASEMENT PLAN 3A
PEYTON 1

It is the builder's complete responsibility to ensure that all plans submitted for approval fully comply with the Architectural Guidelines and all applicable regulations and requirements including zoning provisions and any provisions in the subdivision agreement. The Control Architect is not responsible in any way for examining or approving site (lotting) plans or working drawings with respect to any zoning or building code or permit matter or that any house can be properly built or located on its lot.

This is to certify that these plans comply with the applicable Architectural Design Guidelines approved by the City of MARKHAM.

1904/1895
SEMI LOTS

PEYTON 1
ELEVATION 3A & 3B

A1 PACKAGE

O.REG. 332/12

STRUDET INC.

FOR STRUCTURE ONLY

| | |
|--|-------------------------|
| THE CONTRACTOR SHALL CHECK AND VERIFY ALL DIMENSIONS AND CONDITIONS ON SITE BEFORE PROCEEDING WITH CONSTRUCTION. ANY DISCREPANCIES SHALL BE REPORTED TO JARDIN DESIGN GROUP INC. PRIOR TO COMMENCEMENT OF WORK. | |
| JARDIN DESIGN GROUP INC. IS NOT RESPONSIBLE FOR THE ACCURACY OF SURVEY, STRUCTURAL OR ENGINEERING INFORMATION SHOWN ON THESE DRAWINGS OR FOR CONSTRUCTION STARTED PRIOR TO THE ISSUANCE OF A BUILDING PERMIT. REFER TO THE APPROPRIATE ENGINEERING DRAWINGS BEFORE PROCEEDING WITH WORK. | |
| AS CONSTRUCTED INVERTS MUST BE VERIFIED PRIOR TO POURING FOOTINGS. | |
| JARDIN DESIGN GROUP INC. HAS NOT BEEN RETAINED TO CARRY OUT GENERAL REVIEW OF THE WORK AND ASSUMES NO RESPONSIBILITY FOR THE FAILURE OF THE CONTRACTOR OR SUB CONTRACTOR TO CARRY OUT THE WORK IN ACCORDANCE WITH THE CONTRACT DOCUMENTS. | |
| THIS DRAWING IS AN INSTRUMENT OF SERVICE, IS PROVIDED BY AND IS THE PROPERTY OF JARDIN DESIGN GROUP INC. THIS DRAWING IS NOT TO BE SCALED. | |
| 7 | |
| 6 | |
| 5 | |
| 4 | DEC. 2, 2020 |
| 3 | JULY 2, 2020 |
| 2 | JUNE 25, 2020 |
| 1 | JUNE 2, 2020 |
| No. | DATE: WORK DESCRIPTION: |

jardin
DESIGN GROUP INC

64 JARDIN DR. SUITE 3A
VAUGHAN ONT. L4K 3P3
TEL: 905 660-3377 FAX: 905 660-3713
EMAIL: info@jardindesign.ca

The undersigned has reviewed and takes responsibility for this design and has the qualifications and meets the requirements set out in the Ontario Building Code to be a designer

QUALIFICATION INFORMATION
Required unless design is exempt under Division C, Subsection 3.2.5 of the building code

Walter Botter 21031
NAME SIGNATURE BCIN

REGISTRATION INFORMATION
Required unless design is exempt under Division C, Subsection 3.2.4 of the building code

jardin design group inc. 27763
FIRM NAME BCIN

BASEMENT PLAN EL-3

LAMPONE INVESTMENTS INC.
CITY OF MARKHAM

MODEL: T
SCALE: 3/16"=1'-0"
PROJ. No. 20-03 DWG. No. 1B




Date: 02/10/21

ALL CONSTRUCTION SHALL COMPLY WITH
THE ONTARIO BUILDING CODE

NO PERSON SHALL CONSTRUCT OR DEMOLISH A BUILDING OR
CAUSE A BUILDING TO BE CONSTRUCTED EXCEPT IN ACCORDANCE
WITH THESE CERTIFIED BUILDING PERMIT DOCUMENTS, THE
BUILDING CODE ACT AND THE BUILDING CODE.

NOTE: THE PROPOSED DEVELOPMENT IS SUBJECT TO COMPLIANCE
WITH ALL APPLICABLE PROVISIONS OF THE ZONING BY-LAW AND
ALL OTHER APPLICABLE LAWS INCLUDING THE PROVISIONS OF A
SITE PLAN AND / OR SUBDIVISION AGREEMENT WHICH MAY OR MAY
NOT BE REGISTERED ON TITLE

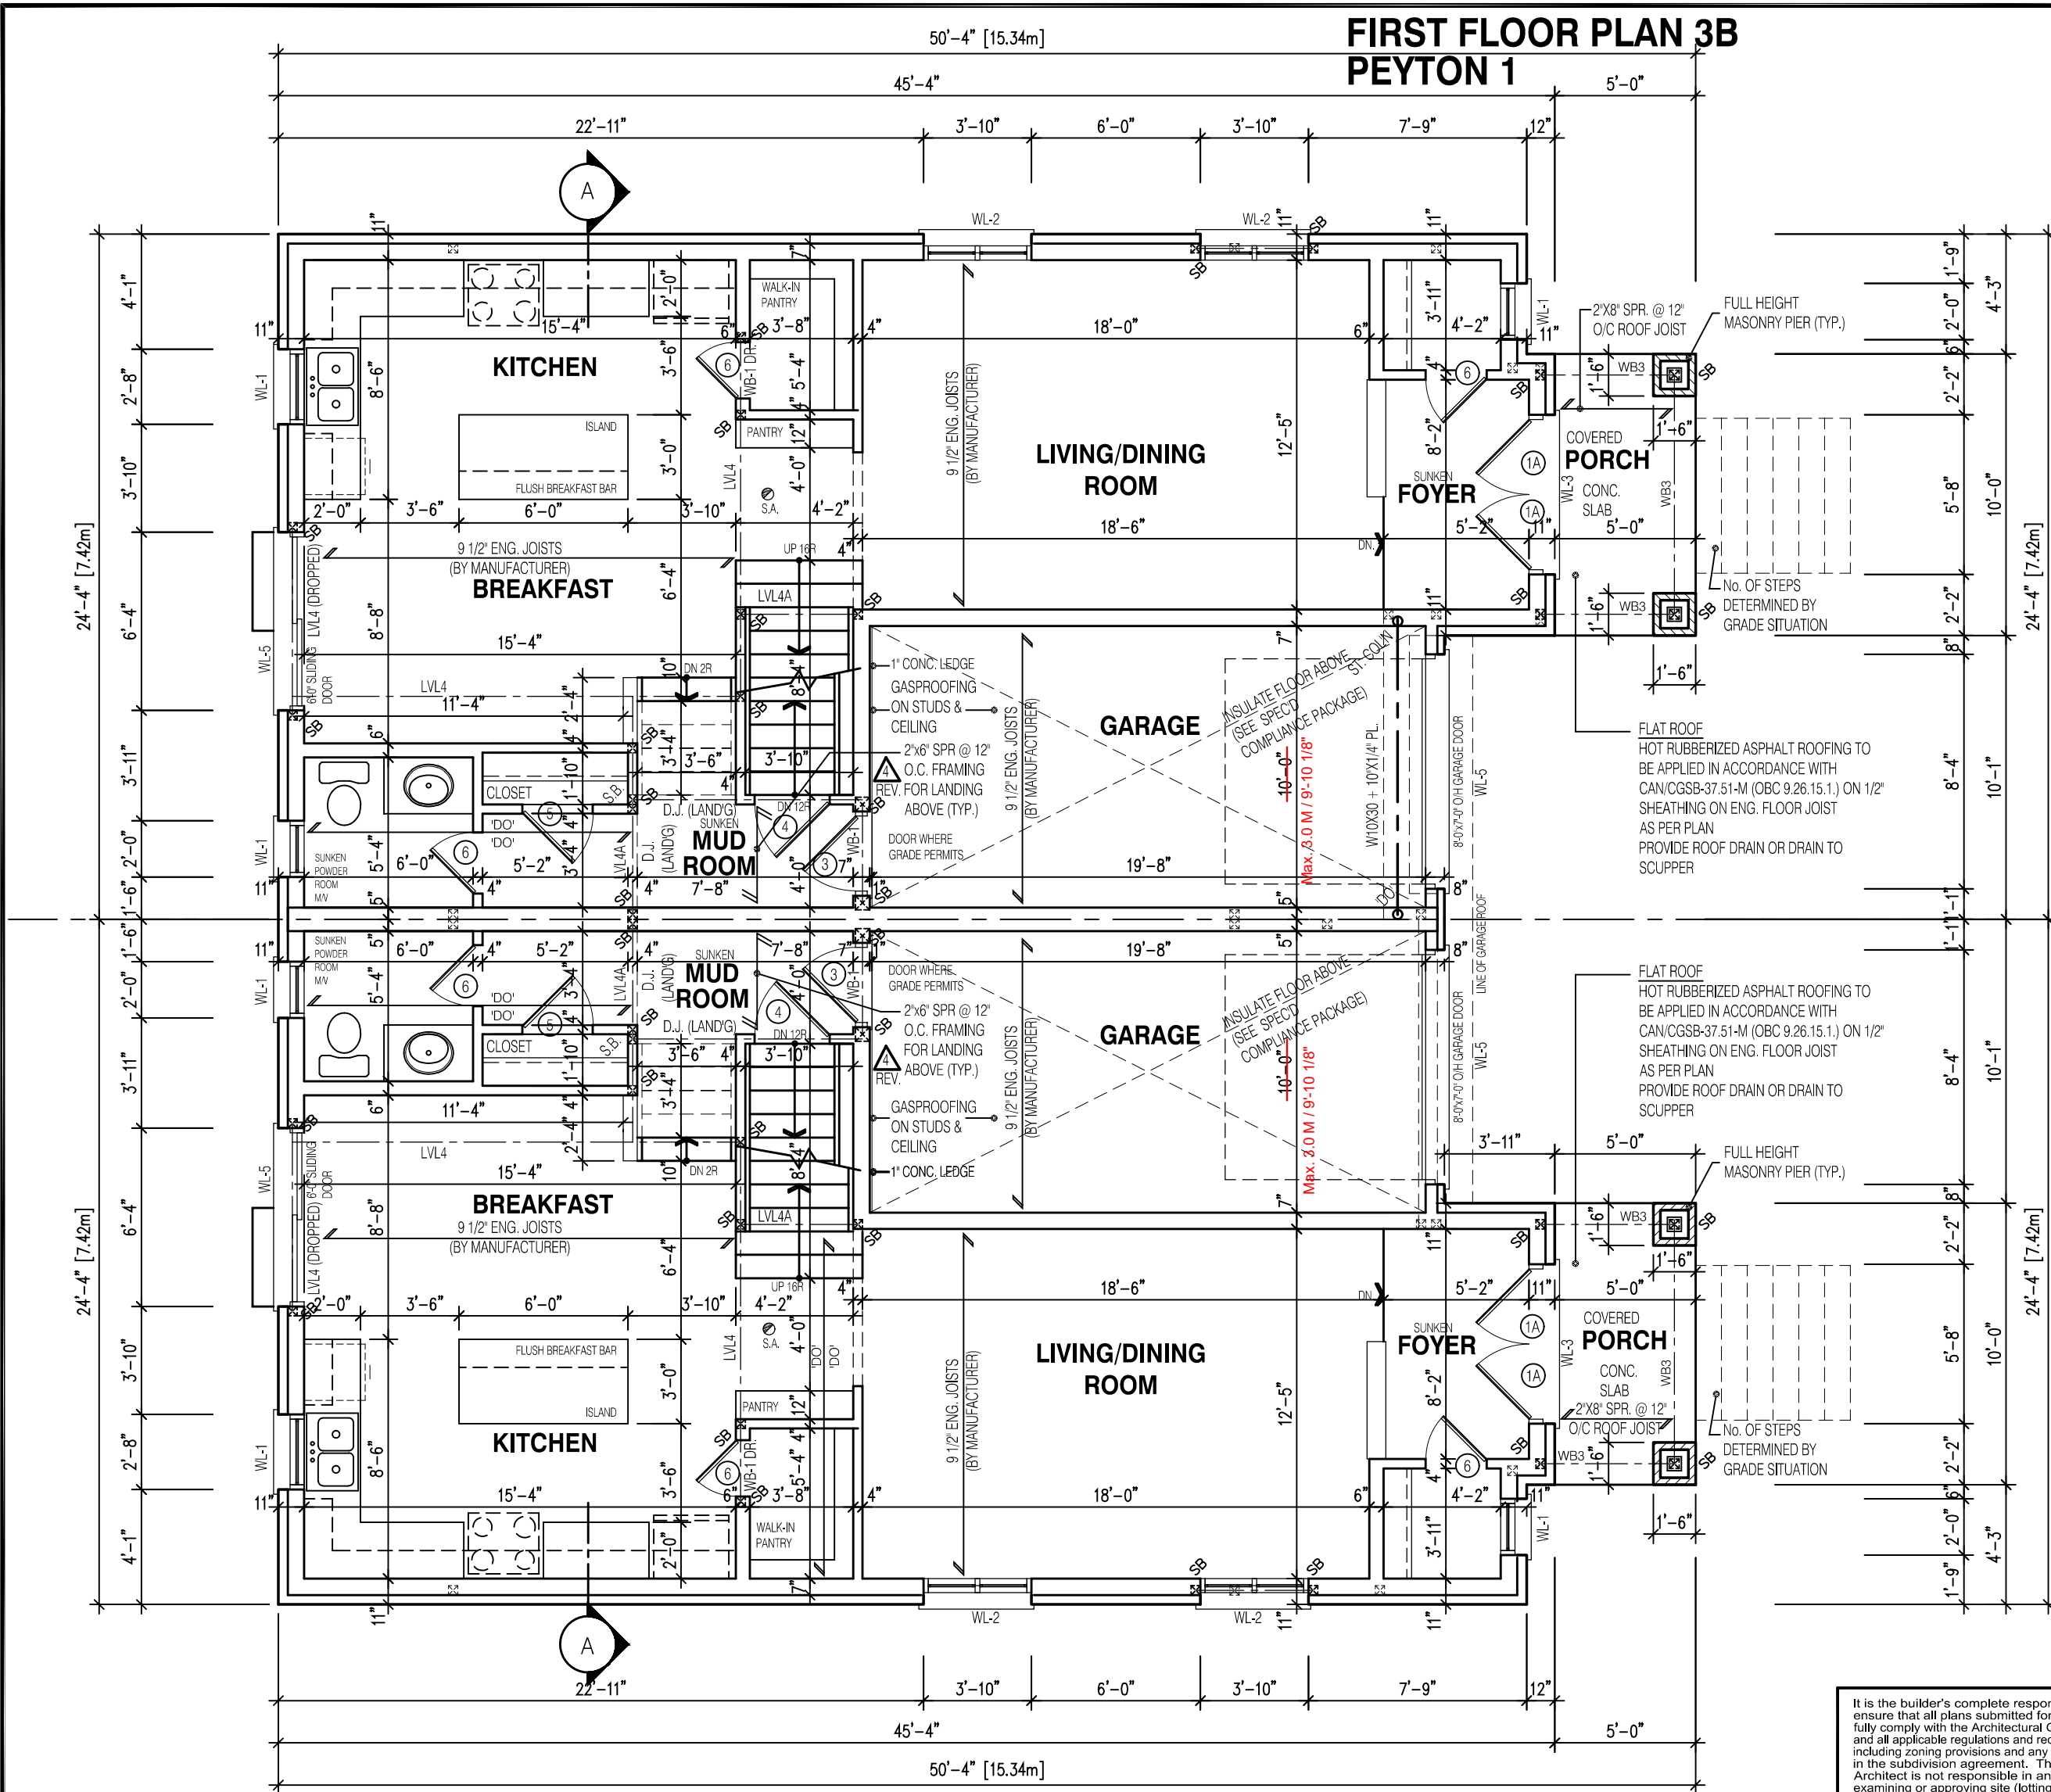

| | | | | |
|--|---|---|--|--|
| NOTE: THESE DRAWINGS ARE TO BE READ IN CONJUNCTION WITH ENGINEER APPROVED ROOF TRUSS DRAWINGS BY MANUFACTURER. | NOTE: SPACE CONVENTIONAL FLOOR JOISTS @ 12" O.C. BELOW ALL CERAMIC TILE AREAS. PROVIDE 1 ROW BRIDGING FOR SPANS OF 5'-7, 2 ROWS FOR SPANS GREATER THAN 7' | NOTE: SUBFLOOR TO BE 5/8" PLYWOOD ON THIS LEVEL | LEGEND: <div><div></div> BUILDING FACE < THAN 4'-0" (1.2m) (45 MIN. FIRE RATING REQ'D)</div> <div><div></div> INDICATES SOLID BEARING REQUIRED OR POINT LOAD FROM ABOVE</div> <div><div></div> STL. PLATE FOR STEEL COLN ABOVE</div> <div><div></div> LVL LAMINATED VENEER LUMBER</div> | S.J. SINGLE JOIST D.J. DOUBLE JOIST T.J. TRIPLE JOIST ○ REPEAT NOTE ○ SHOWER WEEPERS |
| NOTE: REFER TO SHEET NO. 0-1 FOR LINTEL, BEAMS AND DOOR SIZE | NOTE: THESE DRAWINGS ARE TO BE READ IN CONJUNCTION WITH ENGINEER APPROVED FLOOR TRUSS LAYOUT BY MANUFACTURER. | ALL FLOORS TO BE NAILED AND GLUED ON THIS LEVEL | | |

FIRST FLOOR PLAN 3A
PEYTON 1

It is the builder's complete responsibility to ensure that all plans submitted for approval fully comply with the Architectural Guidelines and all applicable regulations and requirements including zoning provisions and any provisions in the subdivision agreement. The Control Architect is not responsible in any way for examining or approving site (lotting) plans or working drawings with respect to any zoning or building code or permit matter or that any house can be properly built or located on its lot.

This is to certify that these plans comply with the applicable Architectural Design Guidelines approved by the City of MARKHAM.

1904/1895
SEMI LOTS

PEYTON 1
ELEVATION 3A & 3B

A1 PACKAGE

O.REG. 332/12

STRUDET INC.

REGISTERED PROFESSIONAL ENGINEER
B. MARINKOVIC
December 15, 2020
PROVINCE OF ONTARIO

FOR STRUCTURE ONLY

THE CONTRACTOR SHALL CHECK AND VERIFY ALL DIMENSIONS AND CONDITIONS ON SITE BEFORE PROCEEDING WITH CONSTRUCTION. ANY DISCREPANCIES SHALL BE REPORTED TO JARDIN DESIGN GROUP INC. PRIOR TO COMMENCEMENT OF WORK.

JARDIN DESIGN GROUP INC. IS NOT RESPONSIBLE FOR THE ACCURACY OF SURVEY, STRUCTURAL OR ENGINEERING INFORMATION SHOWN ON THESE DRAWINGS OR FOR CONSTRUCTION STARTED PRIOR TO THE ISSUANCE OF A BUILDING PERMIT. REFER TO THE APPROPRIATE ENGINEERING DRAWINGS BEFORE PROCEEDING WITH WORK.

AS CONSTRUCTED INVERTS MUST BE VERIFIED PRIOR TO POURING FOOTINGS.

JARDIN DESIGN GROUP INC. HAS NOT BEEN RETAINED TO CARRY OUT GENERAL REVIEW OF THE WORK AND ASSUMES NO RESPONSIBILITY FOR THE FAILURE OF THE CONTRACTOR OR SUB CONTRACTOR TO CARRY OUT THE WORK IN ACCORDANCE WITH THE CONTRACT DOCUMENTS.

THIS DRAWING IS AN INSTRUMENT OF SERVICE. IS PROVIDED BY AND IS THE PROPERTY OF JARDIN DESIGN GROUP INC. THIS DRAWING IS NOT TO BE SCALED.

| | |
|---|---------------|
| 7 | |
| 6 | |
| 5 | |
| 4 | DEC. 2, 2020 |
| 3 | JULY 2, 2020 |
| 2 | JUNE 25, 2020 |
| 1 | JUNE 2, 2020 |

No. DATE: WORK DESCRIPTION:

jardin
DESIGN GROUP INC

64 JARDIN DR. SUITE 3A
VAUGHAN ONT. L4K 3P3
TEL: 905 660-3377 FAX: 905 660-3713
EMAIL: info@jardindesign.ca

The undersigned has reviewed and takes responsibility for this design and has the qualifications and meets the requirements set out in the Ontario Building Code to be a designer

QUALIFICATION INFORMATION
Required unless design is exempt under Division C, Subsection 3.2.5 of the building code.

Walter Botter
NAME SIGNATURE BCIN 21031

REGISTRATION INFORMATION
Required unless design is exempt under Division C, Subsection 3.2.4 of the building code

jardin design group inc. 27763

FIRM NAME BCIN

FIRST FLOOR PLAN EL-3

LAMPONE INVESTMENTS INC.
CITY OF MARKHAM


BILD

MODEL: T
SCALE: 3/16"=1'-0"
PROJ. No. 20-03 DWG. No. 2B

CITY OF MARKHAM
BUILDING STANDARDS DIVISION
REVIEWED FOR COMPLIANCE WITH THE ONTARIO BUILDING CODE AND THE APPLICABLE ZONING BY-LAW

Date: 02/10/21
ALL CONSTRUCTION SHALL COMPLY WITH THE ONTARIO BUILDING CODE
NO PERSON SHALL CONSTRUCT OR DEMOLISH A BUILDING OR CAUSE A BUILDING TO BE CONSTRUCTED EXCEPT IN ACCORDANCE WITH THESE CERTIFIED BUILDING PERMIT DOCUMENTS, THE BUILDING CODE ACT AND THE BUILDING CODE.
NOTE: THE PROPOSED DEVELOPMENT IS SUBJECT TO COMPLIANCE WITH ALL APPLICABLE PROVISIONS OF THE ZONING BY-LAW AND ALL OTHER APPLICABLE LAWS INCLUDING THE PROVISIONS OF A SITE PLAN AND / OR SUBDIVISION AGREEMENT WHICH MAY OR MAY NOT BE REGISTERED ON TITLE

SECOND FLOOR PLAN 3B
PEYTON 1

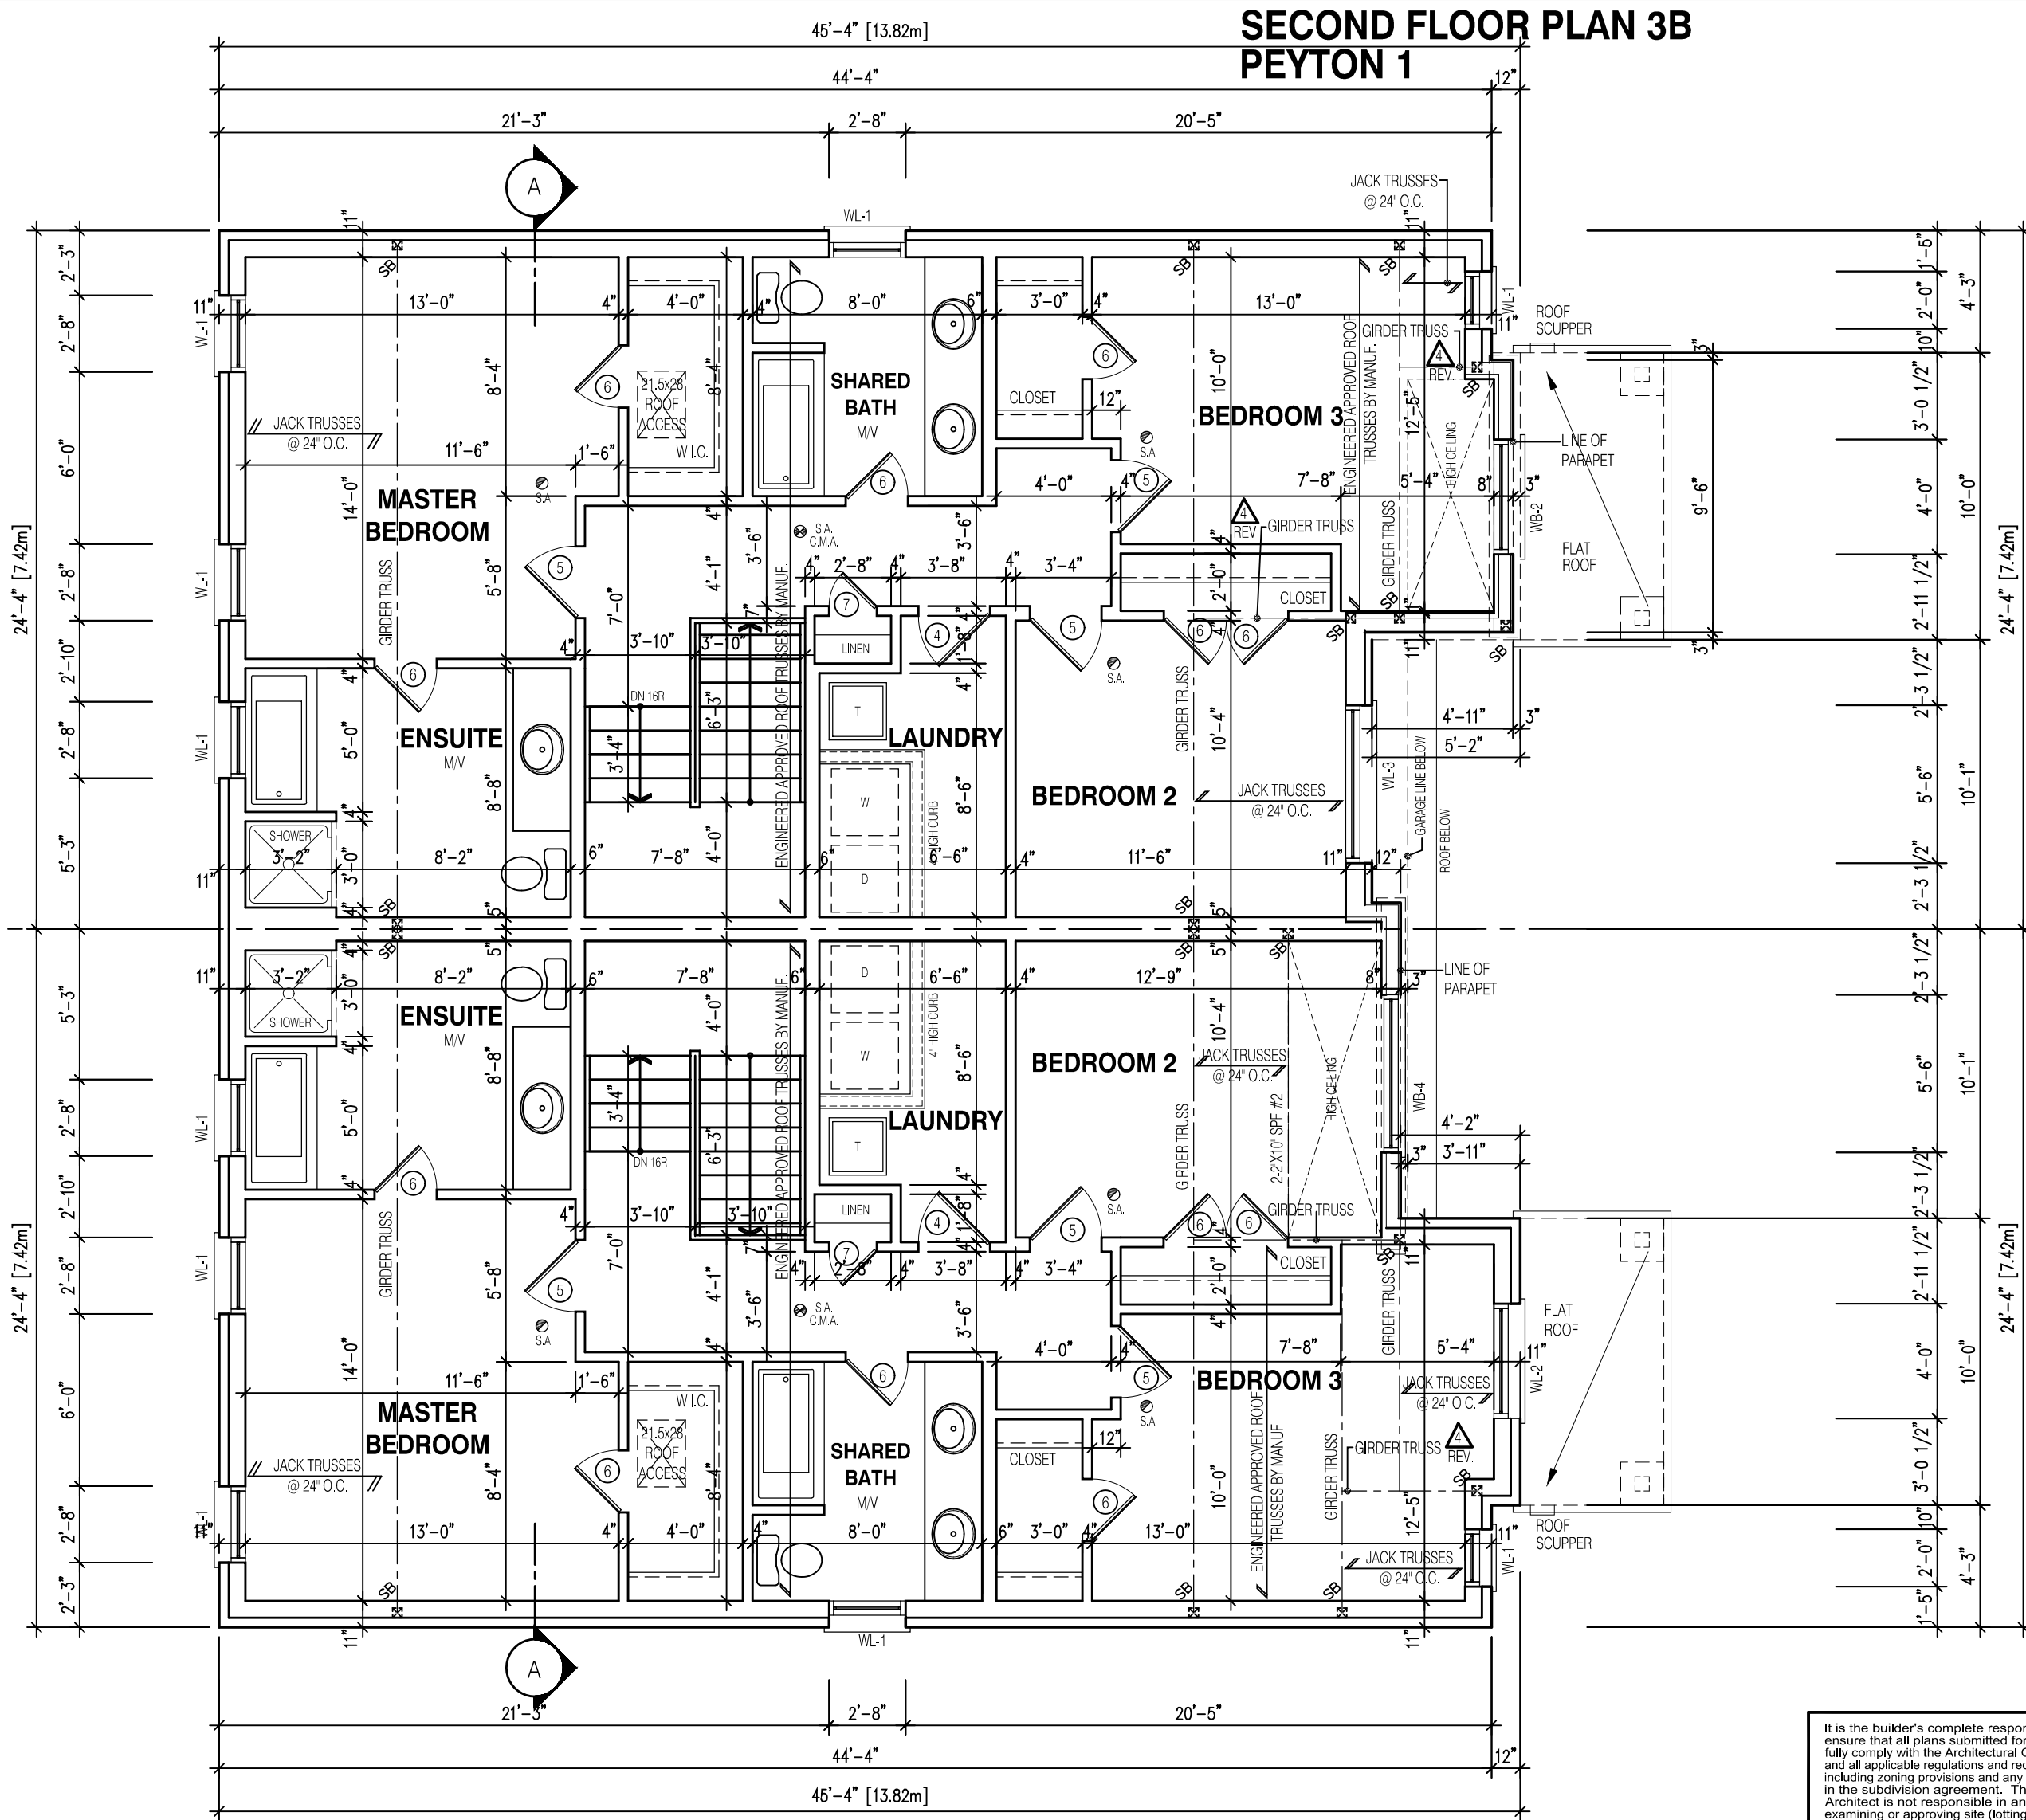

SECOND FLOOR PLAN 3A
PEYTON 1

LEGEND:

| | | | |
|--|--|------|----------------|
| | BUILDING FACE < THAN 4'-0" (1.2m) (45 MIN. FIRE RATING REQ'D) | S.J. | SINGLE JOIST |
| | INDICATES SOLID BEARING REQUIRED OR POINT LOAD FROM ABOVE | D.J. | DOUBLE JOIST |
| | STL. PLATE FOR STEEL COL'N ABOVE | T.J. | TRIPLE JOIST |
| | LVL | | REPEAT NOTE |
| | | | SHOWER WEEPERS |

NOTE:
THESE DRAWINGS ARE TO BE READ IN CONJUNCTION WITH ENGINEER APPROVED ROOF TRUSS DRAWINGS BY MANUFACTURER.

It is the builder's complete responsibility to ensure that all plans submitted for approval fully comply with the Architectural Guidelines and all applicable regulations and requirements including zoning provisions and any provisions in the subdivision agreement. The Control Architect is not responsible in any way for examining or approving site (lotting) plans or working drawings with respect to any zoning or building code or permit matter or that any house can be properly built or located on its lot.

This is to certify that these plans comply with the applicable Architectural Design Guidelines approved by the City of MARKHAM.

1904/1895
SEMI LOTS

PEYTON 1
ELEVATION 3A & 3B

A1 PACKAGE

O.REG. 332/12

STRUDET INC.

REGISTERED PROFESSIONAL ENGINEER
B. MARINKOVIC
December 15, 2020
PROVINCE OF ONTARIO

FOR STRUCTURE ONLY

THE CONTRACTOR SHALL CHECK AND VERIFY ALL DIMENSIONS AND CONDITIONS ON SITE BEFORE PROCEEDING WITH CONSTRUCTION. ANY DISCREPANCIES SHALL BE REPORTED TO JARDIN DESIGN GROUP INC. PRIOR TO COMMENCEMENT OF WORK.

JARDIN DESIGN GROUP INC. IS NOT RESPONSIBLE FOR THE ACCURACY OF SURVEY, STRUCTURAL OR ENGINEERING INFORMATION SHOWN ON THESE DRAWINGS OR FOR CONSTRUCTION STARTED PRIOR TO THE ISSUANCE OF A BUILDING PERMIT. REFER TO THE APPROPRIATE ENGINEERING DRAWINGS BEFORE PROCEEDING WITH WORK.

AS CONSTRUCTED INVERTS MUST BE VERIFIED PRIOR TO POURING FOOTINGS.

JARDIN DESIGN GROUP INC. HAS NOT BEEN RETAINED TO CARRY OUT GENERAL REVIEW OF THE WORK AND ASSUMES NO RESPONSIBILITY FOR THE FAILURE OF THE CONTRACTOR OR SUB CONTRACTOR TO CARRY OUT THE WORK IN ACCORDANCE WITH THE CONTRACT DOCUMENTS.

THIS DRAWING IS AN INSTRUMENT OF SERVICE, IS PROVIDED BY AND IS THE PROPERTY OF JARDIN DESIGN GROUP INC. THIS DRAWING IS NOT TO BE SCALED.

| | |
|---|---------------|
| 7 | |
| 6 | |
| 5 | |
| 4 | DEC. 2, 2020 |
| 3 | JULY 2, 2020 |
| 2 | JUNE 25, 2020 |
| 1 | JUNE 2, 2020 |

No: DATE: WORK DESCRIPTION:

jardin
DESIGN GROUP INC
64 JARDIN DR. SUITE 3A
VAUGHAN ONT. L4K 3P3
TEL: 905 660-3377 FAX: 905 660-3713
EMAIL: info@jardindesign.ca

The undersigned has reviewed and takes responsibility for this design and has the qualifications and meets the requirements set out in the Ontario Building Code to be a designer

QUALIFICATION INFORMATION
Required unless design is exempt under Division C, Subsection 3.2.5 of the building code.

Walter Botter 21031
NAME SIGNATURE BCIN

REGISTRATION INFORMATION
Required unless design is exempt under Division C, Subsection 3.2.4 of the building code

jardin design group inc. 27763
FIRM NAME BCIN

SEC. FLOOR PLAN EL-3

LAMPONE INVESTMENTS INC.
CITY OF MARKHAM

MODEL: T
SCALE: 3/16"=1'-0"
PROJ. No. 20-03 DWG. No. 3B




Date: 02/10/21


ALL CONSTRUCTION SHALL COMPLY WITH THE ONTARIO BUILDING CODE

NO PERSON SHALL CONSTRUCT OR DEMOLISH A BUILDING OR CAUSE A BUILDING TO BE CONSTRUCTED EXCEPT IN ACCORDANCE WITH THESE CERTIFIED BUILDING PERMIT DOCUMENTS, THE BUILDING CODE ACT AND THE BUILDING CODE.

NOTE: THE PROPOSED DEVELOPMENT IS SUBJECT TO COMPLIANCE WITH ALL APPLICABLE PROVISIONS OF THE ZONING BY-LAW AND ALL OTHER APPLICABLE LAWS INCLUDING THE PROVISIONS OF A SITE PLAN AND / OR SUBDIVISION AGREEMENT WHICH MAY OR MAY NOT BE REGISTERED ON TITLE

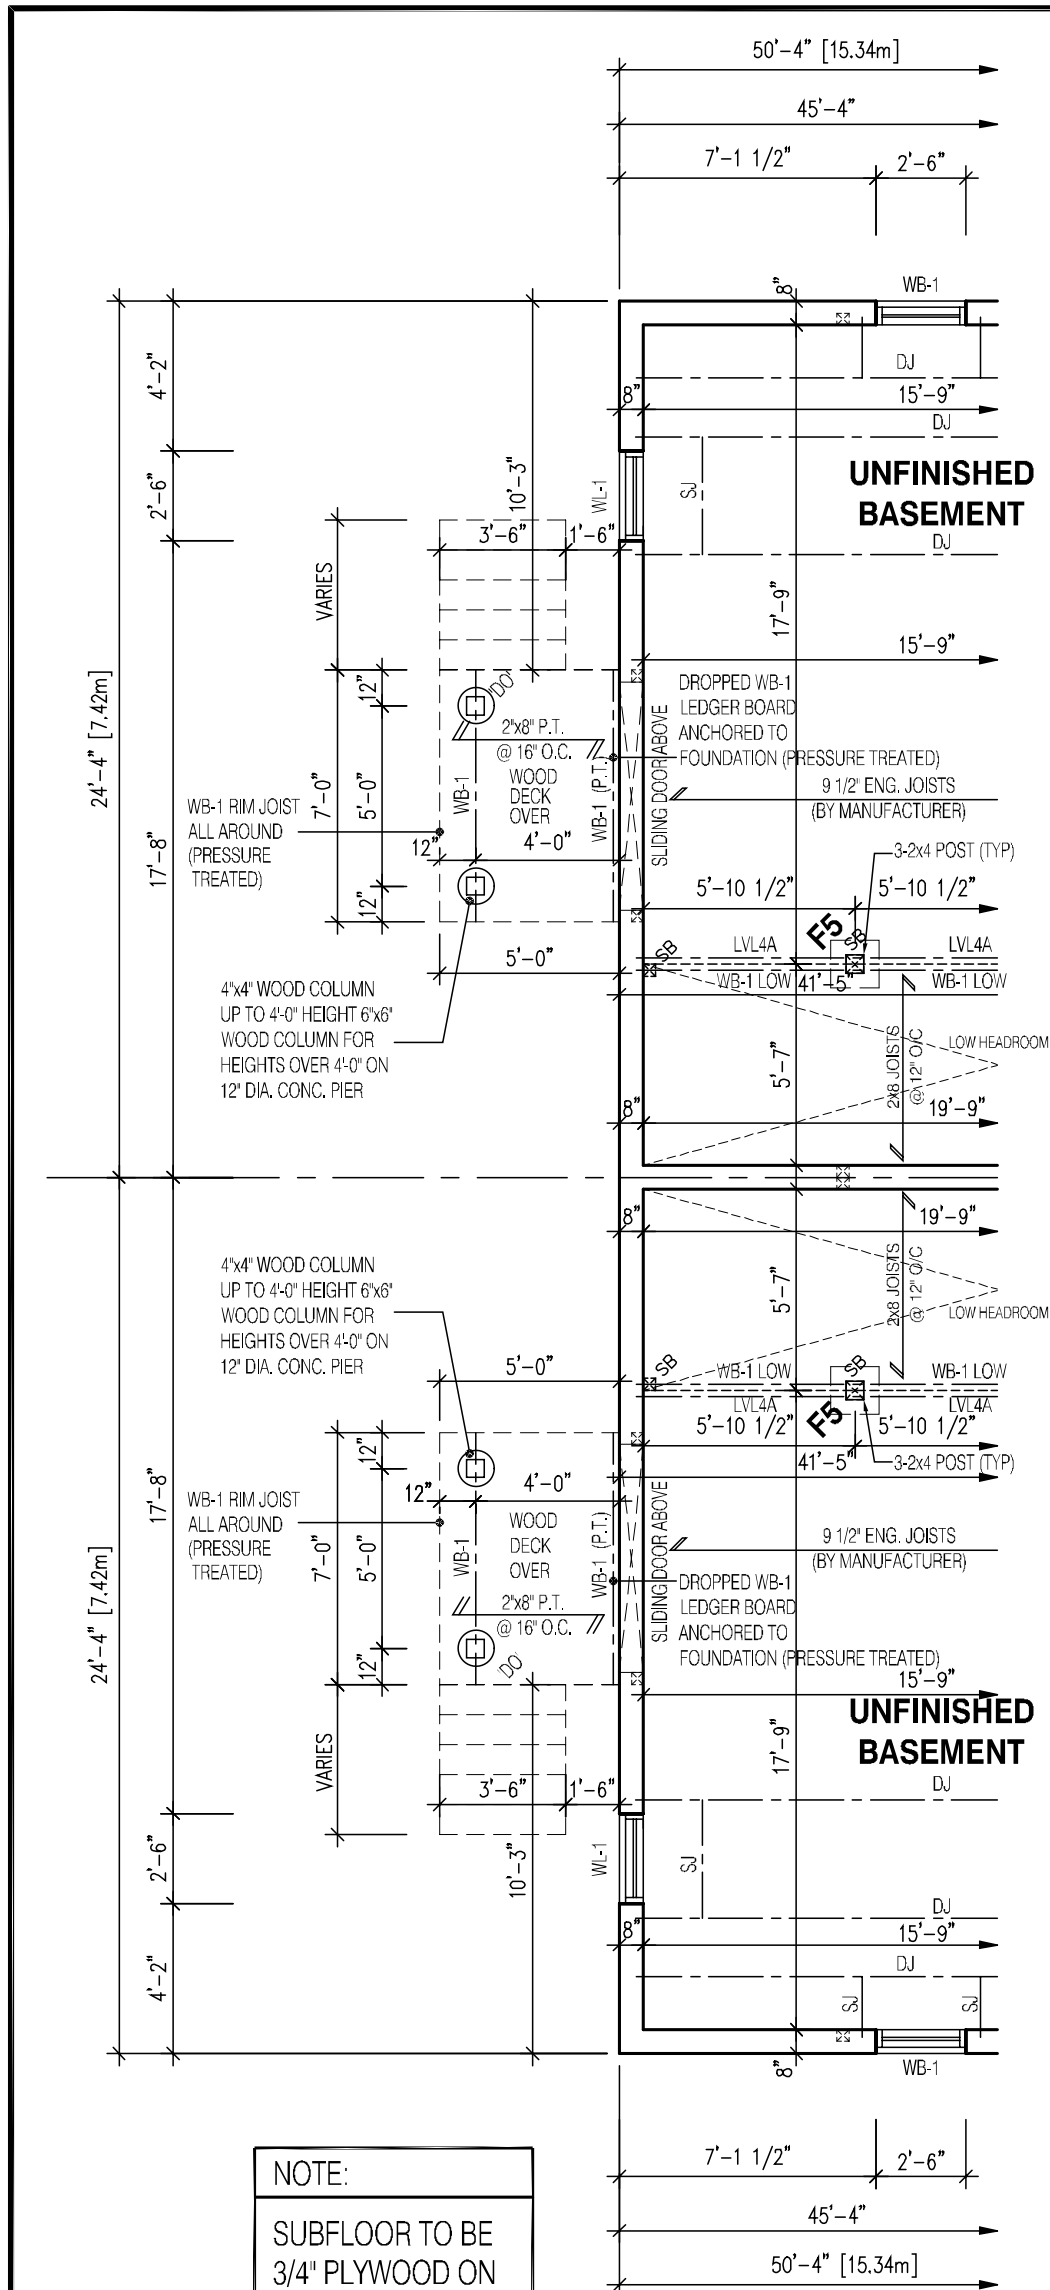

NOTE:
SUBFLOOR TO BE
3/4" PLYWOOD ON
THIS LEVEL
ALL FLOORS TO BE
NAILED AND GLUED
ON THIS LEVEL

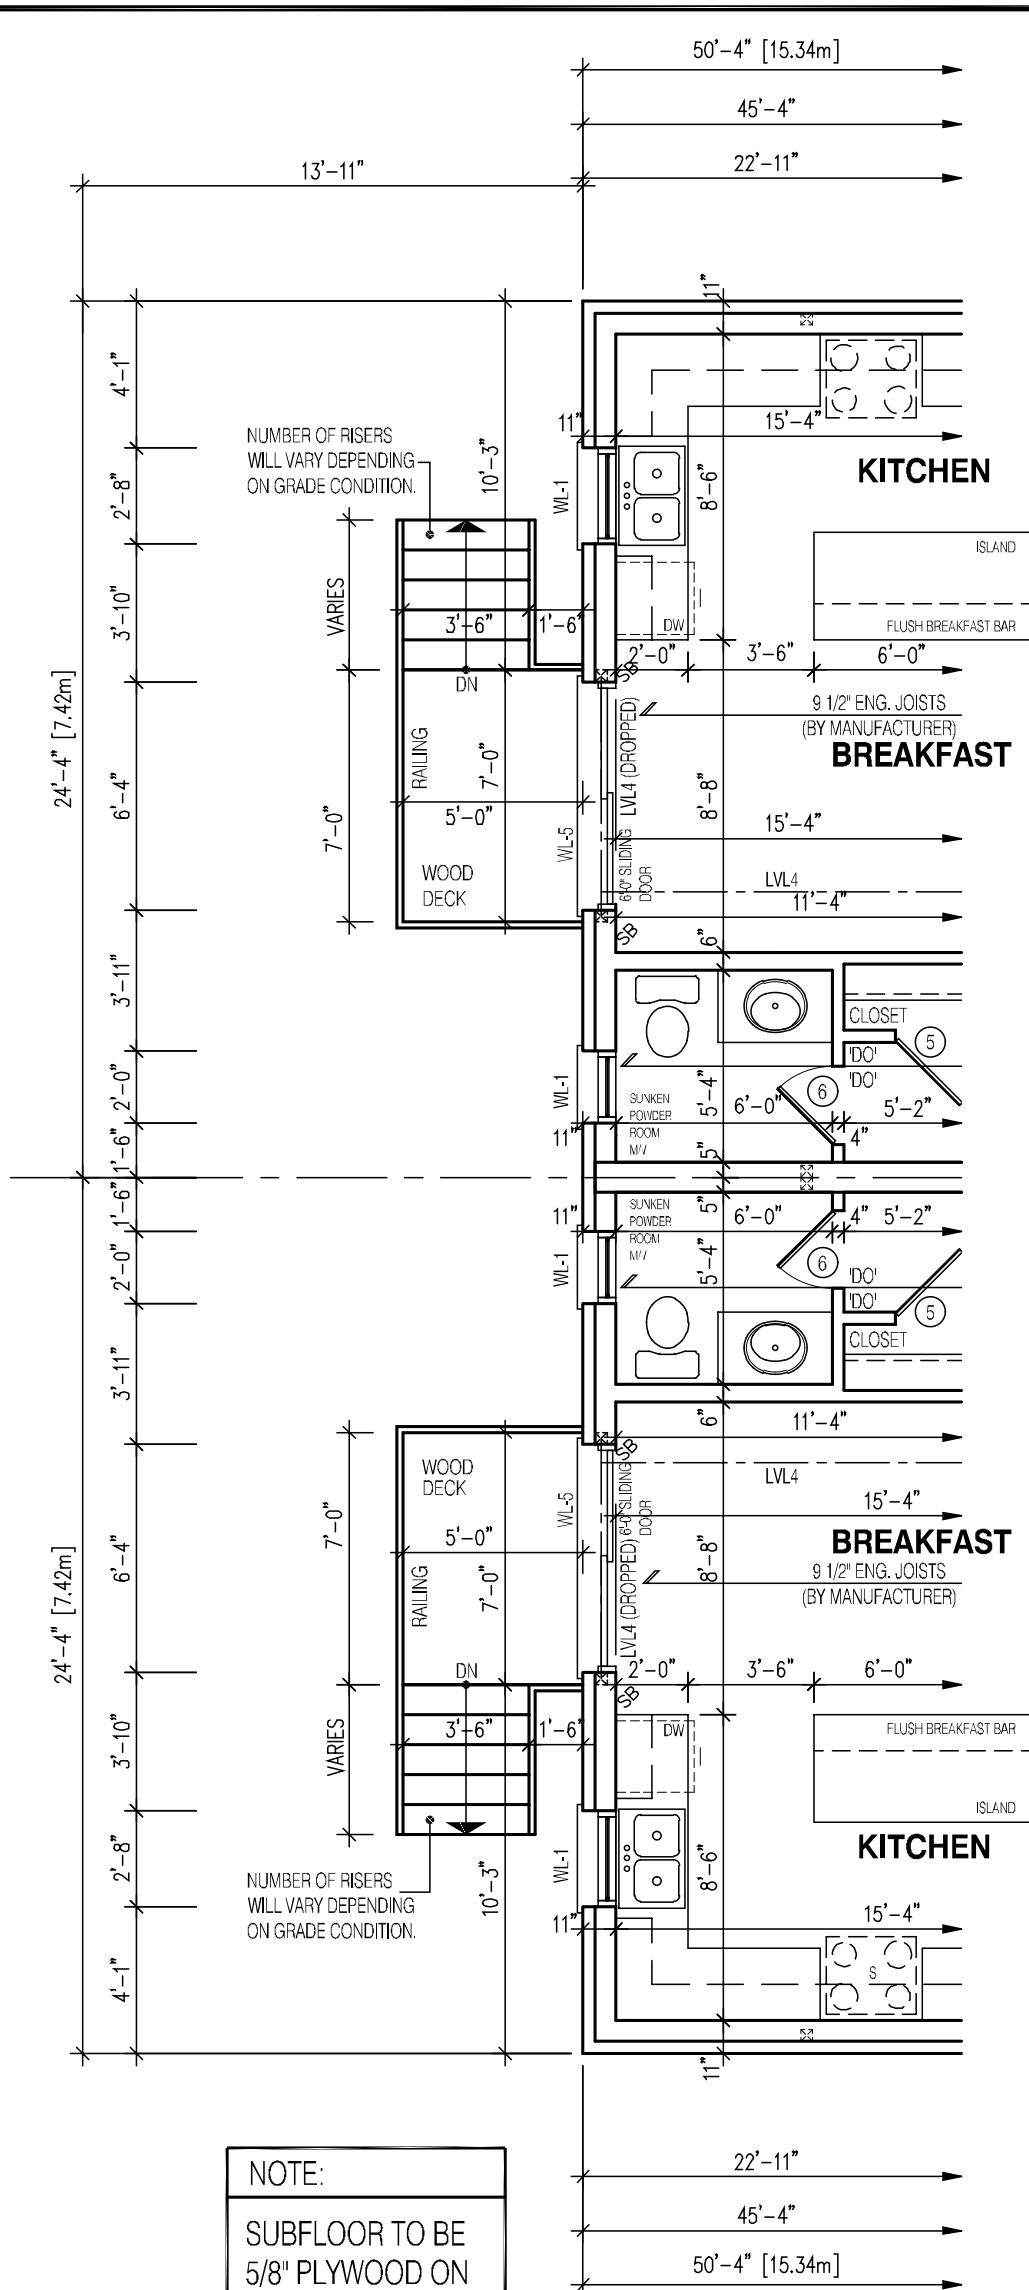

NOTE:
SUBFLOOR TO BE
5/8" PLYWOOD ON
THIS LEVEL
ALL FLOORS TO BE
NAILED AND GLUED
ON THIS LEVEL

- LEGEND:**
- BUILDING FACE < THAN 4'-0" (1.2m)
(45 MIN. FIRE RATING REQ'D)
 - INDICATES SOLID BEARING REQUIRED
OR POINT LOAD FROM ABOVE
 - STL. PLATE FOR STEEL COLN ABOVE
LAMINATED VENEER LUMBER
 - S.J. SINGLE JOIST
 - D.J. DOUBLE JOIST
 - T.J. TRIPLE JOIST
 - REPEAT NOTE
 - SHOWER WEEPERS

NOTE:
REFER TO SHEET NO. 0 - FOR LINTEL, BEAMS
AND DOOR SIZE

NOTE:
THESE DRAWINGS ARE TO BE READ IN
CONJUNCTION WITH ENGINEER APPROVED
ROOF TRUSS DRAWINGS BY MANUFACTURER.

NOTE:
SPACE CONVENTIONAL FLOOR JOISTS @ 12"
O.C. BELOW ALL CERAMIC TILE AREAS.
PROVIDE 1 ROW BRIDGING FOR SPANS OF
5'-7'; 2 ROWS FOR SPANS GREATER THAN 7'

NOTE:
THESE DRAWINGS ARE TO BE READ IN
CONJUNCTION WITH ENGINEER APPROVED
FLOOR TRUSS LAYOUT BY MANUFACTURER.

NOTE:
WHEN VENEER CUT IS
GREATER THAN 26" A 10"
POURED CONC.
FOUNDATION WALL IS
REQUIRED. (FOUNDATION
PLAN TO BE REVIEWED IN
CONJUNCTION WITH SITE
PLAN)

It is the builder's complete responsibility to
ensure that all plans submitted for approval
fully comply with the Architectural Guidelines
and all applicable regulations and requirements
including zoning provisions and any provisions
in the subdivision agreement. The Control
Architect is not responsible in any way for
examining or approving site (lotting) plans or
working drawings with respect to any zoning or
building code or permit matter or that any
house can be properly built or located on its lot.

This is to certify that these plans comply
with the applicable Architectural Design
Guidelines approved by the City of
Markham.

JOHN C. WILLIAMS LTD., ARCHITECT
ARCHITECTURAL CONTROL REVIEW
AND APPROVAL
APPROVED BY: —
DATE: OCT 29, 2020
This stamp certifies compliance with the applicable
Design Guidelines only and bears no further
professional responsibility.

1889/1894
SEMI LOTS

PEYTON 1
ELEVATION 3A & 3B

A1 PACKAGE

O.REG. 332/12

STRUDET INC.

FOR STRUCTURE ONLY

7

6

5

4

3

2

1

JULY 2, 2020

JUNE 25, 2020

JUNE 2, 2020

ISSUED FOR BUILDING PERMIT

ISSUED FOR PRE-COORDINATION STAGE

ISSUED FOR BROCHURE

No: —

DATE: —

WORK DESCRIPTION: —

jardin

DESIGN GROUP INC

64 JARDIN DR. SUITE 3A
VAUGHAN ONT. L4K 3P3
TEL: 905 660-3377 FAX: 905 660-3713
EMAIL: info@jardindesign.ca

The undersigned has reviewed and takes responsibility
for this design and has the qualifications and meets the
requirements set out in the Ontario Building Code to be a
designer

QUALIFICATION INFORMATION

Required unless design is exempt under Division C, Subsection
3.2.5 of the building code

Walter Botter 21031

NAME SIGNATURE BCIN

REGISTRATION INFORMATION

Required unless design is exempt under Division C, Subsection
3.2.4 of the building code

jardin design group inc. 27763

FIRM NAME BCIN

DECK CONDITION EL - 3

LAMPONE INVESTMENTS INC.
CITY OF MARKHAM

MODEL: —
SCALE: 3/16" = 1'-0"
PROJ. No. 20-03
DWG. No. 3B-1




Date: **02/10/21**
**ALL CONSTRUCTION SHALL COMPLY WITH
THE ONTARIO BUILDING CODE**
NO PERSON SHALL CONSTRUCT OR DEMOLISH A BUILDING OR
CAUSE A BUILDING TO BE CONSTRUCTED EXCEPT IN ACCORDANCE
WITH THESE CERTIFIED BUILDING PERMIT DOCUMENTS, THE
BUILDING CODE ACT AND THE BUILDING CODE.
NOTE: THE PROPOSED DEVELOPMENT IS SUBJECT TO COMPLIANCE
WITH ALL APPLICABLE PROVISIONS OF THE ZONING BY-LAW AND
ALL OTHER APPLICABLE LAWS INCLUDING THE PROVISIONS OF A
SITE PLAN AND / OR SUBDIVISION AGREEMENT WHICH MAY OR MAY
NOT BE REGISTERED ON TITLE



FRONT ELEVATION 3A

FRONT ELEVATION 3B

FRONT ELEVATION
PEYTON 1

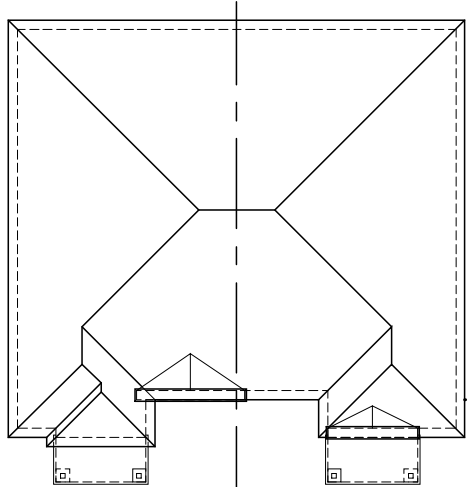

ROOF PLAN
N.T.S.

| PEYTON 1 ELEV.-3A ENERGY EFFICIENCY- A1 PACKAGE | | | |
|---|----------------------|-------------------------|------------|
| ELEVATION | WALL FT ² | OPENING FT ² | PERCENTAGE |
| FRONT | 510.00 | 87.78 | 17.21 % |
| LEFT SIDE | 896.14 | 55.67 | 6.21 % |
| RIGHT SIDE | 896.14 | 0.00 | 0.00 % |
| REAR | 480.00 | 105.00 | 21.88 % |
| TOTAL | 2782.27 | 248.45 | 8.93 % |

| PEYTON 1 ELEV.-3B ENERGY EFFICIENCY- A1 PACKAGE | | | |
|---|----------------------|-------------------------|------------|
| ELEVATION | WALL FT ² | OPENING FT ² | PERCENTAGE |
| FRONT | 508.00 | 85.53 | 16.84 % |
| LEFT SIDE | 894.70 | 0.00 | 0.00 % |
| RIGHT SIDE | 894.70 | 55.67 | 6.22 % |
| REAR | 480.00 | 105.00 | 21.88 % |
| TOTAL | 2777.39 | 246.20 | 8.86 % |

It is the builder's complete responsibility to ensure that all plans submitted for approval fully comply with the Architectural Guidelines and all applicable regulations and requirements including zoning provisions and any provisions in the subdivision agreement. The Control Architect is not responsible in any way for examining or approving site (lotting) plans or working drawings with respect to any zoning or building code or permit matter or that any house can be properly built or located on its lot.

This is to certify that these plans comply with the applicable Architectural Design Guidelines approved by the City of Markham.

JOHN C. WILLIAMS LTD., ARCHITECT
ARCHITECTURAL CONTROL REVIEW
AND APPROVAL
APPROVED BY: [Signature]
DATE: OCT 29, 2020
This stamp certifies compliance with the applicable Design Guidelines only and bears no further professional responsibility.

1904/1895

SEMI LOTS

PEYTON 1
ELEVATION 3A & 3B

A1 PACKAGE

O.REG. 332/12

THE CONTRACTOR SHALL CHECK AND VERIFY ALL DIMENSIONS AND CONDITIONS ON SITE BEFORE PROCEEDING WITH CONSTRUCTION. ANY DISCREPANCIES SHALL BE REPORTED TO JARDIN DESIGN GROUP INC. PRIOR TO COMMENCEMENT OF WORK.
JARDIN DESIGN GROUP INC. IS NOT RESPONSIBLE FOR THE ACCURACY OF SURVEY, STRUCTURAL OR ENGINEERING INFORMATION SHOWN ON THESE DRAWINGS OR FOR CONSTRUCTION STARTED PRIOR TO THE ISSUANCE OF A BUILDING PERMIT. REFER TO THE APPROPRIATE ENGINEERING DRAWINGS BEFORE PROCEEDING WITH WORK.
AS CONSTRUCTED INVENTS MUST BE VERIFIED PRIOR TO POURING FOOTINGS.
JARDIN DESIGN GROUP INC. HAS NOT BEEN RETAINED TO CARRY OUT GENERAL REVIEW OF THE WORK AND ASSUMES NO RESPONSIBILITY FOR THE FAILURE OF THE CONTRACTOR OR SUB CONTRACTOR TO CARRY OUT THE WORK IN ACCORDANCE WITH THE CONTRACT DOCUMENTS.
THIS DRAWING IS AN INSTRUMENT OF SERVICE. IS PROVIDED BY AND IS THE PROPERTY OF JARDIN DESIGN GROUP INC. THIS DRAWING IS NOT TO BE SCALED.

| | |
|---|---|
| 7 | |
| 6 | |
| 5 | |
| 4 | |
| 3 | JULY 2, 2020 ISSUED FOR BUILDING PERMIT |
| 2 | JUNE 25, 2020 ISSUED FOR PRE-COORDINATION STAGE |
| 1 | JUNE 2, 2020 ISSUED FOR BROCHURE |

No: DATE: WORK DESCRIPTION:

jardin
DESIGN GROUP INC
64 JARDIN DR. SUITE 3A
VAUGHAN ONT. L4K 3P3
TEL: 905 660-3377 FAX: 905 660-3713
EMAIL: info@jardindesign.ca

The undersigned has reviewed and takes responsibility for this design and has the qualifications and meets the requirements set out in the Ontario Building Code to be a designer

QUALIFICATION INFORMATION
Required unless design is exempt under Division C, Subsection 3.2.5 of the building code.
[Signature]
Walter Botter 21031

NAME SIGNATURE BCIN

REGISTRATION INFORMATION
Required unless design is exempt under Division C, Subsection 3.2.4 of the building code
jardin design group inc. 27763

FIRM NAME BCIN

FRONT ELEVATION-3

LAMPONE INVESTMENTS INC.
CITY OF MARKHAM



MODEL: T
SCALE: 3/16"=1'-0"
PROJ. No. 20-03
DWG. No. 4B

CITY OF **MARKHAM**

BUILDING STANDARDS DIVISION

REVIEWED FOR COMPLIANCE WITH THE ONTARIO BUILDING
CODE AND THE APPLICABLE ZONING BY-LAW



Date: 02/10/21

**ALL CONSTRUCTION SHALL COMPLY WITH
THE ONTARIO BUILDING CODE**

NO PERSON SHALL CONSTRUCT OR DEMOLISH A BUILDING OR
CAUSE A BUILDING TO BE CONSTRUCTED EXCEPT IN ACCORDANCE
WITH THESE CERTIFIED BUILDING PERMIT DOCUMENTS, THE
BUILDING CODE ACT AND THE BUILDING CODE.


NOTE: THE PROPOSED DEVELOPMENT IS SUBJECT TO COMPLIANCE
WITH ALL APPLICABLE PROVISIONS OF THE ZONING BY-LAW AND
ALL OTHER APPLICABLE LAWS INCLUDING THE PROVISIONS OF A
SITE PLAN AND / OR SUBDIVISION AGREEMENT WHICH MAY OR MAY
NOT BE REGISTERED ON TITLE



FRONT ELEVATION 3A

FRONT ELEVATION 3B

FRONT ELEVATION
PEYTON 1
(FOR LOT 64)

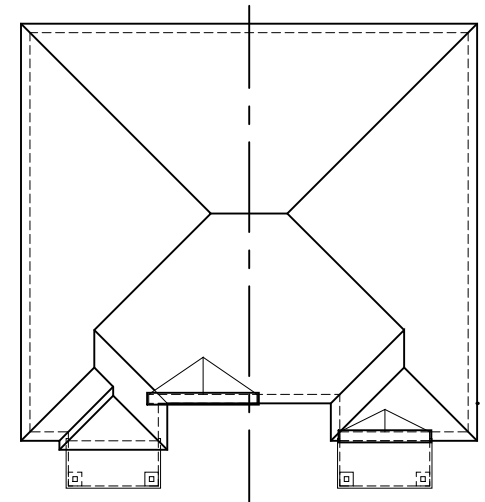

ROOF PLAN
N.T.S.

| PEYTON 1 ELEV.-3A (FOR LOT 64) | | ENERGY EFFICIENCY- A1 PACKAGE | |
|--------------------------------|----------|-------------------------------|------------|
| ELEVATION | WALL FT² | OPENING FT² | PERCENTAGE |
| FRONT | 559.00 | 87.78 | 15.70 % |
| LEFT SIDE | 896.14 | 55.67 | 6.21 % |
| RIGHT SIDE | 896.14 | 0.00 | 0.00 % |
| REAR | 480.00 | 105.00 | 21.88 % |
| TOTAL | 2831.27 | 248.45 | 8.78 % |

| PEYTON 1 ELEV.-3B (FOR LOT 64) | | ENERGY EFFICIENCY- A1 PACKAGE | |
|--------------------------------|----------|-------------------------------|------------|
| ELEVATION | WALL FT² | OPENING FT² | PERCENTAGE |
| FRONT | 556.00 | 85.53 | 15.38 % |
| LEFT SIDE | 894.70 | 0.00 | 0.00 % |
| RIGHT SIDE | 894.70 | 55.67 | 6.22 % |
| REAR | 480.00 | 105.00 | 21.88 % |
| TOTAL | 2825.39 | 246.20 | 8.71 % |

It is the builder's complete responsibility to ensure that all plans submitted for approval fully comply with the Architectural Guidelines and all applicable regulations and requirements including zoning provisions and any provisions in the subdivision agreement. The Control Architect is not responsible in any way for examining or approving site (lotting) plans or working drawings with respect to any zoning or building code or permit matter or that any house can be properly built or located on its lot.

This is to certify that these plans comply with the applicable Architectural Design Guidelines approved by the City of MARKHAM.

JOHN G. WILLIAMS LTD., ARCHITECT
ARCHITECTURAL CONTROL REVIEW
AND APPROVAL

APPROVED BY:
DATE: OCT 29, 2020

This stamp certifies compliance with the applicable Design Guidelines only and bears no further professional responsibility.

1904/1895
SEMI LOTS

PEYTON 1
ELEVATION 3A & 3B

A1 PACKAGE

O.REG. 332/12

THE CONTRACTOR SHALL CHECK AND VERIFY ALL DIMENSIONS AND CONDITIONS ON SITE BEFORE PROCEEDING WITH CONSTRUCTION. ANY DISCREPANCIES SHALL BE REPORTED TO JARDIN DESIGN GROUP INC. PRIOR TO COMMENCEMENT OF WORK.

JARDIN DESIGN GROUP INC. IS NOT RESPONSIBLE FOR THE ACCURACY OF SURVEY, STRUCTURAL OR ENGINEERING INFORMATION SHOWN ON THESE DRAWINGS OR FOR CONSTRUCTION STARTED PRIOR TO THE ISSUANCE OF A BUILDING PERMIT. REFER TO THE APPROPRIATE ENGINEERING DRAWINGS BEFORE PROCEEDING WITH WORK.

AS CONSTRUCTED INVERTS MUST BE VERIFIED PRIOR TO POURING FOOTINGS.

JARDIN DESIGN GROUP INC. HAS NOT BEEN RETAINED TO CARRY OUT GENERAL REVIEW OF THE WORK AND ASSUMES NO RESPONSIBILITY FOR THE FAILURE OF THE CONTRACTOR OR SUB CONTRACTOR TO CARRY OUT THE WORK IN ACCORDANCE WITH THE CONTRACT DOCUMENTS.

THIS DRAWING IS AN INSTRUMENT OF SERVICE, IS PROVIDED BY AND IS THE PROPERTY OF JARDIN DESIGN GROUP INC. THIS DRAWING IS NOT TO BE SCALED.

| | | |
|---|---------------|--|
| 7 | | |
| 6 | | |
| 5 | | |
| 4 | OCT 26, 2020 | ADDED DRAWING TO SET; ISSUED TO CLIENT |
| 3 | JULY 2, 2020 | ISSUED FOR BUILDING PERMIT |
| 2 | JUNE 25, 2020 | ISSUED FOR PRE-COORDINATION STAGE |
| 1 | JUNE 2, 2020 | ISSUED FOR BROCHURE |

No: DATE: WORK DESCRIPTION:

jardin
DESIGN GROUP INC

64 JARDIN DR. SUITE 3A
VAUGHAN ONT. L4K 3P3
TEL: 905 660-3377 FAX: 905 660-3713
EMAIL: info@jardindesign.ca

The undersigned has reviewed and takes responsibility for this design and has the qualifications and meets the requirements set out in the Ontario Building Code to be a designer

QUALIFICATION INFORMATION
Required unless design is exempt under Division C, Subsection 3.2.5 of the building code

Walter Botter 21031
NAME SIGNATURE BCIN

REGISTRATION INFORMATION
Required unless design is exempt under Division C, Subsection 3.2.4 of the building code

jardin design group inc. 27763
FIRM NAME BCIN

FRONT ELEVATION-3

LAMPONE INVESTMENTS INC.
CITY OF MARKHAM

MODEL: T
SCALE: 3/16"=1'-0"
PROJ. No. 20-03
DWG. No. 4B-1




Date: 02/10/21

**ALL CONSTRUCTION SHALL COMPLY WITH
THE ONTARIO BUILDING CODE**

NO PERSON SHALL CONSTRUCT OR DEMOLISH A BUILDING OR CAUSE A BUILDING TO BE CONSTRUCTED EXCEPT IN ACCORDANCE WITH THESE CERTIFIED BUILDING PERMIT DOCUMENTS, THE BUILDING CODE ACT AND THE BUILDING CODE.

NOTE: THE PROPOSED DEVELOPMENT IS SUBJECT TO COMPLIANCE WITH ALL APPLICABLE PROVISIONS OF THE ZONING BY-LAW AND ALL OTHER APPLICABLE LAWS INCLUDING THE PROVISIONS OF A SITE PLAN AND / OR SUBDIVISION AGREEMENT WHICH MAY OR MAY NOT BE REGISTERED ON TITLE

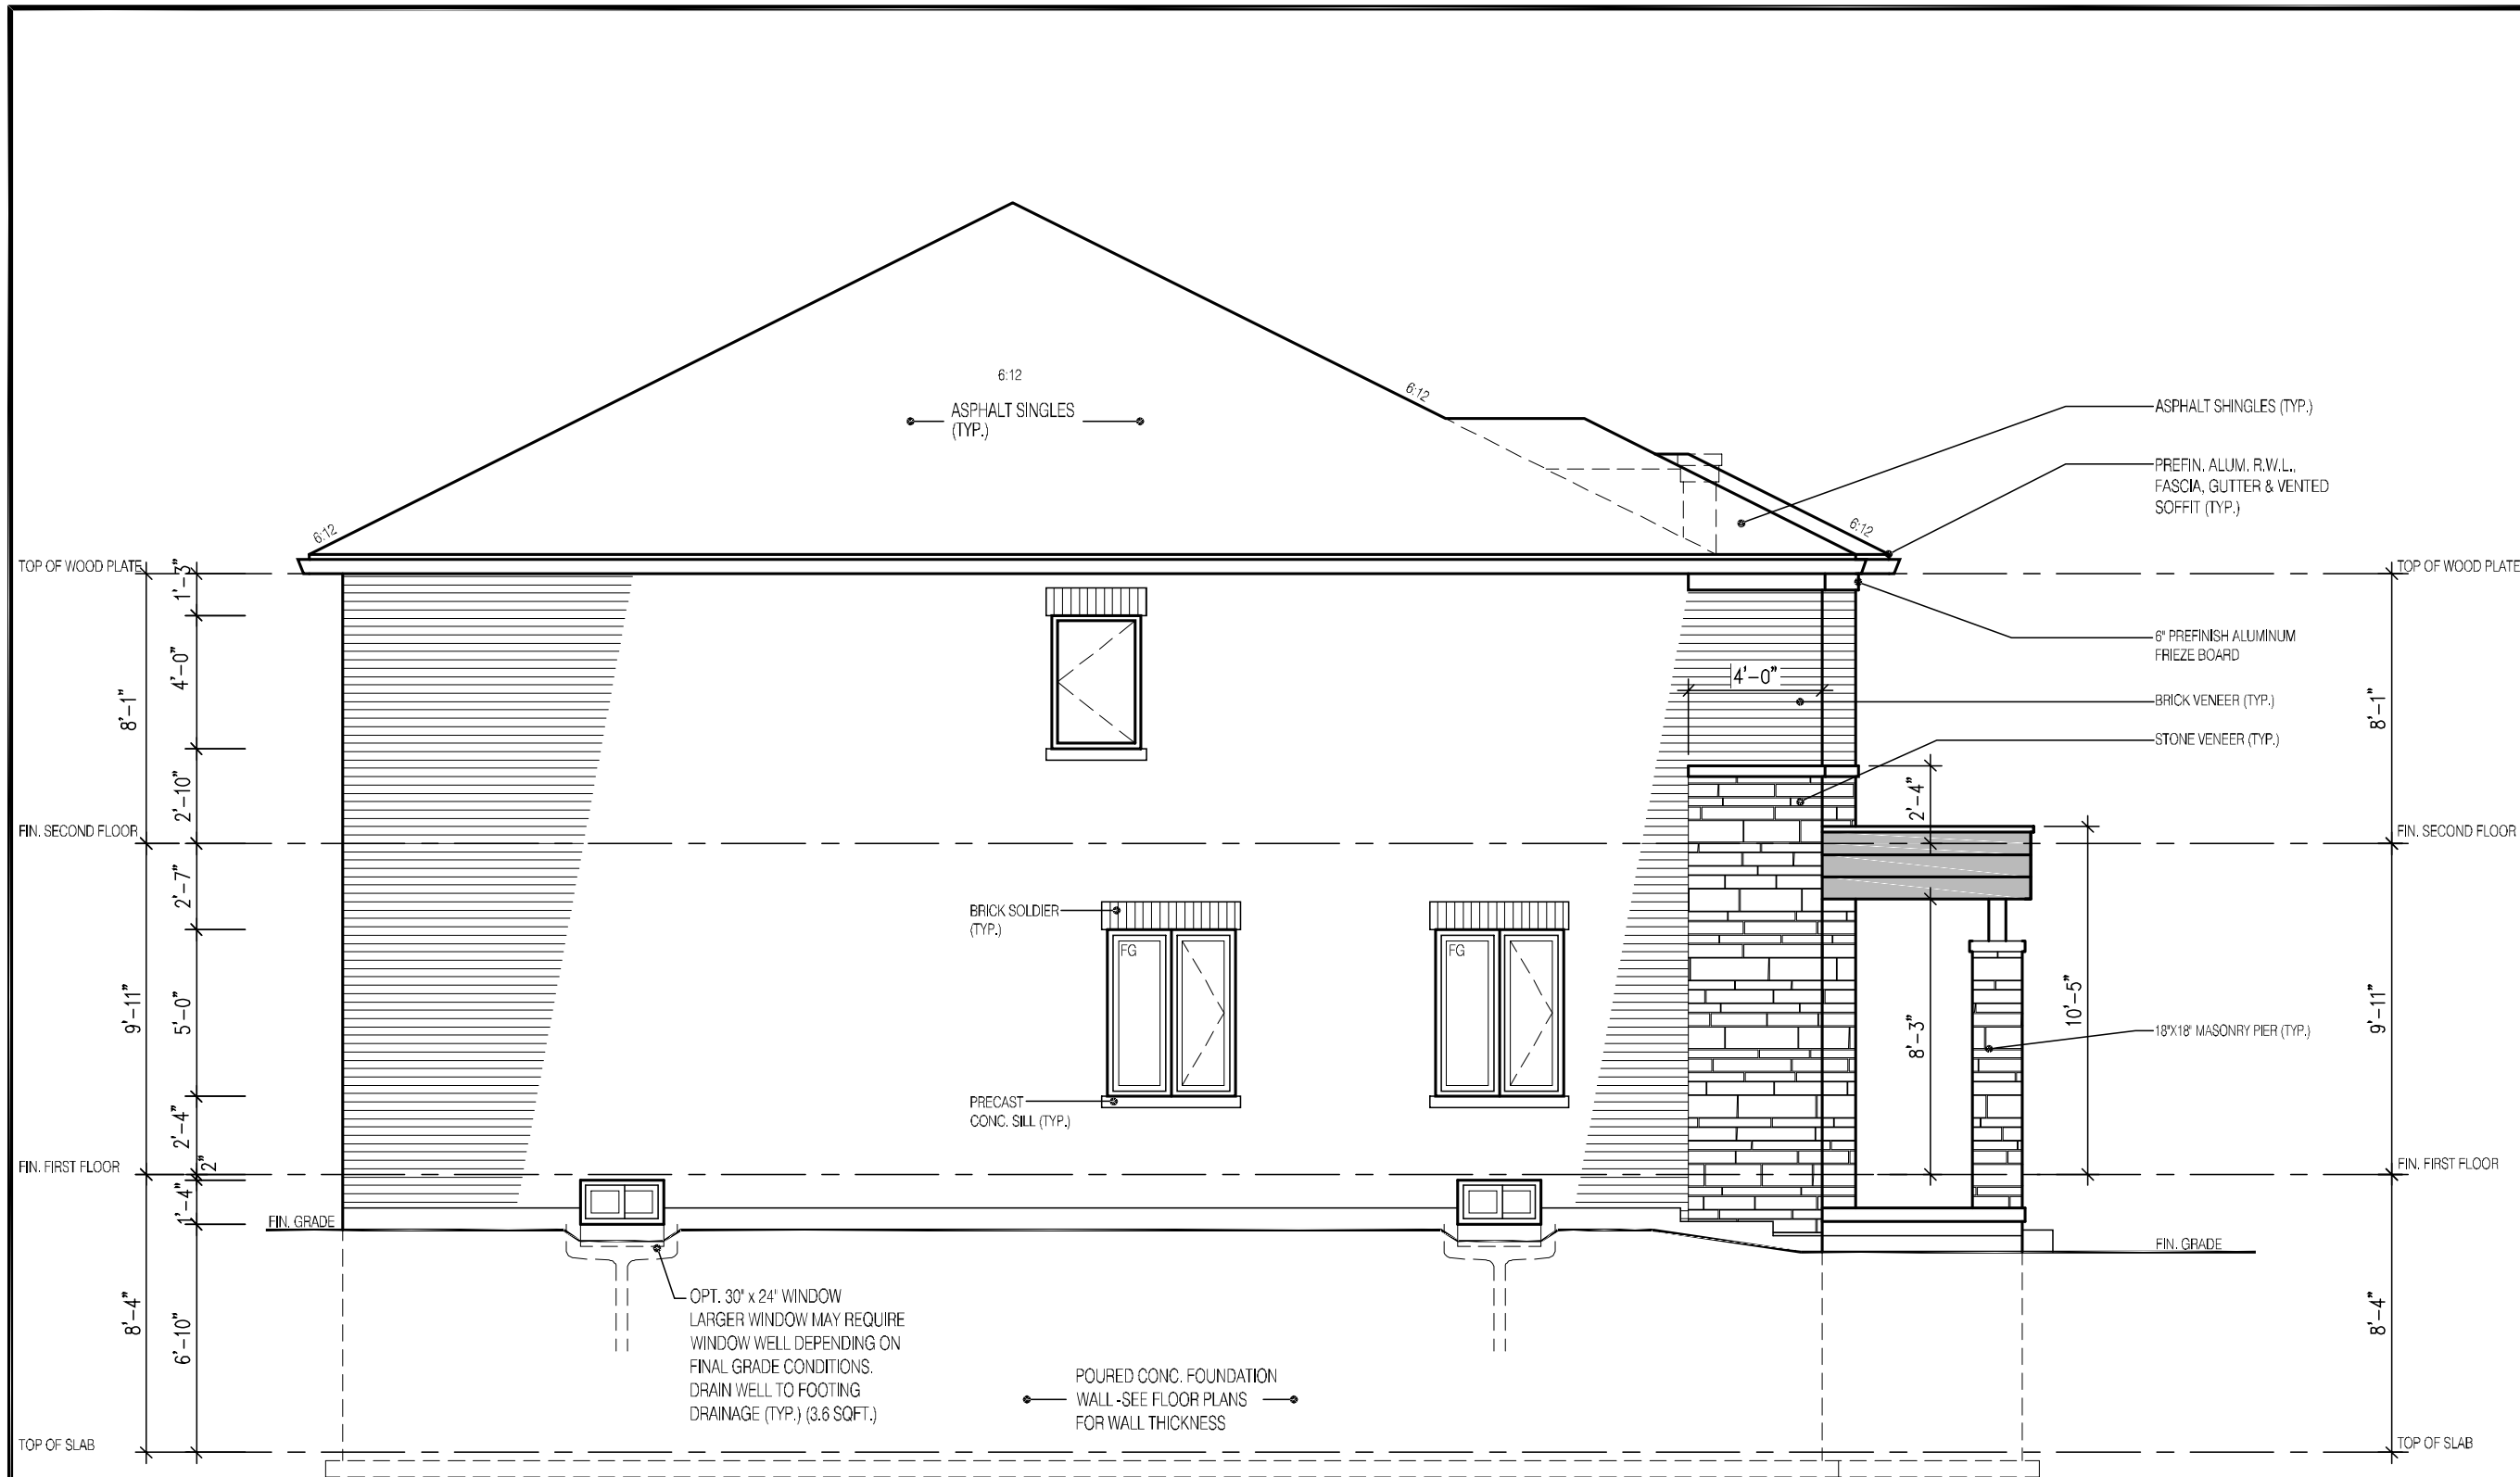

LEFT ELEVATION 3A

SIDE ELEVATION 3
PEYTON 1

UNPROTECTED OPENINGS

| | | |
|---|-------|---|
| WALL AREA | 876 | φ |
| ALLOWABLE WINDOW AREA @ 7.0%(1.2m SIDEYARD) | 61.32 | φ |
| ACTUAL WINDOW AREA | 55.67 | φ |

1904/1895
SEMI LOTS
PEYTON 1
ELEVATION 3A & 3B
A1 PACKAGE
O.REG. 332/12

THE CONTRACTOR SHALL CHECK AND VERIFY ALL DIMENSIONS AND CONDITIONS ON SITE BEFORE PROCEEDING WITH CONSTRUCTION. ANY DISCREPANCIES SHALL BE REPORTED TO JARDIN DESIGN GROUP INC. PRIOR TO COMMENCEMENT OF WORK.
JARDIN DESIGN GROUP INC. IS NOT RESPONSIBLE FOR THE ACCURACY OF SURVEY, STRUCTURAL OR ENGINEERING INFORMATION SHOWN ON THESE DRAWINGS OR FOR CONSTRUCTION STARTED PRIOR TO THE ISSUANCE OF A BUILDING PERMIT. REFER TO THE APPROPRIATE ENGINEERING DRAWINGS BEFORE PROCEEDING WITH WORK.
AS CONSTRUCTED INVERTS MUST BE VERIFIED PRIOR TO POURING FOOTINGS.
JARDIN DESIGN GROUP INC. HAS NOT BEEN RETAINED TO CARRY OUT GENERAL REVIEW OF THE WORK AND ASSUMES NO RESPONSIBILITY FOR THE FAILURE OF THE CONTRACTOR OR SUB CONTRACTOR TO CARRY OUT THE WORK IN ACCORDANCE WITH THE CONTRACT DOCUMENTS.
THIS DRAWING IS AN INSTRUMENT OF SERVICE, IS PROVIDED BY AND IS THE PROPERTY OF JARDIN DESIGN GROUP INC. THIS DRAWING IS NOT TO BE SCALED.

| | | |
|---|---------------|-----------------------------------|
| 7 | | |
| 6 | | |
| 5 | | |
| 4 | | |
| 3 | JULY 2, 2020 | ISSUED FOR BUILDING PERMIT |
| 2 | JUNE 25, 2020 | ISSUED FOR PRE-COORDINATION STAGE |
| 1 | JUNE 2, 2020 | ISSUED FOR BROCHURE |

No: DATE: WORK DESCRIPTION:

jardin
DESIGN GROUP INC
64 JARDIN DR, SUITE 3A
VAUGHAN ONT. L4K 3P3
TEL: 905 660-3377 FAX: 905 660-3713
EMAIL: info@jardindesign.ca

The undersigned has reviewed and takes responsibility for this design and has the qualifications and meets the requirements set out in the Ontario Building Code to be a designer

QUALIFICATION INFORMATION
Required unless design is exempt under Division C, Subsection 3.2.5 of the building code
Walter Botter
NAME SIGNATURE 21031 BCIN

REGISTRATION INFORMATION
Required unless design is exempt under Division C, Subsection 3.2.4 of the building code
jardin design group inc. 27763
FIRM NAME BCIN

SIDE ELEVATION-3
LAMPONE INVESTMENTS INC.
CITY OF MARKHAM

MODEL: T
SCALE: 3/16"=1'-0"
PROJ. No. 20-03
DWG. No. 5B

It is the builder's complete responsibility to ensure that all plans submitted for approval fully comply with the Architectural Guidelines and all applicable regulations and requirements including zoning provisions and any provisions in the subdivision agreement. The Control Architect is not responsible in any way for examining or approving site (lotting) plans or working drawings with respect to any zoning or building code or permit matter or that any house can be properly built or located on its lot.

This is to certify that these plans comply with the applicable Architectural Design Guidelines approved by the City of Markham

APPROVED BY: *[Signature]*
DATE: OCT 29, 2020
This stamp certifies compliance with the applicable Design Guidelines only and bears no further professional responsibility.

CITY OF **MARKHAM**
BUILDING STANDARDS DIVISION
REVIEWED FOR COMPLIANCE WITH THE ONTARIO BUILDING CODE AND THE APPLICABLE ZONING BY-LAW




Date: 02/10/21

ALL CONSTRUCTION SHALL COMPLY WITH THE ONTARIO BUILDING CODE

NO PERSON SHALL CONSTRUCT OR DEMOLISH A BUILDING OR CAUSE A BUILDING TO BE CONSTRUCTED EXCEPT IN ACCORDANCE WITH THESE CERTIFIED BUILDING PERMIT DOCUMENTS, THE BUILDING CODE ACT AND THE BUILDING CODE.

NOTE: THE PROPOSED DEVELOPMENT IS SUBJECT TO COMPLIANCE WITH ALL APPLICABLE PROVISIONS OF THE ZONING BY-LAW AND ALL OTHER APPLICABLE LAWS INCLUDING THE PROVISIONS OF A SITE PLAN AND / OR SUBDIVISION AGREEMENT WHICH MAY OR MAY NOT BE REGISTERED ON TITLE

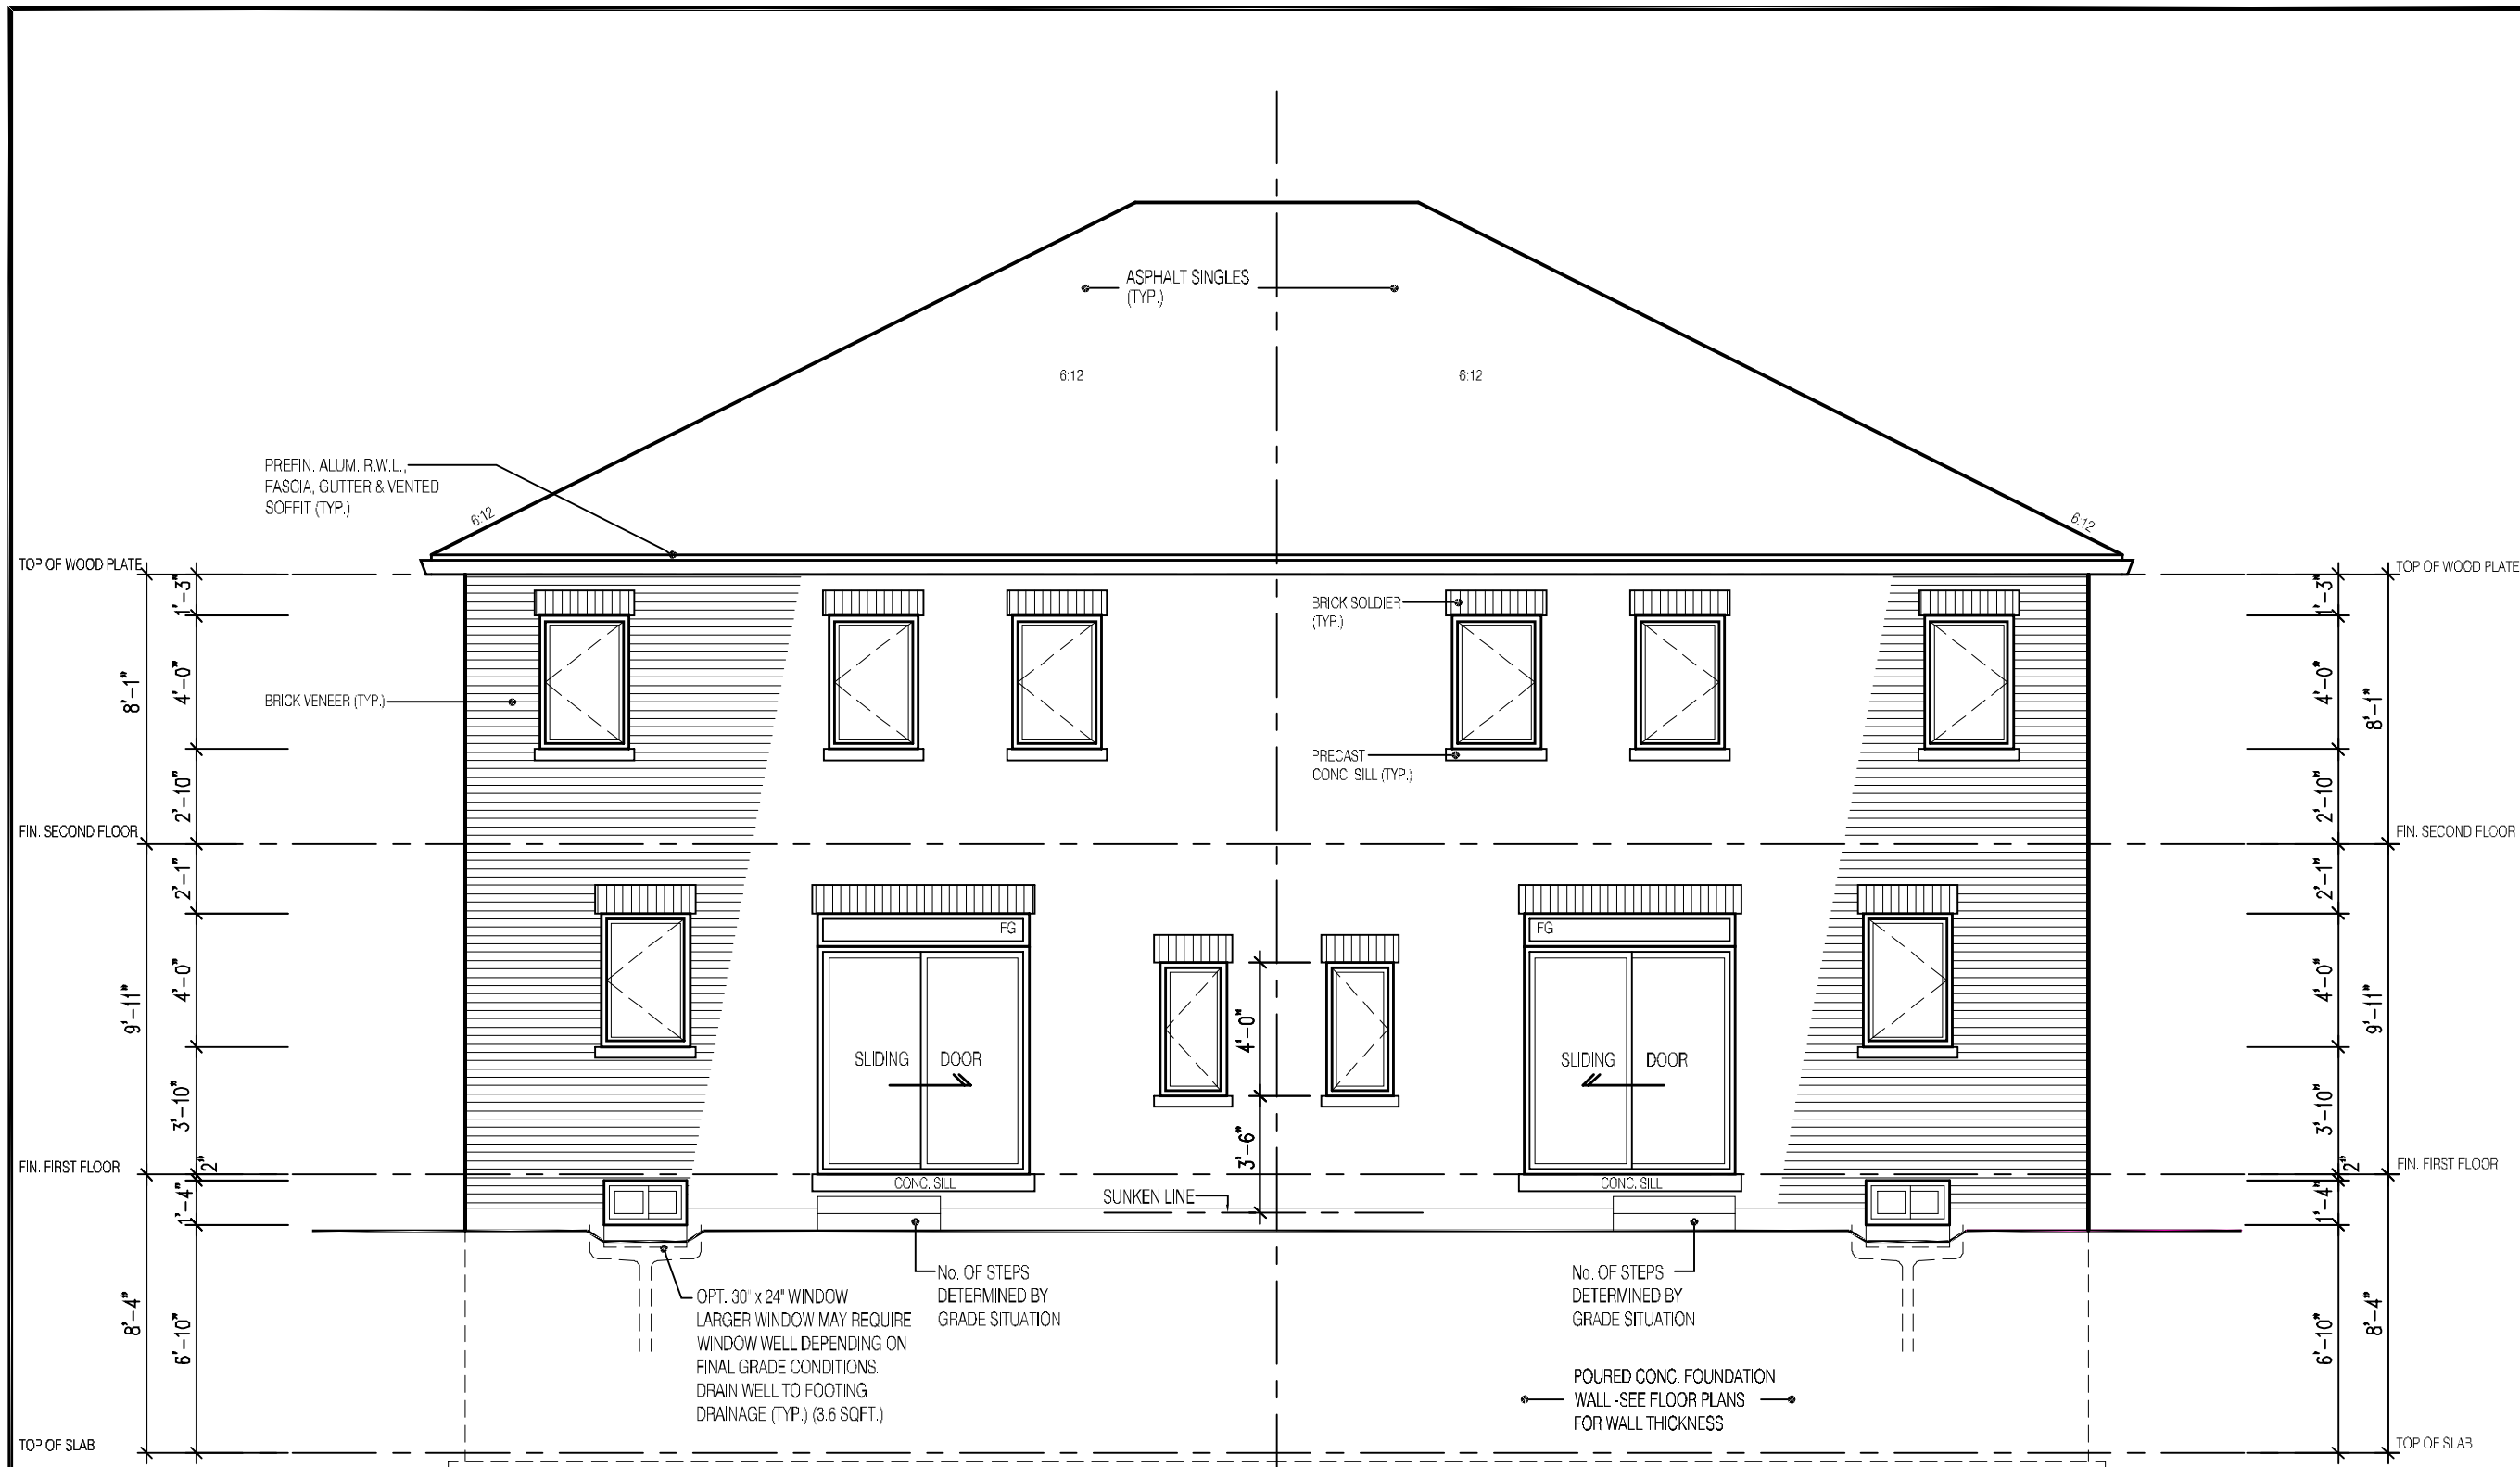

REAR ELEVATION 3B

REAR ELEVATION 3A

REAR ELEVATION 3
PEYTON 1

1904/1895
SEMI LOTS
PEYTON 1
ELEVATION 3A & 3B
A1 PACKAGE
O.REG. 332/12

THE CONTRACTOR SHALL CHECK AND VERIFY ALL DIMENSIONS AND CONDITIONS ON SITE BEFORE PROCEEDING WITH CONSTRUCTION. ANY DISCREPANCIES SHALL BE REPORTED TO JARDIN DESIGN GROUP INC. PRIOR TO COMMENCEMENT OF WORK.
JARDIN DESIGN GROUP INC. IS NOT RESPONSIBLE FOR THE ACCURACY OF SURVEY, STRUCTURAL OR ENGINEERING INFORMATION SHOWN ON THESE DRAWINGS OR FOR CONSTRUCTION STARTED PRIOR TO THE ISSUANCE OF A BUILDING PERMIT. REFERENCE TO THE APPROPRIATE EXISTING DRAWINGS AND/OR PROCEEDINGS WILL WORK.
AS CONSTRUCTED INVENTS MUST BE VERIFIED PRIOR TO POURING FOOTINGS.
JARDIN DESIGN GROUP INC. HAS NOT BEEN RETAINED TO CARRY OUT GENERAL REVIEW OF THE WORK AND ASSUMES NO RESPONSIBILITY FOR THE FAILURE OF THE CONTRACTOR OR SUB CONTRACTOR TO CARRY OUT THE WORK IN ACCORDANCE WITH THE CONTRACT DOCUMENTS.
THIS DRAWING IS AN INSTRUMENT OF SERVICE IS PROVIDED BY AND IS THE PROPERTY OF JARDIN DESIGN GROUP INC. THIS DRAWING IS NOT TO BE REPRODUCED.

| | | |
|---|---------------|-----------------------------------|
| 7 | | |
| 6 | | |
| 5 | | |
| 4 | | |
| 3 | JULY 2, 2020 | ISSUED FOR BUILDING PERMIT |
| 2 | JUNE 25, 2020 | ISSUED FOR PRE-COORDINATION STAGE |
| 1 | JUNE 2, 2020 | ISSUED FOR BROCHURE |

No: DATE: WORK DESCRIPTION:

jardin
DESIGN GROUP INC
64 JARDIN DR. SUITE 3A
VAUGHAN ONT. L4K 3P3
TEL: 905 660-3377 FAX: 905 660-3713
EMAIL: info@jardindesign.ca

The undersigned has reviewed and takes responsibility for this design and has the qualifications and meets the requirements set out in the Ontario Building Code to be a designer.

Walter Botter 21031
NAME SIGNATURE BCIN

REGISTRATION INFORMATION
Required unless design is exempt under Division C, Subsection 3.2.4 of the building code.
jardin design group inc. 27763
FIRM NAME BCIN

REAR ELEVATION-3
LAMPONE INVESTMENTS INC.
CITY OF MARKHAM

MODEL: T
SCALE: 3/16" = 1'-0"
PROJ. No: 20-03
DWG. No: 6B

It is the builder's complete responsibility to ensure that all plans submitted for approval fully comply with the Architectural Guidelines and all applicable regulations and requirements including zoning provisions and any provisions in the subdivision agreement. The Control Architect is not responsible in any way for examining or approving site (lotting) plans or working drawings with respect to any zoning or building code or permit matter or that any house can be properly built or located on its lot.

This is to certify that these plans comply with the applicable Architectural Design Guidelines approved by the City of Markham.

APPROVED BY: [Signature]
DATE: OCT 29, 2020
This stamp certifies compliance with the applicable Design Guidelines only and bears no further professional responsibility.

CITY OF MARKHAM
BUILDING STANDARDS DIVISION
REVIEWED FOR COMPLIANCE WITH THE ONTARIO BUILDING CODE AND THE APPLICABLE ZONING BY-LAW



Date: 02/10/21

ALL CONSTRUCTION SHALL COMPLY WITH THE ONTARIO BUILDING CODE

NO PERSON SHALL CONSTRUCT OR DEMOLISH A BUILDING OR CAUSE A BUILDING TO BE CONSTRUCTED EXCEPT IN ACCORDANCE WITH THESE CERTIFIED BUILDING PERMIT DOCUMENTS, THE BUILDING CODE ACT AND THE BUILDING CODE.

NOTE: THE PROPOSED DEVELOPMENT IS SUBJECT TO COMPLIANCE WITH ALL APPLICABLE PROVISIONS OF THE ZONING BY-LAW AND ALL OTHER APPLICABLE LAWS INCLUDING THE PROVISIONS OF A SITE PLAN AND / OR SUBDIVISION AGREEMENT WHICH MAY OR MAY NOT BE REGISTERED ON TITLE



REAR ELEVATION 3B

REAR ELEVATION 3A

REAR ELEVATION 3
DECK CONDITION

FOR ADDITIONAL DECK STRUCTURE
REFER TO PAGE 7 OF THE DETAIL PACKAGE

NOTE:
**WHEN VENEER CUT IS GREATER THAN
26" A 10" POURED CONC. FOUNDATION
WALL IS REQUIRED.
(FOUNDATION PLAN TO BE REVIEWED
IN CONJUNCTION WITH SITE PLAN)**

1889/1894
SEMI LOTS
PEYTON 1
ELEVATION 3A & 3B
A1 PACKAGE
O.REG. 332/12

CITY OF **MARKHAM**
BUILDING STANDARDS DIVISION
REVIEWED FOR COMPLIANCE WITH THE ONTARIO BUILDING
CODE AND THE APPLICABLE ZONING BY-LAW



Date: **02/10/21**
**ALL CONSTRUCTION SHALL COMPLY WITH
THE ONTARIO BUILDING CODE**
NO PERSON SHALL CONSTRUCT OR DEMOLISH A BUILDING OR
CAUSE A BUILDING TO BE CONSTRUCTED EXCEPT IN ACCORDANCE
WITH THESE CERTIFIED BUILDING PERMIT DOCUMENTS, THE
BUILDING CODE ACT AND THE BUILDING CODE.
NOTE: THE PROPOSED DEVELOPMENT IS SUBJECT TO COMPLIANCE
WITH ALL APPLICABLE PROVISIONS OF THE ZONING BY-LAW AND
ALL OTHER APPLICABLE LAWS INCLUDING THE PROVISIONS OF A
SITE PLAN AND / OR SUBDIVISION AGREEMENT WHICH MAY OR MAY
NOT BE REGISTERED ON TITLE

THE CONTRACTOR SHALL CHECK AND VERIFY ALL DIMENSIONS AND
CONDITIONS ON SITE BEFORE PROCEEDING WITH CONSTRUCTION.
ANY DISCREPANCIES SHALL BE REPORTED TO JARDIN DESIGN GROUP
INC. PRIOR TO COMMENCEMENT OF WORK.
JARDIN DESIGN GROUP INC. IS NOT RESPONSIBLE FOR THE ACCURACY
OF SURVEY, STRUCTURAL OR ENGINEERING INFORMATION SHOWN ON
THESE DRAWINGS OR FOR CONSTRUCTION STARTED PRIOR TO THE
ISSUANCE OF A BUILDING PERMIT. REFERENCE TO THE APPROPRIATE
ENGINEERING DRAWINGS AND/OR PROCEEDINGS SHALL BE MADE.
AS CONSTRUCTED, INVENTS MUST BE VERIFIED PRIOR TO POURING
FOOTINGS.
JARDIN DESIGN GROUP INC. HAS NOT BEEN RETAINED TO CARRY OUT
GENERAL REVIEW OF THE WORK AND ASSUMES NO RESPONSIBILITY
FOR THE FAILURE OF THE CONTRACTOR OR SUB CONTRACTOR TO
CARRY OUT THE WORK IN ACCORDANCE WITH THE CONTRACT
DOCUMENTS.
THIS DRAWING IS AN INSTRUMENT OF SERVICE, IS PROVIDED BY AND IS
THE PROPERTY OF JARDIN DESIGN GROUP INC. THIS DRAWING IS NOT
TO BE REPRODUCED.

| | | |
|---|---------------|--------------------------------------|
| 7 | | |
| 6 | | |
| 5 | | |
| 4 | | |
| 3 | JULY 2, 2020 | ISSUED FOR BUILDING PERMIT |
| 2 | JUNE 25, 2020 | ISSUED FOR PRE-COORDINATION STAGE |
| 1 | JUNE 2, 2020 | ISSUED FOR BROCHURE |

No: DATE: WORK DESCRIPTION:

jardin
DESIGN GROUP INC
64 JARDIN DR. SUITE 3A
VAUGHAN ONT. L4K 3P3
TEL: 905 660-3377 FAX: 905 660-3713
EMAIL: info@jardindesign.ca

The undersigned has reviewed and takes responsibility
for this design and has the qualifications and meets the
requirements set out in the Ontario Building Code to be
a designer

QUALIFICATION INFORMATION
Required unless design is exempt under Division C, Subsection
3.2.5 of the building code
Walter Botter 21031

NAME SIGNATURE BCIN

REGISTRATION INFORMATION
Required unless design is exempt under Division C, Subsection
3.2.4 of the building code

jardin design group inc. 27763
FIRM NAME BCIN


DECK CONDITION EL - 3

LAMPONE INVESTMENTS INC.
CITY OF MARKHAM

MODEL: T
SCALE: 3/16" = 1'-0"
PROJ. No: 20-03
DWG. No: 6B-1

It is the builder's complete responsibility to
ensure that all plans submitted for approval
fully comply with the Architectural Guidelines
and all applicable regulations and requirements
including zoning provisions and any provisions
in the subdivision agreement. The Control
Architect is not responsible in any way for
examining or approving site (lotting) plans or
working drawings with respect to any zoning or
building code or permit matter or that any
house can be properly built or located on its lot.

This is to certify that these plans comply
with the applicable Architectural Design
Guidelines approved by the City of
Markham.
JOHN C. WILLIAMS LTD., ARCHITECT
ARCHITECTURAL CONTROL REVIEW
AND APPROVAL
APPROVED BY: [Signature]
DATE: OCT 29, 2020
This stamp certifies compliance with the applicable
Design Guidelines only and bears no further
professional responsibility.

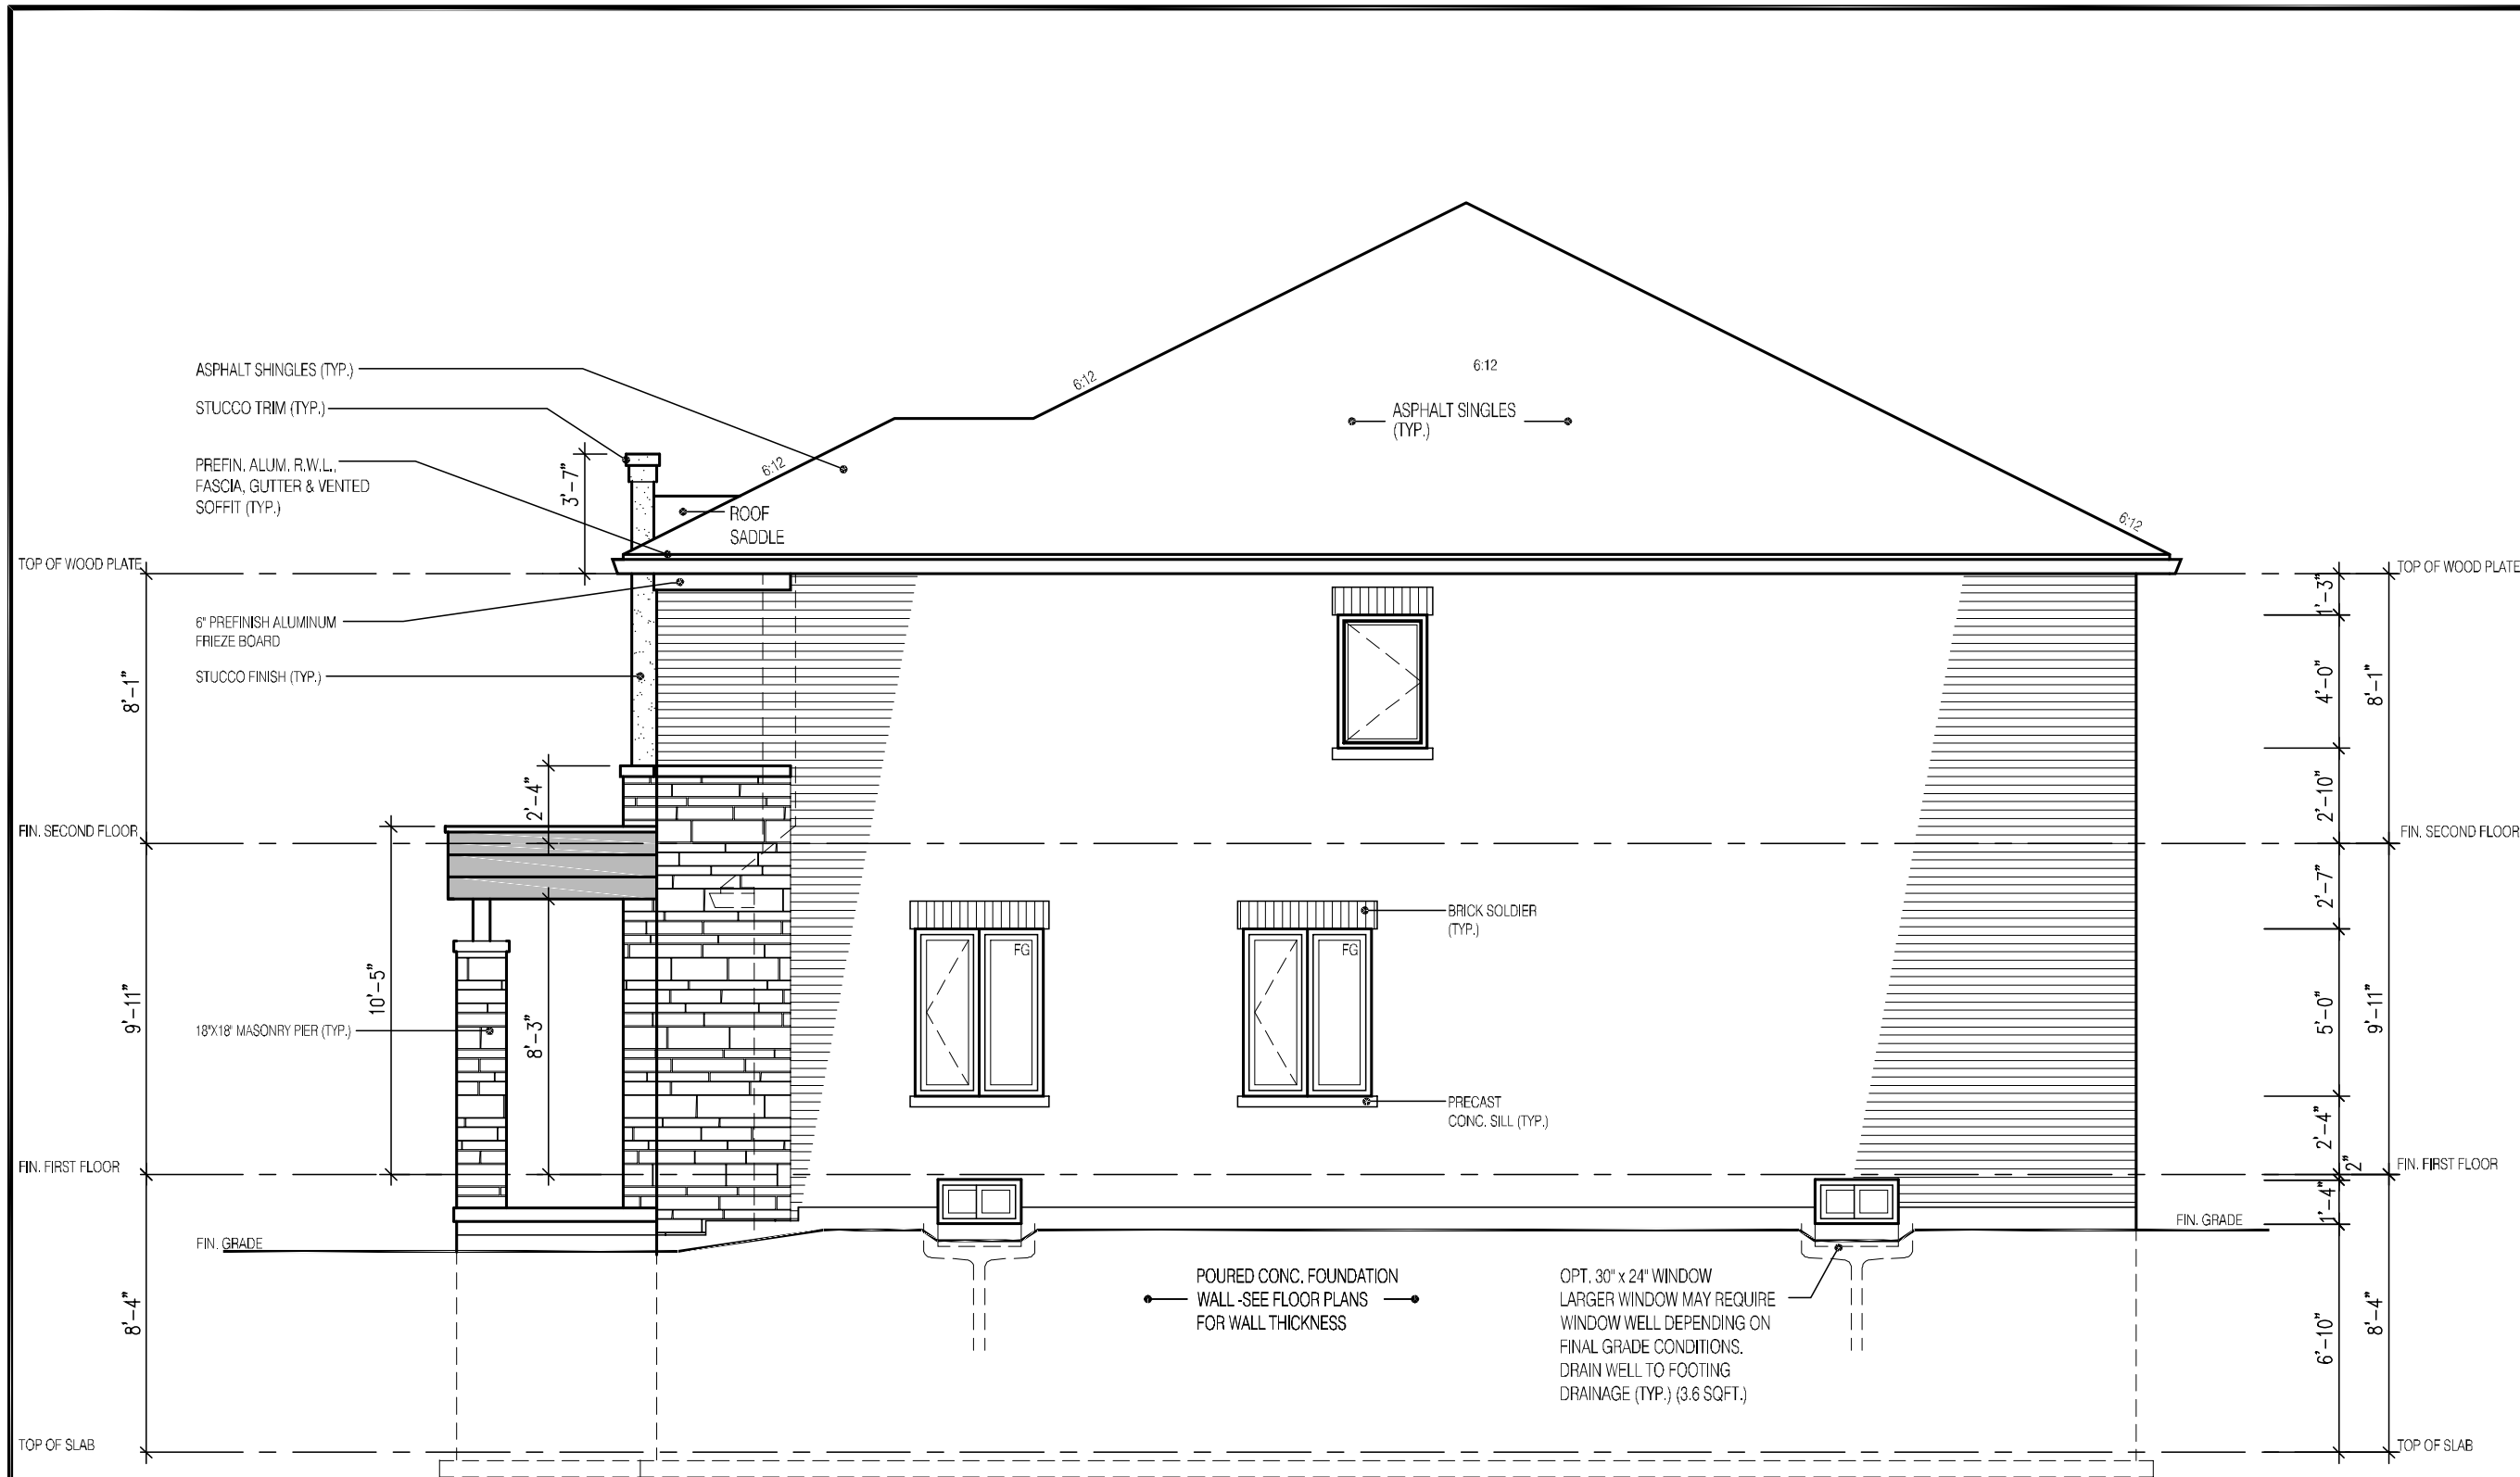

RIGHT ELEVATION 3B

SIDE ELEVATION 3
PEYTON 1

UNPROTECTED OPENINGS

| | | |
|---|-------|---|
| WALL AREA | 876 | φ |
| ALLOWABLE WINDOW AREA @ 7.0%(1.2m SIDEYARD) | 61.32 | φ |
| ACTUAL WINDOW AREA | 55.67 | φ |

It is the builder's complete responsibility to ensure that all plans submitted for approval fully comply with the Architectural Guidelines and all applicable regulations and requirements including zoning provisions and any provisions in the subdivision agreement. The Control Architect is not responsible in any way for examining or approving site (lotting) plans or working drawings with respect to any zoning or building code or permit matter or that any house can be properly built or located on its lot.

This is to certify that these plans comply with the applicable Architectural Design Guidelines approved by the City of Markham.

JOHN C. WILLIAMS LTD., ARCHITECT
ARCHITECTURAL CONTROL REVIEW
AND APPROVAL

APPROVED BY: [Signature]
DATE: OCT 29, 2020

This stamp certifies compliance with the applicable Design Guidelines only and bears no further professional responsibility.

1904/1895
SEMI LOTS
PEYTON 1
ELEVATION 3A & 3B
A1 PACKAGE
O.REG. 332/12

THE CONTRACTOR SHALL CHECK AND VERIFY ALL DIMENSIONS AND CONDITIONS ON SITE BEFORE PROCEEDING WITH CONSTRUCTION. ANY DISCREPANCIES SHALL BE REPORTED TO JARDIN DESIGN GROUP INC. PRIOR TO COMMENCEMENT OF WORK.

JARDIN DESIGN GROUP INC. IS NOT RESPONSIBLE FOR THE ACCURACY OF SURVEY, STRUCTURAL OR ENGINEERING INFORMATION SHOWN ON THESE DRAWINGS OR FOR CONSTRUCTION STARTED PRIOR TO THE ISSUANCE OF A BUILDING PERMIT. REFER TO THE APPROPRIATE ENGINEERING DRAWINGS BEFORE PROCEEDING WITH WORK.

AS CONSTRUCTED INVERTS MUST BE VERIFIED PRIOR TO POURING FOOTINGS.

JARDIN DESIGN GROUP INC. HAS NOT BEEN RETAINED TO CARRY OUT GENERAL REVIEW OF THE WORK AND ASSUMES NO RESPONSIBILITY FOR THE FAILURE OF THE CONTRACTOR OR SUB CONTRACTOR TO CARRY OUT THE WORK IN ACCORDANCE WITH THE CONTRACT DOCUMENTS.

THIS DRAWING IS AN INSTRUMENT OF SERVICE. IT IS PROVIDED BY AND IS THE PROPERTY OF JARDIN DESIGN GROUP INC. THIS DRAWING IS NOT TO BE SCALED.

| | | |
|---|---------------|-----------------------------------|
| 7 | | |
| 6 | | |
| 5 | | |
| 4 | | |
| 3 | JULY 2, 2020 | ISSUED FOR BUILDING PERMIT |
| 2 | JUNE 25, 2020 | ISSUED FOR PRE-COORDINATION STAGE |
| 1 | JUNE 2, 2020 | ISSUED FOR BROCHURE |

No: DATE: WORK DESCRIPTION:

jardin
DESIGN GROUP INC
64 JARDIN DR. SUITE 3A
VAUGHAN ONT. L4K 3P3
TEL: 905 660-3377 FAX: 905 660-3713
EMAIL: info@jardindesign.ca

The undersigned has reviewed and takes responsibility for this design and has the qualifications and meets the requirements set out in the Ontario Building Code to be a designer

QUALIFICATION INFORMATION
Required unless design is exempt under Division C, Subsection 3.2.5 of the building code

Walter Botter 21031
NAME SIGNATURE BCIN

REGISTRATION INFORMATION
Required unless design is exempt under Division C, Subsection 3.2.4 of the building code

jardin design group inc. 27763
FIRM NAME BCIN

SIDE ELEVATION-3
LAMPONE INVESTMENTS INC.
CITY OF MARKHAM

MODEL: T
SCALE: 3/16"=1'-0"
PROJ. No. 20-03
DWG. No. 7B


CITY OF MARKHAM
BUILDING STANDARDS DIVISION
REVIEWED FOR COMPLIANCE WITH THE ONTARIO BUILDING CODE AND THE APPLICABLE ZONING BY-LAW



Date: 02/10/21
ALL CONSTRUCTION SHALL COMPLY WITH THE ONTARIO BUILDING CODE

NO PERSON SHALL CONSTRUCT OR DEMOLISH A BUILDING OR CAUSE A BUILDING TO BE CONSTRUCTED EXCEPT IN ACCORDANCE WITH THESE CERTIFIED BUILDING PERMIT DOCUMENTS, THE BUILDING CODE ACT AND THE BUILDING CODE.

NOTE: THE PROPOSED DEVELOPMENT IS SUBJECT TO COMPLIANCE WITH ALL APPLICABLE PROVISIONS OF THE ZONING BY-LAW AND ALL OTHER APPLICABLE LAWS INCLUDING THE PROVISIONS OF A SITE PLAN AND / OR SUBDIVISION AGREEMENT WHICH MAY OR MAY NOT BE REGISTERED ON TITLE

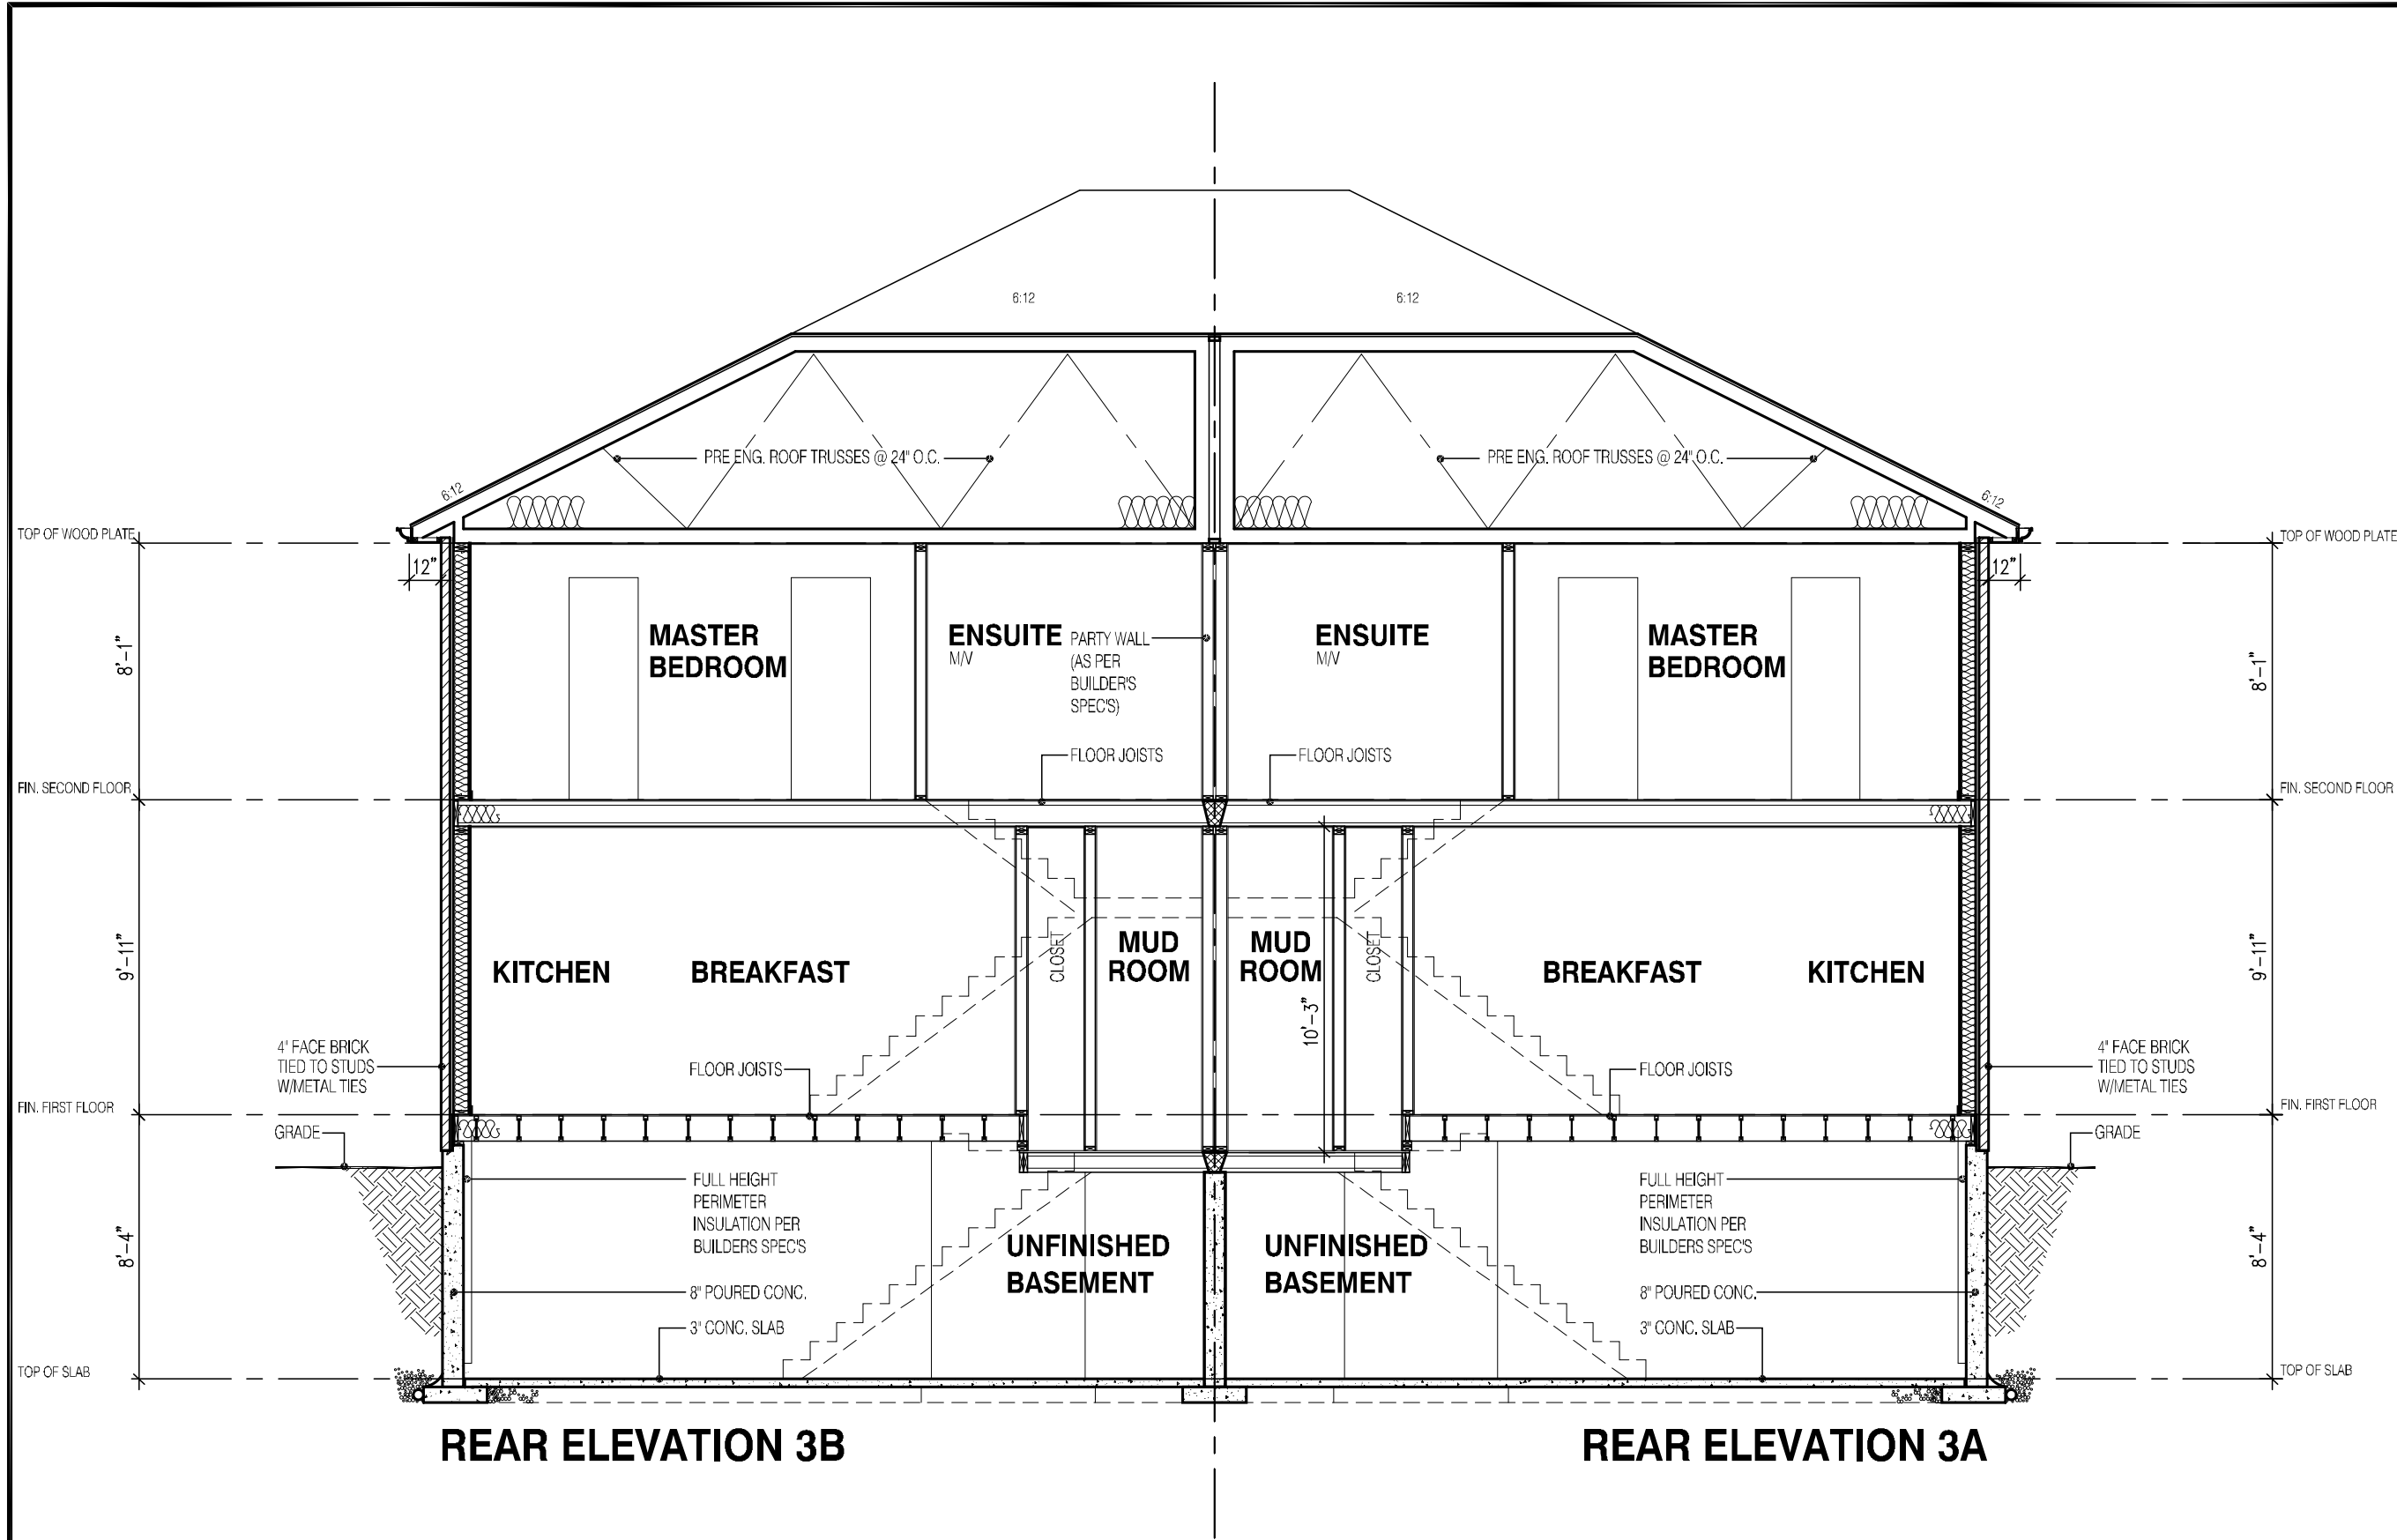

SECTION ELEVATION 3

1889/1894

SEMI LOTS

PEYTON 1

ELEVATION 3A & 3B

A1 PACKAGE

O.REG. 332/12

STRUDET INC.

REGISTERED PROFESSIONAL DESIGNER

B. MARINKOVIC

21031

PROVINCE OF ONTARIO

FOR STRUCTURE ONLY

THE CONTRACTOR SHALL CHECK AND VERIFY ALL DIMENSIONS AND CONDITIONS ON SITE BEFORE PROCEEDING WITH CONSTRUCTION. ANY DISCREPANCIES SHALL BE REPORTED TO JARDIN DESIGN GROUP INC. PRIOR TO COMMENCEMENT OF WORK.

JARDIN DESIGN GROUP INC. IS NOT RESPONSIBLE FOR THE ACCURACY OF SURVEY, STRUCTURAL OR ENGINEERING INFORMATION SHOWN ON THESE DRAWINGS OR FOR CONSTRUCTION STARTED PRIOR TO THE ISSUANCE OF A BUILDING PERMIT. REFER TO THE APPROPRIATE ENGINEERING DRAWINGS BEFORE PROCEEDING WITH WORK.

AS CONSTRUCTED INVENTS MUST BE VERIFIED PRIOR TO POURING FOOTINGS.

JARDIN DESIGN GROUP INC. HAS NOT BEEN RETAINED TO CARRY OUT GENERAL REVIEW OF THE WORK AND ASSUMES NO RESPONSIBILITY FOR THE FAILURE OF THE CONTRACTOR OR SUB CONTRACTOR TO CARRY OUT THE WORK IN ACCORDANCE WITH THE CONTRACT DOCUMENTS.

THIS DRAWING IS AN INSTRUMENT OF SERVICE, IS PROVIDED BY AND IS THE PROPERTY OF JARDIN DESIGN GROUP INC. THIS DRAWING IS NOT TO BE SCALED.

| | |
|---|---|
| 7 | |
| 6 | |
| 5 | |
| 4 | |
| 3 | JULY 2, 2020 ISSUED FOR BUILDING PERMIT |
| 2 | JUNE 25, 2020 ISSUED FOR PRE-COORDINATION STAGE |
| 1 | JUNE 2, 2020 ISSUED FOR BROCHURE |

No: DATE: WORK DESCRIPTION:

jardin

DESIGN GROUP INC

64 JARDIN DR. SUITE 3A

VAUGHAN ONT. L4K 3P3

TEL: 905 660-3377 FAX: 905 660-3713

EMAIL: info@jardindesign.ca

The undersigned has reviewed and takes responsibility for this design and has the qualifications and meets the requirements set out in the Ontario Building Code to be a designer

QUALIFICATION INFORMATION
Required unless design is exempt under Division C, Subsection 3.2.5 of the building code

Walter Botter

21031

NAME SIGNATURE BCIN

REGISTRATION INFORMATION
Required unless design is exempt under Division C, Subsection 3.2.4 of the building code

jardin design group inc.

27763

FIRM NAME BCIN

SECTION (ELEVATION 3)

LAMPONE INVESTMENTS INC.

CITY OF MARKHAM

MODEL: T

SCALE: 3/16"=1'-0"

PROJ. No. 20-03

DWG. No. 8B

CITY OF **MARKHAM**
BUILDING STANDARDS DIVISION
REVIEWED FOR COMPLIANCE WITH THE ONTARIO BUILDING
CODE AND THE APPLICABLE ZONING BY-LAW

Date: **02/10/21**
**ALL CONSTRUCTION SHALL COMPLY WITH
THE ONTARIO BUILDING CODE**
NO PERSON SHALL CONSTRUCT OR DEMOLISH A BUILDING OR
CAUSE A BUILDING TO BE CONSTRUCTED EXCEPT IN ACCORDANCE
WITH THESE CERTIFIED BUILDING PERMIT DOCUMENTS, THE
BUILDING CODE ACT AND THE BUILDING CODE.
NOTE: THE PROPOSED DEVELOPMENT IS SUBJECT TO COMPLIANCE
WITH ALL APPLICABLE PROVISIONS OF THE ZONING BY-LAW AND
ALL OTHER APPLICABLE LAWS INCLUDING THE PROVISIONS OF A
SITE PLAN AND / OR SUBDIVISION AGREEMENT WHICH MAY OR MAY
NOT BE REGISTERED ON TITLE

It is the builder's complete responsibility to ensure that all plans submitted for approval fully comply with the Architectural Guidelines and all applicable regulations and requirements including zoning provisions and any provisions in the subdivision agreement. The Control Architect is not responsible in any way for examining or approving site (lotting) plans or working drawings with respect to any zoning or building code or permit matter or that any house can be properly built or located on its lot.

This is to certify that these plans comply with the applicable Architectural Design Guidelines approved by the City of MARKHAM.