

--- STORM CONNECTION

--- SANITARY CONNECTION

W- WATER CONNECTION

H- HYDRO CONNECTION

DOUBLE CATCH BASIN

CATCH BASIN

HYDRANT

VALVE AND CHAMBER

△ ENTRANCE DOOR LOCATION

▲ GARAGE DOOR LOCATION

\* ENGINEERED FILL LOT

● SANITARY MANHOLE

○ STORM MANHOLE

MAIL COMMUNITY MAILBOX

○ DOWNSPOUT LOCATION

SWALE DIRECTION

● STREET LIGHT

▲ TRANSFORMER

⊠ CABLE TV PEDESTAL

■ BELL PEDESTAL

FG BELL/ROG. FLUSH TO GRADE

HYDRO METER

◇ GAS METER

⊠ AIR-CONDITIONING UNIT

SP SUMP PUMP

F.FLR. FINISHED FLOOR ELEVATION

T/WALL TOP OF FOUNDATION WALL

F.SLAB FIN. BASEMENT FLOOR SLAB

U/FTG. UNDERSIDE FOOTING ELEVATION

PROPOSED 3:1 SLOPE

PROPOSED GRADE

100.00 SW

PROPOSED SWALE GRADE

NORTH

CITY OF **MARKHAM**

BUILDING STANDARDS DIVISION


REVIEWED FOR COMPLIANCE WITH THE APPLICABLE ZONING BY-LAW



21.111026.000.00.RP

Issue Date: 04/09/21

NOTE: THESE PLANS ARE TO BE READ IN CONJUNCTION WITH THE PREVIOUSLY APPROVED CERTIFIED MODEL(S). IT IS THE BUILDERS RESPONSIBILITY TO HAVE CERTIFIED MODEL(S) DRAWINGS READILY AVAILABLE FOR INSPECTOR'S REFERENCE ON THE CONSTRUCTION SITE.

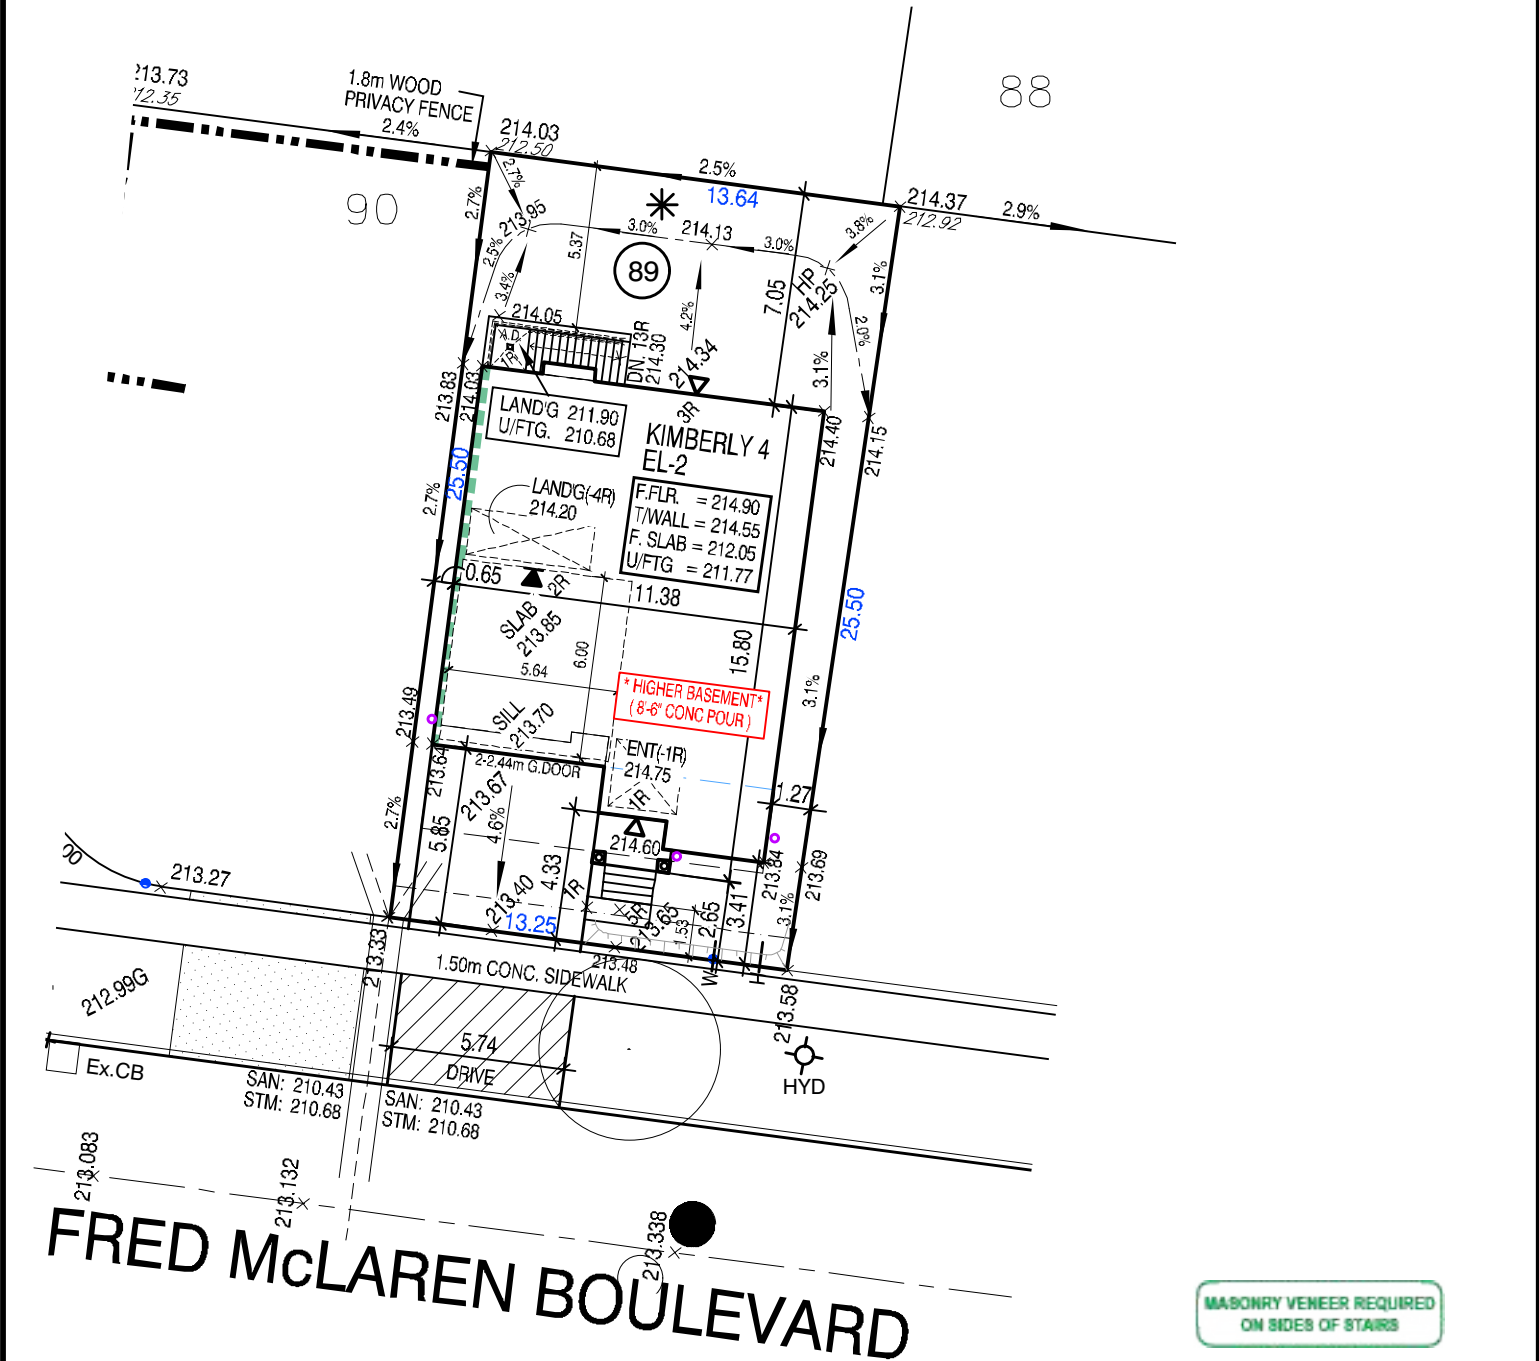

5

4

3

2

SEPT. 29, 2020

REV. AS PER ENGINEERS COMMENTS & ISSUED FOR PERMIT.

1

SEPT. 23, 2020

ISSUED FOR CLIENTS/ENGINEERS GRADING REVIEW.

REVISIONS:

SCALE 1:250

5m

0m

5m

10m

LAMPONE INVESTMENTS INC.

PROJ. No. 20-03

LOT No. 89

MUNICIPAL ADDRESS

FRED McLAREN BOULEVARD

THE CONTRACTOR SHALL CHECK AND VERIFY ALL DIMENSIONS AND CONDITIONS ON SITE BEFORE PROCEEDING WITH CONSTRUCTION. ANY DISCREPANCIES SHALL BE REPORTED TO JARDIN DESIGN GROUP INC. PRIOR TO COMMENCEMENT OF WORK. JARDIN DESIGN GROUP INC. IS NOT RESPONSIBLE FOR THE ACCURACY OF SURVEY STRUCTURAL OR ENGINEERING INFORMATION SHOWN ON THESE DRAWINGS OR FOR CONSTRUCTION STARTED PRIOR TO THE ISSUANCE OF A BUILDING PERMIT. REFER TO THE APPROPRIATE ENGINEERING DRAWINGS BEFORE PROCEEDING WITH WORK.

Walter Botte

21031

NAME

SIGNATURE

BCIN

REGISTRATION INFORMATION

Required unless design is exempt under Division C, Subsection 3.2.3 of the building code.

jardin design group inc.

27763

FIRM NAME

BCIN

64 JARDIN DR. SUITE 3A

VAUGHAN ONT. L4K 3P3

TEL: 905 660-3377 FAX: 905 660-3713

EMAIL: info@jardindesign.ca

THE UNDERSIGNED HAS REVIEWED AND TAKES RESPONSIBILITY FOR THIS DESIGN AND HAS THE QUALIFICATIONS AND MEETS THE REQUIREMENTS SET OUT IN THE ONTARIO BUILDING CODE TO BE A DESIGNER. QUALIFICATION INFORMATION Required unless design is exempt under Division C, Subsection 3.2.3 of the building code.

John G. Williams Ltd., Architect

ARCHITECTURAL CONTROL REVIEW AND APPROVAL

APPROVED BY: [Signature]

DATE: FEB 22, 2021

This stamp certifies compliance with the applicable Design Guidelines only and bears no further professional responsibility.

It is the builder's complete responsibility to ensure that all plans submitted for approval fully comply with the Architectural Guidelines and all applicable regulations and requirements including zoning provisions and any provisions in the subdivision agreement. The Control Architect is not responsible in any way for examining or approving site (lotting) plans or working drawings with respect to any zoning or building code or permit matter or that any house can be properly built or located on its lot.

FOR LOTS: TOWN OF MARKHAM

I, AVI SHWARTZ OAA, MRAIC of JOHN G. WILLIAMS LIMITED, ARCHITECT certify that the plans/drawings comply with the applicable architectural control guidelines approved by the Town of Markham and on file with the Design Group, Development Services Commission.