

CONSTRUCTION SUMMARY

Mountainview Heights 3 (G) - Russell Gardens Building Ltd.

PURCHASERS: Neil SURI and Kirstin Ellen SURI

TEL: RES.: 905-890-1010 BUS.: 416-573-3254

LOT / PHASE 367 / 4	REG. PLAN # 62M-1266	HOUSE TYPE Mountainash Five (4 Bedroom) Elev 1		
------------------------	-------------------------	---------------------------------------------------	--	--

CONSTRUCTION

1 - MASTER BEDROOM- CLOSET MADE SMALLER-SEE SKETCH 27May21 Note:	
---------------------------------------------------------------------	--

MIRRORS AND GLASS

1 - FRAMELESS GLASS SHOWER DOOR FOR 5 FOOT PAN - INCLUDES CHROME KNOB & HINGES 27May21 Note: Masked Ensuite:	
-----------------------------------------------------------------------------------------------------------------	--

PLUMBING

1 - MASTER ENSUITE- ENLARGE SHOWER TO A 5FT SHOWER-SEE SKETCH 27May21 Note:	
--------------------------------------------------------------------------------	--

PROMOTIONAL

1 - LESS CREDIT FROM PURCHASER EXTRA SHEET IN OFFER 27May21 Note: NEW PROMO BALANCE \$5650.00	
--------------------------------------------------------------------------------------------------	--

EXTRAS AS PER OFFER

PURCHASER(S) ACKNOWLEDGES THAT THE PURCHASE PRICE IS INCLUSIVE OF ALL CREDITS AND PROMOTIONAL PACKAGES AVAILABLE AT TIME OF PURCHASE. Worksheet Note:	
The Vendor agrees that notwithstanding any other term or provision in this Agreement included in the Purchase Price and in addition to those items detailed in Schedule GP to the Agreement of Purchase and Sale, the Purchaser is entitled to a credit of Ten Worksheet Note:	
Granite kitchen counter top, from Vendor's standard samples Worksheet Note:	

This Document is Extremely Time Sensitive - Printed 28 May 21 at 9:12

CONSTRUCTION SUMMARY

PRELIMINARY: DATE JUN 23 2021


FINAL: DATE

LOT 367  
RUSSELL GARDENS  
PHASE 4  
MOUNTAINVIEW HEIGHTS

MOUNTAINASH 5  
ELEV. 1

REVISIONS:

1. REVISE SHOWER TO 60"X36" SIZE AND REDUCE CLOSET ACCORDINGLY.

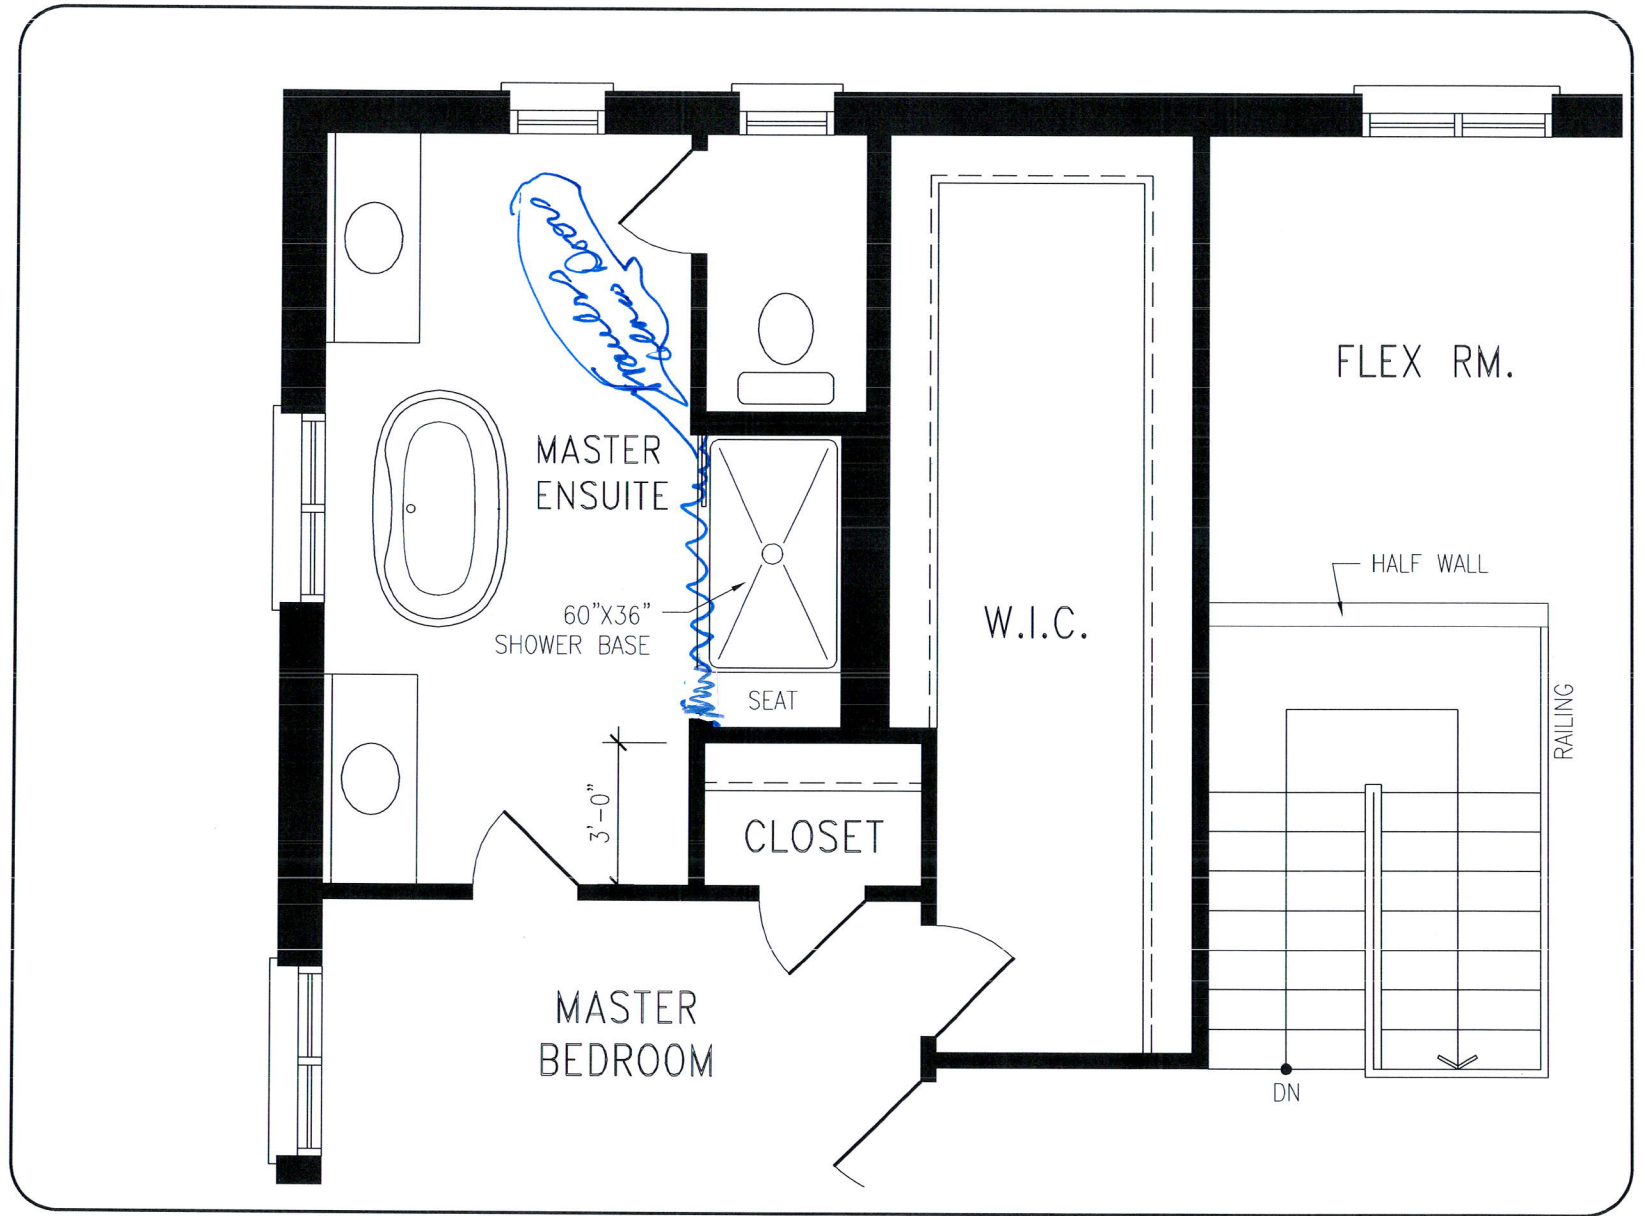

UPPER LEVEL

DISCLAIMERS: SKETCH NOT TO SCALE. DIMENSIONS, SPECIFICATIONS AND ARCHITECTURAL DETAILS SUBJECT TO MODIFICATION BY THE VENDOR. SKETCH IS ONLY FOR THE PURPOSE OF ILLUSTRATING REVISIONS REQUESTED BY THE PURCHASER AND ALL REVISIONS ARE SUBJECT TO VENDOR'S FINAL APPROVAL. ONLY REVISIONS ACCEPTED IN WRITING BY THE PURCHASER AND VENDOR ON A PURCHASER'S EXTRA SHEET WILL BE INCORPORATED INTO THE PLANS FILED WITH THE MUNICIPALITY. E. & O.E.

REGION  
DESIGN  
INC.

SCALE  
N.T.S.  
BY MB  
PAGE No.  
1 OF 1

Greenpark™