



CONSTRUCTION SUMMARY

Mountainview Heights 3 (G) - Russell Gardens Building Ltd.

PURCHASERS: Vipin RAMAWAT and Krishna RAMAWAT

TEL:

LOT / PHASE 401 / 4	REG. PLAN # 62M-1266	HOUSE TYPE Mountainash Five (4 Bedroom) Elev 1		
------------------------	-------------------------	---	--	--

CONSTRUCTION

1 - FLEX ROOM - DELETE WALL AND EXTEND AS PER SKETCH 25May21 Note:	
1 - MASTER ENSUITE WALK IN CLOSET- REDESIGNED TO 9 FT BY 5 FT. 25May21 Note:	
2 - ENLARGE BASEMENT WINDOWS (MAY REQUIRE WINDOW WELLS) - WINDOW IS 30 INCHES X 24 INCHES 25May21 Note:	

ELECTRICAL

1 - 200 AMP ELECTRICAL SERVICE 25May21 Note:	
---	--

PLUMBING

3 - TOE TESTER - ADD TOE TESTER TO SHOWER S * 25May21 Note:	
1 - KITCHEN- SHIFT BAR SINK TO END OF COUNTERTOP- SEE SKETCH 25May21 Note:	
1 - ADD IN ENS. 3/4 -A 5 FOOT SHOWER WITH SLIDING GLASS CHROME DOORS IN LIEU OF TUB 25May21 Note:	

PROMOTIONAL

1 - LESS CREDIT FROM PURCHASER EXTRA SHEET IN OFFER 25May21 Note: NEW PROMO BALANCE \$4290.00	
--	--

EXTRAS AS PER OFFER

(1) The Vendor agrees that notwithstanding any other term or provision in this Agreement included in the Purchase Price and in addition to those items detailed in Schedule GP to the Agreement of Purchase and Sale, the Purchaser is entitled to a credit of Worksheet Note:	
Granite kitchen counter top, from Vendor?s standard samples Worksheet Note:	
PURCHASER(S) ACKNOWLEDGES THAT THE PURCHASE PRICE IS INCLUSIVE OF ALL CREDITS AND PROMOTIONAL PACKAGES AVAILABLE AT TIME OF PURCHASE. Worksheet Note:	

This Document is Extremely Time Sensitive - Printed 27 May 21 at 8:39

CONSTRUCTION SUMMARY

PRELIMINARY: DATE JUN 25 2021


FINAL: DATE

LOT 401  
RUSSELL GARDENS  
PHASE 4  
MOUNTAINVIEW HEIGHTS

MOUNTAINASH 5  
ELEV. 1

REVISIONS:  
  
1. EXTEND FLEX ROOM INTO  
MASTER WALK IN CLOSET,  
REDUCING CLOSET SIZE

*VR*  
*Q*

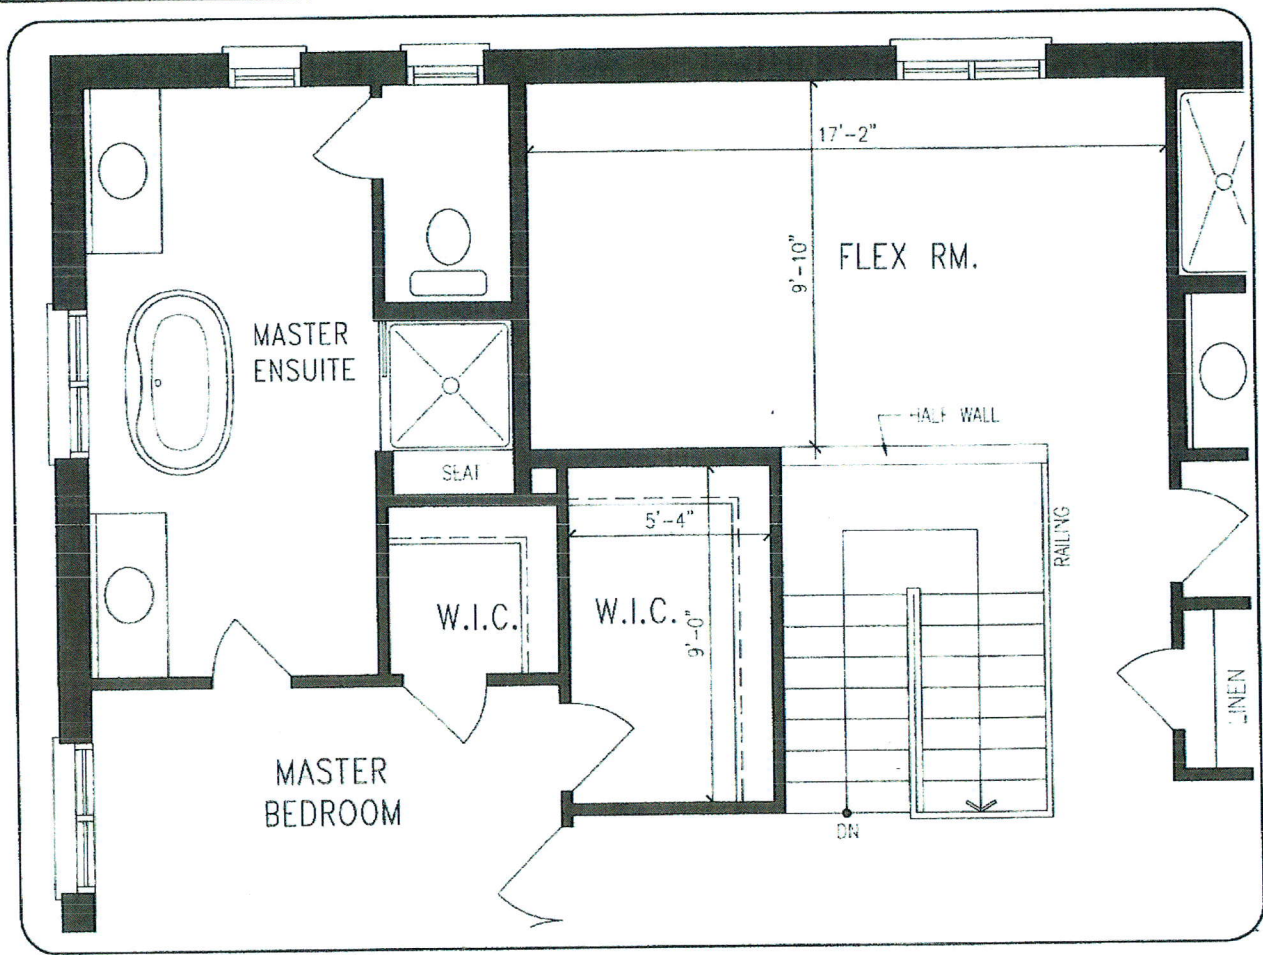

UPPER LEVEL

DISCLAIMERS: SKETCH NOT TO SCALE. DIMENSIONS, SPECIFICATIONS AND ARCHITECTURAL DETAILS SUBJECT TO MODIFICATION BY THE VENDOR. SKETCH IS ONLY FOR THE PURPOSE OF ILLUSTRATING REVISIONS REQUESTED BY THE PURCHASER AND ALL REVISIONS ARE SUBJECT TO VENDOR'S FINAL APPROVAL. ONLY REVISIONS ACCEPTED IN WRITING BY THE PURCHASER AND VENDOR ON A PURCHASER'S EXTRA SHEET WILL BE INCORPORATED INTO THE PLANS FILED WITH THE MUNICIPALITY. E. & O.E.

REGION  
DESIGN  
INC.

SCALE  
NTS

BY  
PAGE No.  
OF



