
Greenpark.

PURCHASERS: Thi Phuoi	Mountainview	NSTRUCTION SUMMAR v Heights 3 (G) - Russell Gardens B hi NGUYEN // Van Viet TRAN	RY Building Ltd.	TINI DEC. 2005 (4.7 a.v.)
LOT / PHASE 404 / 4	REG. PLAN # 62M-1266	HOUSE TYPE Mountainash Three (4 Bedroom) E	lev 1	TEL: RES.: 905-617-2469
CONSTRUCTION				
3 - ENLARGE BASEMENT 15Jun21 Note:	`WINDOWS (MAY REQUI	IRE WINDOW WELLS) - WINDOW IS 30	INCHES X 24 INC	HES
ELECTRICAL				
1 - PLUG - ELECTRICAL P 15Jun21 Note:	LUG WITH GFI AND SWI	TCH - FOR FESTIVE LIGHTING		
8 - POT LIGHT - LED - FIR 15Jun21 Note:		N		
1 - 200 AMP ELECTRICAL 15Jun21 Note:	SERVICE			
MIRRORS AND GLASS 1 - MASTER ENSUITE – FR 15Jun21 Note:		ER ENCLOSURE – INCLUDES CHROME	KNOB AND HINC	GES
PLUMBING				
1 - WATER LINE FOR FRID 15Jun21 Note:	OGE - ROUGH-IN ONLY			
2 - TOE TESTER - ADD TOF 15Jun21 Note:	E TESTER TO SHOWER S	en zen		
PROMOTIONAL				
1 - LESS CREDIT FROM PU 15Jun21 Note:	RCHASER EXTRA SHEET	Γ IN OFFER		
	EX	TRAS AS PER OFFER		
PURCHASER(S) ACKNOV PROMOTIONAL PACKAO Vorksheet Note:	WLEDGES THAT THE F GES AVAILABLE AT TI	PURCHASE PRICE IS INCLUSIVE OF IME OF PURCHASE.	FALL CREDITS A	AND
Granite kitchen counter top, Vorksheet Note:		•		
1) The Vendor agrees that iddition to those items detail <i>Vorksheet</i> Note:	notwithstanding any other iled in Schedule GP to the	term or provision in this Agreement inc Agreement of Purchase and Sale, the Pu	luded in the Purch urchaser is entitled	ase Price and in I to a credit of

This Document is Extremely Time Sensitive - Printed 21 Jun 21 at 9:23

CONSTRUCTION SUMMARYD
PRELIMINARY: DATE, JUN 2 8 2021
FINAL: DATE

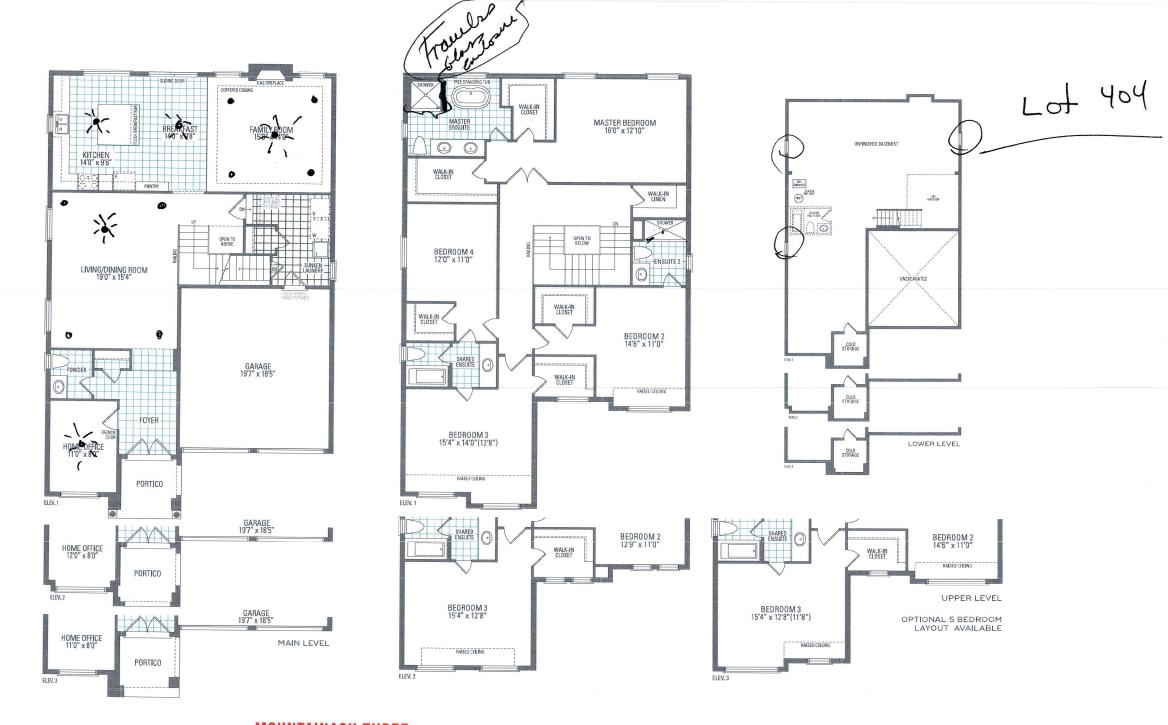

MOUNTAINASH THREE ELEV. 1 · 3,086 sq.ft. | ELEV. 2 · 3,074 sq.ft. | ELEV. 3 · 3,063 sq.ft.