

CONSTRUCTION SUMMARY

Mountainview Heights 3 (G) - Russell Gardens Building Ltd.

PURCHASERS: Asim JAFFRY and Seyeda Farwah BATOOL

TEL: RES.: 647-786-5461

LOT / PHASE	REG. PLAN #	HOUSE TYPE		
358 / 4	62M-1266	Springfield Four (5 Bedroom) Elev 3		

CONSTRUCTION

4 - PROVISION FOR SHAMPOO NICHE APPROX. 24" WIDE X 20" HIGH AS PER SKETCH – IF CONSTRUCTION PERMITS - ALL ENSUITE BATHROOMS 18Jun21 Note: See Sketch for Revision of M.E. Shower *	
1 - SMOOTH CEILINGS ON FIRST FLOOR ONLY - DET 18Jun21 Note:	

COUNTER TOP

4 - SHAMPOO NICHE 24" WIDE X 20" HIGH AS PER SKETCH – MARBLE, GRANITE OR QUARTZ – IF CONSTRUCTION PERMITS - REQUIRES PROVISION FROM CONSTRUCTION - ALL ENSUITE BATHROOMS 18Jun21 Note: SUPPLY & INSTALL	
--	--

DOORS AND TRIM

1 - DOORS - EXTERIOR GARDEN DOORS (CLEAR GLASS) IN PLACE OF SLIDING DOOR - DOES NOT INCLUDE GRILLS - WITH FIXED DOOR PANEL AND SLIDING SCREEN 18Jun21 Note:	
--	--

ELECTRICAL

6 - POT LIGHT - EXTERIOR - SOFFIT MOUNT - REGULAR VOLTAGE 18Jun21 Note:	
1 - PLUG - ELECTRICAL PLUG WITH GFI AND SWITCH - FOR FESTIVE LIGHTING 18Jun21 Note:	
1 - 200 AMP ELECTRICAL SERVICE 18Jun21 Note:	

MIRRORS AND GLASS

1 - MASTER ENSUITE – FRAMELESS GLASS SHOWER ENCLOSURE – INCLUDES CHROME KNOB AND HINGES 18Jun21 Note: See Sketch *	
---	--

PLUMBING

1 - WATER LINE FOR FRIDGE - ROUGH-IN ONLY 18Jun21 Note:	
1 - MOEN 90 DEGREE POSI-TEMP SHOWER ONLY WITH 3 FUNCTION TRANSFER VALVE/TRIM AND SLIDE BAR WITH HAND SHOWER – CHROME #TS2712EP/U361CI/UTS4172/62320/S3879EP/A721 18Jun21 Note: MASTER ENSUITE	
1 - 5 FOOT SHOWER WITH SLIDING GLASS CHROME DOORS IN LIEU OF TUB 18Jun21 Note: IN ENSUITE 2/5	
4 - TOE TESTER - ADD TOE TESTER TO SHOWER 18Jun21 Note:	

PROMOTIONAL

1 - LESS CREDIT FROM PURCHASER EXTRA SHEET IN OFFER 18Jun21 Note:	
--	--

CONSTRUCTION SUMMARY

PRELIMINARY: DATE JUN 30 2021

FINAL: DATE

CONSTRUCTION SUMMARY

Mountainview Heights 3 (G) - Russell Gardens Building Ltd.

PURCHASERS: Asim JAFFRY and Seyeda Farwah BATOOL

TEL: RES.: 647-786-5461

LOT / PHASE 358 / 4	REG. PLAN # 62M-1266	HOUSE TYPE Springfield Four (5 Bedroom) Elev 3		
------------------------	-------------------------	---	--	--

EXTRAS AS PER OFFER

(1) The Vendor agrees that notwithstanding any other term or provision in this Agreement included in the Purchase Price and in addition to those items detailed in Schedule GP to the Agreement of Purchase and Sale, the Purchaser is entitled to a credit of <i>Worksheet</i> Note:	
PURCHASER(S) ACKNOWLEDGES THAT THE PURCHASE PRICE IS INCLUSIVE OF ALL CREDITS AND PROMOTIONAL PACKAGES AVAILABLE AT TIME OF PURCHASE. <i>Worksheet</i> Note:	
Granite kitchen counter top, from Vendor?s standard samples <i>Worksheet</i> Note:	
Purchase Price includes 3 enlarged basement windows, and the obligation to construct the house with the enlarged basement windows is subject to the Vendors approval, in its sole and unfettered discretion The Purchaser acknowledges and agrees that the loc <i>Worksheet</i> Note:	

This Document is Extremely Time Sensitive - Printed 18 Jun 21 at 16:51


Lot. 358

Family Room
Glass Enclosure
Shift seat
to opposite
wall.

47' LOT
SPRINGFIELD FOUR




ELEVATION 1 • 4,080 sq.ft.

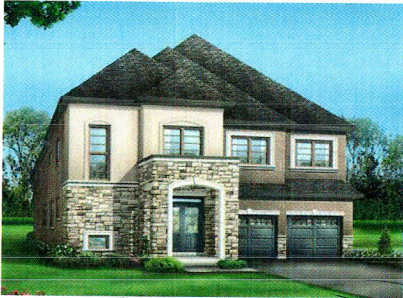


ELEVATION 2 • 4,062 sq.ft.




ELEVATION 3 • 4,082 sq.ft.

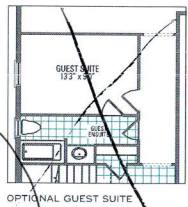

OPTIONAL GUEST SUITE

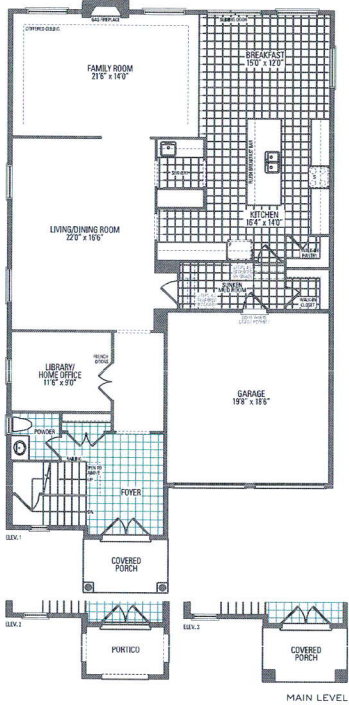

MAIN LEVEL

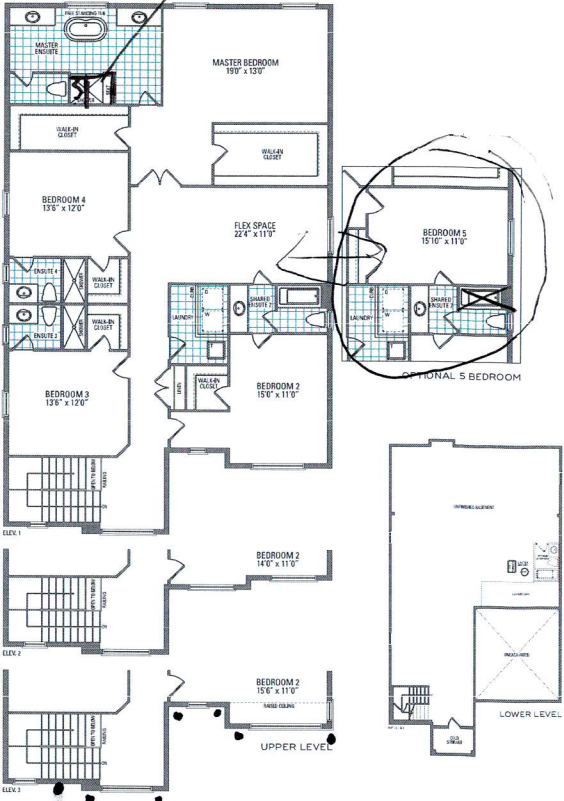

OPTIONAL 5 BEDROOM

LOWER LEVEL

SPRINGFIELD FOUR ELEV. 1 • 4,080 sq.ft. | ELEV. 2 • 4,062 sq.ft. | ELEV. 3 • 4,082 sq.ft.

Orientation of home may be reversed and purchaser agrees to accept same. Steps and porches may vary at any exterior entrance ways due to grading variance. Actual usable floor space may vary from the stated floor areas. All renderings are artist's concept. Dimensions, specifications and architectural detailing subject to modifications. Roofline and adjoining model types may vary due to siting. E. & O.E. May 2021

Orientation of home may be reversed and purchaser agrees to accept same. Steps and porches may vary at any exterior entrance ways due to grading variance. Actual usable floor space may vary from the stated floor areas. All renderings are artist's concept. Dimensions, specifications and architectural detailing subject to modifications. Roofline and adjoining model types may vary due to siting. E. & O.E. May 2021