

CONSTRUCTION SUMMARY

Mountainview Heights 3 (G) - Russell Gardens Building Ltd.

PURCHASERS: DHARMENDRAKUMAR C PATEL and HITIXABEN R PATEL

TEL: RES.: 905-331-1919

LOT / PHASE 324 / 3	REG. PLAN # 62M-1266	HOUSE TYPE Valleycreek Two Elev 2		
------------------------	-------------------------	--------------------------------------	--	--

CABINETRY

1 - KITCHEN - DELETE CABINETS ABOVE STOVE - VENDOR WILL SUPPLY 6 INCH VENT AS PER CONSTRUCTION SPECIFICATIONS AND VENT MAY NOT BE IN THE APPROPRIATE LOCATION FOR INSTALLATION OF PURCHASER SUPPLIED VENT - PURCHASER TO SUPPLY OWN FAN AFTER CLOSING 28Jun21 Note: TEMPORARY HOOD FAN MAY BE PROVIDED	
1 - CABINETRY - KITCHEN - CM3 CROWN MOULDING 28Jun21 Note:	

CABINETRY ACCESSORIES

1 - KITCHEN CABINETRY BASE - POT/PAN DRAWERS (CABINET) - STANDARD 28Jun21 Note:	
1 - PANTRY UNIT UPGRADE - TO GO FROM 300MM TO 600MM DEEP - PRICE IS PER FOOT - STANDARD 28Jun21 Note:	
1 - KITCHEN CABINETRY UPPER - FULL DEPTH ABOVE FRIDGE - WITH GABLES - 600MM - PRICE IS EACH - STANDARD 28Jun21 Note:	
1 - KITCHEN CABINETRY UPPER - ANGLED CORNER CABINET - FITS TALL UPPER CABINETS - PER UNIT - STANDARD 28Jun21 Note:	

CERAMIC TILE

1 - PRICE IS FOR LABOUR ONLY - INSTALL TILE AT A 45 DEGREE ANGLE - KITCHEN 28Jun21 Note:	✓
1 - TILE - UPGRADE 3 FLOOR TILE - - POWDER ROOM 28Jun21 Note:	✓
1 - TILE - UPGRADE 3 FLOOR TILE - - KITCHEN 28Jun21 Note:	✓
1 - TILE - UPGRADE 3 FLOOR TILE - - FOYER 28Jun21 Note:	✓

CONSTRUCTION

1 - DELETE BULK HEADS IN KITCHEN IF CONSTRUCTION PERMITS 28Jun21 Note:	
1 - SMOOTH CEILINGS ON FIRST FLOOR ONLY - DET 28Jun21 Note:	
Plumbing: ★ 1 - SHARED ENSUITE BEDROOM 3/4 - 5 FOOT SHOWER WITH SLIDING GLASS CHROME DOORS IN LIEU OF TUB 12Aug20 Note:	

ELECTRICAL

1 - PLUG - ELECTRICAL PLUG - TO BE INSTALLED OVER FIREPLACE 05Jul21 Note:	
3 - FAN - BATHROOM EXHAUST FAN - ENERGY STAR 80 CFM - IN LIEU OF STANDARD FAN - ALL ENSUITE BATHROOMS 28Jun21 Note:	

CONSTRUCTION SUMMARY

Mountainview Heights 3 (G) - Russell Gardens Building Ltd.

PURCHASERS: DHARMENDRAKUMAR C PATEL and HITIXABEN R PATEL

TEL: RES.: 905-331-1919

LOT / PHASE	REG. PLAN #	HOUSE TYPE		
324 / 3	62M-1266	Valleycreek Two Elev 2		
1 - RELOCATE STANDARD KITCHEN LIGHT TO BE CENTERED OVER ISLAND 28Jun21 Note:				
1 - POT LIGHT - LED - FIRST FLOOR INSTALLATION - INSTALLED ON SEPERATE SWITCH FROM STANDARD LIGHT - KITCHEN WORKSPACE 28Jun21 Note:				

HARDWOOD FLOORING

1 - HARDWOOD - PROMO SERIES 3 1/4 INCH - IN LIEU OF 2 1/4 INCH NATURAL RED OAK - - MAIN HALL 28Jun21 Note:	
1 - HARDWOOD - PROMO SERIES 3 1/4 INCH - IN LIEU OF 2 1/4 INCH NATURAL RED OAK - - FAMILY ROOM 28Jun21 Note:	
1 - HARDWOOD - PROMO SERIES 3 1/4 INCH - IN LIEU OF 2 1/4 INCH NATURAL RED OAK - - DINING ROOM 28Jun21 Note:	

MISCELLANEOUS

1 - NO FURTHER CHANGES PERMITTED 05Jul21 Note:	
---	--

PLUMBING

3 - TOE TESTER - ADD TOE TESTER TO SHOWER - ALL SHOWERS 12Aug20 Note: See Construction: For Tub to Shower Red 3/4 ☆	
---	--

PROMOTIONAL

1 - LESS CREDIT FROM PURCHASER EXTRA SHEET IN OFFER 12Aug20 Note:	
--	--

STAIRS AND RAILINGS

1 - STAIRCASE - V GROOVE HANDRAIL 28Jun21 Note:	
1 - STAINED STAIRS – STANDARD STAIRCASE - PRICE IS PER SET 28Jun21 Note:	

EXTRAS AS PER OFFER

10 Ft ceiling on main level Worksheet Note:	
PURCHASER(S) ACKNOWLEDGES THAT THE PURCHASE PRICE IS INCLUSIVE OF ALL CREDITS AND PROMOTIONAL PACKAGES AVAILABLE AT TIME OF PURCHASE. Worksheet Note:	
(1) The Vendor agrees that notwithstanding any other term or provision in this Agreement included in the Purchase Price and in addition to those items detailed in Schedule GP to the Agreement of Purchase and Sale, the Purchaser is entitled to a credit of Worksheet Note:	
200 AMP SERVICE LABELLED WITH CIRCUIT BREAKER PANEL TO UTILITY AUTHORITY STANDARDS. Worksheet Note:	

Purchasers:DHARMENDRAKUMAR C PATEL & HITIXABEN

Property: 324

Telephone Res. / Bus: (905) 331-1919 /

Project: Russell Gardens Building Ltd.

Decor Advisor: Candace Forza

Model and Elevation: Valleycreek Two Elev 2

Lock Date: 28-Jun-21

28-Jun-21

Plan #: 62M-1266

Layout Changes: ☒ Yes ☐ No

Sketch Attached: ☒ Yes ☐ No

Exterior Colour Scheme:

1. Cabinetry

	Style and Colour	Hardware
Kitchen / Breakfast	CONTINENTAL 823 DRIFTWOOD	431SA
Laundry Room	ELISSE	Standard
Powder Room	CONTINENTAL 823 DRIFTWOOD	431SA
Master Ensuite Bathroom	CONTINENTAL 814 DARK CHOCOLATE	447SA
Ensuite Bath - Bedroom 2	CONTINENTAL 814 DARK CHOCOLATE	447SA
Ensuite Bath - Bedroom 3/4	CONTINENTAL 814 DARK CHOCOLATE	447SA
	N/A	N/A
	N/A	N/A
	N/A	N/A

Appliances:

Built In Appliances ☐ Yes ☒ No

Slide In Stove ☐ Yes ☒ No

Dishwasher Cabinet

☐ Closed ☒ Open

41" Upper Cabinets ☒ Yes ☐ No

Please NOTE: Standard Cabinet Height is 30"

Stove Opening

NOTE: If not specified, opening will be set to builder's standard opening of approximately 30" width

Fridge Opening

NOTE: If not specified, opening will be set to builder's standard opening of approximately 37" width x 74" height

** Refer to Construction Summary

2. Counters

	Counter	Edge
Kitchen / Breakfast	LAMINATE-CARRARA BIANCO 6696-46	
Laundry Room	N/A	
Powder Room	LAMINATE-CARRARA BIANCO 6696-46	
Master Ensuite Bathroom	LAMINATE-CARRARA BIANCO 6696-46	
Ensuite Bath - Bedroom 2	LAMINATE-CALCUTTA MARBLE 4925K-07	
Ensuite Bath - Bedroom 3/4	LAMINATE-CALCUTTA MARBLE 4925K-07	
	N/A	
	N/A	
	N/A	

** Refer to Construction Summary

Purchasers:

DHARMENDRAKUMAR C PATEL & HITIXABEN

Property: 324

Telephone Res. / Bus:

(905) 331-1919 /

Decor Advisor:

Candace Forza

Lock Date:

5-Jul-21

28-Jun-21

Project:

Russell Gardens Building Ltd.

Model and Elevation:

Valleycreek Two Elev 2

Plan #:

62M-1266

3. Ceramic Flooring

		At a 45	Threshold-If App.
Entrance Vestibule	TILE-LITIUM SILVER POLISHED-24X24	<input type="checkbox"/>	<input type="checkbox"/> metal strip where applicable
Main Hall	STRIP	<input type="checkbox"/>	
Kitchen / Breakfast	TILE-LITIUM SILVER POLISHED-24X24	<input checked="" type="checkbox"/>	
Laundry Room	TILE-RAINBOW LIGHT GREY-13X13	<input type="checkbox"/>	
Powder Room	TILE-LITIUM SILVER POLISHED-12X24	<input type="checkbox"/>	
Master Ensuite Bathroom	TILE-CONCEPT GREY-13X13	<input type="checkbox"/>	
Ensuite Bath - Bedroom 2	TILE-GAT2J156 NEO GREY-13X13	<input type="checkbox"/>	
Ensuite Bath - Bedroom 3/4	TILE-RAINBOW LIGHT GREY-13X13	<input type="checkbox"/>	
	N/A	<input type="checkbox"/>	
	N/A	<input type="checkbox"/>	
	N/A	<input type="checkbox"/>	

** Refer to Construction Summary

4. Ceramic Wall Tile

Master Ensuite Bathroom	Selection	Describe
Tub Deck Wall	N/A	
Tub Deck	N/A	
Tub Deck Skirt	N/A	
Shower Stall	TILE-LUC BLANC GROENLANDIA-8X16	
Bathtub Enclosure Walls	N/A	
Ensuite Bath - Bedroom 2	TILE-LUC CONCEPT NEVE-8X16	
Ensuite Bath - Bedroom 3/4	TILE-LUC AFRICA-8X16	
	N/A	
	N/A	
	N/A	
Kitchen Backsplash	N/A	

** Refer to Construction Summary - STANDARD GROUT THROUGHOUT UNLESS SPECIFIED

5. Plumbing Fixtures

All Bathrooms

White

N/A

N/A

Whirlpool

N/A

☐ Yes

☒ No

Dishwasher Rough-In

☒ Yes

☐ No

Waterline for Fridge

☐ Yes

☒ No

** Refer to Construction Summary

6. Trim Carpentry

Interior Doors	CARRARA-SMOOTH
Interior Trim	As Per Construction Specifications
Door Handles	As Per Construction Specifications
Exterior Front Door Handle	As Per Construction Specifications

** Refer to Construction Summary

Purchasers:

DHARMENDRAKUMAR C PATEL & HITIXABEN

Property: 324

Telephone Res. / Bus:

(905) 331-1919 /

Project: Russell Gardens Building Ltd.

Decor Advisor:

Candace Forza

Model and Elevation: Valleycreek Two Elev 2

Lock Date:

28-Jun-21

28-Jun-21

Plan #: 62M-1266

7. Other Flooring

Main Hall	STRIP-MIRAGE-ADMIRATION-MAPLE-SEMI-GLOSS-PLATINUM-3 1/4"	
Living Room	N/A	
Dining Room	STRIP-MIRAGE-ADMIRATION-MAPLE-SEMI-GLOSS-PLATINUM-3 1/4"	
Family Room	STRIP-MIRAGE-ADMIRATION-MAPLE-SEMI-GLOSS-PLATINUM-3 1/4"	
Den / Library / Study	N/A	
Basement Landing(If Applies)	N/A	
Lower Landing (If Applies)	STRIP-MIRAGE-ADMIRATION-MAPLE-SEMI-GLOSS-PLATINUM-3 1/4"	
Upper Landing	STRIP-MIRAGE-ADMIRATION-MAPLE-SEMI-GLOSS-PLATINUM-3 1/4"	
Upper Hall	LAMINATE-MANHATTAN-EARL GREY OAK-TL-15012	
Master Bedroom	LAMINATE-MANHATTAN-EARL GREY OAK-TL-15012	
Bedroom #2	LAMINATE-MANHATTAN-EARL GREY OAK-TL-15012	
Bedroom #3	LAMINATE-MANHATTAN-EARL GREY OAK-TL-15012	
Bedroom #4	LAMINATE-MANHATTAN-EARL GREY OAK-TL-15012	
Bedroom #5	N/A	
	N/A	
	N/A	
	N/A	
Underpad	Type	Area
	N/A	N/A

** Refer to Construction Summary

8. Railings and Pickets

Railing Type	V-GROOVE	Colour	MIRAGE PLATINUM MAPLE
Picket Type	AS PER CONSTRUCTION SPECIFICATIONS	Colour	MIRAGE PLATINUM MAPLE
Stringer / Riser	AS PER CONSTRUCTION SPECIFICATIO	Colour	MIRAGE PLATINUM MAPLE
Treads	AS PER CONSTRUCTION SPECIFICATIO	Colour	MIRAGE PLATINUM MAPLE
Red Oak Stairs with Semi Gloss Finish		<input checked="" type="radio"/> Yes <input type="radio"/> No	

** Refer to Construction Summary THE STAIN COLOURS OR FINISH AVAILABLE ON RISERS, TREADS, PICKETS AND RAILS (STAIRCASES), WILL NOT BE AN EXACT MATCH TO PREFINISHED HARDWOOD OR LAMINATE FLOORS.

9. Wall Paint Flat Finish

Main & Upper Hall	22 WARM GREY	Master Bedroom	22 WARM GREY
Living Room	N/A	Bedroom #2	22 WARM GREY
Dining Room	22 WARM GREY	Bedroom #3	22 WARM GREY
Kitchen / Breakfast	22 WARM GREY	Bedroom #4	22 WARM GREY
Family Room	22 WARM GREY	Bedroom #5	N/A
Powder Room	22 WARM GREY	Master Ensuite	22 WARM GREY
Laundry Room	22 WARM GREY	Ensuite Bath - Bedroom 2	22 WARM GREY
Den/Library	N/A	Ensuite Bath - Bedroom 3/4	22 WARM GREY
Trim Paint-Semi Gloss	BIRCH WHITE		N/A
	N/A		N/A
	N/A		N/A
Smooth Ceilings First Floor		<input checked="" type="radio"/> Yes <input type="radio"/> No	

** Refer to Construction Summary

Initials:

Purchasers:

DHARMENDRAKUMAR C PATEL & HITIXABEN

Property: 324

Telephone Res. / Bus:

(905) 331-1919 /

Decor Advisor:

Candace Forza

Model and Elevation: Valleycreek Two Elev 2

Lock Date:

28-Jun-21

28-Jun-21

Plan #:

62M-1266

Project: Russell Gardens Building Ltd.

10. Plaster Mouldings and Medallions

Entrance Vestibule	N/A	N/A	Kitchen/Breakfast	N/A	N/A
Main Hall	N/A	N/A	Den/Library	N/A	N/A
Living Room	N/A	N/A	Lower Landing	N/A	N/A
Dining Room	N/A	N/A		N/A	N/A
Family Room	N/A	N/A		N/A	N/A

** Refer to Construction Summary

11. Fireplace

	Living Room			Family Room			Other Room - Specify		
	Purchased	As Per Plan	N/A	Purchased	As Per Plan	N/A	Purchased	As Per Plan	N/A
Fireplace Type	<input type="radio"/>	<input type="radio"/>	<input checked="" type="radio"/>	<input type="radio"/>	<input checked="" type="radio"/>	<input type="radio"/>	<input type="radio"/>	<input type="radio"/>	<input checked="" type="radio"/>
Mantle Type	N/A			FLAT ON WALL			N/A		
Colour / Stain	N/A			MANTLE M1-STANDARD			N/A		
Surround	N/A			AS PER CONSTRUCTION SPECIFICATIONS			N/A		
Hearth	N/A			BIANCO			N/A		
	N/A			NO			N/A		

** Refer to Construction Summary

12. Heating and Air Conditioning

Air Conditioning	NO	Gas Provisions Stove	NO
Gas Provisions Dryer	NO	Gas Provisions Barbecue	NO
Comment			

** Refer to Construction Summary

13. Electrical

Plugs and Switches	<input checked="" type="radio"/> White	DECOR	Above Kitchen Cabinet Light	<input type="radio"/> Yes	<input checked="" type="radio"/> No
Hood Fan	STANDARD WHITE		Below Kitchen Cabinet Light	<input type="radio"/> Yes	<input checked="" type="radio"/> No
Appliances	Built in Cooktop	Built in Oven	Gas Stove	Microwave	
	<input type="radio"/> Yes <input checked="" type="radio"/> No	<input type="radio"/> Yes <input checked="" type="radio"/> No	<input type="radio"/> Yes <input checked="" type="radio"/> No	<input type="radio"/> Yes <input checked="" type="radio"/> No	
Dishwasher Rough-in	Yes				

** Refer to Construction Summary

14. General Comments

** Refer to Construction Summary


Disclaimers and Notes

1) Colours of all materials are as close as possible to builder's selection, but not necessarily identical due to variances in manufacturing.


2) Any extras listed above are null and void unless accompanied by a separate invoice/amendment. Said invoice must be paid in full.

3) The Purchaser agrees that this colour selection is final and that no changes will be permitted, unless required by the Vendor.

4) The Purchaser acknowledges reading and accepting document which contains other miscellaneous disclaimers.

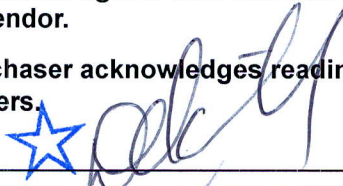Signature: 

Date: 28th June 2021


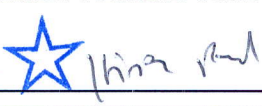
Signature: 

Date: 28th June 2021

Relocate
sta Light
Above Island

1 Potlight

3aa Plug Above
Fireplace

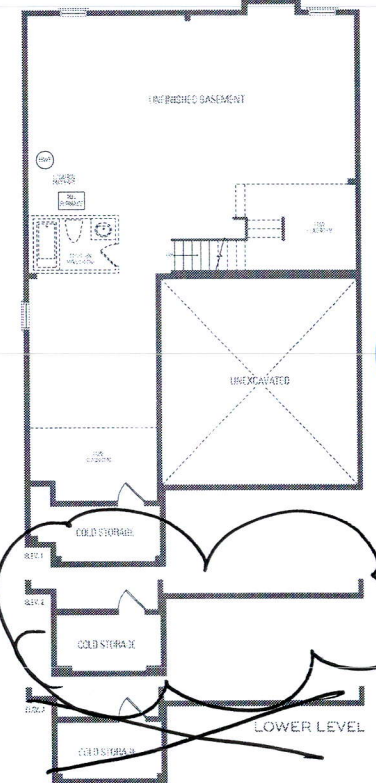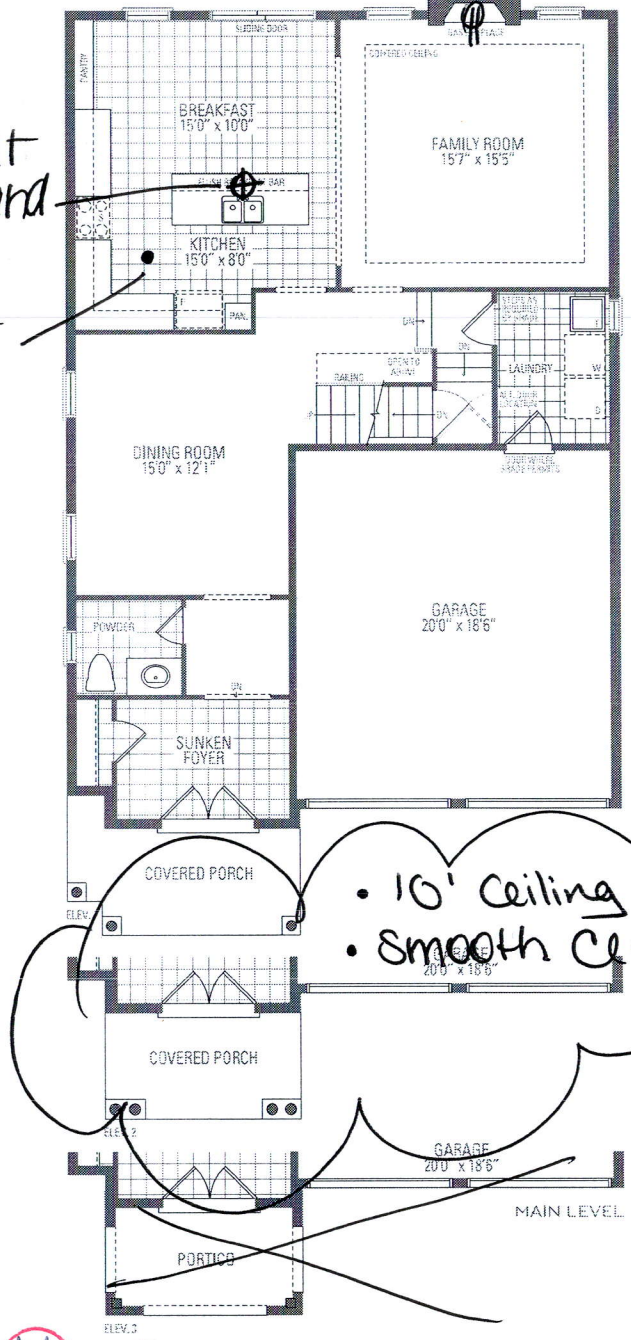

200 AMP

Shower








VALLEYCREEK TWO ELEV. 1 • 2,602 sq.ft. | ELEV. 2 + 3 • 2,624 sq.ft.

Orientation of home may be reversed and purchaser agrees to accept the same. Steps and porches may vary at any exterior entrance ways due to grading variance. Actual usable floor space may vary from the stated floor areas. All renderings are artist's concept. Dimensions, specifications and architectural detailing subject to modifications. Roofline and adjoining model types may vary due to siting. E. & O. E. May 2020

Kitchen
 • am 3 Crown
 moulding.

upper angled
 corner cabinet

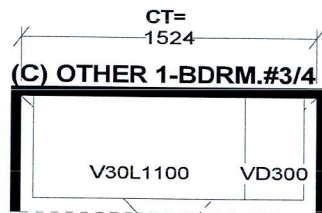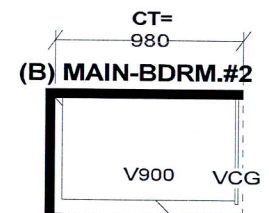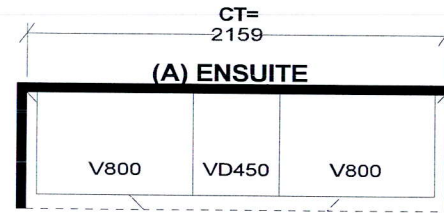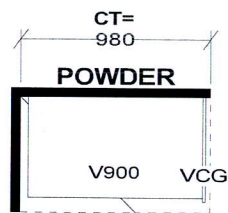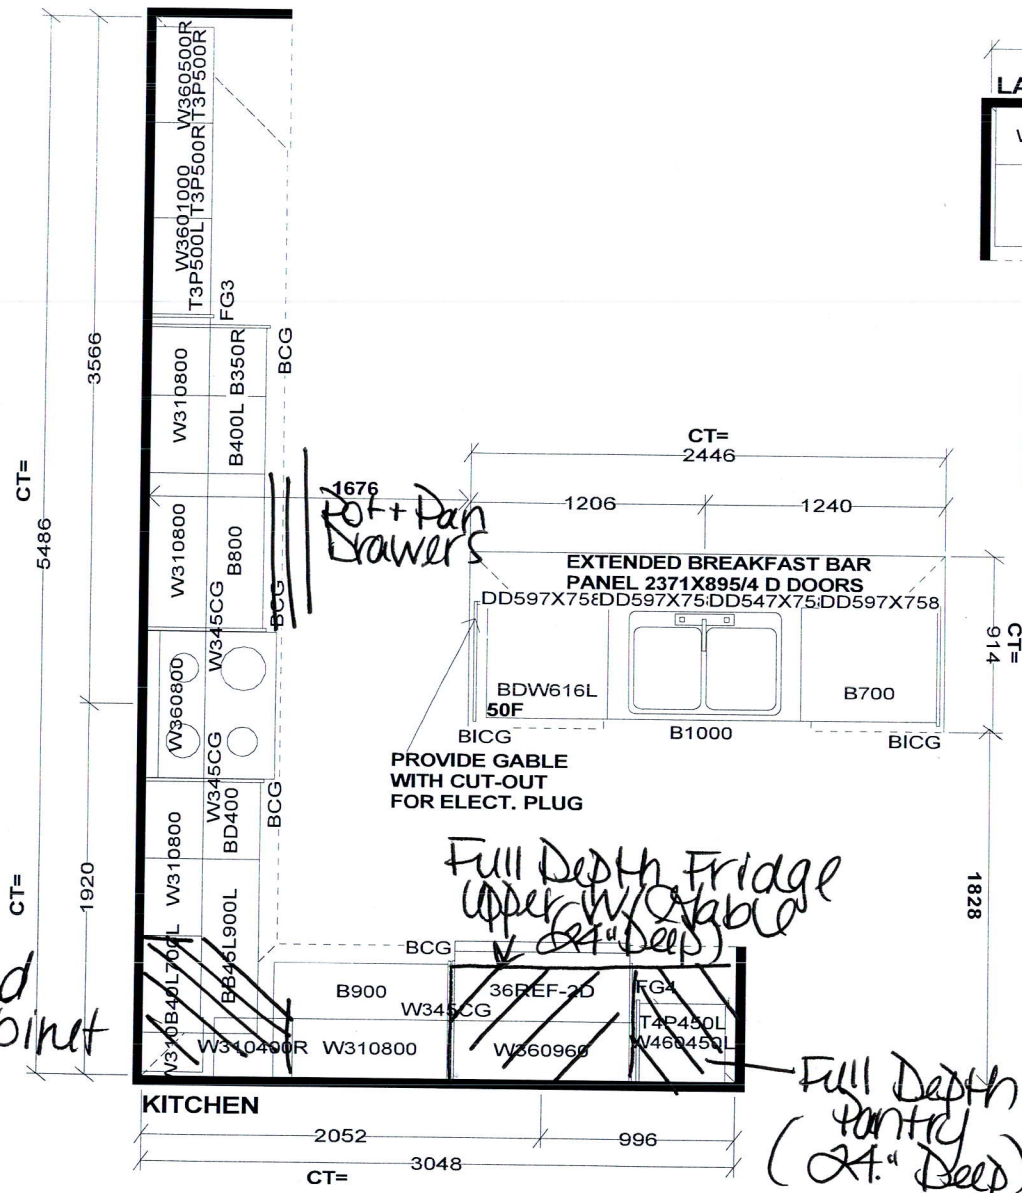

Selba Industries			J#
W WDT	W HGHT	W CNT	This drawing is the intellectual property of SELBA INDUSTRIES INC. and is an original design which must not be released or copied unless applicable fee has been paid or job order placed. DESIGNER: KS DATE: MAY 13 20 JOB NUMBER: BUILDER: GREENPARK SITE: RUSSELL GARDENS PH.3 MODEL: VALLEYCREEK 2X EL 1,2,3 LOT #:
FLOOR HGHT	DOOR HGHT		
ST CENT	2X4	VENT BOX COVER	
G H A B C F E D			

We're here to get you what you need.

Shop online for pickup or delivery, or visit a store for a safe shopping and service experience. [Learn more](#) >



Stores

Cart

Search Best Buy

Q

Home > Appliances > Major Appliances > Ranges, Cooking & Ventilation > Range Hoods > Product Details

ROXON 850 CFM STAINLESS STEEL 30 Inches Range Hood


Wall Mounted Kitchen Exhaust Fan Style RXN-W44A-30

Model Number: RXN-W44A-30


Web Code: 15458501



No reviews yet. Be the first! >

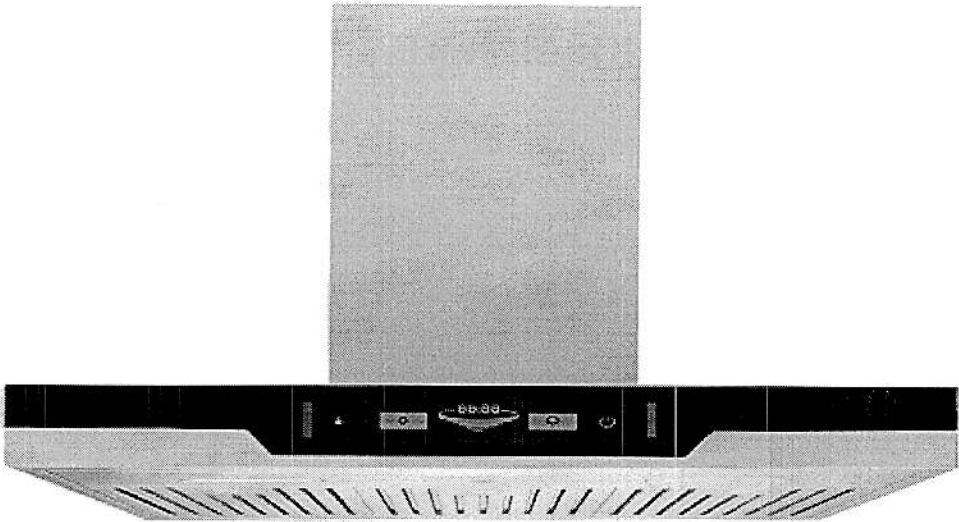


1 of 6

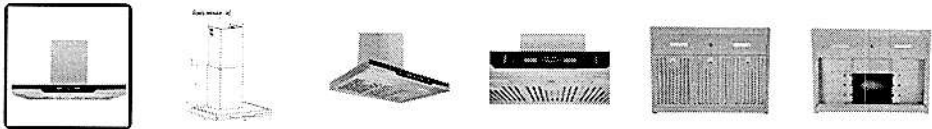

SAVE \$400

\$499⁹⁹

SALE ends: July 6, 2021

 Sold and shipped by **Roxon Inc.**

4.5 seller rating, 19 review(s)



Available online only
Most items leave this seller's location within 2 business days. Allow additional time for shipping to your address.

Overview

Keep your kitchen fresh with this strong powerful stainless steel range hood. The hood can be mounted to your wall to add a modern yet durable accent to the room. Running at a quiet noise level, your day won't be disrupted as it freshens the air. Cool white LED lighting brightens up your area, and tidying up is a breeze thanks to the easy-to-clean surface.

More Information	Details & Specs	What's Included	From the Manufacturer
Customer Reviews	Common Questions	Seller Shipping Policy	
Seller Return Policy			

- Model# RXN-W46A-30
- 850 CFM capacity
- STAINLESS STEEL Wall mount range hood
- TOUCHLESS FEATURE (OPTIONAL)
- SMOKE SENSOR AUTO START (OPTIONAL)
- Dishwasher safe Stainless-Steel Baffle Filters
- Centrifugal Blower motor to reduce noise
- 6" Round Venting
- Includes main unit and mounting kit
- Includes remote control
- 2 cool bluish white LED lights illuminate area
- Made of durable quality stainless steel body
- Digital touch control
- 6 Speed Level Control
- Auto Shut-off feature (2 to 30 mins)
- Less power consumption
- Noise level less than 65db
- Two Years Limited parts warranty included

Advice



Delivery



Installation



Ready to make an appliance purchase? There's some important things you need to know about measurements, delivery, and installation.

[Learn More](#)

Type of Range Hoods	Standard Over Range
Style of Range Hoods	Wall Chimney Hoods
Colour Family	Stainless Steel
Type of Venting	External
Number of Fan Speed	6

Dimensions

Width (Inches)	30 in
Depth (Inches)	22 in

Warranty

Seller's Warranty - Parts	2 Years
Seller's Warranty - Labour	2 Years

- Main Unit- Mounting Kit- Filters- Two LED Light bulbs (Installed)

There is no manufacturer content to show for this product. Explore the Details & Specs and Customer Reviews sections to learn more.

Ratings

