

CONSTRUCTION SUMMARY				
Mountainview Heights 3 (G) - Russell Gardens Building Ltd.				
PURCHASER: Mira NIKOLIC				TEL:
LOT / PHASE	REG. PLAN #	HOUSE TYPE		
540 / 4	62M-1266	Valleycreek Two Elev 3		

CONSTRUCTION

1 - FRONT ELEVATION-REPLACE BRICK WITH STONE AROUND PORTICO AND AT BASE OF GARAGE-SEE SKETCH	
28Jun21 Note:	

PROMOTIONAL

1 - LESS CREDIT FROM PURCHASER EXTRA SHEET IN OFFER	
28Jun21 Note: NEW PROMO BALANCE \$2500.00	

EXTRAS AS PER OFFER

(1) The Vendor agrees that notwithstanding any other term or provision in this Agreement included in the Purchase Price and in addition to those items detailed in Schedule GP to the Agreement of Purchase and Sale, the Purchaser is entitled to a credit of	
Worksheet Note:	
PURCHASER(S) ACKNOWLEDGES THAT THE PURCHASE PRICE IS INCLUSIVE OF ALL CREDITS AND PROMOTIONAL PACKAGES AVAILABLE AT TIME OF PURCHASE.	
Worksheet Note:	
Granite kitchen counter top, from Vendor?s standard samples	
Worksheet Note:	

This Document is Extremely Time Sensitive - Printed 28 Jun 21 at 11:34


RECEIVED
CONSTRUCTION SUMMARY
JUL 12 2021
PRELIMINARY: DATE _____
FINAL: DATE _____

LOT 540
RUSSELL GARDENS
PHASE 4
MOUNTAINVIEW HEIGHTS

VALLEYCREEK 2
ELEV. 3

REVISIONS:

- 1. REPLACE BRICK WITH STONE AROUND PORTICO AND AT BASE OF GARAGE.

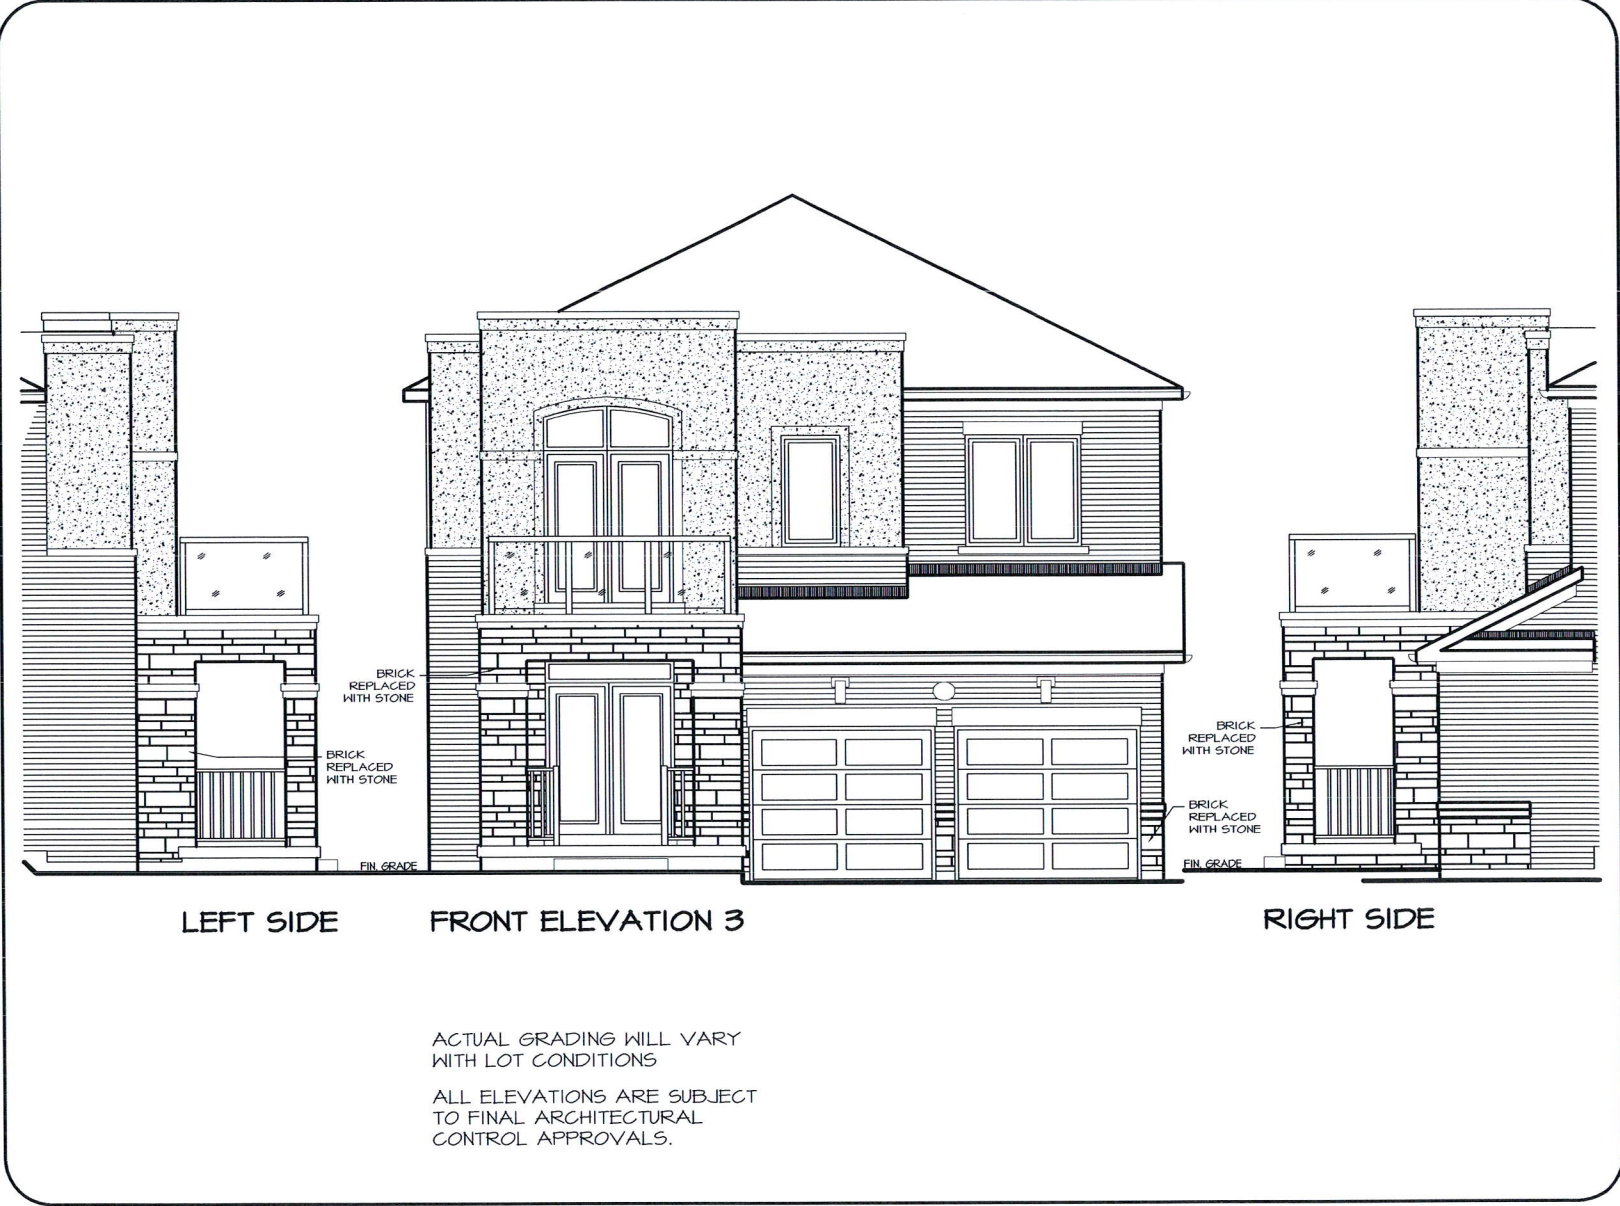

ACTUAL GRADING WILL VARY
WITH LOT CONDITIONS

ALL ELEVATIONS ARE SUBJECT
TO FINAL ARCHITECTURAL
CONTROL APPROVALS.

ELEVATIONS

DISCLAIMERS: SKETCH NOT TO SCALE. DIMENSIONS, SPECIFICATIONS AND ARCHITECTURAL DETAILS SUBJECT TO MODIFICATION BY THE VENDOR. SKETCH IS ONLY FOR THE PURPOSE OF ILLUSTRATING REVISIONS REQUESTED BY THE PURCHASER AND ALL REVISIONS ARE SUBJECT TO VENDOR'S FINAL APPROVAL. ONLY REVISIONS ACCEPTED IN WRITING BY THE PURCHASER AND VENDOR ON A PURCHASER'S EXTRA SHEET WILL BE INCORPORATED INTO THE PLANS FILED WITH THE MUNICIPALITY. E. & O.E.



SCALE		N.T.S.
BY	PAGE No.	
MB	1 OF 1	

