

CONSTRUCTION SUMMARY				
Mountainview Heights 3 (G) - Russell Gardens Building Ltd.				
PURCHASERS: Rajwinder SINGH and Sabrina Kaur SINGH			TEL: RES.: 905-320-0030	
LOT / PHASE	REG. PLAN #	HOUSE TYPE		
344 / 4	62M-1266	Valleycreek Three Elev 3		

CONSTRUCTION

1 - SMOOTH CEILINGS ON FIRST FLOOR ONLY - DET	
06Jul21    Note:	

ELECTRICAL

1 - PLUG - ELECTRICAL PLUG WITH GFI AND SWITCH - FOR FESTIVE LIGHTING	
06Jul21    Note:	

MIRRORS AND GLASS

1 - MASTER ENSUITE – FRAMELESS GLASS SHOWER ENCLOSURE – INCLUDES CHROME KNOB AND HINGES	
06Jul21    Note:	

PLUMBING

1 - WATER LINE FOR FRIDGE - ROUGH-IN ONLY	
06Jul21    Note:	

PROMOTIONAL

1 - LESS CREDIT FROM PURCHASER EXTRA SHEET IN OFFER	
06Jul21    Note:	

EXTRAS AS PER OFFER



PURCHASER(S) ACKNOWLEDGES THAT THE PURCHASE PRICE IS INCLUSIVE OF ALL CREDITS AND PROMOTIONAL PACKAGES AVAILABLE AT TIME OF PURCHASE.	
Worksheet    Note:	
(1) The Vendor agrees that notwithstanding any other term or provision in this Agreement included in the Purchase Price and in addition to those items detailed in Schedule GP to the Agreement of Purchase and Sale, the Purchaser is entitled to a credit of	
Worksheet    Note:	
Granite kitchen counter top, from Vendor?s standard samples	
Worksheet    Note:	

This Document is Extremely Time Sensitive - Printed 12 Jul 21 at 9:35

CONSTRUCTION SUMMARY

PRELIMINARY: DATE JUL 13 2021

FINAL: DATE

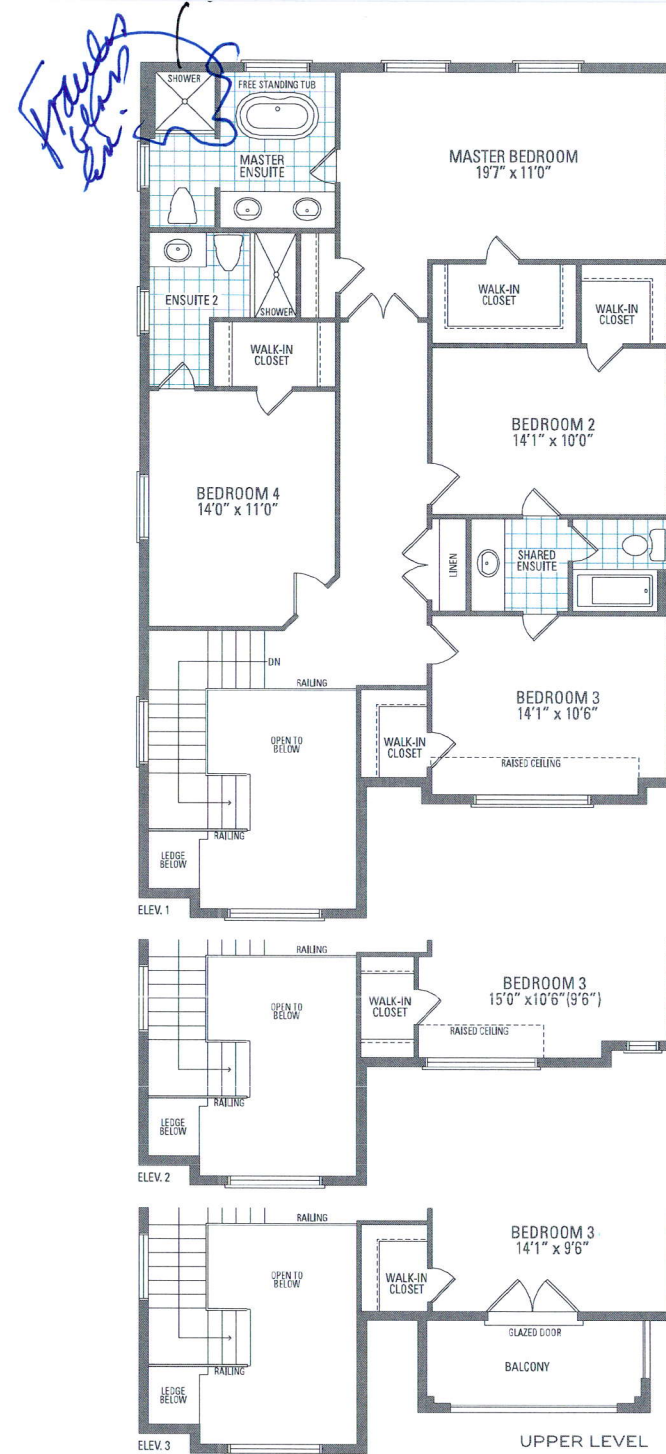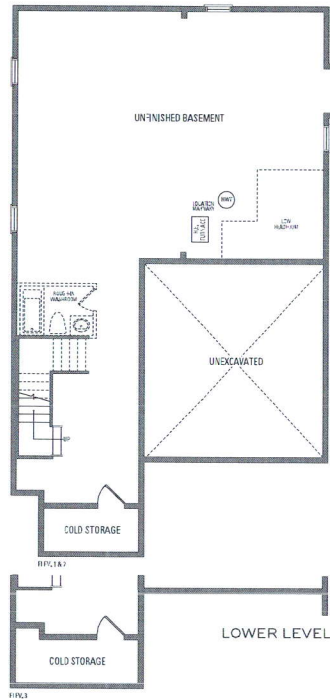

Orientation of home may be reversed and purchaser agrees to accept the same. Steps and porches may vary at any exterior entrance ways due to grading variance. Actual usable floor space may vary from the stated floor areas. All renderings are artist's concept. Dimensions, specifications and architectural detailing subject to modifications. Roofline and adjoining model types may vary due to siting. E. & O. E. May 2020