

CONSTRUCTION SUMMARY

Mountainview Heights 3 (G) - Russell Gardens Building Ltd.

PURCHASERS: HARDIK Pankajkumar PATEL and BINAKUMARI HASMUKHBHAI PATEL

TEL: RES.: 289-772-5366

LOT / PHASE 229 / 3	REG. PLAN # 62M-1266	HOUSE TYPE Mountainash Three (5 Bedroom) Elev 3		
------------------------	-------------------------	--	--	--

CABINETRY

1 - CABINETRY PROVISION - PROVISION FOR PLUG ON ISLAND (PLUG EXTRA ORDERED SEPARATELY) 07Jul21 Note:	
--	--

CABINETRY ACCESSORIES

1 - KITCHEN - REDUCE PANTRY AND SHIFT FRIDGE TO ACCOMMODATE BUILT-IN OVEN/MICRO 07Jul21 Note:	
1 - KITCHEN CABINETRY - BUILT-IN MICROWAVE/OVEN COMBO - STANDARD 07Jul21 Note:	

CERAMIC TILE

1 - DELETE ALL CERAMIC BATHROOM ACCESSORIES - DELETE TOWEL BAR, PAPER HOLDER & SOAP DISH THROUGHOUT 07Jul21 Note:	
1 - TILE - UPGRADE 4 FLOOR TILE - - POWDER ROOM 07Jul21 Note:	
1 - TILE - UPGRADE 4 FLOOR TILE - - KITCHEN 07Jul21 Note:	
1 - TILE - UPGRADE 4 FLOOR TILE - - FOYER 07Jul21 Note:	
1 - TILE - UPGRADE 1 WALL TILE - - BATHROOM 4/5 - TUB AREA 07Jul21 Note:	
1 - TILE - UPGRADE 1 FLOOR TILE - - BATHROOM 4/5 - FLOOR 07Jul21 Note:	
1 - TILE - UPGRADE 1 FLOOR TILE - - BATHROOM 2/3 - SHOWER 07Jul21 Note:	
1 - TILE - UPGRADE 1 FLOOR TILE - - BATHROOM 2/3 - FLOOR 07Jul21 Note:	
1 - TILE - UPGRADE 1 WALL TILE - - ENSUITE WALL TILE - SHOWER 07Jul21 Note:	
1 - TILE - UPGRADE 1 FLOOR TILE - - ENSUITE BATHROOM - FLOOR 07Jul21 Note:	

ELECTICAL

1 - PLUG – ROUGH-IN FOR ELECTRIC CAR PLUG IN GARAGE – FOR FUTURE ELECTRIC CAR – 240V / 40-50 AMPS 07Jul21 Note: SPECIFICATIONS REQUIRED	
---	--

ELECTRICAL

1 - FAN - BATHROOM EXHAUST FAN - ENERGY STAR 80 CFM - IN LIEU OF STANDARD FAN - ENSUITE 2/3 BATHROOM 12Jul21 Note:	
1 - BUILT IN OVEN AND COOKTOP PROVISION - PROVISION ONLY - ELECTRICAL ONLY 07Jul21 Note:	

CONSTRUCTION SUMMARY

Mountainview Heights 3 (G) - Russell Gardens Building Ltd.

PURCHASERS: HARDIK Pankajkumar PATEL and BINAKUMARI HASMUKHBHAI PATEL

TEL: RES.: 289-772-5366

LOT / PHASE	REG. PLAN #	HOUSE TYPE		
229 / 3	62M-1266	Mountainash Three (5 Bedroom) Elev 3		

1 - PLUG - ELECTRICAL PLUG WITH GFI AND SWITCH - FOR FESTIVE LIGHTING 07Jul21 Note:	
2 - FAN - BATHROOM EXHAUST FAN - ENERGY STAR 80 CFM - IN LIEU OF STANDARD FAN - ENSUITE 4/5 BATHROOM & MASTER ENSUITE BATHROOM 07Jul21 Note:	
1 - PLUG - ELECTRICAL PLUG - INSTALLED 5' FROM FLOOR - MASTER BEDROOM 07Jul21 Note:	
1 - PLUG - ELECTRICAL PLUG - TO BE INSTALLED OVER FIREPLACE 07Jul21 Note:	
1 - STANDARD DINING ROOM LIGHT TO BE CENTERED BETWEEN LIVING AND DINING ROOM 07Jul21 Note:	
1 - PLUG - ELECTRICAL PLUG - ADD TO ISLAND 07Jul21 Note:	
1 - RELOCATE STANDARD KITCHEN LIGHT TO BE CENTERED OVER ISLAND 07Jul21 Note:	
1 - POT LIGHT - LED - FIRST FLOOR INSTALLATION - INSTALLED ON SEPERATE SWITCH FROM STANDARD LIGHT - KITCHEN WORKSPACE 07Jul21 Note:	
1 - POT LIGHT - LED - FIRST FLOOR INSTALLATION - INSTALLED ON SEPERATE SWITCH FROM STANDARD LIGHT - KITCHEN BREAKFAST 07Jul21 Note:	
1 - POT LIGHT - LED - FIRST FLOOR INSTALLATION - INSTALLED ON SEPERATE SWITCH FROM STANDARD LIGHT - FAMILY ROOM 07Jul21 Note:	
1 - POT LIGHT - LED - FIRST FLOOR INSTALLATION - INSTALLED ON SEPERATE SWITCH FROM STANDARD LIGHT - LIVING/DINING ROOM 07Jul21 Note:	
1 - POT LIGHT - LED - FIRST FLOOR INSTALLATION - INSTALLED ON SEPERATE SWITCH FROM STANDARD LIGHT - HOME OFFICE 07Jul21 Note:	
1 - POT LIGHT - LED - FIRST FLOOR INSTALLATION - INSTALLED ON SEPERATE SWITCH FROM STANDARD LIGHT - FOYER 07Jul21 Note:	

FIREPLACE AND ACCESSORIES

1 - FIREPLACE - ADD MARBLE HEARTH TO FIREPLACE - STANDARD MARBLE 12Jul21 Note:	
1 - GAS LINE ROUGH-IN FOR STOVE (INCLUDES ELECTRICAL OUTLET) - FIRST FLOOR 07Jul21 Note:	

HARDWOOD FLOORING

1 - LAMINATE – UPGRADE TO PARKLANE SERIES IN LIEU OF STANDARD LAMINATE 07Jul21 Note:	
--	--

CONSTRUCTION SUMMARY

Mountainview Heights 3 (G) - Russell Gardens Building Ltd.

PURCHASERS: HARDIK Pankajkumar PATEL and BINAKUMARI HASMUKHBHAI PATEL

TEL: RES.: 289-772-5366

LOT / PHASE	REG. PLAN #	HOUSE TYPE		
229 / 3	62M-1266	Mountainash Three (5 Bedroom) Elev 3		
1 - HARDWOOD - GROUP B SERIES 5 INCH - IN LIEU OF 2 1/4 INCH NATURAL RED OAK - - LIVING AND DINING ROOM 07Jul21 Note:				
1 - HARDWOOD - GROUP B SERIES 5 INCH - IN LIEU OF 2 1/4 INCH NATURAL RED OAK - - LIBRARY/DEN 07Jul21 Note:				
1 - HARDWOOD - GROUP B SERIES 5 INCH - IN LIEU OF 2 1/4 INCH NATURAL RED OAK - - FAMILY ROOM 07Jul21 Note:				

PLASTER MOULDINGS

1 - CORNICE MOULDING - - FAMILY ROOM - INSTALLED INSIDE COFFERED CEILING 07Jul21 Note:	
---	--

PROMOTIONAL

1 - LESS CREDIT FROM PURCHASER EXTRA SHEET IN OFFER 07Jul21 Note:	
--	--

STAIRS AND RAILINGS

1 - STAINED STAIRS – STANDARD STAIRCASE - PRICE IS PER SET 07Jul21 Note:	
1 - STAIRCASE - V GROOVE HANDRAIL 07Jul21 Note:	
1 - STAIRCASE - EUROLINE 1 IRON PICKETS - BLACK 07Jul21 Note:	

EXTRAS AS PER OFFER

(1) The Vendor agrees that notwithstanding any other term or provision in this Agreement included in the Purchase Price and in addition to those items detailed in Schedule GP to the Agreement of Purchase and Sale, the Purchaser is entitled to a credit of Worksheet Note:	
200 AMP SERVICE LABELLED WITH CIRCUIT BREAKER PANEL TO UTILITY AUTHORITY STANDARDS. Worksheet Note:	
Purchase Price includes 3 enlarged basement windows, and the obligation to construct the house with the enlarged basement windows is subject to the Vendor's approval, in its sole and unfettered discretion The Purchaser acknowledges and agrees that the lo Worksheet Note:	
10 foot ceiling height on Main Floor. The Purchaser acknowledges that as a result of the increased ceiling height from the Vendor's standard ceiling height, various modifications to the interior and exterior of the dwelling unit may be made, including bu Worksheet Note:	
Delete wall in bedroom 5 as per sketch dated August 22, 2020. Worksheet Note:	
BEDROOM 2 WALK-IN CLOSET TO BE REVISED AS PER SKETCH DATED AUGUST 22, 2020. HEREBY REDUCING CLOSET SIZE IN BEDROOM #2 AND ADDING EXTRA CLOSET IN MASTER BEDROOM Worksheet Note:	
PURCHASER(S) ACKNOWLEDGES THAT THE PURCHASE PRICE IS INCLUSIVE OF ALL CREDITS AND PROMOTIONAL PACKAGES AVAILABLE AT TIME OF PURCHASE. Worksheet Note:	

Purchasers:

Telephone Res. / Bus:

Decor Advisor:

Lock Date:

HARDIK Pankajkumar PATEL & BINAKUMARI H

(289) 772-5366 /

Candace Forza

7-Jul-21

Property: 229

Project: Russell Gardens Building Ltd.

Model and Elevation: Mountainash Three (5 Bedroom) Elev 3

Plan #: 62M-1266

Layout Changes:

Sketch Attached:

Exterior Colour Scheme:

☒ Yes ☐ No

☒ Yes ☐ No

1. Cabinetry

	Style and Colour	Hardware
Kitchen / Breakfast	DORAL W-500	431SA
Laundry Room	ELISSE	Standard
Powder Room	SABRA 350 PLATINUM SILVER	431SA
Master Ensuite Bathroom	DORAL K38 RIVERSIDE	431SA
Ensuite Bath - Bedroom 2/3	DORAL H3078 HACIENDA WHITE	431SA
Ensuite Bath - Bedroom 3/4	SABRA 814 DARK DARK CHOCOLATE	431SA
	N/A	N/A
	N/A	N/A
	N/A	N/A

Appliances:

Built In Appliances ☒ Yes ☐ No

Slide In Stove ☐ Yes ☒ No

Dishwasher Cabinet ☐ Closed ☒ Open

41" Upper Cabinets ☒ Yes ☐ No

Please NOTE: Standard Cabinet Height is 30"

Stove Opening

NOTE: If not specified, opening will be set to builder's standard opening of approximately 30" width

Fridge Opening

NOTE: If not specified, opening will be set to builder's standard opening of approximately 37" width x 74" height

BUILT-IN OVEN/MICRO ONLY ** Refer to Construction Summary

2. Counters

	Counter	Edge
Kitchen / Breakfast	LAMINATE-PEARL SOAPSTONE 4886-38	
Laundry Room	N/A	
Powder Room	LAMINATE-WHITE CARRARA 4924-38	
Master Ensuite Bathroom	LAMINATE-PALOMA POLAR 6698-46	
Ensuite Bath - Bedroom 2/3	LAMINATE-INUK SHUK GREY P-344 LM	
Ensuite Bath - Bedroom 3/4	LAMINATE-WHITE CARRARA 4924-38	
	N/A	
	N/A	
	N/A	

** Refer to Construction Summary

Purchasers: HARDIK Pankajkumar PATEL & BINAKUMARI H.

Property: 229

Telephone Res. / Bus: (289) 772-5366 /

Project: Russell Gardens Building Ltd.

Decor Advisor: Candace Forza

Model and Elevation: Mountainash Three (5 Bedroom) Elev 3

Lock Date: 7-Jul-21

7-Jul-21

Plan #: 62M-1266

3. Ceramic Flooring

At a 45 Threshold-If App.

Entrance Vestibule	TILE-TRAVERTINO MEMENTO BIANCO-24X24	☐	metal strip where applicable
Main Hall	N/A	☐	
Kitchen / Breakfast	TILE-TRAVERTINO MEMENTO BIANCO-24X24	☐	
Laundry Room	TILE-ESSENZE GRIGIO-13X13	☐	
Powder Room	TILE-TRAVERTINO MEMENTO BIANCO-24X24	☐	
Master Ensuite Bathroom	TILE-STONE DARK GREY-12 1/4 X 24 1/4	☐	
Ensuite Bath - Bedroom 2/3	TILE-IROC MULTICOLOUR-12X24	☐	
Ensuite Bath - Bedroom 4/5	TILE-AXIS LIGHT GREY NAT-12X24	☐	
	N/A	☐	
	N/A	☐	
	N/A	☐	

** Refer to Construction Summary

4. Ceramic Wall Tile

	Selection	Describe
Master Ensuite Bathroom		
Tub Deck Wall	N/A	
Tub Deck	N/A	
Tub Deck Skirt	N/A	
Shower Stall	SEE BELOW	
Bathtub Enclosure Walls	N/A	
Ensuite Bath - Bedroom 2/3	TILE-IROC WHITE-12X24	
Ensuite Bath - Bedroom 4/5	TILE-LIFE ICE-12X24	
	N/A	
	N/A	
	N/A	
Kitchen Backsplash	N/A	

MASTER ENSUTE BATHROOM - SHOWER WALLS - TILE-STONE DARK GREY-12 1/4 X 24 1/4 ON BACK WALL & TILE-STONE WHITE -12 1/4 X 24 1/4 ON SIDE WALLS

** Refer to Construction Summary - STANDARD GROUT THROUGHOUT UNLESS SPECIFIED

5. Plumbing Fixtures

All Bathrooms

White

N/A

N/A

Whirlpool

N/A ☐ Yes ☒ No

Dishwasher Rough-In

☒ Yes ☐ No

Waterline for Fridge

☒ Yes ☐ No

** Refer to Construction Summary

6. Trim Carpentry

Interior Doors	CARRARA-SMOOTH
Interior Trim	As Per Construction Specifications
Door Handles	As Per Construction Specifications
Exterior Front Door Handle	As Per Construction Specifications

** Refer to Construction Summary

Purchasers:

Telephone Res. / Bus:

Decor Advisor:

Lock Date:

HARDIK Pankajkumar PATEL & BINAKUMARI H.

(289) 772-5366 /

Candace Forza

7-Jul-21

Property: 229

Project: Russell Gardens Building Ltd.

Model and Elevation: Mountainash Three (5 Bedroom) Elev 3

Plan #: 62M-1266

7. Other Flooring

Main Hall	N/A	
Living Room	STRIP-VINTAGE-NSS-WIRE BRUSHED-CHARACTER-UV URETHANE OIL-RED OAK-TITAN-5"	
Dining Room	STRIP-VINTAGE-NSS-WIRE BRUSHED-CHARACTER-UV URETHANE OIL-RED OAK-TITAN-5"	
Family Room	STRIP-VINTAGE-NSS-WIRE BRUSHED-CHARACTER-UV URETHANE OIL-RED OAK-TITAN-5"	
Den / Library / Study	STRIP-VINTAGE-NSS-WIRE BRUSHED-CHARACTER-UV URETHANE OIL-RED OAK-TITAN-5"	
Basement Landing(If Applies)	N/A	
Lower Landing (If Applies)	N/A	
Upper Landing	STRIP-VINTAGE-NSS-WIRE BRUSHED-CHARACTER-UV URETHANE OIL-RED OAK-TITAN-5"	
Upper Hall	LAMINATE-PARK LANE-VENICE OAK GREY-TL-EL3906	
Master Bedroom	LAMINATE-PARK LANE-VENICE OAK GREY-TL-EL3906	
Bedroom #2	LAMINATE-PARK LANE-VENICE OAK GREY-TL-EL3906	
Bedroom #3	LAMINATE-PARK LANE-VENICE OAK GREY-TL-EL3906	
Bedroom #4	LAMINATE-PARK LANE-VENICE OAK GREY-TL-EL3906	
Bedroom #5	LAMINATE-PARK LANE-VENICE OAK GREY-TL-EL3906	
	N/A	
	N/A	
	N/A	
Underpad	Type	Area
	N/A	N/A

** Refer to Construction Summary

8. Railings and Pickets

Railing Type	V-GROOVE	Colour	VINTAGE TITAN RED OAK
Picket Type	EUROLINE 1	Colour	BLACK
Stringer / Riser	AS PER CONSTRUCTION SPECIFICATIO	Colour	VINTAGE TITAN RED OAK
Treads	AS PER CONSTRUCTION SPECIFICATIO	Colour	VINTAGE TITAN RED OAK

Red Oak Stairs with Semi Gloss Finish

☒ Yes ☐ No

** Refer to Construction Summary THE STAIN COLOURS OR FINISH AVAILABLE ON RISERS, TREADS, PICKETS AND RAILS (STAIRCASES), WILL NOT BE AN EXACT MATCH TO PREFINISHED HARDWOOD OR LAMINATE FLOORS.

9. Wall Paint Flat Finish

Main & Upper Hall	22 WARM GREY	Master Bedroom	22 WARM GREY
Living Room	22 WARM GREY	Bedroom #2	22 WARM GREY
Dining Room	22 WARM GREY	Bedroom #3	22 WARM GREY
Kitchen / Breakfast	22 WARM GREY	Bedroom #4	22 WARM GREY
Family Room	22 WARM GREY	Bedroom #5	22 WARM GREY
Powder Room	22 WARM GREY	Master Ensuite	22 WARM GREY
Laundry Room	22 WARM GREY	Ensuite Bath - Bedroom 2/3	22 WARM GREY
Den/Library	22 WARM GREY	Ensuite Bath - Bedroom 4/5	22 WARM GREY
Trim Paint-Semi Gloss	BIRCH WHITE		N/A
	N/A		N/A
	N/A		N/A

Smooth Ceilings First Floor ☐ Yes ☒ No

** Refer to Construction Summary

Initials:

H.P.

B.

Purchasers: HARDIK Pankajkumar PATEL & BINAKUMARI H

Property: 229

Telephone Res. / Bus: (289) 772-5366 /

Project: Russell Gardens Building Ltd.

Decor Advisor: Candace Forza

Model and Elevation: Mountainash Three (5 Bedroom) Elev 3

Lock Date: 12-Jul-21

7-Jul-21

Plan #: 62M-1266

10. Plaster Mouldings and Medallions

Entrance Vestibule	N/A	N/A	Kitchen/Breakfast	N/A	N/A
Main Hall	N/A	N/A	Den/Library	N/A	N/A
Living Room	N/A	N/A	Lower Landing	N/A	N/A
Dining Room	N/A	N/A		N/A	N/A
Family Room	UP714	N/A			

** Refer to Construction Summary

11. Fireplace

	Living Room			Family Room			Other Room - Specify		
	Purchased	As Per Plan	N/A	Purchased	As Per Plan	N/A	Purchased	As Per Plan	N/A
Fireplace Type	☐	☐	☒	☐	☒	☐	☐	☐	☒
Mantle Type	N/A			FLAT ON WALL CABINET			N/A		
Colour / Stain	N/A			MANTLE M2-STANDARD			N/A		
Surround	N/A			AS PER CONSTRUCTION SPECIFICATIONS			N/A		
Hearth	N/A			NERO			N/A		
	N/A			YES			N/A		

** Refer to Construction Summary

12. Heating and Air Conditioning

Air Conditioning	NO	Gas Provisions Stove	YES
Gas Provisions Dryer	NO	Gas Provisions Barbecue	NO
Comment			

** Refer to Construction Summary

13. Electrical

Plugs and Switches	☒ White	DECOR	Above Kitchen Cabinet Light	☐ Yes	☒ No
Hood Fan	STANDARD WHITE		Below Kitchen Cabinet Light	☐ Yes	☒ No
Appliances	Built in Cooktop	Built in Oven	Gas Stove	Microwave	
	☐ Yes ☒ No	☒ Yes ☐ No	☒ Yes ☐ No	☒ Yes ☐ No	
Dishwasher Rough-in	Yes				

** Refer to Construction Summary

14. General Comments

** Refer to Construction Summary

Disclaimers and Notes


- 1) Colours of all materials are as close as possible to builder's selection, but not necessarily identical due to variances in manufacturing.
- 2) Any extras listed above are null and void unless accompanied by a separate invoice/amendment. Said invoice must be paid in full.
- 3) The Purchaser agrees that this colour selection is final and that no changes will be permitted, unless required by the Vendor.
- 4) The Purchaser acknowledges reading and accepting document which contains other miscellaneous disclaimers.

Signature: 

Date: _____




Signature: _____

Date: _____

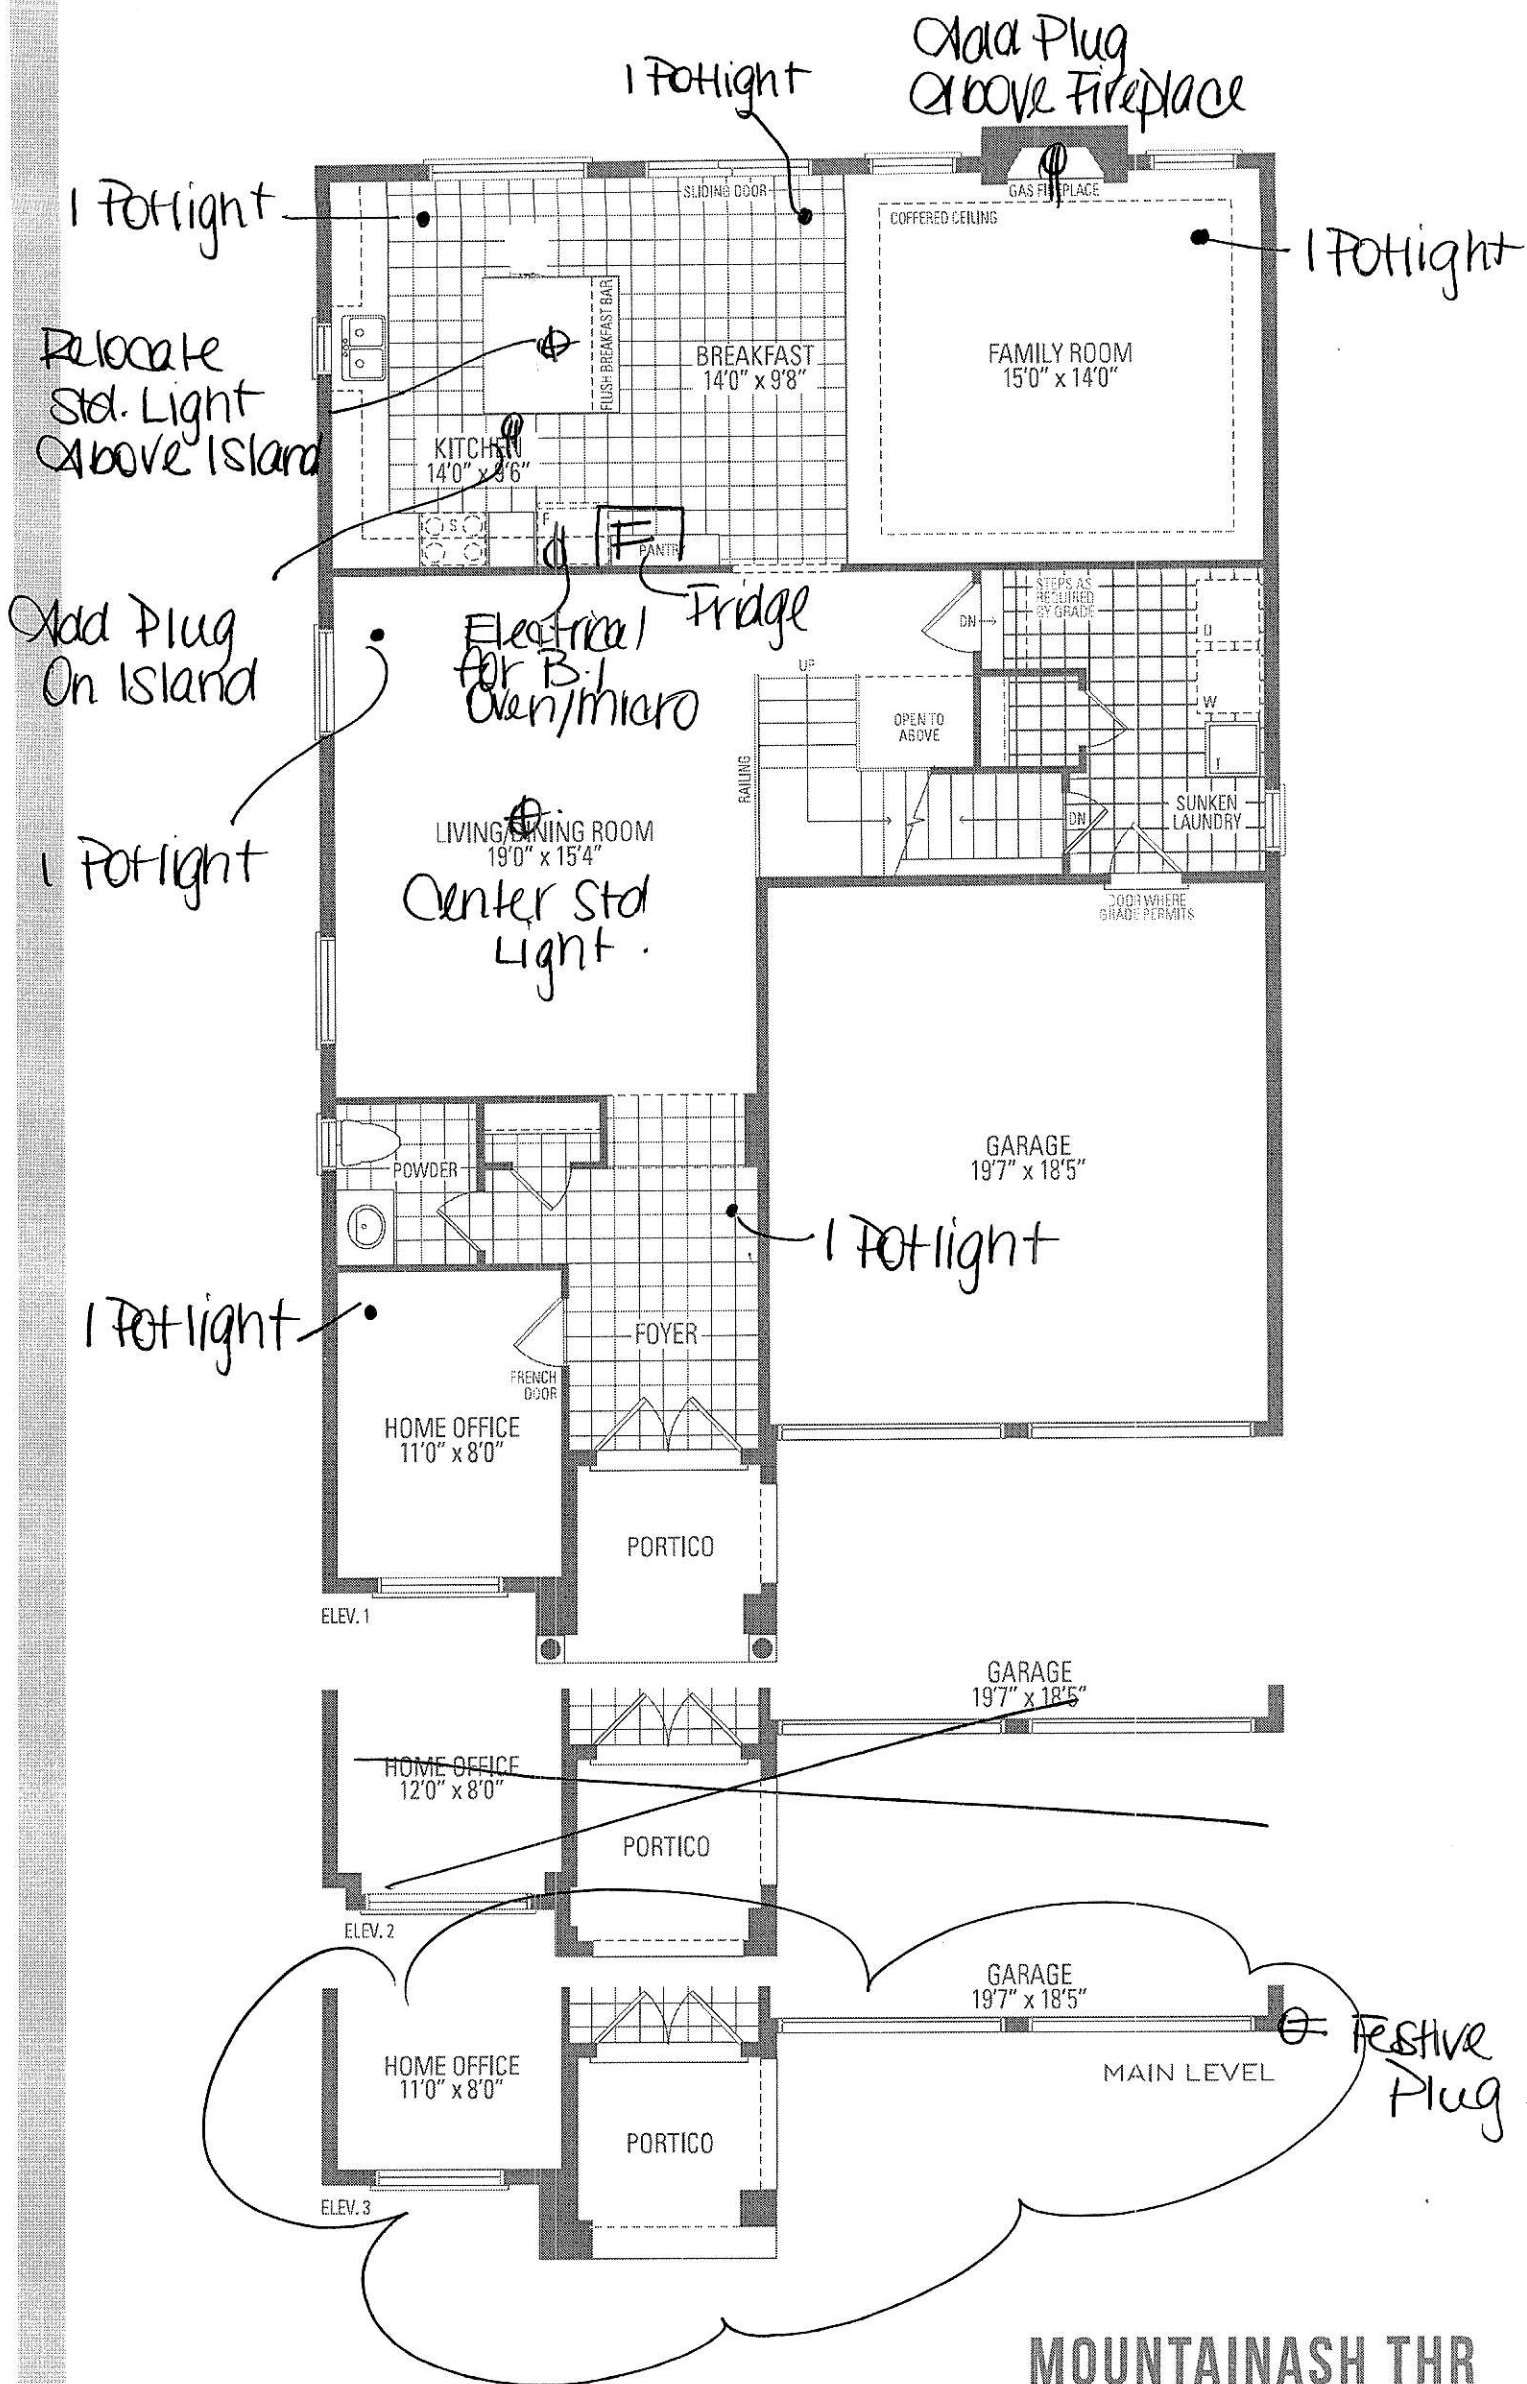


MOUNTAINASH THR

Orientation of home may be reversed and purchaser agree the stated floor areas. All renderings are artist's concept. Dime

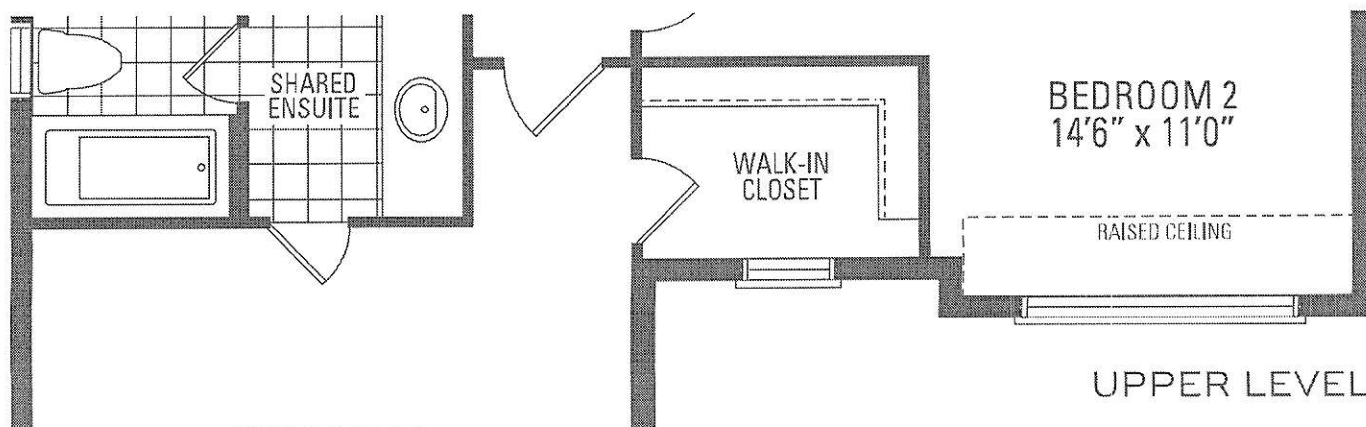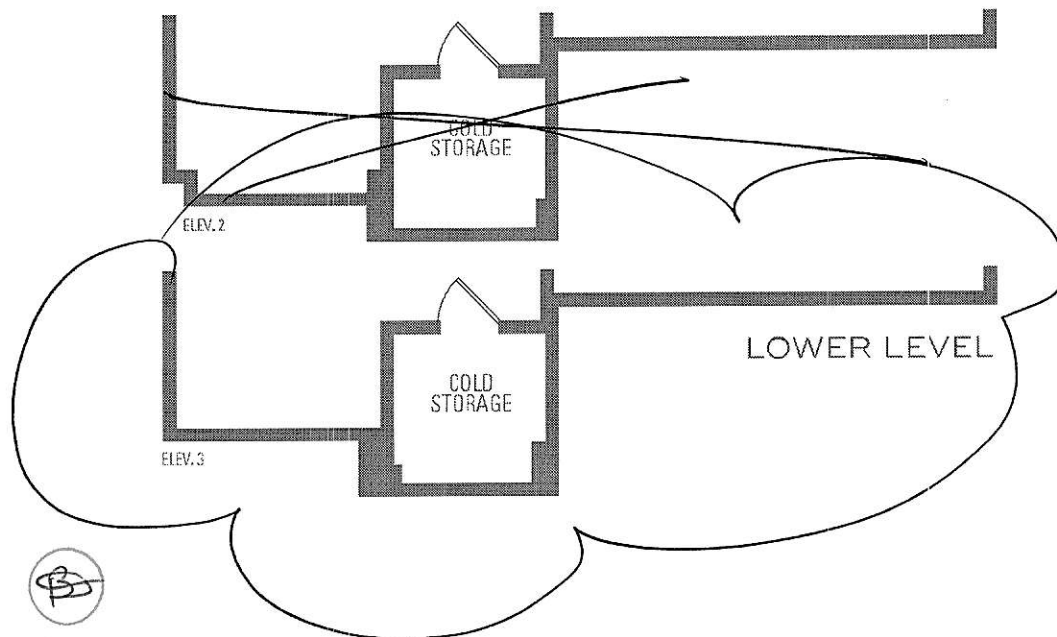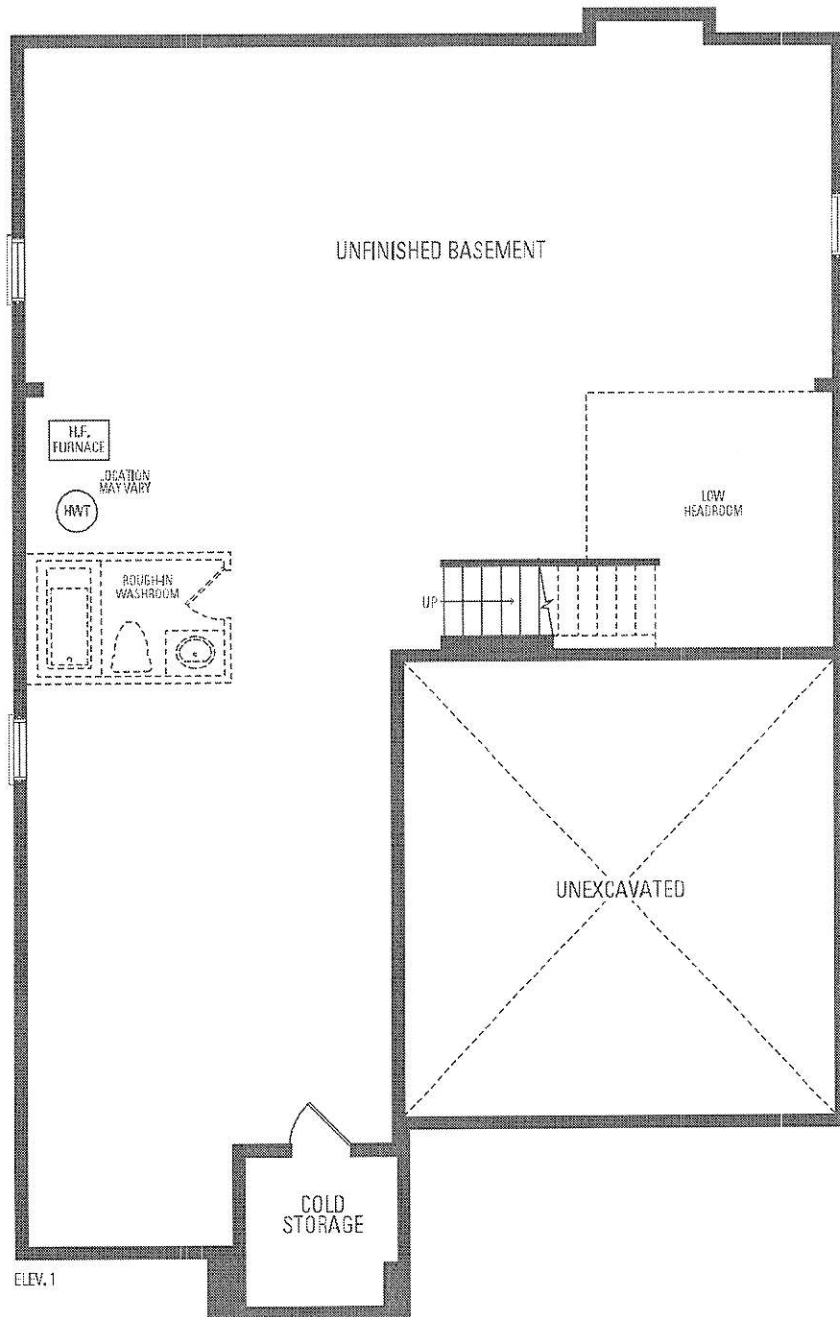

* Purchasers
Deadline
Full Depth
Fridge upper
+ Full Depth
Pantry.

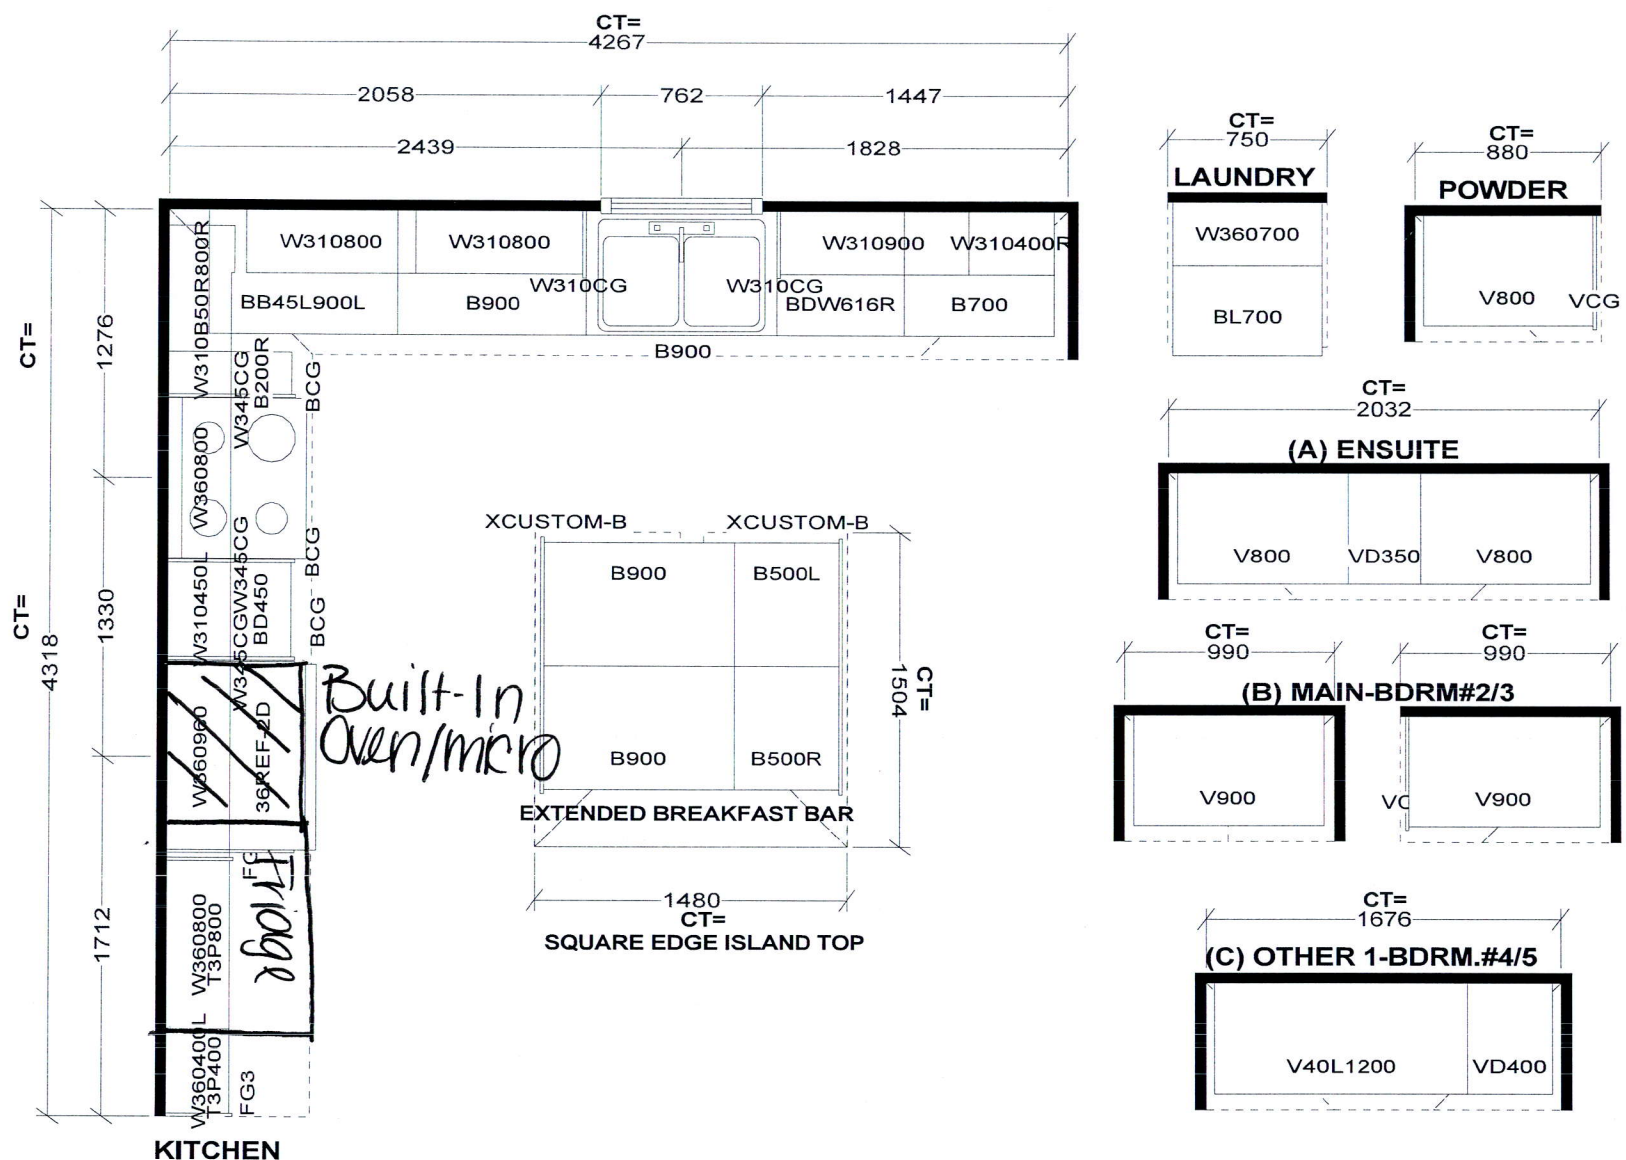

Built-In
Oven/micro

KITCHEN

Selba Industries

J#

W WIDTH _____ W HGHT _____ W CNT _____

FLOOR HGHT _____ DOOR HGHT _____

ST. CENT _____ 2X4 _____ VENT BOX COVER _____

This drawing is the intellectual property of SELBA INDUSTRIES INC. and is an original design which must not be released or copied unless applicable fee has been paid or job order placed.


DESIGNER: KS
DATE: MAY 13 20

JOB NUMBER:
BUILDER: GREENPARK
SITE: RUSSELL GARDENS PH.3
MODEL: MOUNTAINASH 3X OPT 5 BDRM EL 1,2,3
LOT #:

FRIGIDAIRE GALLERY

FGMC3066U D/F

FOURS À MICRO-
ONDES COMBINÉS
ÉLECTRIQUE - 30 PO (76,2 CM)

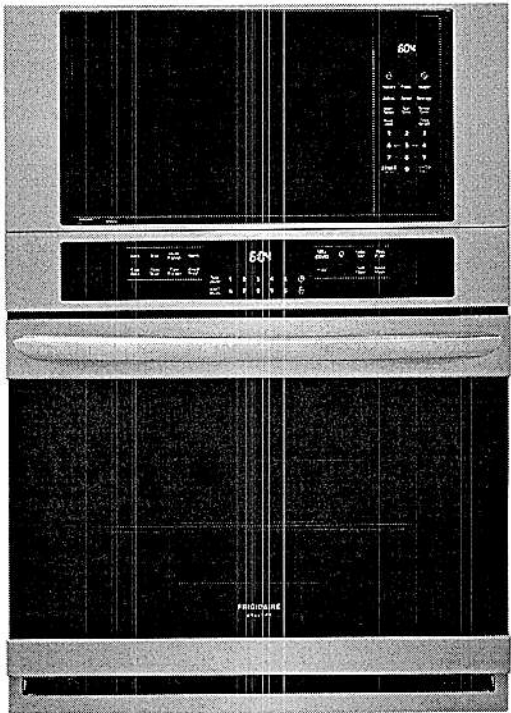

COULEURS
OFFERTES

D

Inox
noir

F

Inoxydable

DIMENSIONS DU PRODUIT

Hauteur (max.)	41-1/4 po (104,76 cm)
Largeur	30 po (76,2 cm)
Profondeur	24-3/4 po (62,86 cm)

DAVANTAGE DE CARACTÉRISTIQUES CONVIVIALES

Options capteur de cuisson
Le micro-ondes règle automatiquement la puissance et le temps de cuisson pour cuire un grand nombre d'aliments facilement.

Smudge-Proof^{MD} en acier inoxydable
Résiste aux traces de doigts et se nettoie facilement. Offert avec des finitions en acier inoxydable et en acier inoxydable noir.

Notre four offrant la plus grande capacité
Cuisinez plus de plats simultanément grâce à une capacité de four de 5,1 pieds cubes (144,4 l).

Plus de 30 options de réglage
Offre de multiples réglages pour répondre à vos besoins en matière de cuisson, y compris les croquettes de poulet et les collations.

Facile à nettoyer grâce à sa qualité autonettoyante
Votre four se nettoie tout seul, vous laissant libre de vaquer à vos occupations. Options d'autonettoyage disponibles par cycles de 2, 3 et 4 heures.

Réchauffage Effortless^{MC}
Réchauffez presque tout d'une simple pression sur un bouton.

Réglage pour garder au chaud en une touche
Il suffit d'appuyer sur un bouton pour garder les aliments au chaud jusqu'à ce que tout – et tout le monde – soit prêt.

Option de nettoyage différé
Réglez le four pour commencer le nettoyage selon vos horaires.

Nettoyage à la vapeur
Nettoyage léger du four en 30 minutes, sans produits chimiques, sans odeurs et rapide.

CERTIFICATIONS

Certifié Star-K^{MD} (mode Sabbath)

CARACTÉRISTIQUES EXCLUSIVES

Des résultats de cuisson plus rapides et plus homogènes grâce à la convection véritable
Obtenez une cuisson plus rapide et plus homogène sur grilles multiples grâce à une convection par ventilateur puissant et à un troisième élément chauffant qui fait circuler l'air chaud à travers le four.

Préchauffage rapide
Préchauffez en quelques minutes.¹

Sonde thermique Effortless^{MC}
La Sonde thermique Effortless^{MC} détecte et avertit lorsque la température de cuisson finale désirée est atteinte et passe automatiquement au réglage pour garder au chaud.

Micro-ondes Fits-More^{MC}
Micro-ondes très grand offrant un espace de cuisson de 2,0 pi³ (56,6 l)

¹ En fonction des performances de cuisson sur une seule grille, température non définie, en utilisant le préchauffage rapide.

FGMC3066U D/F
FOUR À MICRO-ONDES COMBINÉ
ÉLECTRIQUE - 30 PO (76.2 CM)

FRIGIDAIRE
GALLERY

CARACTÉRISTIQUES

Système de commande/Système de chronométrage	Commandes Express-Select™ ^{1D}
Finition extérieure des portes	Inoxydable Smudge-Proof™ ^{CD} Acier (F), Inox noir (D) Smudge-Proof™ ^{CD}
Conception des poignées	Acier inoxydable (F), Inox noir (D)

CARACTÉRISTIQUES DU MICRO-ONDES

Capacité du micro-ondes (pi³)	1,6
W (méthode de vérification IEC-705)	1 100
Fenêtre	Grande
Éclairage intérieur	Oui
Couleur intérieure	Blanc
Diamètre du plateau tournant	13,5 po (34,29 cm)
Marche/Arrêt du plateau tournant	
Dispositif de verrouillage/Horloge	Oui/Oui
Touches du pavé tactile/Niveaux de puissance	28/11

OPTIONS DE COMMANDE DU MICRO-ONDES

Touche Maïs à éclater	Oui
Touche Légumes (frais/congelés)	2
Touche Pomme de terre	Oui
Touche de réchauffage	Oui
Options faire fondre/ramollir automatiquement	4
Options de réchauffage automatique	3
Options de cuisson automatique	3
Options de décongélation automatique	3
Ajouter 30 secondes	Oui
Options capteur de cuisson	4
Démarrage différé/Préférences utilisateur	Oui/Oui

CARACTÉRISTIQUES DU FOUR

Capacité (pi³)	5,1
Fenêtre du four	Grande
Éclairage du four	2 lampes halogènes
Élément de cuisson dissimulé	Oui
Système de convection	Convection véritable
Système de cuisson	Technologie de cuisson homogène
Système de grillage	Vari-Broil™ ^{CC} (haut/bas)
Préchauffage rapide	Oui
Élément de cuisson/gril (watts)	2 200/4 000
Configuration de la grille de four	1 grille coulissante à extension/ 1 grille à poignée
Système de nettoyage du four	Autonettoyage/nettoyage à la vapeur

COMMANDES DU FOUR

Dispositif de verrouillage	Oui
Démarrage différé	Oui
Fonction convection	Effortless™ ^{CC}
Sonde thermique Effortless™ ^{CC}	Oui
Garder au chaud/ajouter une minute	Oui/Non

ACCESSOIRES OPTIONNELS

Garniture inférieure d'une hauteur de 3 po (7,62 cm) - Inoxydable Acier (F)/Acier inoxydable noir (D)	(F) PN : 5304520627 (D) PN : 5304520624
Long câble d'alimentation armé de 10 pi (3,04 m)	PN : 903056-9010

CERTIFICATIONS

Certifié par Star-K™ ^{CD} (mode Sabbath)	Oui
---	-----

SPÉCIFICATIONS


Intérieur du four à micro-ondes (H x L x P)	10-1/2 x 17-3/8 x 18-5/8 po (26,67 x 44,13 x 47,31 cm)
Intérieur du four (H x L x P)	18-5/8 x 24-1/8 x 19-1/2 po (47,31 x 61,27 x 49,53 cm)
Emplacement du raccordement électrique	Arrière inférieur gauche
Tension nominale	240/208 V/60 Hz
Charge connectée (puissance nominale kW) à 240/208 volts	7,9/5,9
Ampères à 240/208 volts	30,38/35,25
Circuit minimum requis (ampères)	30
Poids d'expédition (approx.)	300 lb (136,07 kg)

DIMENSIONS DU PRODUIT

A - Hauteur (max.)	41-1/4 po (104,76 cm)
B - Largeur	30 po (76,2 cm)
C - Profondeur	24-3/4 po (62,86 cm)
D - Hauteur (emballage)	40-4/5 po (103,63 cm)
E - Largeur (emballage)	28-1/4 po (71,75 cm)
Profondeur avec porte ouverte à 90°	45-1/8 po (114,61 cm)

DIMENSIONS DES DÉCOUPES DU MEUBLE

Hauteur (min.)/(max.)	41-1/8 po/41-1/4 po (104,75 cm/104,77 cm)
Largeur (min.)/(max.)	28-1/2 po/29 po (72,39 cm/73,66 cm)
Profondeur (min.)	23-3/4 po (60,32 cm)

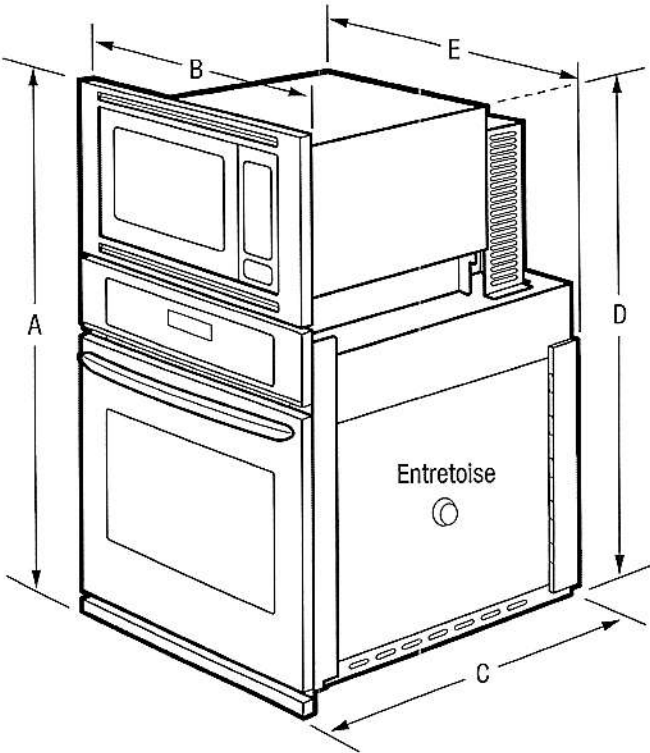


¹ Câble monophasé à 3 ou 4 fils, alimentation 120/240 ou 120/208 volts, 60 hertz CA uniquement avec mise à la terre requise sur un circuit séparé et des fusibles des deux côtés de la conduite.
Remarque : Aux fins de planification seulement. Consultez systématiquement les codes locaux et nationaux d'électricité, de gaz et de plomberie. Reportez-vous au guide d'installation du produit pour des instructions d'installation détaillées sur le web à frigidaire.com/frigidaire.ca.
Spécifications sujettes à modification. Informations sur les accessoires offerts sur le web à frigidaire.com/frigidaire.ca

FGMC3066U D/F

FOUR À MICRO-ONDES COMBINÉ

ÉLECTRIQUE - 30 PO (76,2 CM)

FRIGIDAIRE
GALLERY

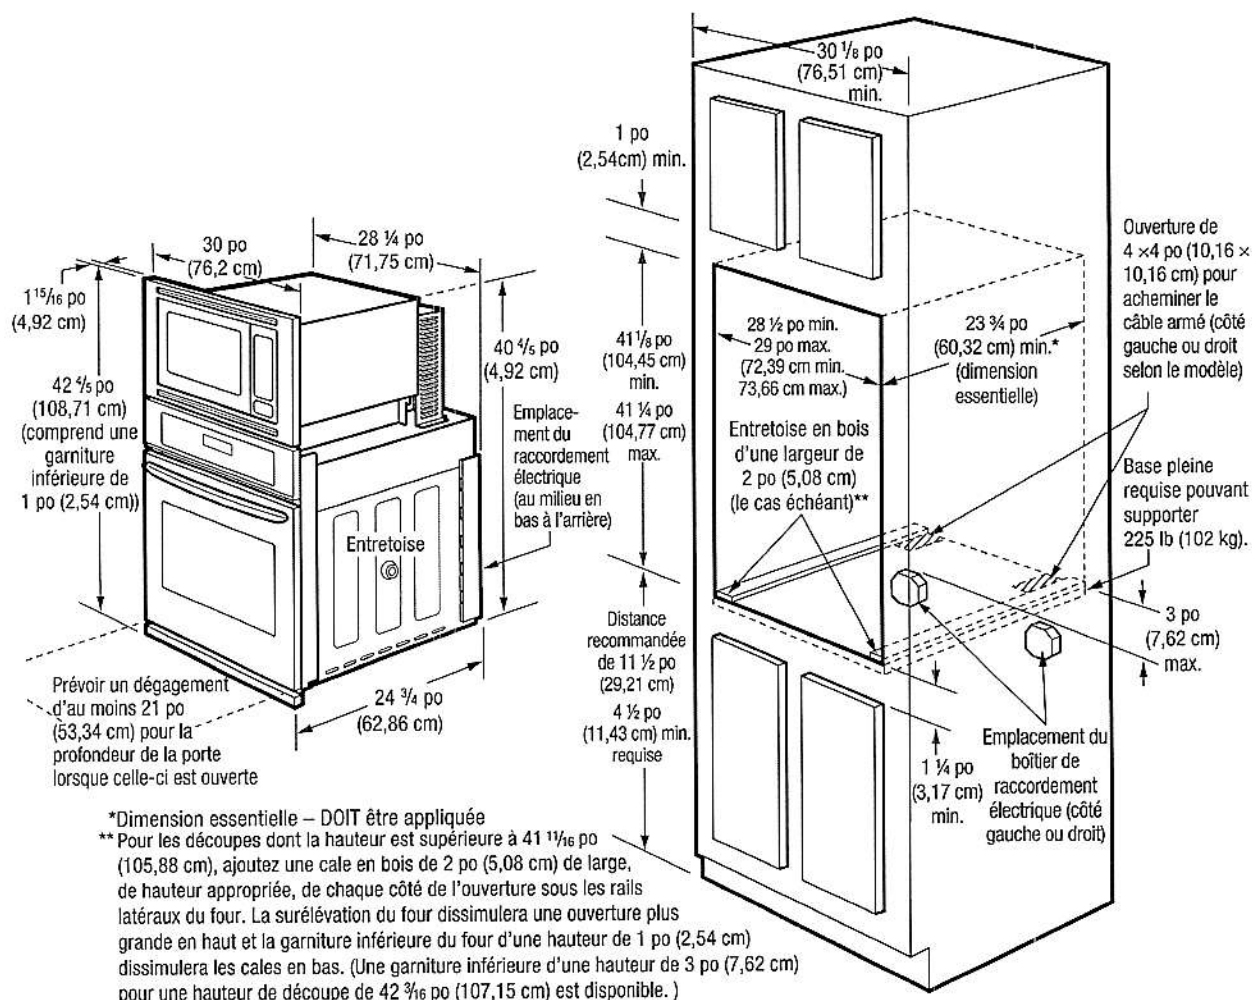

SPÉCIFICATIONS D'INSTALLATION

- Poids d'expédition du produit (approx.) - 300 lb (136,07 kg)
- Câble monophasé à 3 ou 4 fils, alimentation 120/240 ou 120/208 volts, 60 hertz CA uniquement avec mise à la terre requise sur un circuit séparé et des fusibles des deux côtés de la conduite.
- Charge connectée (puissance nominale en kilowatt) à 240/208 V = 7,9/5,9 kW
- Ampères à 240/208 volts = 30,38/35,25
- Disjoncteur recommandé - 30 A
- Consultez systématiquement les codes locaux et nationaux d'électricité.
- Un dégagement minimal de 21 po (53,34 cm) pour la profondeur de la porte du four lorsque celle-ci est ouverte.
- La distance par rapport au plancher recommandée est de 11-1/2 po (29,21 cm). Distance minimale requise de 4-1/2 po (11,43 cm).
- Pour que le four à micro-ondes combiné tienne dans une découpe dont la hauteur est supérieure à 41-11/16 po (105,88 cm), ajoutez une cale en bois de 2 po (5,08 cm) de large d'une hauteur appropriée de chaque côté de l'ouverture sous les rails latéraux du four. La surélévation du four dissimulera une ouverture plus grande en haut et la garniture inférieure du four d'une hauteur de 1 po (2,54 cm) dissimulera les cales en bas. (Garniture inférieure standard d'une hauteur de 1 po (2,54 cm) comprise)

- Pour que le four à micro-ondes combiné tienne dans une découpe dont la hauteur est supérieure à 42-3/16 po (107,15 cm), une garniture inférieure d'une hauteur de 3 po (7,62 cm) est disponible.
- Une découpe d'au moins 24 po (60,96 cm) est essentielle pour installer correctement le four et s'assurer que le plateau du four tournera sans heurter la porte.
- Base complète pour four en contre-plaqué plein ou matériau similaire au besoin et pouvant supporter 225 lb (102,06 kg).
- La base doit être à niveau et les côtés doivent être égaux.
- Les fours à micro-ondes combinés NE sont PAS approuvés pour être utilisés dans une installation empilable ou côte à côte.

ACCESSOIRES OPTIONNELS

- Garniture inférieure en acier inoxydable d'une hauteur de 3 po (7,62 cm) - (PN : 5304520627)
- Garniture inférieure en inox noir d'une hauteur de 3 po (7,62 cm) - (PN : 5304520624)
- Long câble d'alimentation armé de 10 pi (3,04 m) - (PN° 903056-9010).



Remarque : Aux fins de planification seulement. Consultez systématiquement les codes locaux et nationaux d'électricité, de gaz et de plomberie. Reportez-vous au guide d'installation du produit pour des instructions d'installation détaillées sur le web à frigidaire.com/frigidaire.ca.
Spécifications sujettes à modification. Informations sur les accessoires offerts sur le web à frigidaire.com/frigidaire.ca

FRIGIDAIRE
É.-U. • 10200 David Taylor Drive • Charlotte, NC 28262 • 1 800 FRIGIDAIRE • frigidaire.com
CANADA • 5855 Terry Fox Way • Mississauga, ON L5V 3E4 • 1 800 265-8352 • frigidaire.ca

FGMC3066U 02/19
© 2019 Electrolux Home Products, Inc.

