Greenpark.

										_
(	'ON	STR	IIC	TIC	N	SIIN	IIV	TA	R	Y

Mountainview Heights 3 (G) - Russell Gardens Building Ltd.

AUG 12 2021

PURCHASERS: SABA	HAQUE and SANAM	HAQUE CHANNA
------------------	-----------------	--------------

LOT / PHASE 224/3


REG. PLAN #	HOUSE TYPE	
62M-1266	Mountainash Twelve Elev 3	

ABINETRY ACCESSORIES
- KICTHEN - ROTATE ISLAND AS PER SKETCH
10Aug21 Note:
CONSTRUCTION
CONSTRUCTION  TO A CONTRUCTION PROCESS ON FIRST SLOOP ONLY DET
1 - SMOOTH CEILINGS ON FIRST FLOOR ONLY - DET
10Aug21 Note:
ELECTICAL
1 - PLUG – ROUGH-IN FOR ELECTRIC CAR PLUG IN GARAGE – FOR FUTURE ELECTRIC CAR – 240V / 40-50 AMPS
10Aug21 Note: SPECIFICATIONS REQUIRED
EX ECTIVICAL S
ELECTRICAL  TO DE NOTA LE PROPERTIE A POVE ISLAND AND ON SAME SWITCH AS WORK SPACE
1 - KITCHEN - RELOACTE BREAKFAST LIGHT TO BE INSTALLED ABOVE ISLAND AND ON SAME SWITCH AS WORK SPACE LIGHT
10Aug21 Note:
1 - LIGHT AND SWITCH - NO FIXTURE INCLUDED - INSTALLED ABOVE STAIRCASE - UPPER HALL
10Aug21 Note:
1 - DINING ROOM - RELOCATE STANDARD LIGHT AS PER SKETCH - IF CONSTRUCTION PERMITS
10Aug21 Note:
1 - BUILT IN OVEN AND COOKTOP PROVISION - PROVISION ONLY - ELECTRICAL ONLY
10Aug21 Note:
1 - PLUG - ELECTRICAL PLUG - INSTALLED 5' FROM FLOOR - FLEX ROOM
10Aug21 Note:
1 - SWITCH - DIMMER SWITCH IN LIEU OF EXISTING SWITCH - LIBRARY
10Aug21 Note:
1 - SWITCH - DIMMER SWITCH IN LIEU OF EXISTING SWITCH - KITCHEN
10Aug21 Note:
1 - SWITCH - DIMMER SWITCH IN LIEU OF EXISTING SWITCH - DINING ROOM/ HALL WAY
10Aug21 Note:
1 - SWITCH - DIMMER SWITCH IN LIEU OF EXISTING SWITCH - FAMILY ROOM
10Aug21 Note:
3 - FAN - BATHROOM EXHAUST FAN - ENERGY STAR 80 CFM - IN LIEU OF STANDARD FAN - ALL ENSUITE BATHROOMS
10Aug21 Note:
1 - SWITCH - DIMMER SWITCH IN LIEU OF EXISTING SWITCH - MASTER BEDROOM
10Aug21 Note:
1 - RELOCATE STANDARD KITCHEN LIGHT TO BE CENTERED OVER ISLAND
10Aug21 Note:
1 - PLUG - ELECTRICAL PLUG WITH GFI AND SWITCH - FOR FESTIVE LIGHTING
10Aug21 Note:

Greenpark.

		INSTRUCTION SUMMARY				
		w Heights 3 (G) - Russell Gardens Building I	⊥td.			
PURCHASERS: SABA HAC	QUE and SANAM HAQU	JE CHANNA			TE	EL:
LOT / PHASE	REG. PLAN#	HOUSE TYPE				
224/3	62M-1266	Mountainash Twelve Elev 3			<u> </u>	
1 - PLUG - ELECTRICAL PI	LUG - TO BE INSTALLE	ED OVER FIREPLACE				
10Aug21 Note:						
1 - LIGHT AND SWITCH - 1	O FIXTURE INCLUDE	D - LIVING ROOM				
10Aug21 Note:						
	TO ENTERINE BIOLINE	CD MACTED DEDDOOM				
1 - LIGHT AND SWITCH - 1 RELOCATE STADNARD L	NO FIXTURE INCLUDE IGHT TO ACCOMMOD	ATE - SEE SKETCH				
10Aug21 Note:						
FIREPLACE AND ACCI	ESSORIES					
		S ELECTRICAL OUTLET) - FIRST FLOOR				
10Aug21 Note:	,					
PLUMBING						
	LAND AND ADJUST S	INK AND DISHAWASHER LOCATION - SEE SKETC	CH			
10Aug21 Note:						
1 - WATER LINE FOR FRII	OGE - ROUGH-IN ONLY	Y				
10Aug21 Note:						
	,					
PROMOTIONAL						
1 - PARTIAL REDEMTION	OF PROMOTIONAL PA	ACKAGE \$11,815.00 BALANCE FORWARD (\$10,185	5.00) TO BI	E USED AT A	A LATER	
DATE. ORIGINAL PROMO 10Aug21 Note:	TIONAL PACKAGE OF	F \$22,000.00 AS PER SCHEDULE PE.				
TOAugzi Note.						
	7	TWEN A C A C BED OFFED				
		EXTRAS AS PER OFFER				
(1) The Vendor agrees tha	t notwithstanding any o	other term or provision in this Agreement included	in the Purc	hase Price a	ind in	
addition to those items det	tailed in Schedule GP to	o the Agreement of Purchase and Sale, the Purchase	er is entitle	ed to a credit	t of	
Worksheet Note:						
8-foot 6-inch basement co	ncrete pour.					
If the Purchaser has purch	ased or been provided	with an 8-foot 6-inch basement concrete pour (bein	g an increa	ase from the	Vendor?s	
standard basement depth) Worksheet Note:	the depth is measured f	from the top of footing to the top of				
worksheet Note.						
		WE DREAMED BANKS TO LITTLE TO ALTHOUGH	TV CT AN	DARDC		
200 AMP SERVICE LAE Worksheet Note:	BELLED WITH CIRCU	JIT BREAKER PANEL TO UTILITY AUTHORI	IY SIAN	DAKDS.		
worksheet Note.						
Dunchass Duise in the L. D.	OLID (4) onlarged been	ement windows, and the obligation to construct the	house with	the enlarge	d	
basement windows is subi	ect to the Vendor?s and	proval, in its sole and unfettered discretion The Pu	rchaser acl	knowledges	and	
agrees t	·FI	•				
Worksheet Note:						
PURCHASER(S) ACKN	OWLEDGES THAT T	HE PURCHASE PRICE IS INCLUSIVE OF ALL	CREDITS	AND		
PROMOTIONAL PACK		AT TIME OF PURCHASE.				
Worksheet Note:						

This Document is Extremely Time Sensitive - Printed  $\underline{10~Aug~21}$  at  $\underline{12:42}$ 

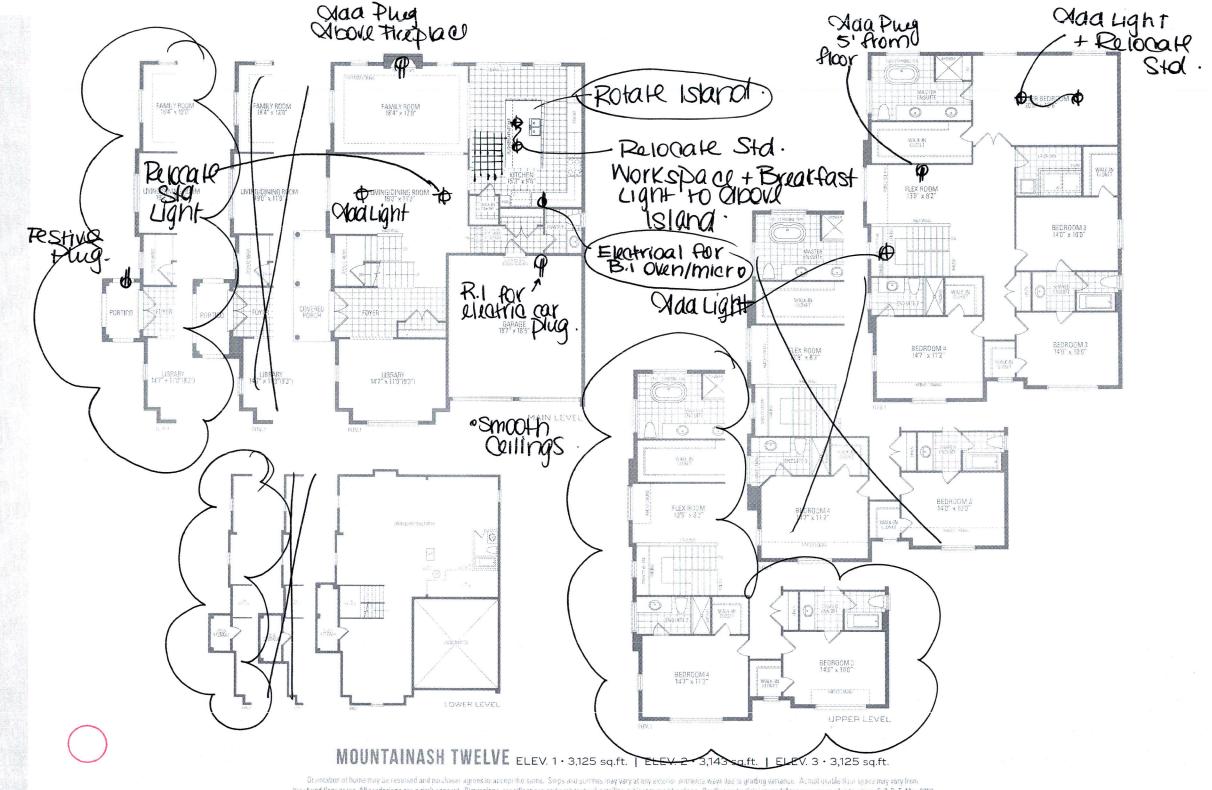

the stared floor areas. All renderings are a tist's encount. Dimensions, specifications and architectural detailing subject to modifications. Reofline and adjoining model types may vary due to sning. E. & D. E. May 2020