

CONSTRUCTION SUMMARY

Mountainview Heights 3 (G) - Russell Gardens Building Ltd.

PURCHASERS: CH BASHARAT AZEEM and RABIA BASHARAT

TEL:

LOT / PHASE	REG. PLAN #	HOUSE TYPE		
335 / 3	62M-1266	Mountainash Five (5 Bedroom) Elev 2		

CABINETRY ACCESSORIES

1 - KITCHEN CABINETRY BASE - BANK OF DRAWERS - STANDARD 12Aug21 Note: EXTRA	
1 - KITCHEN - REVISE LAYOUT - RELOCATE FRIDGE AND PANTRY TO WET BAR - SEE SKETCH 12Aug21 Note:	
1 - PANTRY UNIT UPGRADE - TO GO FROM 300MM TO 600MM DEEP - PRICE IS PER FOOT - STANDARD 12Aug21 Note:	
1 - KITCHEN CABINETRY UPPER - FULL DEPTH ABOVE FRIDGE - WITH GABLES - 600MM - PRICE IS EACH - STANDARD 12Aug21 Note:	
1 - KITCHEN CABINETRY - BUILT-IN MICROWAVE/OVEN COMBO - STANDARD 12Aug21 Note:	
1 - KITCHEN CABINETRY BASE - COOKTOP CABINET WITH POT DRAWERS (2 DRAWERS) - STANDARD 12Aug21 Note:	

CERAMIC TILE

1 - DELETE ALL CERAMIC BATHROOM ACCESSORIES - DELETE TOWEL BAR, PAPER HOLDER & SOAP DISH THROUGHOUT 12Aug21 Note:	
1 - TILE - UPGRADE 2 FLOOR TILE - - POWDER ROOM 12Aug21 Note: Staggered	1
1 - TILE - UPGRADE 2 FLOOR TILE - - MUD ROOM 12Aug21 Note:	3
1 - TILE - UPGRADE 2 FLOOR TILE - - KITCHEN 12Aug21 Note:	4
1 - TILE - UPGRADE 2 FLOOR TILE - - FOYER 12Aug21 Note:	2
1 - PRICE IS FOR LABOUR ONLY - INSTALL TILE IN A STAGGERED PATTERN - - POWDER ROOM 12Aug21 Note:	1
1 - PRICE IS FOR LABOUR ONLY - INSTALL TILE IN A STAGGERED PATTERN - - MUD ROOM 12Aug21 Note:	3
1 - PRICE IS FOR LABOUR ONLY - INSTALL TILE IN A STAGGERED PATTERN - - KITCHEN 12Aug21 Note:	4
1 - PRICE IS FOR LABOUR ONLY - INSTALL TILE IN A STAGGERED PATTERN - - FOYER 12Aug21 Note:	2
1 - PRICE IS FOR LABOUR ONLY - INSTALL TILE IN A STAGGERED PATTERN - - BATHROOM 4/5 - SHOWER 12Aug21 Note:	
1 - PRICE IS FOR LABOUR ONLY - INSTALL TILE IN A STAGGERED PATTERN - - BATHROOM 4/5 - FLOOR 12Aug21 Note:	

CONSTRUCTION SUMMARY

Mountainview Heights 3 (G) - Russell Gardens Building Ltd.

PURCHASERS: CH BASHARAT AZEEM and RABIA BASHARAT

TEL:

LOT / PHASE	REG. PLAN #	HOUSE TYPE		
335 / 3	62M-1266	Mountainash Five (5 Bedroom) Elev 2		
1 - PRICE IS FOR LABOUR ONLY - INSTALL TILE IN A STAGGERED PATTERN - - BATHROOM 2/3 - SHOWER 12Aug21 Note:				
1 - PRICE IS FOR LABOUR ONLY - INSTALL TILE IN A STAGGERED PATTERN - - BATHROOM 2/3 - FLOOR 12Aug21 Note:				
1 - PRICE IS FOR LABOUR ONLY - INSTALL TILE IN A STAGGERED PATTERN - - ENSUITE WALL TILE - SHOWER 12Aug21 Note:				
1 - PRICE IS FOR LABOUR ONLY - INSTALL TILE IN A STAGGERED PATTERN - - ENSUITE BATHROOM - FLOOR 12Aug21 Note:				
1 - TILE - UPGRADE 2 WALL TILE - - ENSUITE WALL TILE - SHOWER 12Aug21 Note:				
1 - TILE - UPGRADE 2 FLOOR TILE - - ENSUITE BATHROOM - FLOOR 12Aug21 Note:				
1 - TILE - UPGRADE 1 WALL TILE - - BATHROOM 4/5 - SHOWER 12Aug21 Note:				
1 - TILE - UPGRADE 1 FLOOR TILE - - BATHROOM 4/5 - FLOOR 12Aug21 Note:				
1 - TILE - UPGRADE 1 FLOOR TILE - - BATHROOM 2/3 - SHOWER 12Aug21 Note:				
1 - TILE - UPGRADE 1 FLOOR TILE - - BATHROOM 2/3 - FLOOR 12Aug21 Note:				

CONSTRUCTION

1 - SMOOTH CEILINGS ON FIRST FLOOR ONLY - DET 12Aug21 Note:	
--	--

ELECTRICAL

1 - KITCHEN - RELOCATE FRIDGE TO WET BAR - SEE SKETCH 12Aug21 Note:	
1 - BUILT IN OVEN AND COOKTOP PROVISION - PROVISION ONLY - ELECTRICAL ONLY 12Aug21 Note:	
3 - FAN - BATHROOM EXHAUST FAN - ENERGY STAR 80 CFM - IN LIEU OF STANDARD FAN - ALL ENSUITE BATHROOMS 12Aug21 Note:	
1 - LIGHT AND SWITCH - NO FIXTURE INCLUDED - UPPER HALL 12Aug21 Note:	
1 - RELOCATE STANDARD KITCHEN LIGHT TO BE CENTERED OVER ISLAND 12Aug21 Note:	
1 - POT LIGHT - LED - FIRST FLOOR INSTALLATION - INSTALLED ON SEPERATE SWITCH FROM STANDARD LIGHT - KITCHEN BREAKFAST 12Aug21 Note:	

CONSTRUCTION SUMMARY

Mountainview Heights 3 (G) - Russell Gardens Building Ltd.

PURCHASERS: CH BASHARAT AZEEM and RABIA BASHARAT

TEL:

LOT / PHASE	REG. PLAN #	HOUSE TYPE		
335 / 3	62M-1266	Mountainash Five (5 Bedroom) Elev 2		
1 - POT LIGHT - LED - FIRST FLOOR INSTALLATION - INSTALLED ON SEPERATE SWITCH FROM STANDARD LIGHT - KITCHEN WORKSPACE 12Aug21 Note:				
1 - PLUG - ELECTRICAL PLUG - TO BE INSTALLED OVER FIREPLACE 12Aug21 Note:				
1 - POT LIGHT - LED - FIRST FLOOR INSTALLATION - INSTALLED ON SEPERATE SWITCH FROM STANDARD LIGHT - FAMILY ROOM 12Aug21 Note:				
1 - POT LIGHT - LED - FIRST FLOOR INSTALLATION - INSTALLED ON SEPERATE SWITCH FROM STANDARD LIGHT - LIVING/DINING ROOM 12Aug21 Note:				
1 - STANDARD DINING ROOM LIGHT TO BE CENTERED BETWEEN LIVING AND DINING ROOM 12Aug21 Note:				

FIREPLACE AND ACCESSORIES

1 - MANTEL - PAINTED - M 4 - IN LIEU OF STANDARD MANTEL 12Aug21 Note:	
1 - GAS LINE ROUGH-IN FOR STOVE (INCLUDES ELECTRICAL OUTLET) - FIRST FLOOR 12Aug21 Note:	

HARDWOOD FLOORING

1 - LAMINATE – UPGRADE TO PARKLANE SERIES IN LIEU OF STANDARD LAMINATE 12Aug21 Note:	
1 - HARDWOOD - GROUP B SERIES 5 INCH - IN LIEU OF 2 1/4 INCH NATURAL RED OAK - - MAIN HALL 12Aug21 Note:	
1 - HARDWOOD - GROUP B SERIES 5 INCH - IN LIEU OF 2 1/4 INCH NATURAL RED OAK - - LIVING AND DINING ROOM 12Aug21 Note:	
1 - HARDWOOD - GROUP B SERIES 5 INCH - IN LIEU OF 2 1/4 INCH NATURAL RED OAK - - LIBRARY/DEN 12Aug21 Note:	
1 - HARDWOOD - GROUP B SERIES 5 INCH - IN LIEU OF 2 1/4 INCH NATURAL RED OAK - - FAMILY ROOM 12Aug21 Note:	

MIRRORS AND GLASS

1 - MASTER ENSUITE – FRAMELESS GLASS SHOWER ENCLOSURE – INCLUDES CHROME KNOB AND HINGES - MASTER ENSUITE BATHROOM 12Aug21 Note:	
--	--

PLUMBING

1 - KITCHEN - WET BAR - RELOCATE BAR SINK TO ACCOMMODATE RELOCATION OF FRIDGE AND PANTRY - SEE SKETCH 12Aug21 Note:	
3 - TOE TESTER - ADD TOE TESTER TO SHOWER - ALL ENSUITE BATHROOMS 12Aug21 Note:	

CONSTRUCTION SUMMARY

Mountainview Heights 3 (G) - Russell Gardens Building Ltd.

PURCHASERS: CH BASHARAT AZEEM and RABIA BASHARAT

TEL:

LOT / PHASE 335 / 3	REG. PLAN # 62M-1266	HOUSE TYPE Mountainash Five (5 Bedroom) Elev 2		
------------------------	-------------------------	---	--	--

1 - 5 FOOT SHOWER WITH SLIDING GLASS CHROME DOORS IN LIEU OF TUB - ENSUITE 4/5 BATHROOM  
12Aug21 Note:

PROMOTIONAL

1 - LESS CREDIT FROM PURCHASER EXTRA SHEET IN OFFER

12Aug21 Note:

STAIRS AND RAILINGS

1 - STAINED STAIRS – STANDARD STAIRCASE - PRICE IS PER SET

12Aug21 Note:

1 - STAIRCASE - V GROOVE HANDRAIL

12Aug21 Note:

1 - STAIRCASE - 4 X 4 POSTS

12Aug21 Note:

1 - STAIRCASE - EUROLINE 2 IRON PICKETS - BLACK

12Aug21 Note:

EXTRAS AS PER OFFER

SUNKEN FOYER AS REQUIRED BY GRADE CONDITIONS.

Upgrade Note:

LOW HEADROOM UNDER SUNKEN FOYER.

Upgrade Note:

INSERT SKETCH DATED NOVEMBER 17, 2020, AS ATTACHED.

Upgrade Note:

10 foot ceiling height on Main Floor. The Purchaser acknowledges that as a result of the increased ceiling height from the Vendor's standard ceiling height, various modifications to the interior and exterior of the dwelling unit may be made, including bu

Worksheet Note:

(1) The Vendor agrees that notwithstanding any other term or provision in this Agreement included in the Purchase Price and in addition to those items detailed in Schedule GP to the Agreement of Purchase and Sale, the Purchaser is entitled to a credit of

Worksheet Note:

200 AMP SERVICE LABELLED WITH CIRCUIT BREAKER PANEL TO UTILITY AUTHORITY STANDARDS.

Worksheet Note:

Purchase Price includes Three enlarged basement windows, and the obligation to construct the house with the enlarged basement windows is subject to the Vendor's approval, in its sole and unfettered discretion The Purchaser acknowledges and agrees that

Worksheet Note:

PURCHASER(S) ACKNOWLEDGES THAT THE PURCHASE PRICE IS INCLUSIVE OF ALL CREDITS AND PROMOTIONAL PACKAGES AVAILABLE AT TIME OF PURCHASE.

Worksheet Note:

This Document is Extremely Time Sensitive - Printed 12 Aug 21 at 14:17

Purchasers:CH BASHARAT AZEEM & RABIA BASHARAT

Property: 335

Telephone Res. / Bus: /

Project: Russell Gardens Building Ltd.

Decor Advisor: Candace Forza

Model and Elevation: Mountainash Five (5 Bedroom) Elev 2

Lock Date: 12-Aug-21

12-Aug-21

Plan #: 62M-1266

Layout Changes: ☒ Yes ☐ No

Sketch Attached: ☒ Yes ☐ No

Exterior Colour Scheme:

1. Cabinetry

	Style and Colour	Hardware
Kitchen / Breakfast	CONTINENTAL 350 PLATINUM SILVER	431SA
Laundry Room	ELISSE	Standard
Powder Room	DORAL K38 RIVERSIDE	447SA
Master Ensuite Bathroom	MONACO 350 PLATINUM SILVER	431SA
Ensuite Bath - Bedroom 2/3	DORAL K44 TITAN GREY	113SB
Ensuite Bath - Bedroom 4/5	DORAL K44 TITAN GREY	190SA
	N/A	N/A
	N/A	N/A
	N/A	N/A

Appliances:

Built In Appliances ☒ Yes ☐ No

Slide In Stove ☐ Yes ☒ No

Dishwasher Cabinet ☐ Closed ☒ Open

41" Upper Cabinets ☒ Yes ☐ No

Please NOTE: Standard Cabinet Height is 30"

Stove Opening

NOTE: If not specified, opening will be set to builder's standard opening of approximately 30" width

Fridge Opening

NOTE: If not specified, opening will be set to builder's standard opening of approximately 37" width x 74" height

\*\* Refer to Construction Summary

2. Counters

	Counter	Edge
Kitchen / Breakfast	LAMINATE-CARRARA BIANCO 6696-46	
Laundry Room	N/A	
Powder Room	LAMINATE-PALOMA POLAR 6698-46	
Master Ensuite Bathroom	LAMINATE-PORTICO MARBLE 7735-58	
Ensuite Bath - Bedroom 2/3	LAMINATE-WHITE CARRARA 4924-38	
Ensuite Bath - Bedroom 4/5	LAMINATE-WHITE CARRARA 4924-38	
	N/A	
	N/A	
	N/A	

\*\* Refer to Construction Summary

Initials:

Purchasers:CH BASHARAT AZEEM & RABIA BASHARAT

Telephone Res. / Bus: /

Decor Advisor:Candace Forza

Lock Date:12-Aug-21

Property: 335

Project: Russell Gardens Building Ltd.

Model and Elevation: Mountainash Five (5 Bedroom) Elev 2

Plan #: 62M-1266

3. Ceramic Flooring

Entrance Vestibule	TILE-SUITE ICE-12X24***STAGGERED PATTERN***	<input type="checkbox"/>	At a 45 Threshold-If App. metal strip where applicable
Main Hall	STRIP	<input type="checkbox"/>	
Kitchen / Breakfast	TILE-SUITE ICE-12X24***STAGGERED PATTERN***	<input type="checkbox"/>	
Laundry Room	TILE-ESSENZE GRIGIO-13X13	<input type="checkbox"/>	
Powder Room	TILE-SUITE ICE-12X24***STAGGERED PATTERN***	<input type="checkbox"/>	
Master Ensuite Bathroom	TILE-IROC WHITE-12X24***STAGGERED PATTERN***	<input type="checkbox"/>	
Ensuite Bath - Bedroom 2/3	TILE-STONE WHITE-12 1/4 X 24 1/4***STAGGERED***	<input type="checkbox"/>	
Ensuite Bath - Bedroom 4/5	TILE-STONE WHITE-12 1/4 X 24 1/4***STAGGERED***	<input type="checkbox"/>	
MUD ROOM	TILE-SUITE ICE-12X24***STAGGERED PATTERN***	<input type="checkbox"/>	
	N/A	<input type="checkbox"/>	
	N/A	<input type="checkbox"/>	

\*\* Refer to Construction Summary

4. Ceramic Wall Tile

Master Ensuite Bathroom	Selection	Describe
Tub Deck Wall	N/A	
Tub Deck	N/A	
Tub Deck Skirt	N/A	
Shower Stall	TILE-IROC WHITE-12X24	***LAID IN A STAGGERED PATTERN***
Bathtub Enclosure Walls	N/A	
Ensuite Bath - Bedroom 2/3	TILE-STONE WHITE-12 1/4 X 24 1/4	***LAID IN A STAGGERED PATTERN***
Ensuite Bath - Bedroom 4/5	TILE-STONE WHITE-12 1/4 X 24 1/4	***LAID IN A STAGGERED PATTERN***
MUD ROOM	N/A	
	N/A	
	N/A	
Kitchen Backsplash	N/A	

\*\* Refer to Construction Summary - STANDARD GROUT THROUGHOUT UNLESS SPECIFIED

5. Plumbing Fixtures

All Bathrooms

White

N/A

N/A

Whirlpool

N/A

☒ Yes ☐ No

Dishwasher Rough-In

☒ Yes ☐ No

Waterline for Fridge

☐ Yes ☒ No

\*\* Refer to Construction Summary

6. Trim Carpentry

Interior Doors	CARRARA-SMOOTH
Interior Trim	As Per Construction Specifications
Door Handles	As Per Construction Specifications
Exterior Front Door Handle	As Per Construction Specifications

\*\* Refer to Construction Summary

Initials:

BA

Purchasers:CH BASHARAT AZEEM & RABIA BASHARAT

Telephone Res. / Bus: /

Decor Advisor:Candace Forza

Lock Date:12-Aug-21

Property: 335

Project: Russell Gardens Building Ltd.

Model and Elevation: Mountainash Five (5 Bedroom) Elev 2

Plan #: 62M-1266

7. Other Flooring

Main Hall	MIRAGE-IMAGINE-CHARACTER-CORK-RED OAK-DURAMATT-DRIFTWOOD-5"
Living Room	MIRAGE-IMAGINE-CHARACTER-CORK-RED OAK-DURAMATT-DRIFTWOOD-5"
Dining Room	MIRAGE-IMAGINE-CHARACTER-CORK-RED OAK-DURAMATT-DRIFTWOOD-5"
Family Room	MIRAGE-IMAGINE-CHARACTER-CORK-RED OAK-DURAMATT-DRIFTWOOD-5"
Den / Library / Study	MIRAGE-IMAGINE-CHARACTER-CORK-RED OAK-DURAMATT-DRIFTWOOD-5"
Basement Landing(If Applies)	N/A
Lower Landing (If Applies)	MIRAGE-IMAGINE-CHARACTER-CORK-RED OAK-DURAMATT-DRIFTWOOD-5"
Upper Landing	MIRAGE-IMAGINE-CHARACTER-CORK-RED OAK-DURAMATT-DRIFTWOOD-5"
Upper Hall	LAMINATE-PARKLANE-VENICE OAK GREY-TL-EL-3906
Master Bedroom	LAMINATE-PARKLANE-VENICE OAK GREY-TL-EL-3906
Bedroom #2	LAMINATE-PARKLANE-VENICE OAK GREY-TL-EL-3906
Bedroom #3	LAMINATE-PARKLANE-VENICE OAK GREY-TL-EL-3906
Bedroom #4	LAMINATE-PARKLANE-VENICE OAK GREY-TL-EL-3906
Bedroom #5	LAMINATE-PARKLANE-VENICE OAK GREY-TL-EL-3906
	N/A
	N/A
	N/A
Underpad	TypeArea
	N/AN/A

\*\* Refer to Construction Summary

8. Railings and Pickets

Railing Type	4X4 POSTS & V-GROOVE	Colour	MIRAGE DRIFTWOOD RED OAK
Picket Type	EUROLINE 2	Colour	BLACK
Stringer / Riser	AS PER CONSTRUCTION SPECIFICATIO	Colour	MIRAGE DRIFTWOOD RED OAK
Treads	AS PER CONSTRUCTION SPECIFICATIO	Colour	MIRAGE DRIFTWOOD RED OAK
Red Oak Stairs with Semi Gloss Finish		<input checked="" type="radio"/> Yes <input type="radio"/> No	


\*\* Refer to Construction Summary THE STAIN COLOURS OR FINISH AVAILABLE ON RISERS, TREADS, PICKETS AND RAILS (STAIRCASES), WILL NOT BE AN EXACT MATCH TO PREFINISHED HARDWOOD OR LAMINATE FLOORS.

9. Wall Paint Flat Finish

Main & Upper Hall	22 WARM GREY	Master Bedroom	22 WARM GREY
Living Room	22 WARM GREY	Bedroom #2	22 WARM GREY
Dining Room	22 WARM GREY	Bedroom #3	22 WARM GREY
Kitchen / Breakfast	22 WARM GREY	Bedroom #4	22 WARM GREY
Family Room	22 WARM GREY	Bedroom #5	22 WARM GREY
Powder Room	22 WARM GREY	Master Ensuite	22 WARM GREY
Laundry Room	22 WARM GREY	Ensuite Bath - Bedroom 2/3	22 WARM GREY
Den/Library	22 WARM GREY	Ensuite Bath - Bedroom 4/5	22 WARM GREY
Trim Paint-Semi Gloss	BIRCH WHITE	MUD ROOM	22 WARM GREY
	N/A		N/A
	N/A		N/A

Smooth Ceilings First Floor ☒ Yes ☐ No

\*\* Refer to Construction Summary

Initials: 

Purchasers:

CH BASHARAT AZEEM & RABIA BASHARAT

Property: 335

Telephone Res. / Bus:

/

Project: Russell Gardens Building Ltd.

Decor Advisor:

Candace Forza

Model and Elevation: Mountainash Five (5 Bedroom) Elev 2

Lock Date:

12-Aug-21

12-Aug-21

Plan #: 62M-1266

10. Plaster Mouldings and Medallions

Entrance Vestibule	N/A	N/A	Kitchen/Breakfast	N/A	N/A
Main Hall	N/A	N/A	Den/Library	N/A	N/A
Living Room	N/A	N/A	Lower Landing	N/A	N/A
Dining Room	N/A	N/A		N/A	N/A
Family Room	N/A	N/A			

\*\* Refer to Construction Summary

11. Fireplace

	Living Room			Family Room			Other Room - Specify		
	Purchased	As Per Plan	N/A	Purchased	As Per Plan	N/A	Purchased	As Per Plan	N/A
Fireplace Type	<input type="radio"/>	<input type="radio"/>	<input checked="" type="radio"/>	<input type="radio"/>	<input checked="" type="radio"/>	<input type="radio"/>	<input type="radio"/>	<input type="radio"/>	<input checked="" type="radio"/>
Mantle Type	N/A			FLAT ON WALL			N/A		
Colour / Stain	N/A			MANTLE M4			N/A		
Surround	N/A			AS PER CONSTRUCTION SPECIFICATIONS			N/A		
Hearth	N/A			BIANCO			N/A		
	N/A			NO			N/A		

\*\* Refer to Construction Summary

12. Heating and Air Conditioning

Air Conditioning	NO	Gas Provisions Stove	YES
Gas Provisions Dryer	NO	Gas Provisions Barbecue	NO
Comment			

\*\* Refer to Construction Summary

13. Electrical

Plugs and Switches	<input checked="" type="radio"/> White	DECOR	Above Kitchen Cabinet Light	<input type="radio"/> Yes	<input checked="" type="radio"/> No
Hood Fan	STANDARD WHITE		Below Kitchen Cabinet Light	<input type="radio"/> Yes	<input checked="" type="radio"/> No
Appliances	Built in Cooktop	Built in Oven	Gas Stove	Microwave	
	<input checked="" type="radio"/> Yes <input type="radio"/> No	<input checked="" type="radio"/> Yes <input type="radio"/> No	<input checked="" type="radio"/> Yes <input type="radio"/> No	<input checked="" type="radio"/> Yes <input type="radio"/> No	
Dishwasher Rough-in	Yes				

\*\* Refer to Construction Summary

14. General Comments

\*\* Refer to Construction Summary

Disclaimers and Notes

- 1) Colours of all materials are as close as possible to builder's selection, but not necessarily identical due to variances in manufacturing.

2) Any extras listed above are null and void unless accompanied by a separate invoice/amendment. Said invoice must be paid in full.

3) The Purchaser agrees that this colour selection is final and that no changes will be permitted, unless required by the Vendor.

4) The Purchaser acknowledges reading and accepting document which contains other miscellaneous disclaimers.

Signature: 

Date: Aug 12, 2021

Signature: \_\_\_\_\_

Date: \_\_\_\_\_

Add Potlight

1 Potlight

1 Potlight +

Add Plug Above Fireplace.

Add Potlight

Relocate Std Light Above Island.




Electrical for B.I. Oven/micro

Center Std Light

Relocated Bar Sink

Relocated Fridge

• 10' Ceiling •

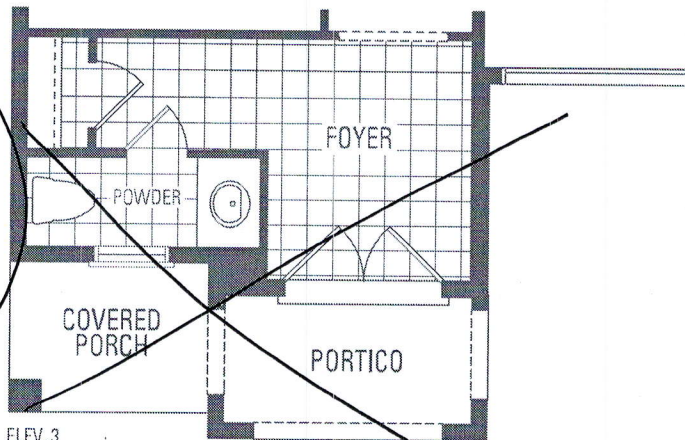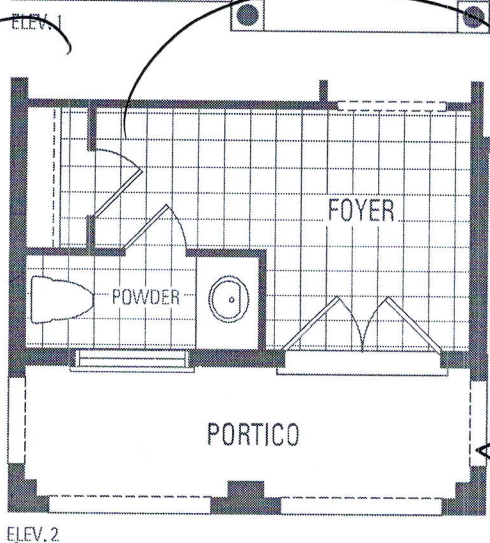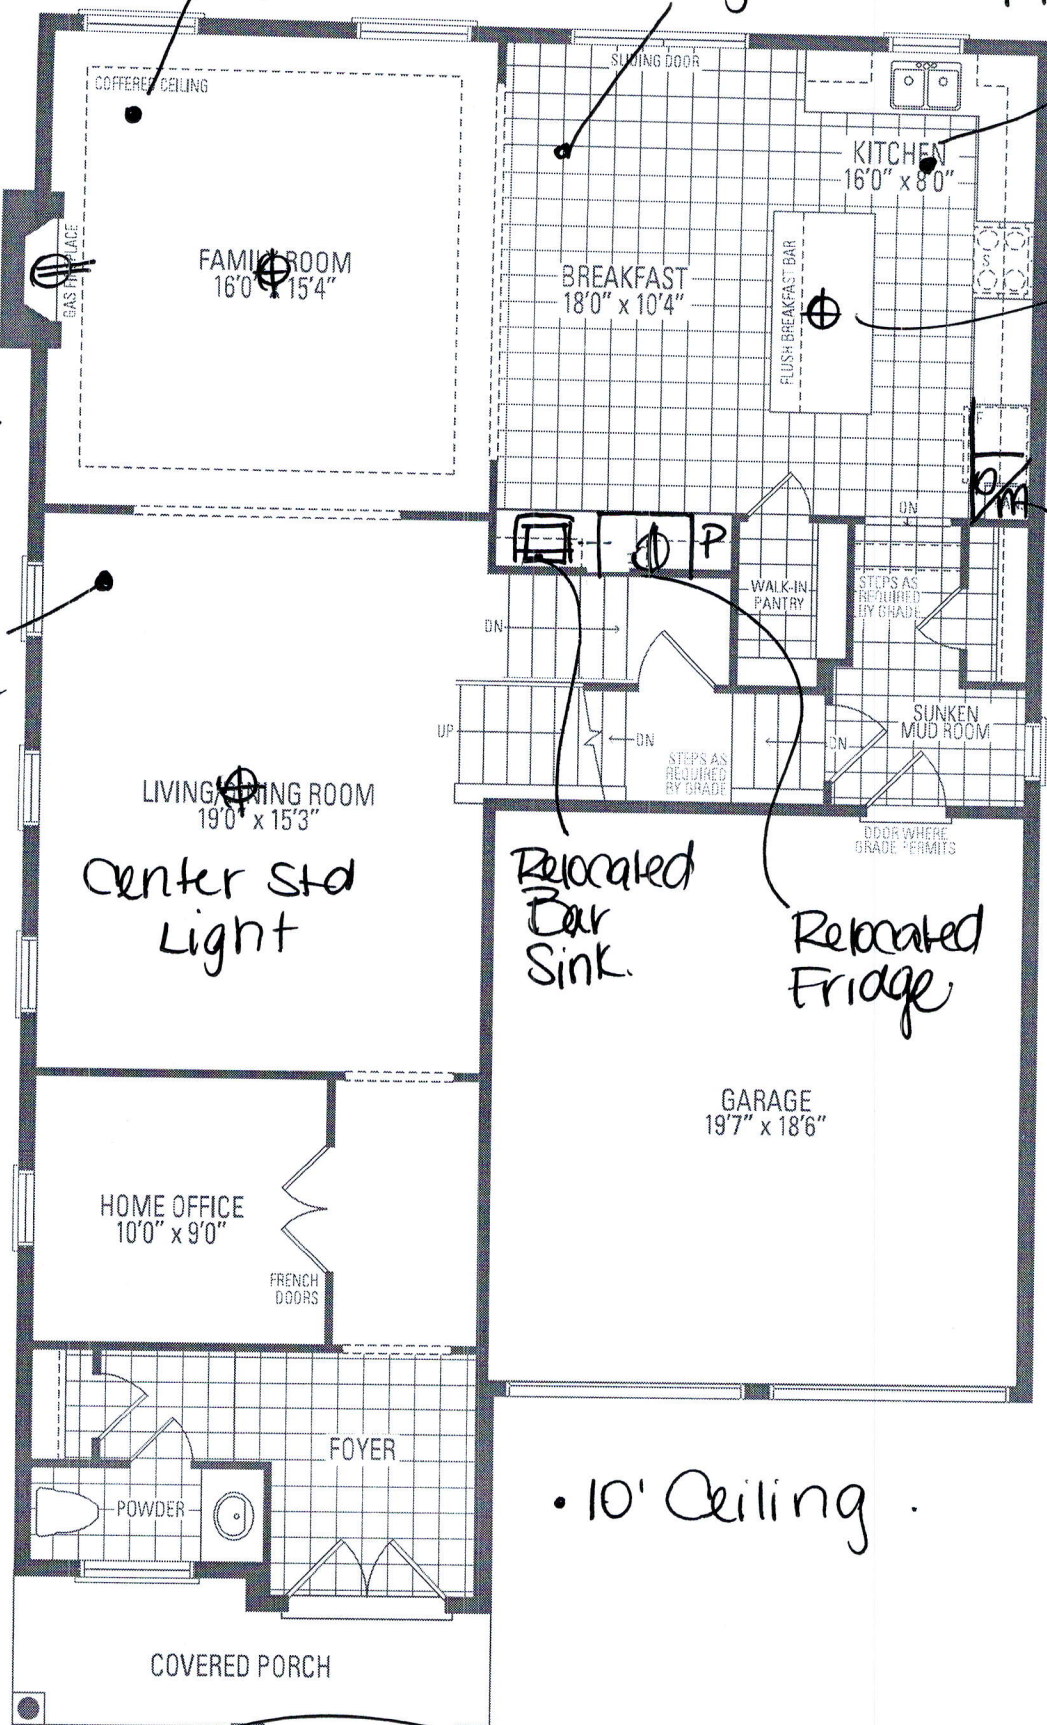

for

## MOUNTAINASH FIVE ELE

Orientation of home may be reversed and purchaser agrees to accept the stated floor areas. All renderings are artist's concept. Dimensions, speci


# 5 BEDROOM LAYOUT MOUNTAINASH FIVE

ELEV. 1 • 3,288 sq.ft. | ELEV. 2 • 3,291 sq.ft. | ELEV. 3 • 3,298 sq.ft.


Delete Wall  
Frameless Glass Enclosure

Add Light

5' Shower  
In Lieu of  
tub

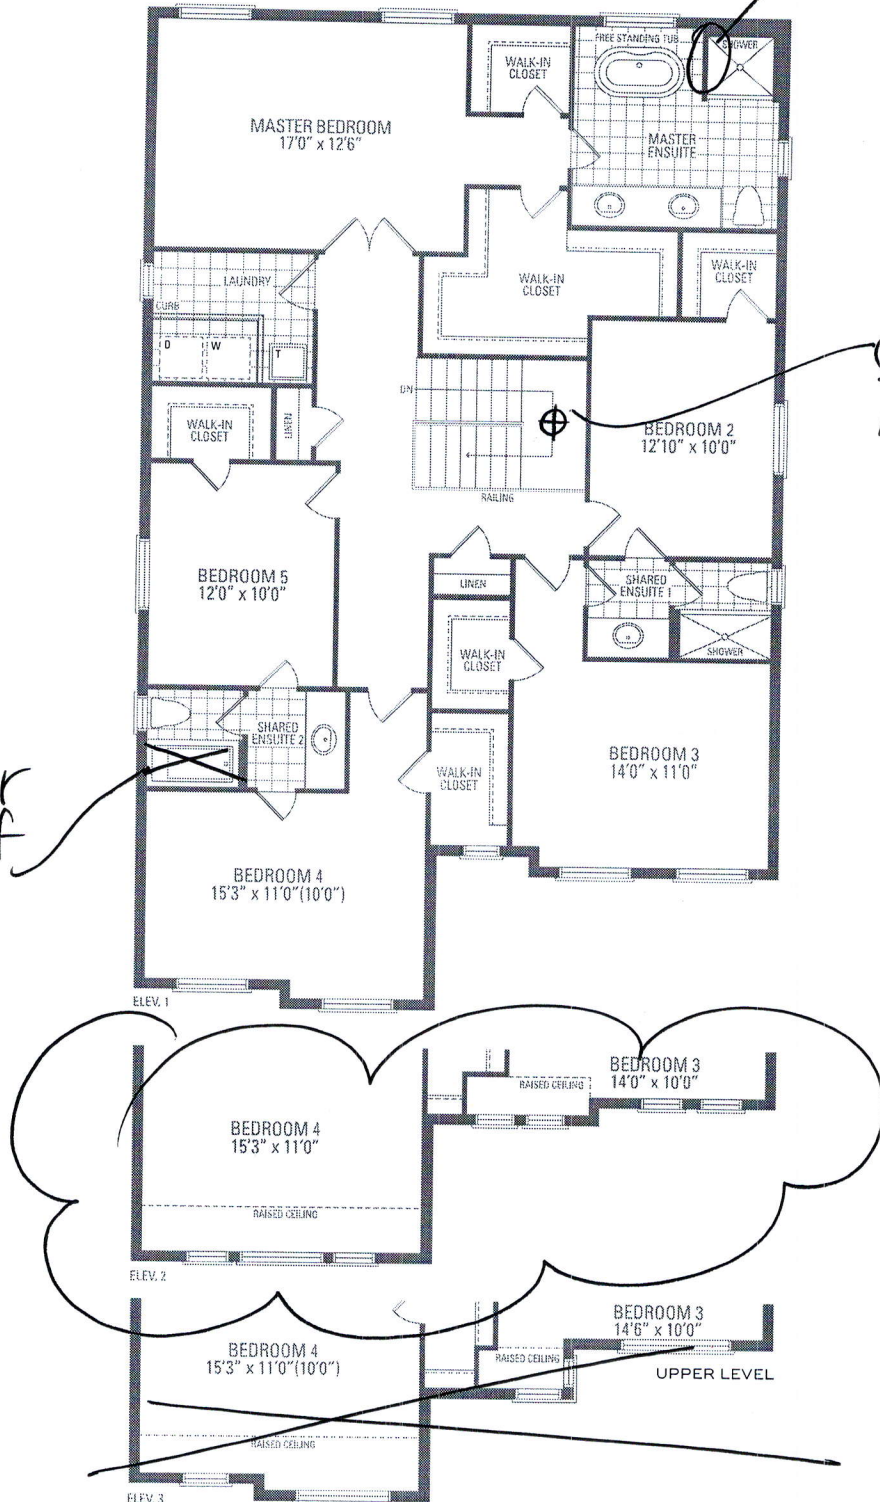

Orientation of home may be reversed and purchaser agrees to accept the same. Steps and porches may vary at any exterior entrance ways due to grading variance. Actual usable floor space may vary from the stated floor areas. All renderings are artist's concept. Dimensions, specifications and architectural detailing subject to modifications. Roofline and adjoining model types may vary due to siting. E. & O. E. May 2020

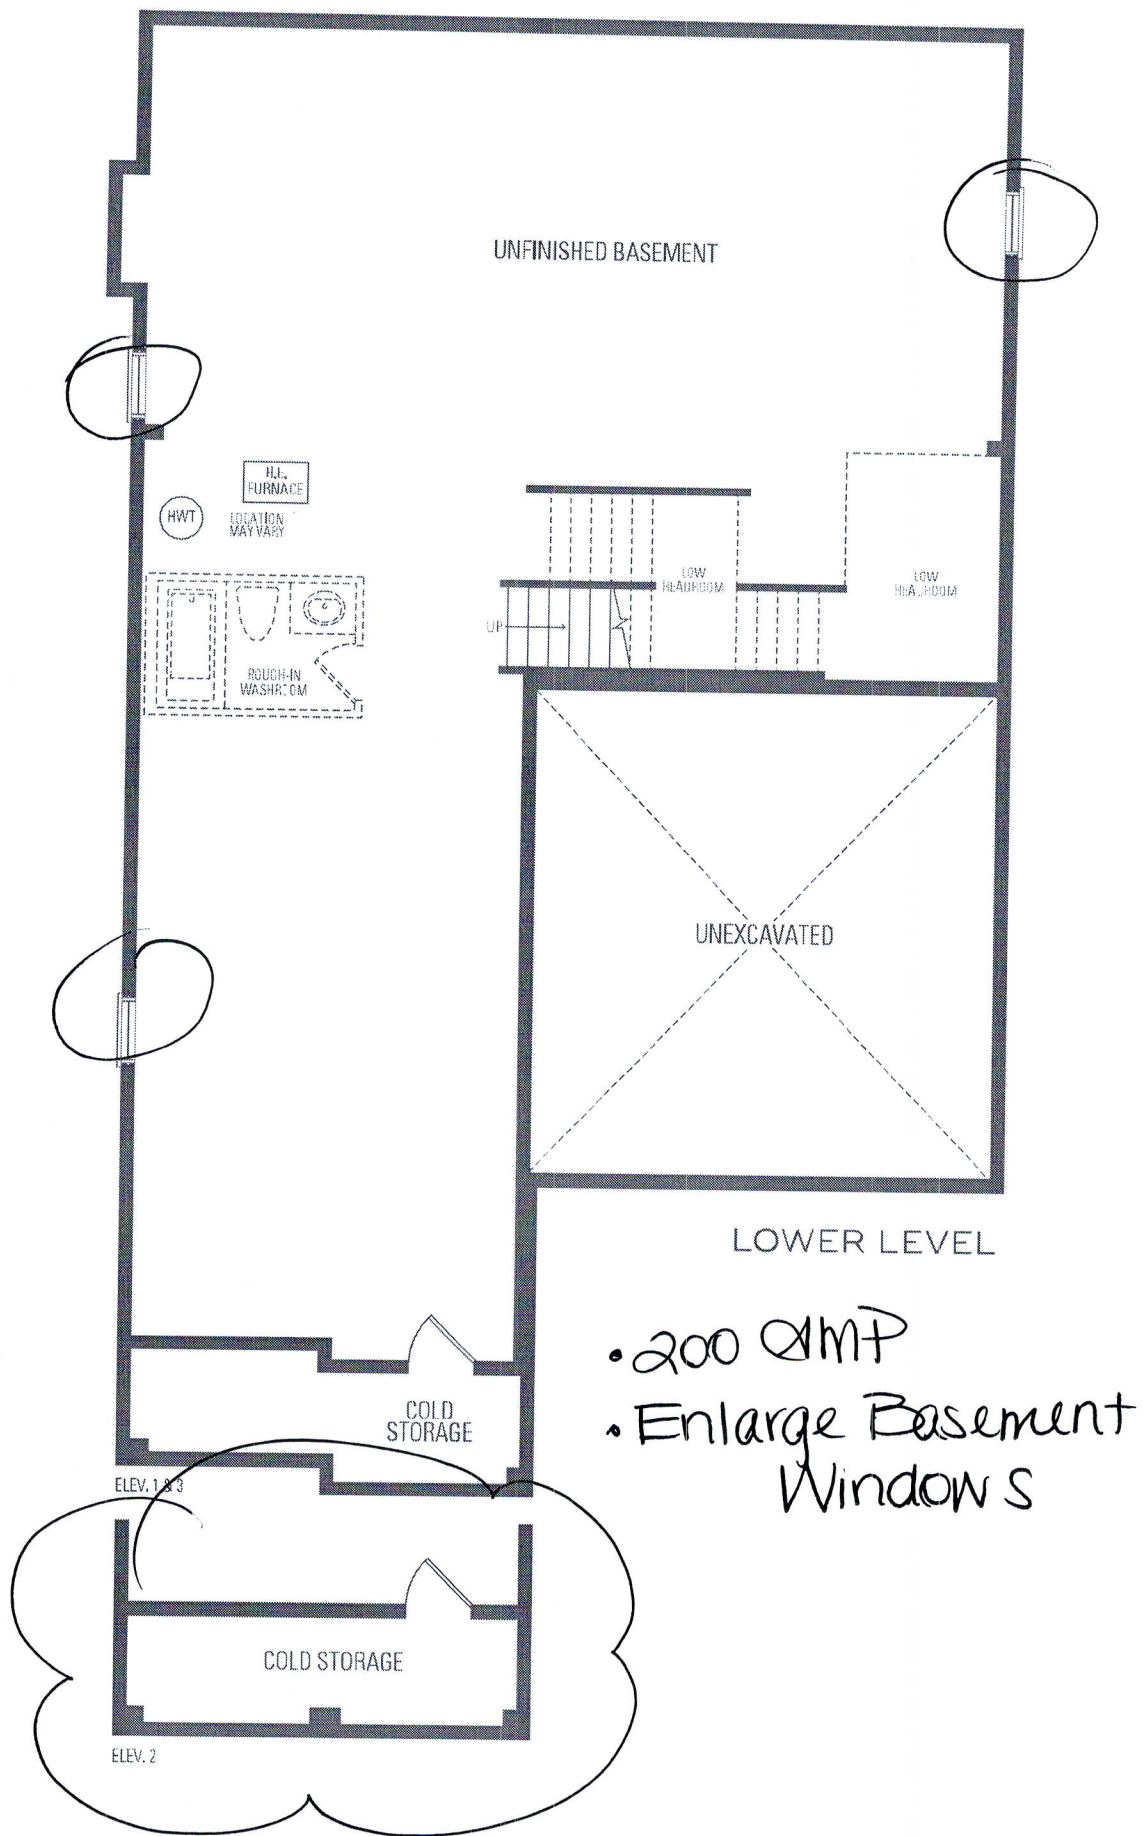

PURCHASER ALTERATION FORM

LOT 335  
RUSSELL GARDENS  
PHASE 3  
MOUNTAINVIEW HEIGHTS


MOUNTAINASH 5  
ELEV. 2

REVISIONS:


- 1. SUNKEN FOYER AS REQUIRED BY GRADE CONDITIONS.
- 2. LOW HEADROOM UNDER SUNKEN FOYER.

DocuSigned by:  
*Rabia Sachdev* 18-Nov-20  
C6952F64DFA34BF...

DocuSigned by:  
*Rabia Sachdev* 17-Nov-20  
0BAB1C3D72EB4A9...

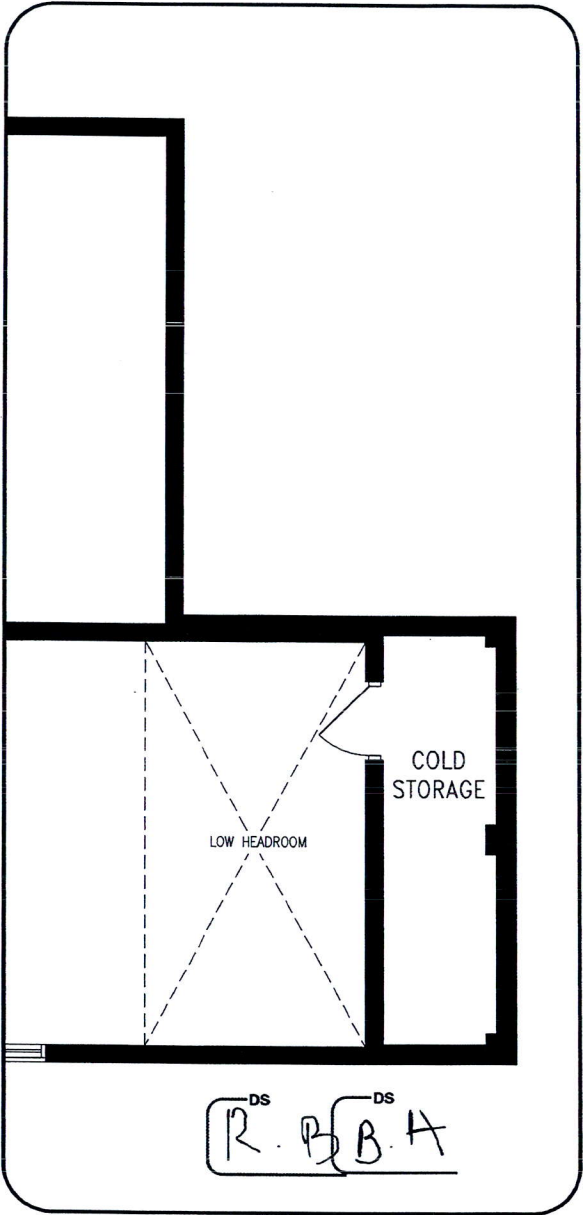

LOWER LEVEL

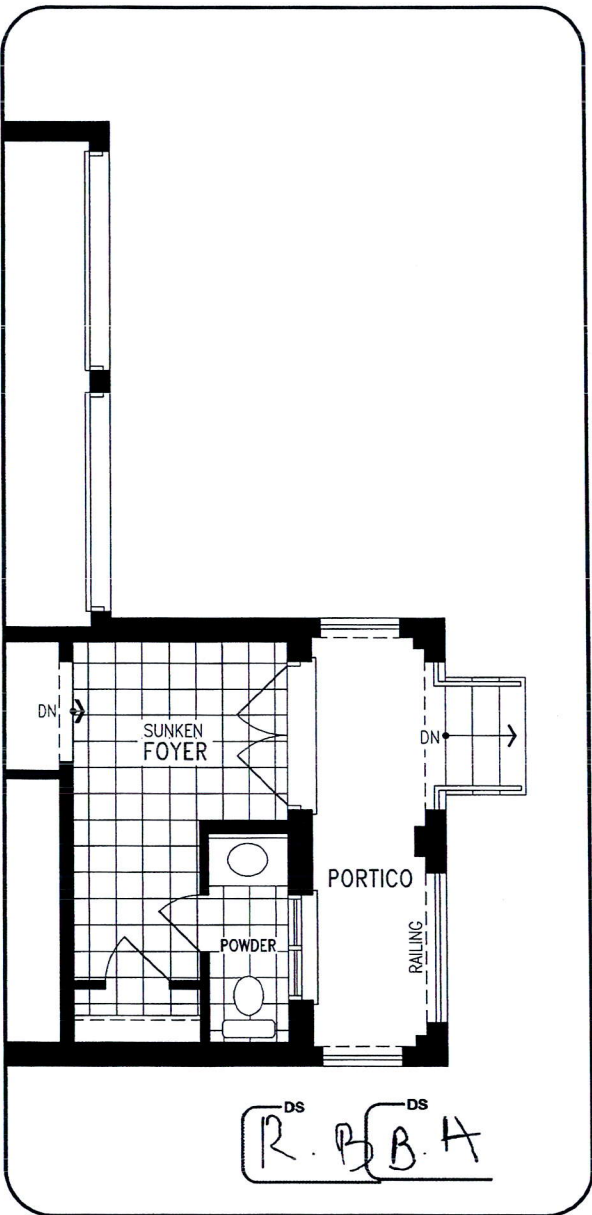


MAIN LEVEL

DISCLAIMERS: SKETCH NOT TO SCALE. DIMENSIONS, SPECIFICATIONS AND ARCHITECTURAL DETAILS SUBJECT TO MODIFICATION BY THE VENDOR. SKETCH IS ONLY FOR THE PURPOSE OF ILLUSTRATING REVISIONS REQUESTED BY THE PURCHASER AND ALL REVISIONS ARE SUBJECT TO VENDOR'S FINAL APPROVAL. ONLY REVISIONS ACCEPTED IN WRITING BY THE PURCHASER AND VENDOR ON A PURCHASER'S EXTRA SHEET WILL BE INCORPORATED INTO THE PLANS FILED WITH THE MUNICIPALITY. E. & O.E.

REGION  
DESIGN  
INC.

SCALE  
BY MB  
PAGE No. 1 OF 1  
N.T.S.



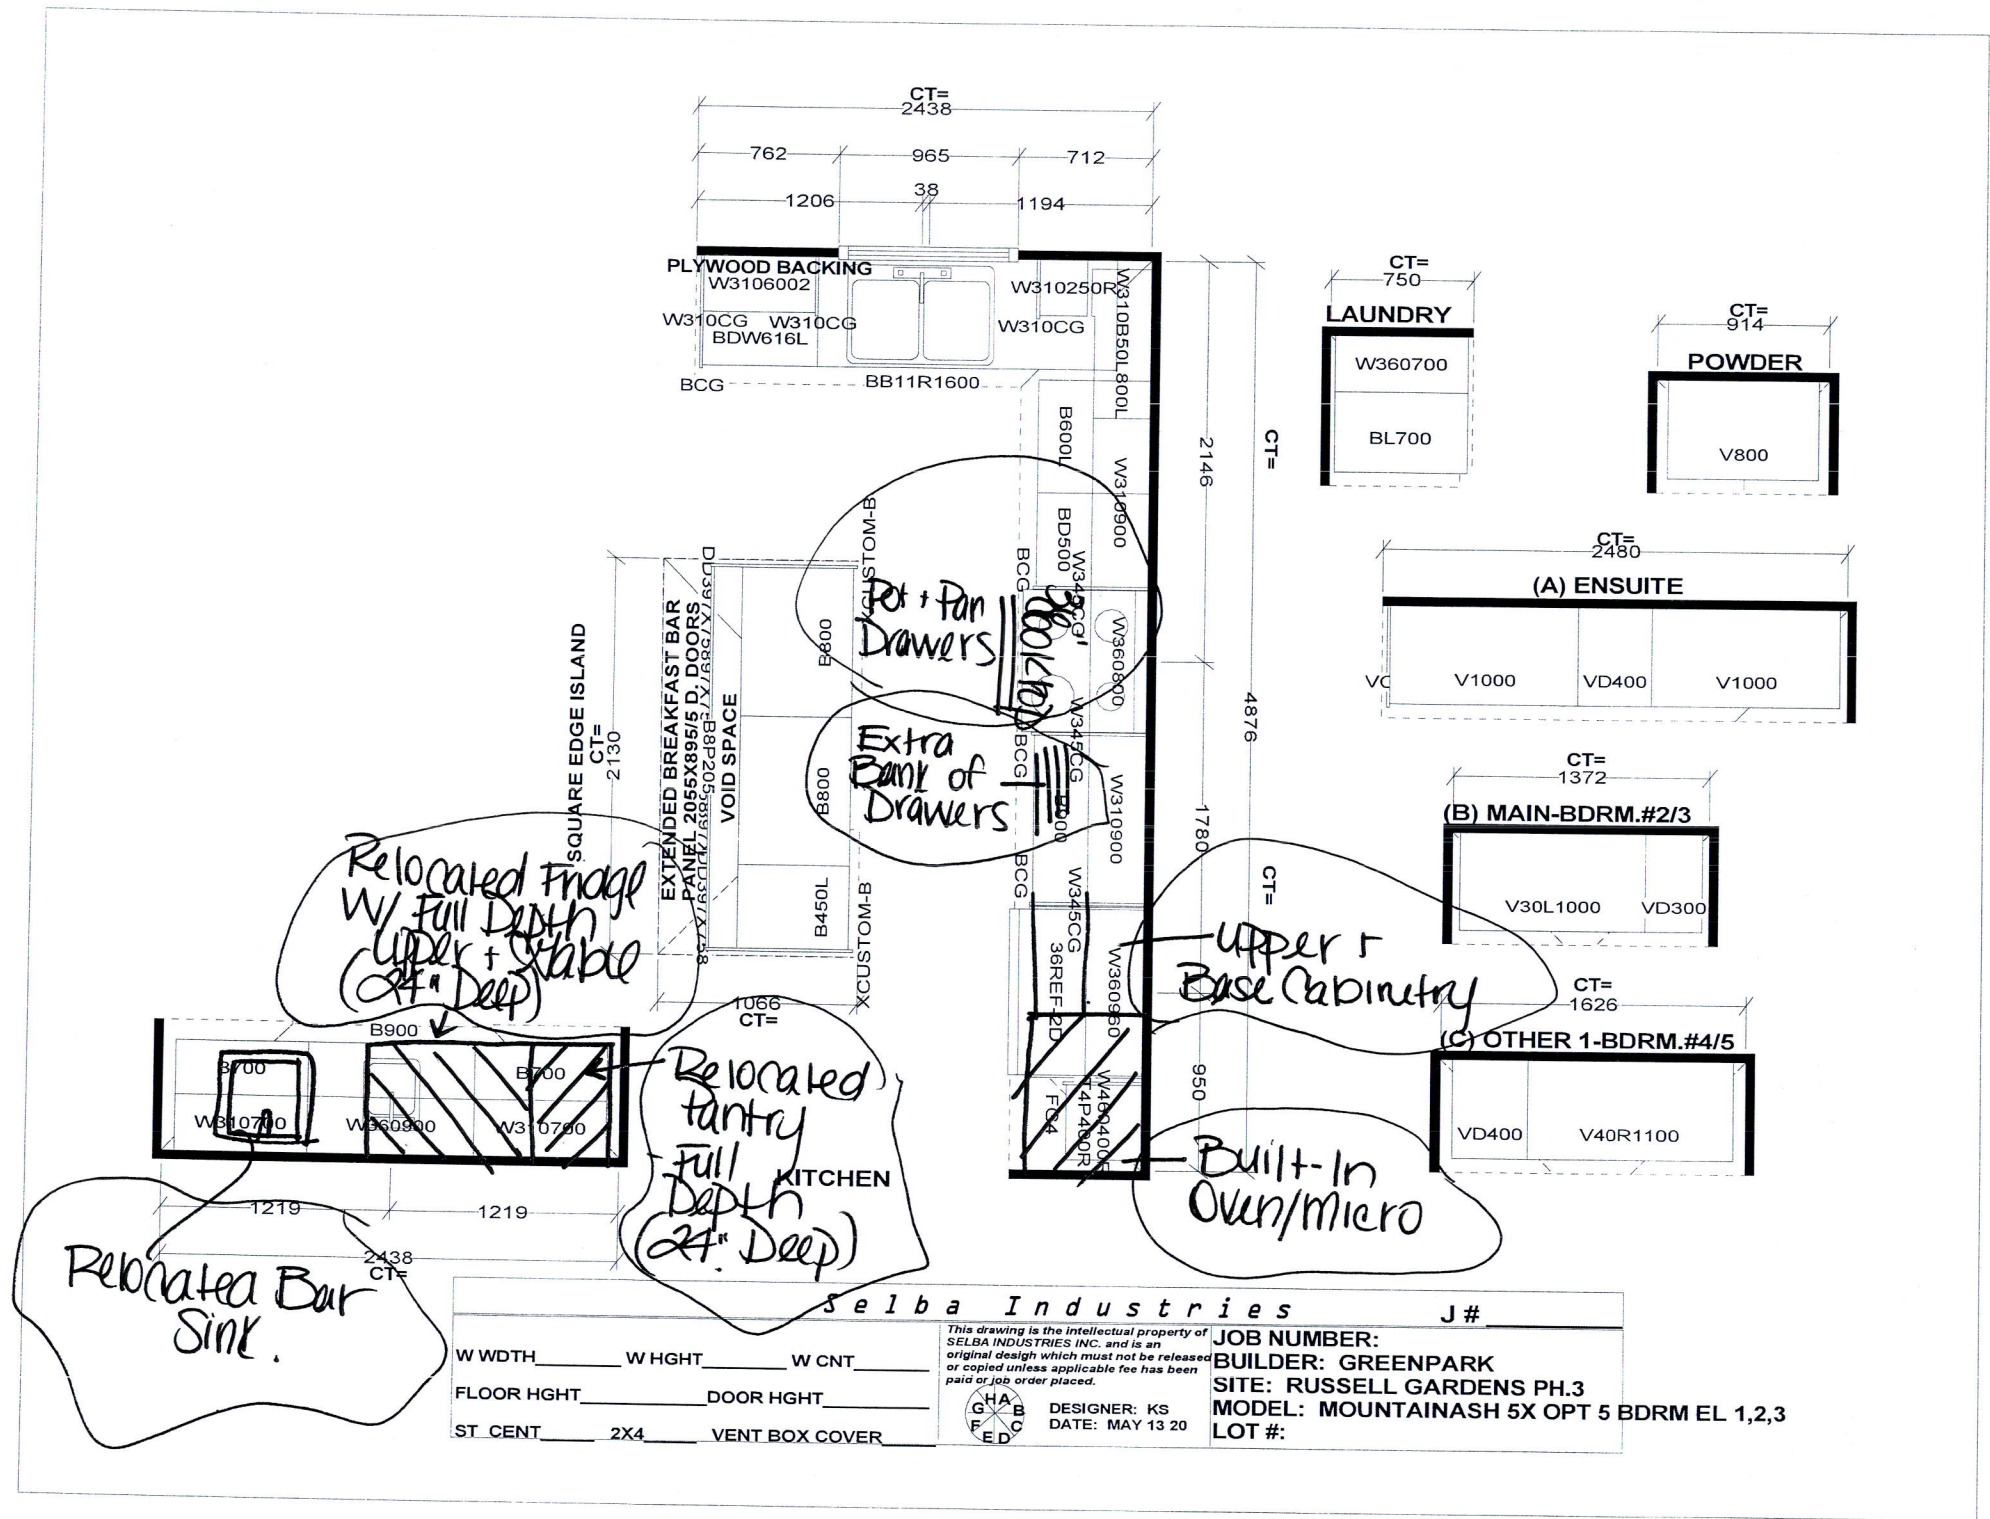

**selba Industries** J# \_\_\_\_\_

W WIDTH \_\_\_\_\_ W HGHT \_\_\_\_\_ W CNT \_\_\_\_\_

FLOOR HGHT \_\_\_\_\_ DOOR HGHT \_\_\_\_\_

ST. CENT \_\_\_\_\_ 2X4 \_\_\_\_\_ VENT BOX COVER \_\_\_\_\_

This drawing is the intellectual property of SELBA INDUSTRIES INC. and is an original design which must not be released or copied unless applicable fee has been paid or job order placed.

DESIGNER: KS DATE: MAY 13 20

JOB NUMBER: \_\_\_\_\_

BUILDER: GREENPARK

SITE: RUSSELL GARDENS PH.3


MODEL: MOUNTAINASH 5X OPT 5 BDRM EL 1,2,3

LOT #: \_\_\_\_\_

Whirlpool®

20 cu. ft. French Door Refrigerator

WRF540CWH

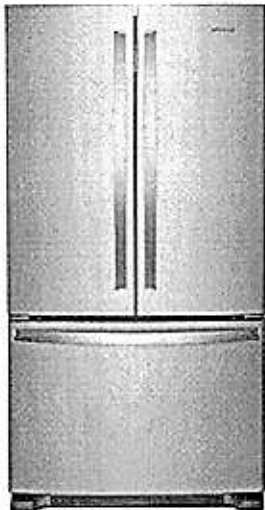

Fingerprint-Resistant Stainless  
WRF540CWHZ

Also available in:

- White
- WRF540CWHW
- Black
- WRF540CWHB
- Fingerprint-Resistant Black Stainless
- WRF540CWHV

Key Features & Benefits

- Fingerprint Resistant

Resists fingerprints and smudges with an easy-to-clean finish.
- Counter Depth Design

Add additional kitchen space with styling that fits virtually flush with the countertop.
- Humidity-Controlled Crispers

Store fruits and veggies in their ideal environment.

Capacity

Total Capacity	20 cu. ft.
Refrigerator Capacity	14 cu. ft.
Freezer Capacity	6 cu. ft.

General Features & Properties

- Interior Water Dispenser with EveryDrop® Water Filtration
- Full-Width, Temperature-Controlled Drawer
- Frameless Glass Shelves
- Gallon Door Bins
- Accu-Chill™ Temperature Management System
- Adaptive Defrost
- FreshFlow™ Produce Preserver
- LED Interior Lighting
- Designed, Engineered and Assembled in the U.S.A.

Electrical Details

Amps	20
Volts	115

Certifications

ENERGY STAR® Certified	Yes
------------------------	-----

Technical Details


Refrigerator Type	French Door
Number of Doors	3
Number of Interior Refrigerator Shelves	5
Number of Refrigerator Door Bins	2 Fixed, 4 Adjustable
Number of Interior Freezer Shelves	1 Wire, 1 Plastic
Lighting Type	LED
Ice Maker	Factory Installed
Ice Maker Location	Freezer
Dispenser Type	Interior Water

Dimensions

Product Dimensions (H x W x D)	70-1/8" x 35-5/8" x 29 3/8"
Depth with Door Open 90°	43"
Cutout Dimensions	Allow extra 1/2" on sides and top Allow extra 1" on rear


Reference Material

- [Dimension Guide](#)
- [Use & Care Guide](#)
- [Energy Guide](#)
- [Warranty](#)

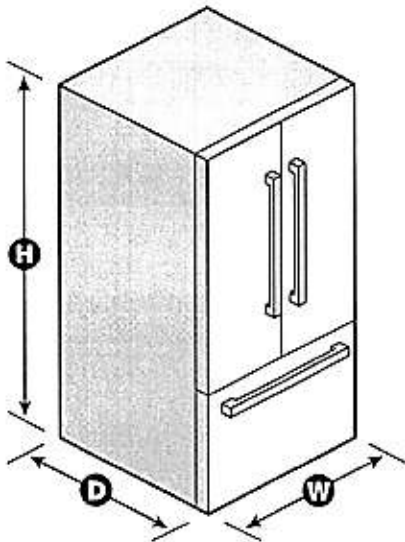

NOTE: Dimensions are for planning purposes only. For complete details, see Installation Instructions packed with product. Specifications subject to change without notice.  
®/™ © 2020. All rights reserved. Printed in the U.S.A. D200052XXC. WRF540CWHSPEC SHEETV01.

WCG97US6H  
GAS COOKTOP

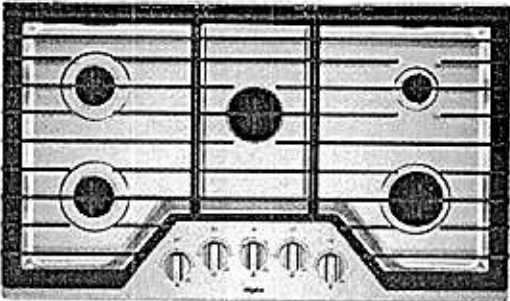

EZ-2-LIFT™ HINGED CAST-IRON GRATES



Get quick access to spills on the cooktop with our industry-first EZ-2-Lift™ hinged cast-iron grates. The hinged design lets you wipe up underneath without removing them. For a more thorough clean, the grates are also dishwasher safe.

UPSWEPT SPILLGUARD™ COOKTOP



Clean up faster with a cooktop that has raised edges to help contain spills.


FLEXHEAT™ BURNER



Two rows of flames give you the evenly distributed high heat you need for rapid boiling and searing or the lower temperatures necessary for more delicate dishes.

OTHER FEATURES

- Upswept SpillGuard™ cooktop
- Griddle
- SpeedHeat™ burner
- AccuSimmer® burner
- FlexHeat™ burner
- Fifth Burner
- Sealed burners
- Full width grates
- Wall oven compatible

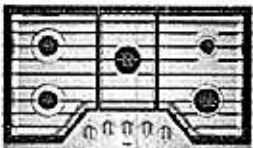

Silver (S)


MODEL	WCG97US6HS
Max height (in)	4-1/8"
Width (in)	36"
Depth (in)	21"

Whirlpool®



## 6.4 cu. ft. Smart Combination Wall Oven

WOC54EC0H

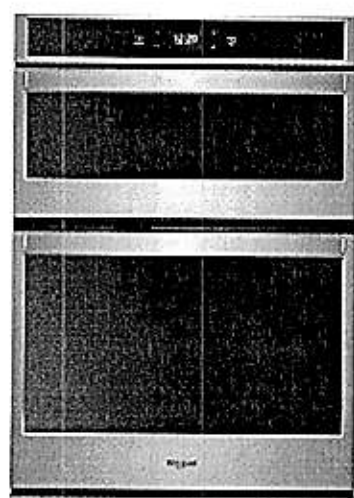

Stainless Steel  
WOC54EC0HS

### Also available in:

- ☐ White WOC54EC0HW
- ☒ Black WOC54EC0HB

### Capacity

Oven 6.4 cu. ft.

### General Features & Properties

Frozen Bake™ technology

Multi-Step Cooking

Steam Clean option

Scan-to-Connect Technology

Remote Start

Keep Warm Setting

Party Mode

Enhanced Troubleshooting

Guided Service

### Electrical Details

Amps 40

Volts 240

### Certifications

Connected/Smart Appliance Yes

Star-K Certified/Kosher Yes

### Technical Details

Fuel Type Electric

Oven Type Combination

Oven Cooking System Thermal

Number of Oven Racks 2

Cleaning Type Self-Cleaning w/Steam

### Dimensions

Product Dimensions (H x W x D) 42-9/16" x 30" x 26-1/2"

Depth with Door Open 90° 46-3/4"

Cutout Dimensions (H x W x D) 41-5/16" x 28-1/2" x 24"

### Reference Material

[Install Guide](#)

[Use & Care Guide](#)

[Warranty](#)

### Key Features & Benefits

#### Smart Appliance


Care smarter with connected features that let you send cooking instructions to the oven from your smartphone, control your kitchen with voice commands using a compatible voice-enabled device\* or skip preheating.

#### Touchscreen

Get instant access to the settings you use most with a touchscreen that learns, adapts and suggests customized presets based on your family's routines.

#### Voice Control with a Compatible Voice-Enabled Device\*\*

Control your kitchen no matter what you've got on your hands with simple voice commands using the Google Assistant or an Alexa-enabled device.

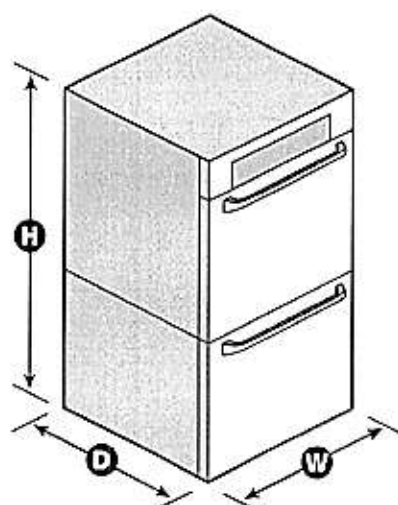

\*Appliance must be set to remote enable. WiFi & App Required. Features subject to change. Details and privacy info at [whirlpool.com/connect](http://whirlpool.com/connect). \*\*U.S. Only. NOTE: Dimensions are for planning purposes only. For complete details, see Installation Instructions packed with product. Specifications subject to change without notice.

©/™ © 2020. All rights reserved. Printed in the U.S.A. D200104XXE. WOC54EC0HSpecSheetV01.