



CONSTRUCTION SUMMARY

Mountainview Heights 3 (G) - Russell Gardens Building Ltd.

PURCHASER: Akinniyi Oluseyi SOLADEMI

RECEIVED

SEP 20 2021

TEL:

LOT / PHASE 383 / 4	REG. PLAN # 62M-1266	HOUSE TYPE Valleycreek Four A Elev 1		
------------------------	-------------------------	-----------------------------------------	--	--

CABINETRY ACCESSORIES

1 - PANTRY UNIT UPGRADE - TO GO FROM 300MM TO 600MM DEEP - PRICE IS PER FOOT - STANDARD 15Sep21 Note:		
1 - KITCHEN CABINETRY UPPER - FULL DEPTH ABOVE FRIDGE - WITH GABLES - 600MM - PRICE IS EACH - STANDARD 15Sep21 Note:		

CERAMIC TILE

1 - TILE- UPGRADE 1 FLOOR TILE - SIDE HALL 15Sep21 Note:		
1 - TILE- UPGRADE 1 FLOOR TILE - POWDER ROOM 15Sep21 Note:		
1 - TILE- UPGRADE 1 FLOOR TILE - KITCHEN 15Sep21 Note:		
1 - TILE- UPGRADE 1 FLOOR TILE - FOYER 15Sep21 Note:		

ELECTRICAL

1 - PLUG - ELECTRICAL PLUG - TO BE INSTALLED OVER FIREPLACE 15Sep21 Note:		
1 - FAN - BATHROOM EXHAUST FAN - ENERGY STAR 80 CFM - IN LIEU OF STANDARD FAN - MASTER ENSUITE BATHROOM 15Sep21 Note:		
1 - LIGHT AND SWITCH - NO FIXTURE INCLUDED - LIVING ROOM 15Sep21 Note:		
1 - 200 AMP ELECTRICAL SERVICE 15Sep21 Note:		

HARDWOOD FLOORING

1 - LAMINATE – UPGRADE TO FJORD SERIES IN LIEU OF STANDARD LAMINATE 15Sep21 Note:		
1 - HARDWOOD - PROMO SERIES 3 1/4 INCH - IN LIEU OF 2 1/4 INCH NATURAL RED OAK - - MAIN HALL 15Sep21 Note:		
1 - HARDWOOD - PROMO SERIES 3 1/4 INCH - IN LIEU OF 2 1/4 INCH NATURAL RED OAK - - LIVING/DIING ROOM 15Sep21 Note:		
1 - HARDWOOD - PROMO SERIES 3 1/4 INCH - IN LIEU OF 2 1/4 INCH NATURAL RED OAK - - LIBRARY/DEN 15Sep21 Note:		
1 - HARDWOOD - PROMO SERIES 3 1/4 INCH - IN LIEU OF 2 1/4 INCH NATURAL RED OAK - - FAMILY ROOM 15Sep21 Note:		

PLUMBING

1 - WATER LINE FOR FRIDGE - ROUGH-IN ONLY 15Sep21 Note:		
------------------------------------------------------------	--	--

CONSTRUCTION SUMMARY

Mountainview Heights 3 (G) - Russell Gardens Building Ltd.

PURCHASER: Akinniyi Oluseyi SOLADEMI

TEL:

LOT / PHASE 383 / 4	REG. PLAN # 62M-1266	HOUSE TYPE Valleycreek Four A Elev 1		
------------------------	-------------------------	-----------------------------------------	--	--

PROMOTIONAL

1 - LESS BALANCE OF CREDIT FROM PURCHASER EXTRA SHEET IN OFFER

15Sep21 Note:

EXTRAS AS PER OFFER

PURCHASER(S) ACKNOWLEDGES THAT THE PURCHASE PRICE IS INCLUSIVE OF ALL CREDITS AND PROMOTIONAL PACKAGES AVAILABLE AT TIME OF PURCHASE.

Worksheet Note:

(1) The Vendor agrees that notwithstanding any other term or provision in this Agreement included in the Purchase Price and in addition to those items detailed in Schedule GP to the Agreement of Purchase and Sale, the Purchaser is entitled to a credit of

Worksheet Note:

Purchase Price includes 3 enlarged basement windows, and the obligation to construct the house with the enlarged basement windows is subject to the Vendors approval, in its sole and unfettered discretion The Purchaser acknowledges and agrees that the loc

Worksheet Note:

Granite kitchen counter top, from Vendor?s standard samples

Worksheet Note:

This Document is Extremely Time Sensitive - Printed 15 Sep 21 at 12:44

Purchaser: Akinniyi Oluseyi SOLADEMI

Property: 383

Telephone Res. / Bus: /

Project: Russell Gardens Building Ltd.

Decor Advisor: Candace Forza

Model and Elevation: Valleycreek Four A Elev 1

Lock Date: 15-Sep-21

15-Sep-21

Plan #: 62M-1266

Layout Changes: ☐ Yes ☒ No

Sketch Attached: ☒ Yes ☐ No

Exterior Colour Scheme:

1. Cabinetry

	Style and Colour	Hardware
Kitchen / Breakfast	EVEREST	431SA
Laundry Room	ELISSE	Standard
Powder Room	MONACO 823 DRIFT WOOD	431SA
Master Ensuite Bathroom	DORAL K44 TITAN GREY	431SA
Ensuite Bath - Bedroom 2/3	DORAL H3081 HACIENDA BLACK	431SA
Ensuite Bath - Bedroom 4	DORAL K38 RIVERSIDE	431SA
	N/A	N/A
	N/A	N/A
	N/A	N/A

Appliances:

Built In Appliances ☐ Yes ☒ No

Slide In Stove ☐ Yes ☒ No

Dishwasher Cabinet

☐ Closed ☒ Open

41" Upper Cabinets ☒ Yes ☐ No

Please NOTE: Standard Cabinet Height is 30"

Stove Opening

NOTE: If not specified, opening will be set to builder's standard opening of approximately 30" width

Fridge Opening

NOTE: If not specified, opening will be set to builder's standard opening of approximately 37" width x 74" height

** Refer to Construction Summary

2. Counters

	Counter	Edge
Kitchen / Breakfast	GRANITE-GIRIGO SARDO	#360
Laundry Room	N/A	
Powder Room	LAMINATE-WHITE CARRARA 4924-38	
Master Ensuite Bathroom	LAMINATE-WHITE CARRARA 4924-38	
Ensuite Bath - Bedroom 2/3	LAMINATE-CARRARA BIANCO 6696-46	
Ensuite Bath - Bedroom 4	LAMINATE-WHITE CARRARA 4924-38	
	N/A	
	N/A	
	N/A	

** Refer to Construction Summary

Initial: 

Purchaser:

Akinniyi Oluseyi SOLADEMI

Telephone Res. / Bus:

/

Decor Advisor:

Candace Forza

Lock Date:

15-Sep-21

Property: 383

Project: Russell Gardens Building Ltd.

Model and Elevation: Valleycreek Four A Elev 1

Plan #: 62M-1266

3. Ceramic Flooring

		At a 45	Threshold-If App.
Entrance Vestibule	TILE-STONE WHITE-12 1/4X 24 1/4	<input type="checkbox"/>	metal strip where applicable
Main Hall	STRIP	<input type="checkbox"/>	
Kitchen / Breakfast	TILE-STONE WHITE-12 1/4X 24 1/4	<input type="checkbox"/>	
Laundry Room	TILE-CONCPET GREY-13X13	<input type="checkbox"/>	
Powder Room	TILE-STONE WHITE-12 1/4X 24 1/4	<input type="checkbox"/>	
Master Ensuite Bathroom	TILE-ESSENZE GRIGIO-13X13	<input type="checkbox"/>	
Ensuite Bath - Bedroom 2/3	TILE-RAINBOW LIGHT GREY-13X13	<input type="checkbox"/>	
Ensuite Bath - Bedroom 4	TILE-SN PASTELLO WHITE-13X13	<input type="checkbox"/>	
SIDE HALL	TILE-STONE WHITE-12 1/4X 24 1/4	<input type="checkbox"/>	
	N/A	<input type="checkbox"/>	
	N/A	<input type="checkbox"/>	

** Refer to Construction Summary

4. Ceramic Wall Tile

Master Ensuite Bathroom	Selection	Describe
Tub Deck Wall	N/A	
Tub Deck	N/A	
Tub Deck Skirt	N/A	
Shower Stall	TILE-EXTRA WHITE/GREY-8X16	
Bathtub Enclosure Walls	N/A	
Ensuite Bath - Bedroom 2/3	TILE-SILVIA WHITE-8X16	
Ensuite Bath - Bedroom 4	TILE-LUC AFRICA-8X16	
SIDE HALL	N/A	
	N/A	
	N/A	
	N/A	
Kitchen Backsplash	N/A	

** Refer to Construction Summary - STANDARD GROUT THROUGHOUT UNLESS SPECIFIED

5. Plumbing Fixtures

All Bathrooms

White

N/A

N/A

Whirlpool

N/A

Yes

No

Dishwasher Rough-In

Yes

No

Waterline for Fridge

Yes


No

** Refer to Construction Summary

6. Trim Carpentry

Interior Doors	CARRARA-SMOOTH
Interior Trim	As Per Construction Specifications
Door Handles	As Per Construction Specifications
Exterior Front Door Handle	As Per Construction Specifications

** Refer to Construction Summary

Initial: 

Purchaser: Akinniyi Oluseyi SOLADEMI

Telephone Res. / Bus: /

Decor Advisor: Candace Forza

Lock Date: 15-Sep-21

Property: 383

Project: Russell Gardens Building Ltd.

Model and Elevation: Valleycreek Four A Elev 1

Plan #: 62M-1266

7. Other Flooring

Main Hall	STRIP-MIRAGE-ADMIRATION-RED OAK-CASHMERE-PLATINUM-3 1/4"
Living Room	STRIP-MIRAGE-ADMIRATION-RED OAK-CASHMERE-PLATINUM-3 1/4"
Dining Room	STRIP-MIRAGE-ADMIRATION-RED OAK-CASHMERE-PLATINUM-3 1/4"
Family Room	STRIP-MIRAGE-ADMIRATION-RED OAK-CASHMERE-PLATINUM-3 1/4"
Den / Library / Study	STRIP-MIRAGE-ADMIRATION-RED OAK-CASHMERE-PLATINUM-3 1/4"
Basement Landing(If Applies)	N/A
Lower Landing (If Applies)	STRIP-MIRAGE-ADMIRATION-RED OAK-CASHMERE-PLATINUM-3 1/4"
Upper Landing	STRIP-MIRAGE-ADMIRATION-RED OAK-CASHMERE-PLATINUM-3 1/4"
Upper Hall	LAMINATE-FJORD-NORD OAK-TL-NEUM05
Master Bedroom	LAMINATE-FJORD-NORD OAK-TL-NEUM05
Bedroom #2	LAMINATE-FJORD-NORD OAK-TL-NEUM05
Bedroom #3	LAMINATE-FJORD-NORD OAK-TL-NEUM05
Bedroom #4	LAMINATE-FJORD-NORD OAK-TL-NEUM05
Bedroom #5	N/A
	N/A
	N/A
	N/A
Underpad	Type Area
	N/A N/A

** Refer to Construction Summary

8. Railings and Pickets

Railing Type V-GROOVE

Picket Type AS PER CONSTRUCTION SPECIFICATIONS

Stringer / Riser AS PER CONSTRUCTION SPECIFICATIO

Treads AS PER CONSTRUCTION SPECIFICATIO

Complimenting Colour MIRAGE PLATINUM RED OAK

Complimenting Colour MIRAGE PLATINUM RED OAK

Complimenting Colour MIRAGE PLATINUM RED OAK

Complimenting Colour MIRAGE PLATINUM RED OAK

Red Oak Stairs ☒ Yes ☐ No

** Refer to Construction Summary THE STAIN COLOURS OR FINISH AVAILABLE ON RISERS, TREADS, PICKETS AND RAILS (STAIRCASES), WILL NOT BE AN EXACT MATCH TO PREFINISHED HARDWOOD OR LAMINATE FLOORS.

9. Wall Paint Flat Finish

Main & Upper Hall	22 WARM GREY	Master Bedroom	22 WARM GREY
Living Room	22 WARM GREY	Bedroom #2	22 WARM GREY
Dining Room	22 WARM GREY	Bedroom #3	22 WARM GREY
Kitchen / Breakfast	22 WARM GREY	Bedroom #4	22 WARM GREY
Family Room	22 WARM GREY	Bedroom #5	N/A
Powder Room	22 WARM GREY	Master Ensuite	22 WARM GREY
Laundry Room	22 WARM GREY	Ensuite Bath - Bedroom 2/3	22 WARM GREY
Den/Library	22 WARM GREY	Ensuite Bath - Bedroom 4	22 WARM GREY
Trim & Door Paint-Semi Gloss	BIRCH WHITE		N/A
	N/A		N/A
	N/A		N/A

Smooth Ceilings First Floor ☐ Yes ☒ No

** Refer to Construction Summary

Initial: 

Purchaser: Akinniyi Oluseyi SOLADEMI

Property: 383

Telephone Res. / Bus: /

Project: Russell Gardens Building Ltd.

Decor Advisor: Candace Forza

Model and Elevation: Valleycreek Four A Elev 1

Lock Date: 15-Sep-21

15-Sep-21

Plan #: 62M-1266

10. Plaster Mouldings and Medallions

Entrance Vestibule	N/A	N/A	Kitchen/Breakfast	N/A	N/A
Main Hall	N/A	N/A	Den/Library	N/A	N/A
Living Room	N/A	N/A	Lower Landing	N/A	N/A
Dining Room	N/A	N/A		N/A	N/A
Family Room	N/A	N/A		N/A	N/A

** Refer to Construction Summary

11. Fireplace

	Living Room			Family Room			Other Room - Specify		
	Purchased	As Per Plan	N/A	Purchased	As Per Plan	N/A	Purchased	As Per Plan	N/A
Fireplace Type	<input type="radio"/>	<input type="radio"/>	<input checked="" type="radio"/>	<input type="radio"/>	<input checked="" type="radio"/>	<input type="radio"/>	<input type="radio"/>	<input type="radio"/>	<input checked="" type="radio"/>
Mantle Type	N/A			FLAT ON WALL			N/A		
Colour / Stain	N/A			MANTLE M2-STANDARD			N/A		
Surround	N/A			AS PER CONSTRUCTION SPECIFICATIONS			N/A		
Hearth	N/A			GRIGIO CARNICO			N/A		
				NO			N/A		

** Refer to Construction Summary

12. Heating and Air Conditioning

Air Conditioning	NO	Gas Provisions Stove	NO
Gas Provisions Dryer	NO	Gas Provisions Barbecue	NO
Comment			

** Refer to Construction Summary

13. Electrical

Plugs and Switches	<input checked="" type="radio"/> White	DECOR	Above Kitchen Cabinet Light	<input type="radio"/> Yes	<input checked="" type="radio"/> No
Hood Fan	STANDARD WHITE		Below Kitchen Cabinet Light	<input type="radio"/> Yes	<input checked="" type="radio"/> No
Appliances	Built in Cooktop	Built in Oven	Gas Stove	Microwave	
	<input type="radio"/> Yes <input checked="" type="radio"/> No	<input type="radio"/> Yes <input checked="" type="radio"/> No	<input type="radio"/> Yes <input checked="" type="radio"/> No	<input type="radio"/> Yes <input checked="" type="radio"/> No	
Dishwasher Rough-in	Yes				

** Refer to Construction Summary

14. General Comments

** Refer to Construction Summary

Disclaimers and Notes






- Colours of all materials are as close as possible to builder's selection, but not necessarily identical due to variances in manufacturing.
- Any extras listed above are null and void unless accompanied by a separate invoice/amendment. Said invoice must be paid in full.
- The Purchaser agrees that this colour selection is final and that no changes will be permitted, unless required by the Vendor.
- The Purchaser acknowledges reading and accepting document which contains other miscellaneous disclaimers.

Signature: 

Date: 15/09/2021



Add Ding Above Fireplace.

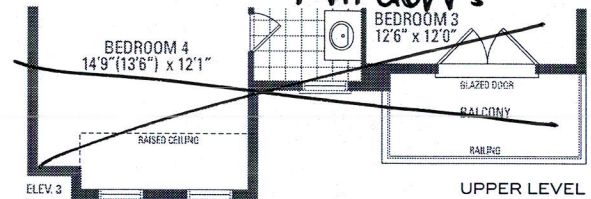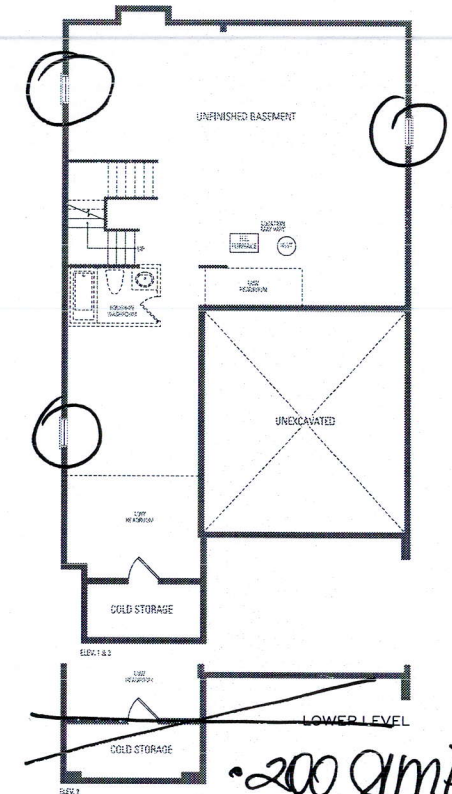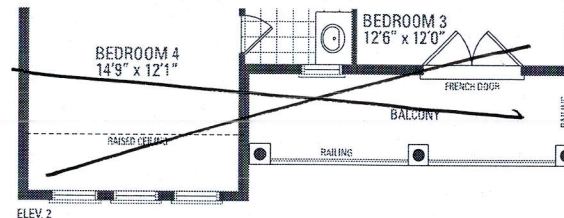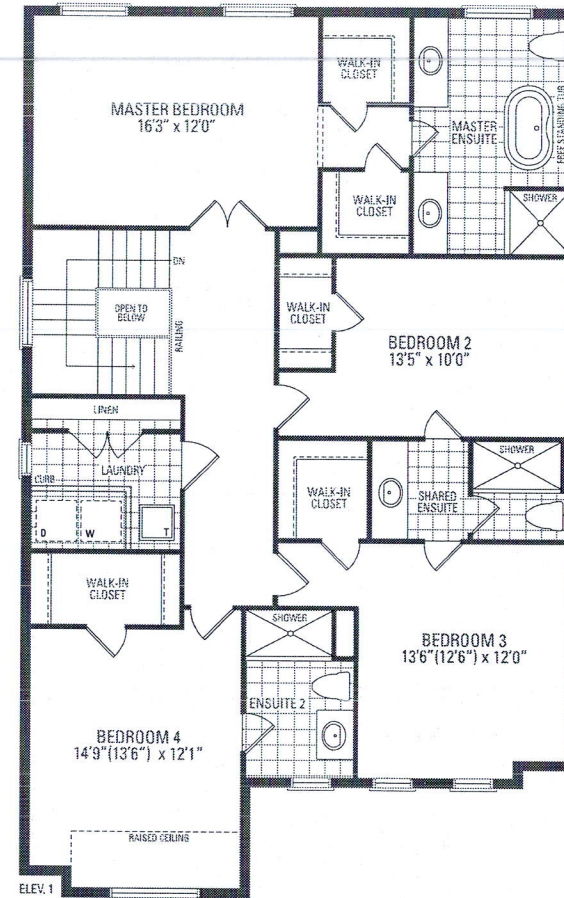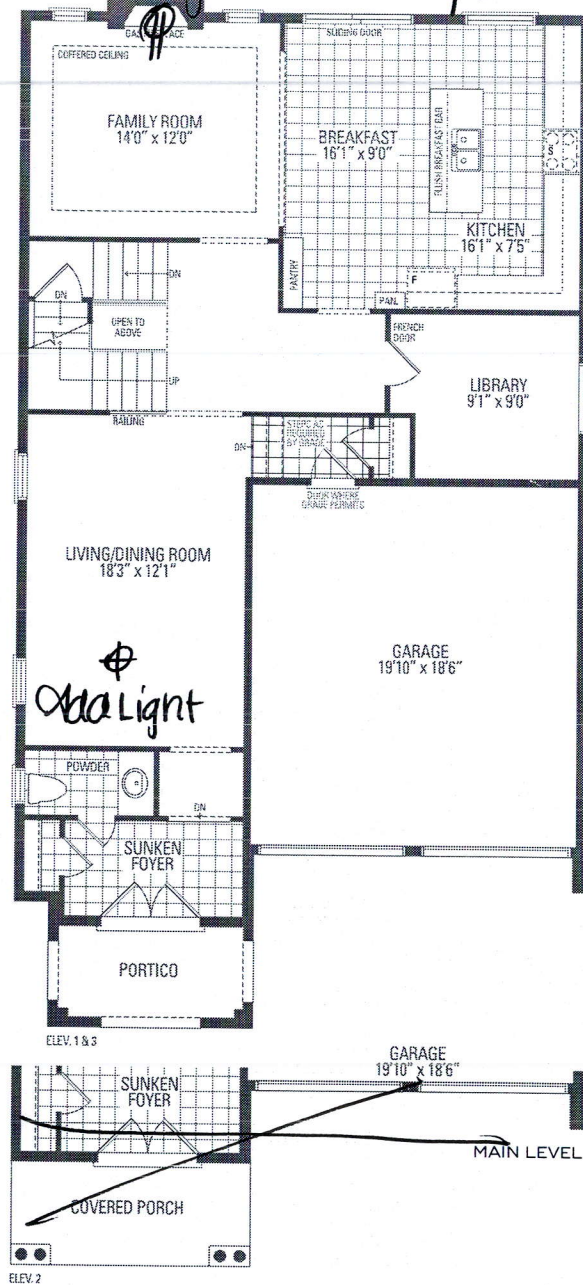

VALLEYCREEK FOUR A ELEV. 1 • 2,827 sq.ft. | ELEV. 2 • 2,818 sq.ft. | ELEV. 3 • 2,819 sq.ft. | Include 10 sq.ft. of open area.

Orientation of home may be reversed and purchaser agrees to accept same. Steps and porches may vary at any exterior entrance ways due to grading variance. Actual usable floor space may vary from the

