Greenpark.

O RELIMINARY

		NSTRUCTION SUMI v Heights 3 (G) - Russell Gar			
PURCHASER: Fatima BUT					TEL:
LOT / PHASE 347 / 4	REG. PLAN # 62M-1266	HOUSE TYPE Mountainash Three (4 Bed	room) Elev 2		
CONSTRUCTION					
I - HIGHER ARCHES AND	DOORS FIRST FLOOR (ONLY			
20Sep21 Note:	DOOKS TIME TI DE STE				
1 - SMOOTH CEILINGS ON	FIRST FLOOR ONLY -	DET			
20Sep21 Note:					
ELECTRICAL					
1 - RELOCATE STANDARI	KITCHEN LIGHT TO E	BE CENTERED OVER ISLAND			
20Sep21 Note:					
1 - PLUG - ELECTRICAL P	LUG WITH GFI AND SW	VITCH - FOR FESTIVE LIGHTING	i		
20Sep21 Note:					
2 POTLICHT LED EID	ST FLOOR INSTALLAT	ION - TO BE INSTALLED ON SEP	ARATE SWITCH FROM	STANDARD LIGHT	
20Sep21 Note: KITCHE		1011			
LIVING	/DINING - X1				
	Y ROOM - X1 TO SKETCH		*		
1 - 200 AMP ELECTRICAL	SERVICE				
20May21 Note:			•		
MIDDODS AND CLASS	*				
MIRRORS AND GLASS	RAMELESS GLASS SHO	OWER ENCLOSURE – INCLUDES	CHROME KNOB AND I	HINGES	
20May21 Note:	KANLEEGS GE/105 5110				
PLUMBING					
1 - WATER LINE FOR FRI	DGE - ROUGH-IN ONLY	A CONTRACTOR OF THE PARTY OF TH			
20Sep21 Note:					
3 - TOE TESTER - ADD TO	DE TESTER TO SHOWE	R			
20May21 Note:					
1 - 5 FOOT SHOWER WIT	H SLIDING GLASS CHR	ROME DOORS IN LIEU OF TUB			
20May21 Note:					
ENSUITE 3/4	والمراجعة المراجعة المراجعة		ONE STATE OF BATTER STREET, STATE		
PROMOTIONAL		OPP FIXTD A CLIPPE BY OPPER			<u> </u>
1 - LESS BALANCE OF CL 20Sep21 Note:	REDIT FROM PURCHAS	SER EXTRA SHEET IN OFFER			
1 - LESS CREDIT FROM F					
20May 21 Note: NEW F	PROMO BALANCE \$1	/35.00			

RECEIVED
SEP 2 3 2021

Greenpark.

62M-1266

PURCHASER: Fatima BUTT

LOT / PHASE

347 / 4


	CONSTRUCTION SUMMARY tainview Heights 3 (G) - Russell Gardens Building Ltd. TEL		TEL:
REG. PLAN #	HOUSE TYPE	T	

EXTRAS AS PER OFFER

Mountainash Three (4 Bedroom) Elev 2

Purchase Price includes 3 enlarged basement windows, and the obligation to construct the house with the enlarged basement windows is subject to the Vendors approval, in its sole and unfettered discretion The Purchaser acknowledges and agrees that the
loc Worksheet Note:
PURCHASER(S) ACKNOWLEDGES THAT THE PURCHASE PRICE IS INCLUSIVE OF ALL CREDITS AND PROMOTIONAL PACKAGES AVAILABLE AT TIME OF PURCHASE. Worksheet Note:
(1) The Vendor agrees that notwithstanding any other term or provision in this Agreement included in the Purchase Price and in addition to those items detailed in Schedule GP to the Agreement of Purchase and Sale, the Purchaser is entitled to a credit of Worksheet Note:
Granite kitchen counter top, from Vendor?s standard samples Worksheet Note:

This Document is Extremely Time Sensitive - Printed 20 Sep 21 at 15:48

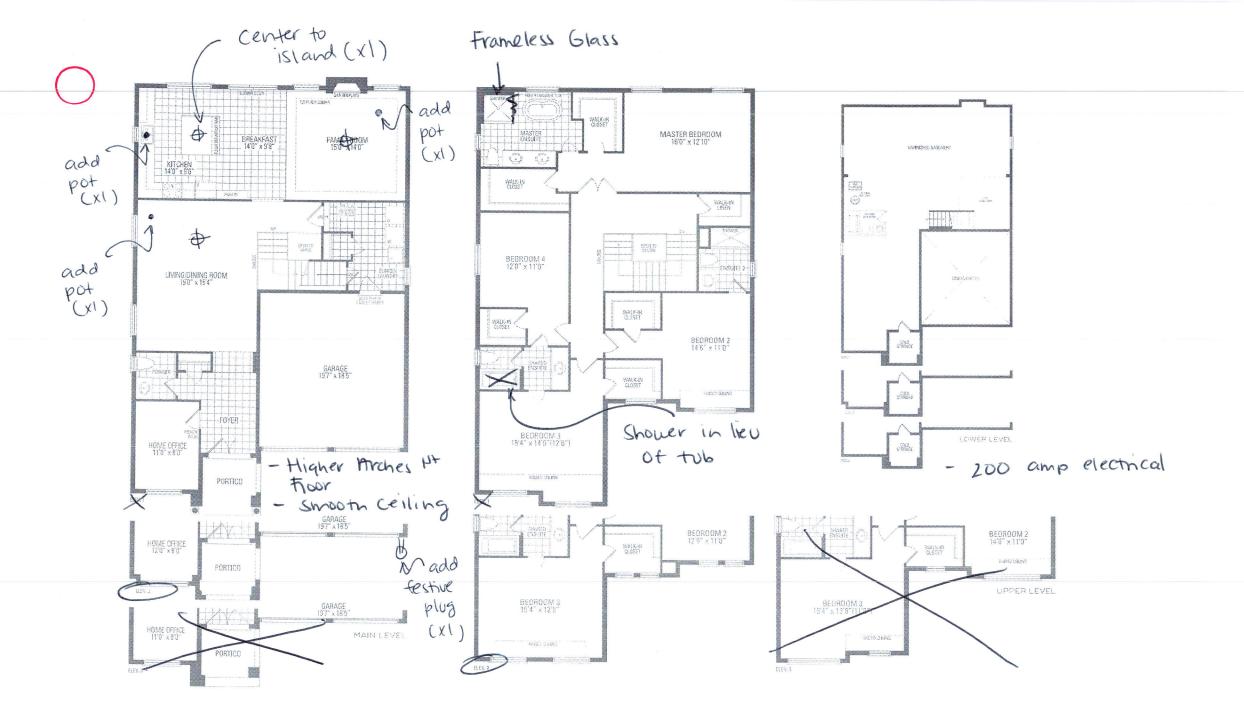

MOUNTAINASH THREE ELEV. 1 · 3,085 sq.ft. | ELEV. 2 · 3,074 sq.ft. | ELEV. 3 · 3,063 sq.ft. | Include 14 sq.ft. of open area.