


LOT 216
RUSSELL GARDENS
PHASE 3
MOUNTAINVIEW HEIGHTS

MOUNTAINASH 6
ELEV. 3

REVISION:

1. DELETE SERVERY WITH CABINETS, SINK AND PANTRY.
2. INCREASE POWDER ROOM SIZE INTO BATHROOM WITH SEPARATE SHOWER AREA.
3. EXTEND KITCHEN COUNTER AND CABINETS BESIDE FRIDGE.
4. INCREASE LIVING/DINING ROOM BY 1'-0", REDUCING BATHROOM ACCORDINGLY. ADJUST WINDOW LOCATION TO NEW ROOM SIZE.

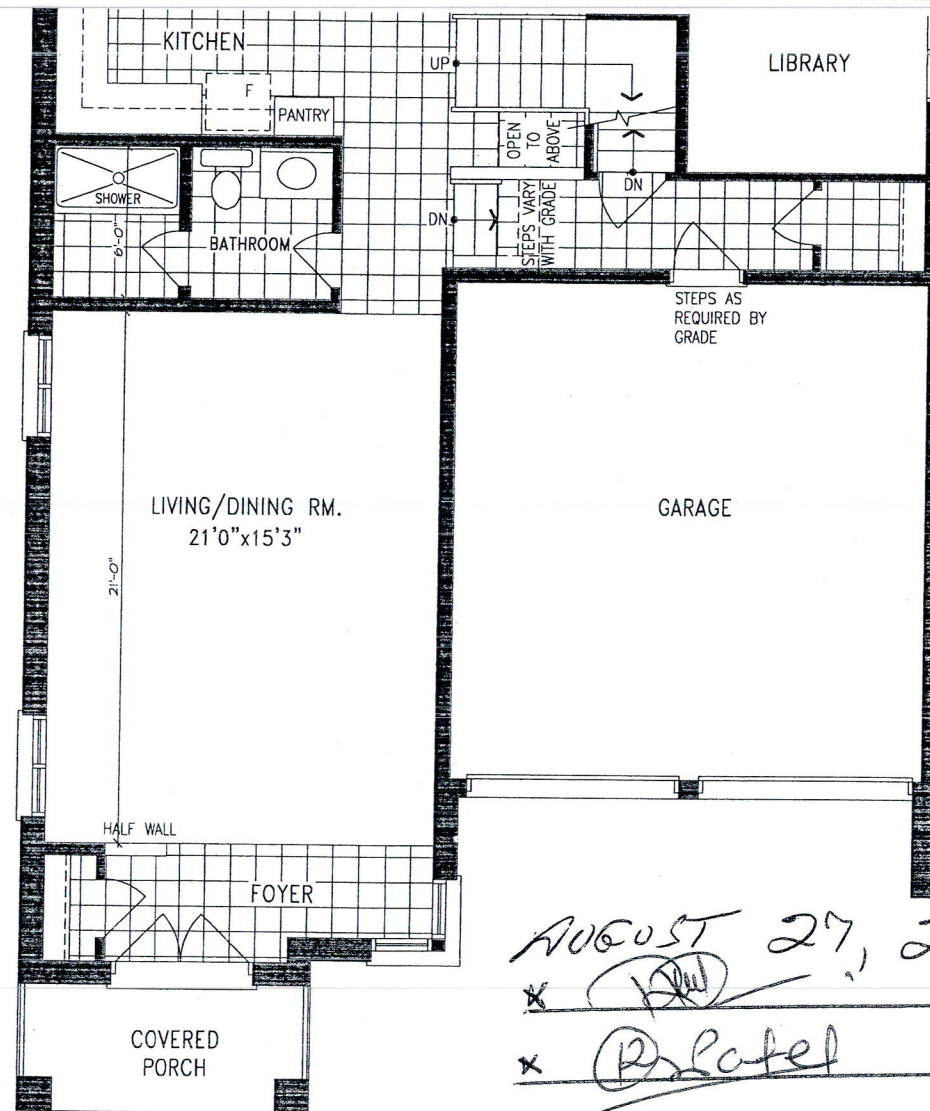

RECEIVED
SEP 24 2021

AUGUST 27, 2020
* *[Signature]*
* *[Signature]*

MAIN LEVEL

DISCLAIMERS: SKETCH NOT TO SCALE. DIMENSIONS, SPECIFICATIONS AND ARCHITECTURAL DETAILS SUBJECT TO MODIFICATION BY THE VENDOR. SKETCH IS ONLY FOR THE PURPOSE OF ILLUSTRATING REVISIONS REQUESTED BY THE PURCHASER AND ALL REVISIONS ARE SUBJECT TO VENDOR'S FINAL APPROVAL. ONLY REVISIONS ACCEPTED IN WRITING BY THE PURCHASER AND VENDOR ON A PURCHASER'S EXTRA SHEET WILL BE INCORPORATED INTO THE PLANS FILED WITH THE MUNICIPALITY. E. & O.E.

REGION
DESIGN
INC.


SCALE
N.T.S.
BY
MB
PAGE No.
1 OF 1

Greenpark™

5 BEDROOM LAYOUT

MOUNTAINASH SIX

ELEV. 1 • 3,409 sq.ft. | ELEV. 2 • 3,403 sq.ft. | ELEV. 3 • 3,368 sq.ft.

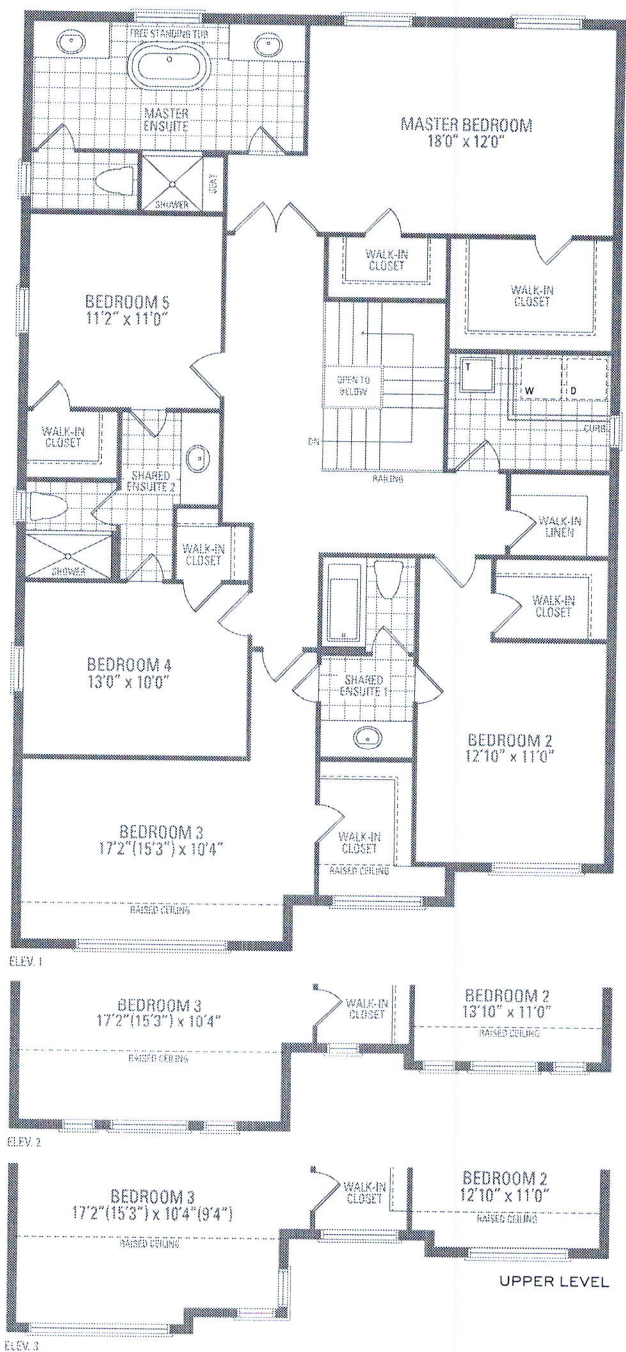

Orientation of home may be reversed and purchaser agrees to accept the same. Steps and porches may vary at any exterior entrance ways due to grading variations. Actual usable floor space may vary from the stated floor areas. All renderings are artist's concept. Dimensions, specifications and architectural detailing subject to modifications. Roofline and adjoining model types may vary due to siting. E. & O. E. May 2021

RECEIVED
SEP 24 2021