


THIS LOT GRADING PLAN HAS BEEN REVIEWED BY METROPOLITAN CONSULTING INC. FOR CONFORMANCE WITH THE APPROVED SUBDIVISION GRADING DESIGN. THE PROPOSED GRADES ON THIS PLAN ARE IN GENERAL CONFORMITY WITH THE APPROVED GRADING PLAN AS IT RELATES TO THIS LOT AND ADJACENT LOTS. WHERE THE BASEMENT FLOOR OR OTHER FOUNDATION ELEVATIONS ARE PROPOSED AT A DIFFERENT ELEVATION THAN THAT SHOWN ON THE APPROVED SUBDIVISION PLANS THE SEWER LATERALS HAVE BEEN REVIEWED AND WE ARE SATISFIED THAT THE MINIMUM GRADES FOR THESE LATERALS CAN BE MAINTAINED IN ACCORDANCE WITH THE REQUIREMENTS OF THE O.B.C. AND CITY DESIGN CRITERIA. NOTE: THIS CERTIFICATION DOES NOT REPLACE THE BUILDER'S RESPONSIBILITY TO EXPOSE THE SEWER LATERALS AND CONFIRM ELEVATIONS PRIOR TO EXCAVATING FOR THE FOUNDATION. BY USE OF THIS PLAN THE BUILDER AGREES THAT THEY SHALL BE RESPONSIBLE FOR IMMEDIATELY REPORTING TO METROPOLITAN CONSULTING ANY DISCREPANCY OR VARIATION BETWEEN THE LATERAL INFORMATION AND GRADES DEPICTED ON THIS PLAN AND THE CONDITIONS FOUND IN THE FIELD.

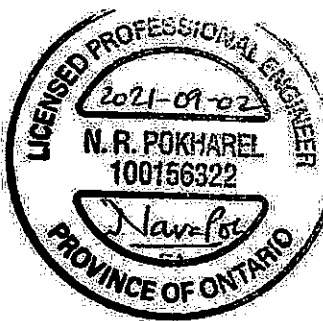

It is the builder's complete responsibility to ensure that all plans submitted for approval fully comply with the Architectural Guidelines and all applicable regulations and requirements including zoning provisions and any provisions in the subdivision agreement. The Control Architect is not responsible in any way for examining or approving site (lotting) plans or working drawings with respect to any zoning or building code or permit matter or that any house can be properly built or located on its lot.

This is to certify that these plans comply with the applicable Architectural Design Guidelines approved by the City of Hamilton.


JOHN G. WILLIAMS LTD., ARCHITECT
ARCHITECTURAL CONTROL REVIEW
AND APPROVAL
APPROVED BY:
DATE: SEP 07, 2021
This stamp certifies compliance with the applicable Design Guidelines only and bears no further professional responsibility.

CITY OF HAMILTON
BUILDING DIVISION
Planning & Development Department
SEP 13 2021
RECD BY: _____ DATE: _____
REFD TO: _____ DATE: _____

CITY OF HAMILTON
Building Division

Permit No. 21-151958

THESE STAMPED DRAWINGS SHALL BE AVAILABLE ON SITE
THE OWNER AND/OR CONTRACTOR SHALL COMPLY WITH
THE CITY OF HAMILTON BUILDING CODE AND ALL OTHER APPLICABLE LAW
UPGRADE EXPOSED ELEVATIONS (See Approved Street Elevation for Permit # 21-151958)
FOR CHIEF BUILDING OFFICIAL
Oct. 20/21

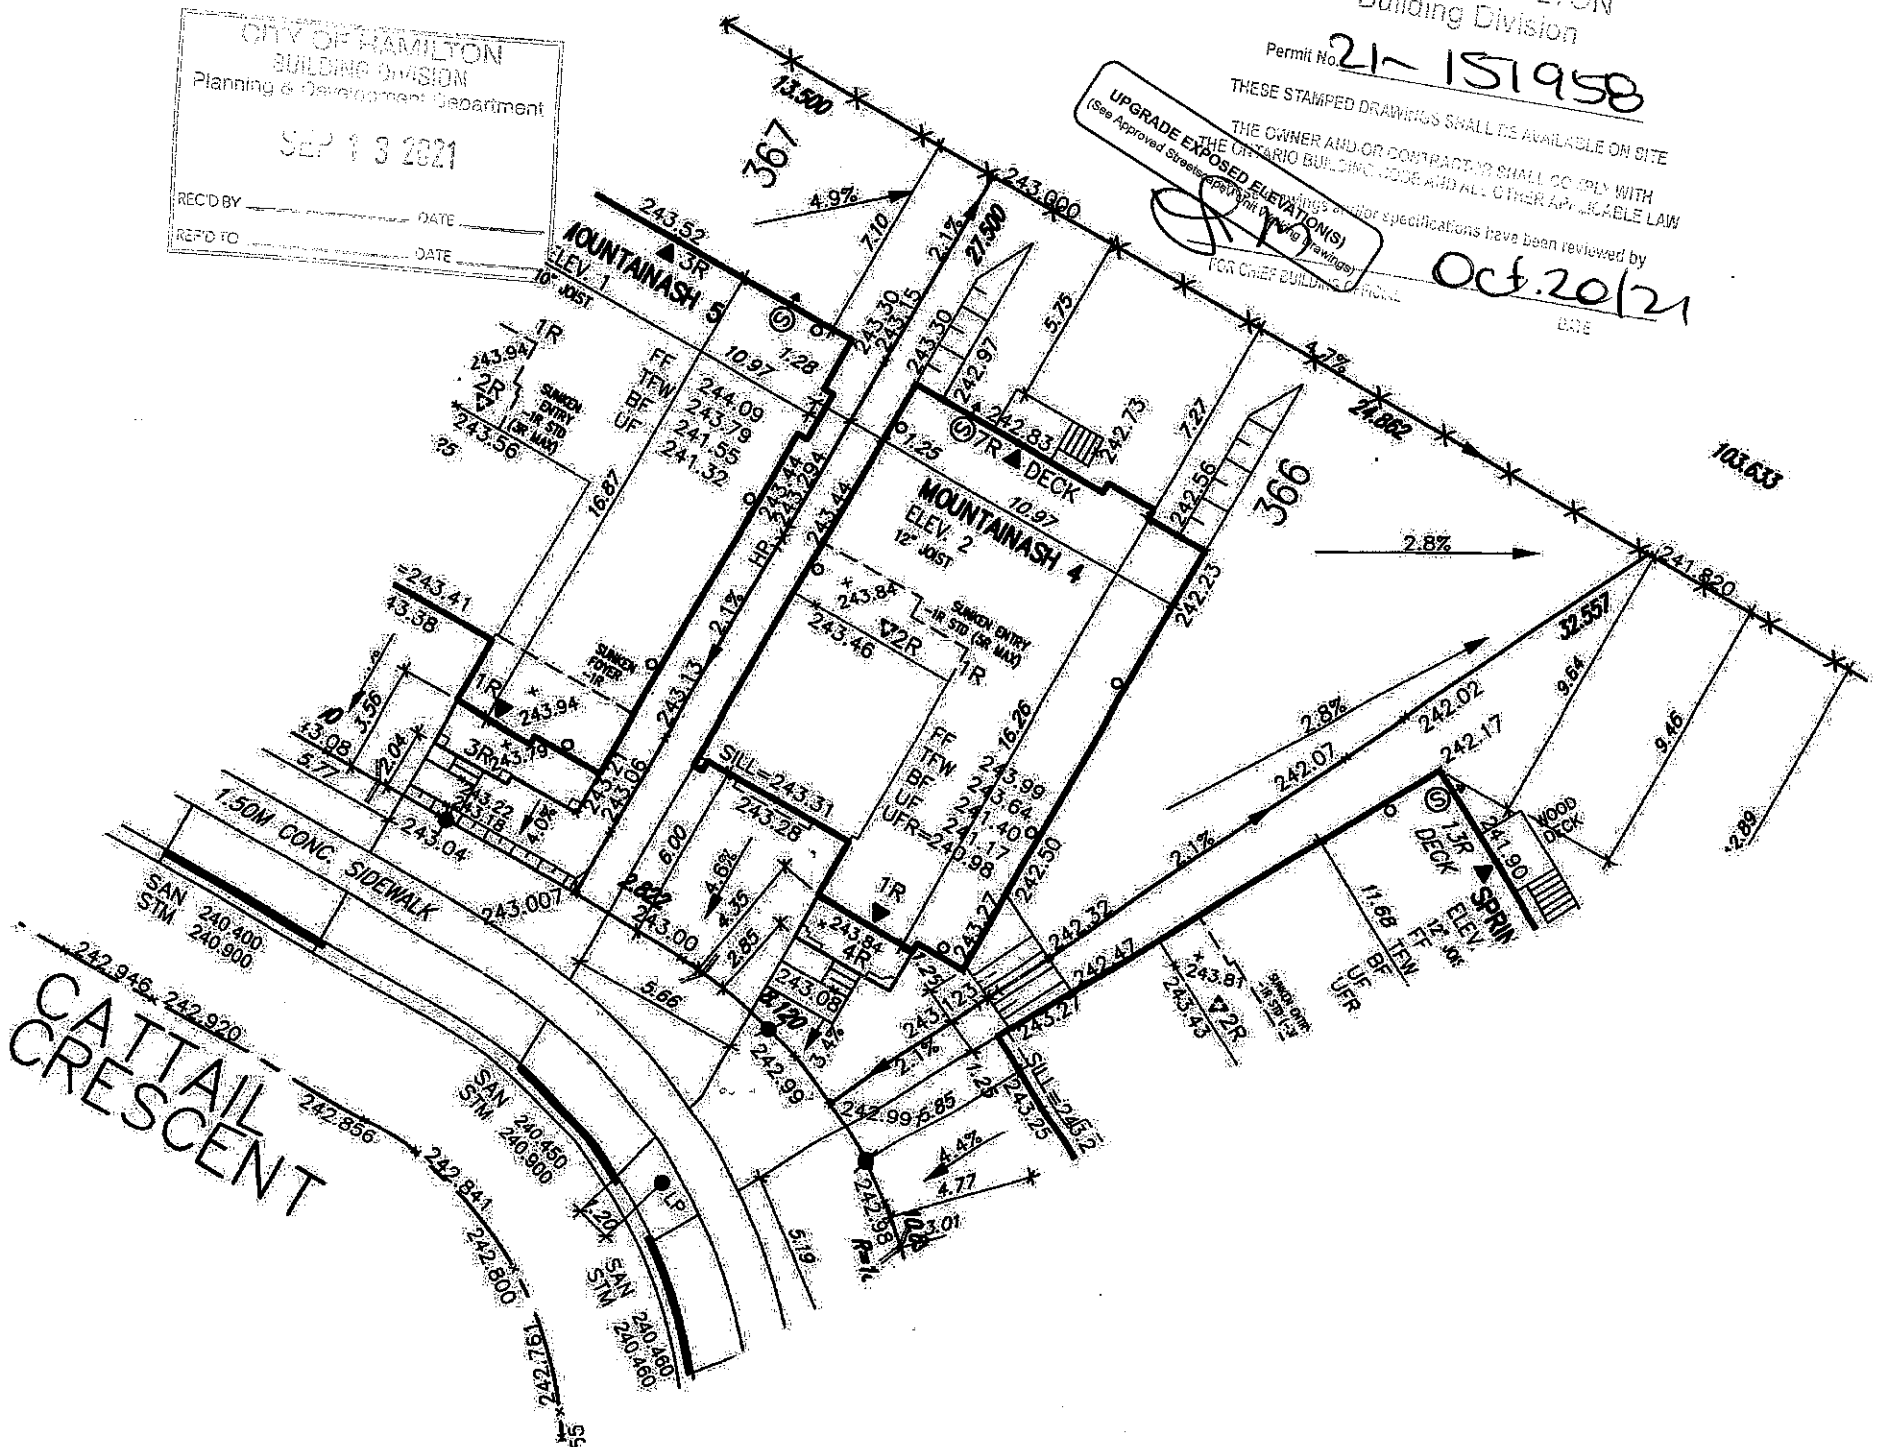

LOT 366		
LOT No.	LOT WIDTH (M) (@ 5.8m)	LOT AREA (M ²)
366	13.491	505.94

Grading Notes:
It shall be the responsibility of the builder to have all grades and services verified and checked before construction by an approved grading engineer. These grades and the placement of storm and sanitary services off the street are to meet the requirements of the municipality having jurisdiction.

VA3 Design Inc. is to be notified promptly of any discrepancies at least 1 (one) week prior to excavation commences in order that the building can be re-sited. Failure to observe these conditions may require expensive remedial action that will not be the responsibility of or cost to VA3 Design Inc. Foundation wall shall be poured to a minimum of 6" above approved grades.

Finished grade lines as indicated on the house prototype are for reference only and do not necessarily depict finish grading conditions of any particular lot.

These drawings are to be read in conjunction with municipal approved site engineering drawings prepared by Metropolitan Consulting Inc.

NOTE: REFER TO LANDSCAPE DRAWINGS FOR ALL FENCING TYPES, HEIGHTS AND LOCATIONS. CONTRACTOR TO VERIFY PRIOR TO INSTALLATION.

 PROPOSED VALVE	 LIGHT POLE	 HYDRANT	 WATER SERVICE	 TRANSFORMER	 DOUBLE STM/SAN CONNECTION	 SINGLE STM/SAN CONNECTION	 CATCH BASIN	 CABLE TELEVISION PEDESTAL	 BELL PEDESTAL	 NO. OF RISERS	 FINISHED FLOOR ELEVATION	 FINISHED WALK LEVEL ELEVATION	 UNDERSIDE FOOTING ELEVATION	 F.W. BASEMENT FLOOR SLAB	 TOP OF FOUNDATION WALL	 UNDERSIDE FOOTING AT REAR	 UNDERSIDE FOOTING AT FRONT	 UNDERSIDE FOOTING AT SIDE	 W.O.D. WALK OUT DECK	 W.O.B. WALK OUT BASEMENT	 REVERSE PLAN	 STREET SIGN	 MAIL BOX	 RETAINING WALL	 CHAIN LINK FENCE (SEE LANDSCAPE PLAN)	 ACOUSTICAL FENCE (SEE LANDSCAPE PLAN)	 WOOD SCREEN FENCE (SEE LANDSCAPE PLAN)	 HYDRO SERVICE LATERAL	 HYDRO METER	 GAS METER	 EASEMENT (RT SLOPE unless otherwise noted)		 THIS LOT CONTAINS ENGINEERED FILL	 AIR CONDITIONER REQUIRED	 RAIN WATER DOWNSPOUT LOCATION (DISCHARGE ONTO SPLASHPAD)	 SIDE WINDOW LOCATION	 OPT. DOOR LOCATION	 EXTERIOR DOOR LOCATION	 REDUCE SIDE YARD	 NORTH ARROW
--------------------	----------------	-------------	-------------------	-----------------	-------------------------------	-------------------------------	-----------------	-------------------------------	-------------------	-------------------	------------------------------	-----------------------------------	---------------------------------	------------------------------	----------------------------	-------------------------------	--------------------------------	-------------------------------	--------------------------	------------------------------	------------------	-----------------	--------------	--------------------	---	---	--	---------------------------	-----------------	---------------	--	--	---------------------------------------	------------------------------	--	--------------------------	------------------------	----------------------------	----------------------	-----------------

The undersigned has examined and taken responsibility for this design and has the qualifications and meets the requirements set out in the Ontario Building Code to be a Designer.
Qualification Information
Richard Vink 24486
name
signature
VA3 Design Inc. 42658
registration information
Builder to verify location of all hydrants, street lights, transformers and other services. If minimum dimensions are not maintained, builder is to relocate all lot lines and services.
Builder to verify service connection elevations prior to constructing foundations. Drawings NOT to be scaled.

VA3 DESIGN
255 Consumers Rd Suite 120
Toronto ON M2J 1R4
416.630.2255 F 416.630.4782
va3design.com

Greenpark
project name
RUSSELL GARDENS PHASE 4
municipality
HAMILTON
date
JUL 2021
drawn by
GW
checked by
scale
1:250
LOT SITING/GRADING
20027-RC4-SITE-LAYOUTS
file name
20027-RC4-SITE-LAYOUTS.dwg - Fri - Aug 27, 2021 - 8:35 AM

lot/block no.
366
registered plan no.
62M-1266
project no.
20027
drawing no.
1