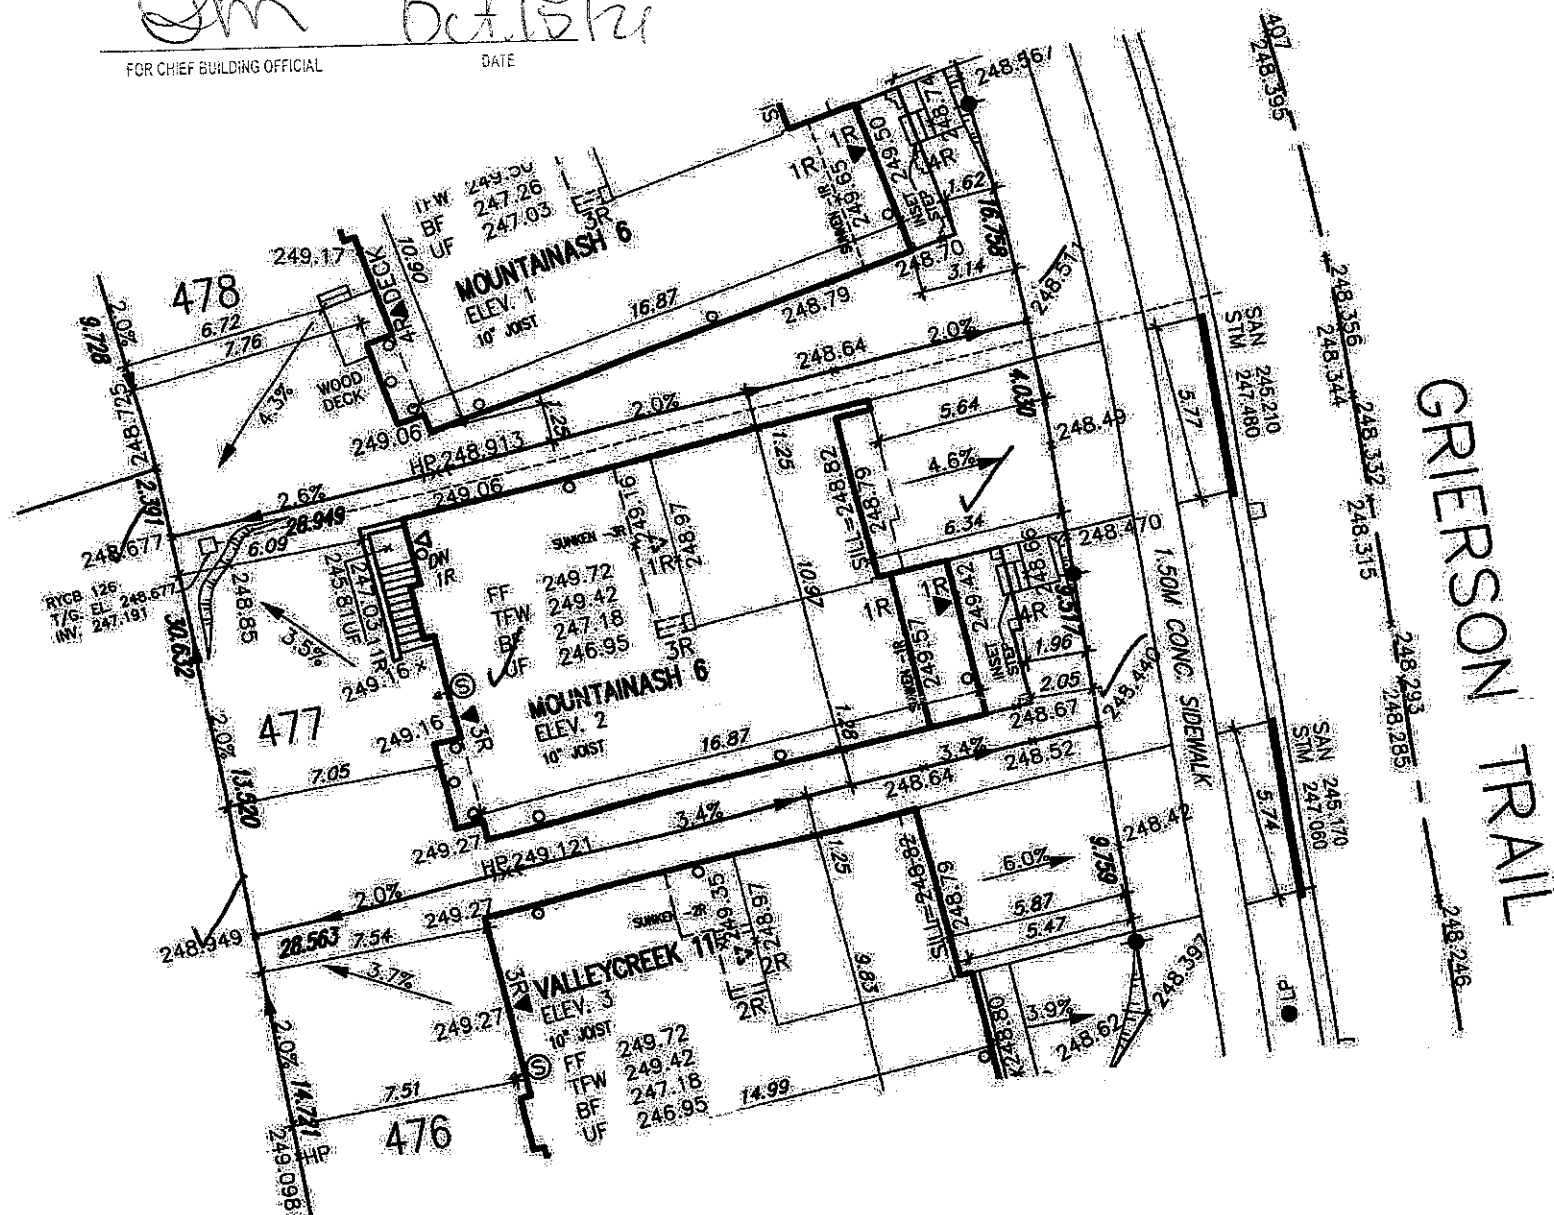


A circular professional seal for a Licensed Professional Engineer in the Province of Ontario. The outer ring contains the text "LICENSED PROFESSIONAL ENGINEER" at the top and "PROVINCE OF ONTARIO" at the bottom. The center of the seal features the name "N. R. POKHAREL" and the license number "100156322". Above the name is a handwritten number "1021-09-07" inside a horizontal oval, and below the name is a handwritten signature "Nava Pokharel" inside another horizontal oval.

This stamp certifies compliance with the applicable Design Guidelines only and bears no further professional responsibility.

DATE _____

REC'D BY _____ DATE _____
REC'D TO _____ DATE _____

[illegible][illegible]