


THIS LOT GRADING PLAN HAS BEEN REVIEWED BY METROPOLITAN CONSULTING INC. FOR CONFORMANCE WITH THE APPROVED SUBDIVISION GRADING DESIGN. THE PROPOSED GRADES ON THIS PLAN ARE IN GENERAL CONFORMITY WITH THE APPROVED GRADING PLAN AS IT RELATES TO THIS LOT AND ADJACENT LOTS. WHERE THE BASEMENT FLOOR OR OTHER FOUNDATION ELEVATIONS ARE PROPOSED AT A DIFFERENT ELEVATION THAN THAT SHOWN ON THE APPROVED SUBDIVISION PLANS THE SEWER LATERALS HAVE BEEN REVIEWED AND WE ARE SATISFIED THAT THE MINIMUM GRADES FOR THESE LATERALS CAN BE MAINTAINED IN ACCORDANCE WITH THE REQUIREMENTS OF THE O.B.C. AND CITY DESIGN CRITERIA. NOTE: THIS CERTIFICATION DOES NOT REPLACE THE BUILDER'S RESPONSIBILITY TO EXPOSE THE SEWER LATERALS AND CONFIRM ELEVATIONS PRIOR TO EXCAVATING FOR THE FOUNDATION. BY USE OF THIS PLAN THE BUILDER AGREES THAT THEY SHALL BE RESPONSIBLE FOR IMMEDIATELY REPORTING TO METROPOLITAN CONSULTING ANY DISCREPANCY OR VARIATION BETWEEN THE LATERAL INFORMATION AND GRADES DEPICTED ON THIS PLAN AND THE CONDITIONS FOUND IN THE FIELD.

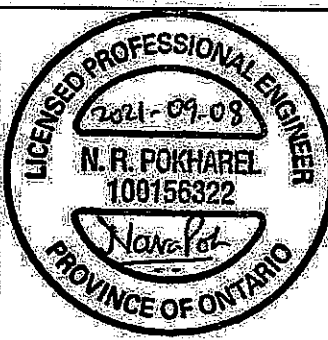

It is the builder's complete responsibility to ensure that all plans submitted for approval fully comply with the Architectural Guidelines and all applicable regulations and requirements including zoning provisions and any provisions in the subdivision agreement. The Control Architect is not responsible in any way for examining or approving site (lotting) plans or working drawings with respect to any zoning or building code or permit matter or that any house can be properly built or located on its lot.

This is to certify that these plans comply with the applicable Architectural Design Guidelines approved by the City of Hamilton.


JOHN G. WILLIAMS LTD., ARCHITECT
ARCHITECTURAL CONTROL REVIEW
AND APPROVAL

APPROVED BY:

DATE: SEP 10, 2021

This stamp certifies compliance with the applicable Design Guidelines only and bears no further professional responsibility.

HOLCOMB TERRACE

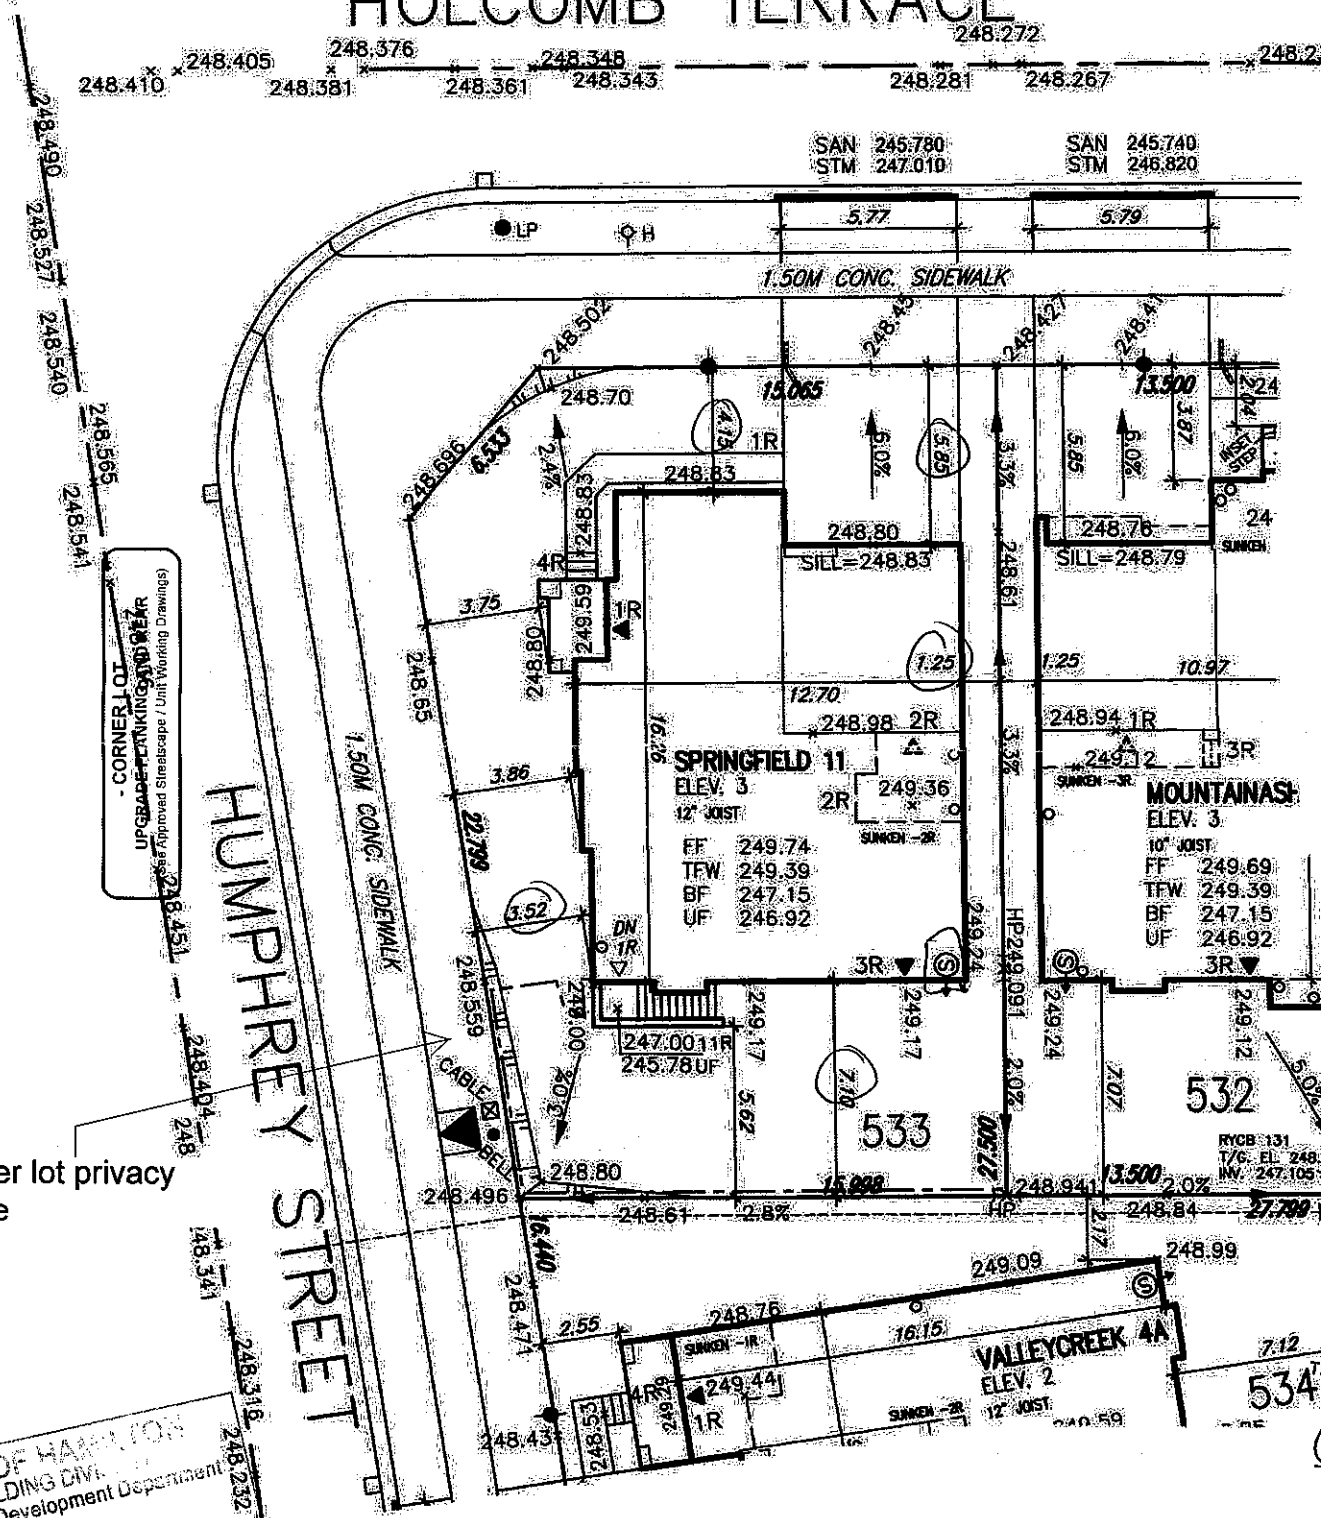

CITY OF HAMILTON
Building Division

Permit No. 21-161653

THESE STAMPED DRAWINGS SHALL BE AVAILABLE ON SITE
THE OWNER AND/OR CONTRACTOR SHALL COMPLY WITH
THE OFFICIAL BUILDING CODE AND ALL OTHER APPLICABLE LA

These drawings and/or specifications have been reviewed by
Carmen Chu Dec 10/21
FOR CHIEF BUILDING OFFICIAL
DATE

CITY OF HAMILTON
BUILDING DIVISION
Planning & Development Department
NOV 16 2021

REC'D BY _____ DATE _____
REF'D TO _____ DATE _____

LOT 533		
LOT No.	LOT WIDTH (M) (@ 5.8m)	LOT AREA (M ²)
533	19.207	483.49

Grading Notes:
It shall be the responsibility of the builder to have all grades and services verified and checked before construction by an approved grading engineer. These grades and the placement of storm and sanitary services off the street are to meet the requirements of the municipality having jurisdiction.

VA3 Design Inc. is to be notified promptly of any discrepancies at least 1 (one) week prior to excavation commences in order that the building can be re-sited. Failure to observe these conditions may require expensive remedial action that will not be the responsibility of or cost to VA3 Design Inc. Foundation wall shall be poured to a minimum of 6" above approved grades.

Finished grade lines as indicated on the house prototype are for reference only and do not necessarily depict finish grading conditions of any particular lot.

These drawings are to be read in conjunction with municipal approved site engineering drawings prepared by Metropolis Consulting Inc.

PROPOSED VALVE
LP LIGHT POLE
H HYDRANT
WATER SERVICE
DOUBLE S/S/S CONNECTION
SINGLE S/S/S CONNECTION
CATCH-BASIN
CABLE TELEVISION PEDestal
BELL PEDestal

NO. OF RISERS
FF FINISHED FLOOR ELEVATION
ML FINISHED MAIN LEVEL ELEVATION
UF UNDERSIDE FOOTING ELEVATION
FF FIN. BASEMENT FLOOR SLAB
TOP OF FOUNDATION WALL
UPR UNDERSIDE FOOTING AT REAR
UPR UNDERSIDE FOOTING AT FRONT
UPR UNDERSIDE FOOTING AT SIDE
W.O.B. WALK OUT BECK
W.O.B. WALK OUT BASEMENT
REV REVERSE PLAN

STREET SIGN
MAIL BOX
RETAINING WALL
CHAIN LINK FENCE (SEE LANDSCAPE PLAN)
ACOUSTICAL FENCE (SEE LANDSCAPE PLAN)
WOOD SCREEN FENCE (SEE LANDSCAPE PLAN)
HYDRO SERVICE LATERAL
HYDRO METER
GAS METER
EMBANKMENT (AT SLOPE UNLESS OTHERWISE NOTED)

PROVIDE 3/4" DIA. CLEAR STONE IN THIS AREA
THIS LOT CONTAINS ENGINEERED FILL
AIR CONDITIONER REQUIRED
RAIN WATER DOWNSPOUT LOCATION (DISCHARGE OVER SPLASHING)
SIDE WINDOW LOCATION
OPT. DOOR LOCATION
EXTERIOR DOOR LOCATION
REDUCE SIDE YARD

NOTE: REFER TO LANDSCAPE DRAWINGS FOR ALL FENCING TYPES, HEIGHTS AND LOCATIONS. CONTRACTOR TO VERIFY PRIOR TO INSTALLATION.

no.	description	date	by
1	ISSUED FOR PERMIT	AUG 27/21	GW

VA3 DESIGN
255 Consumers Rd Suite 120
Toronto, ON M2J 1R4
T 416.630.2255 F 416.630.4782
va3design.com

Greenpark
project name
RUSSELL GARDENS PHASE 4
municipality
HAMILTON
date
JUL 2021
drawn by
GW
checked by
scale
1:250
20027-RG4-SITE-LAYOUTS
FILE NAME
20027-RG4-SITE-LAYOUTS.dwg
DATE
Aug 27, 2021 9:42 AM

lot/block no. 533
registered plan no. 62M-1266
project no. 20027
drawing no. 1