


THIS LOT GRADING PLAN HAS BEEN REVIEWED BY METROPOLITAN CONSULTING INC. FOR CONFORMANCE WITH THE APPROVED SUBDIVISION GRADING DESIGN. THE PROPOSED GRADES ON THIS PLAN ARE IN GENERAL CONFORMITY WITH THE APPROVED GRADING PLAN AS IT RELATES TO THIS LOT AND ADJACENT LOTS. WHERE THE BASEMENT FLOOR OR OTHER FOUNDATION ELEVATIONS ARE PROPOSED AT A DIFFERENT ELEVATION THAN THAT SHOWN ON THE APPROVED SUBDIVISION PLANS THE SEWER LATERALS HAVE BEEN REVIEWED AND WE ARE SATISFIED THAT THE MINIMUM GRADES FOR THESE LATERALS CAN BE MAINTAINED IN ACCORDANCE WITH THE REQUIREMENTS OF THE O.B.C. AND CITY DESIGN CRITERIA. NOTE: THIS CERTIFICATION DOES NOT REPLACE THE BUILDER'S RESPONSIBILITY TO EXPOSE THE SEWER LATERALS AND CONFIRM ELEVATIONS PRIOR TO EXCAVATING FOR THE FOUNDATION. BY USE OF THIS PLAN THE BUILDER AGREES THAT THEY SHALL BE RESPONSIBLE FOR IMMEDIATELY REPORTING TO METROPOLITAN CONSULTING ANY DISCREPANCY OR VARIATION BETWEEN THE LATERAL INFORMATION AND GRADES DEPICTED ON THIS PLAN AND THE CONDITIONS FOUND IN THE FIELD.

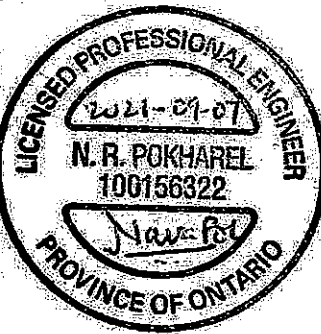

It is the builder's complete responsibility to ensure that all plans submitted for approval fully comply with the Architectural Guidelines and all applicable regulations and requirements including zoning provisions and any provisions in the subdivision agreement. The Control Architect is not responsible in any way for examining or approving site (lotting) plans or working drawings with respect to any zoning or building code or permit matter or that any house can be properly built or located on its lot.

This is to certify that these plans comply with the applicable Architectural Design Guidelines approved by the City of Hamilton.

JOHN G. WILLIAMS LTD., ARCHITECT  
ARCHITECTURAL CONTROL REVIEW  
AND APPROVAL

APPROVED BY:   
DATE: SEP 08 2021

This stamp certifies compliance with the applicable Design Guidelines only and bears no further professional responsibility.

CITY OF HAMILTON  
Building Division

Permit No. 21-152034

THESE STAMPED DRAWINGS SHALL BE AVAILABLE ON SITE

THE OWNER AND/OR CONTRACTOR SHALL COMPLY WITH THE ONTARIO BUILDING CODE AND ALL OTHER APPLICABLE LAW


These drawings and specifications have been reviewed by

DATE 06/20/21  
FOR CHIEF BUILDING OFFICIAL

CITY OF HAMILTON  
BUILDING DIVISION  
Planning & Development Department

SEP 13 2021

REC'D BY: \_\_\_\_\_ DATE: \_\_\_\_\_  
REF'D TO: \_\_\_\_\_ DATE: \_\_\_\_\_

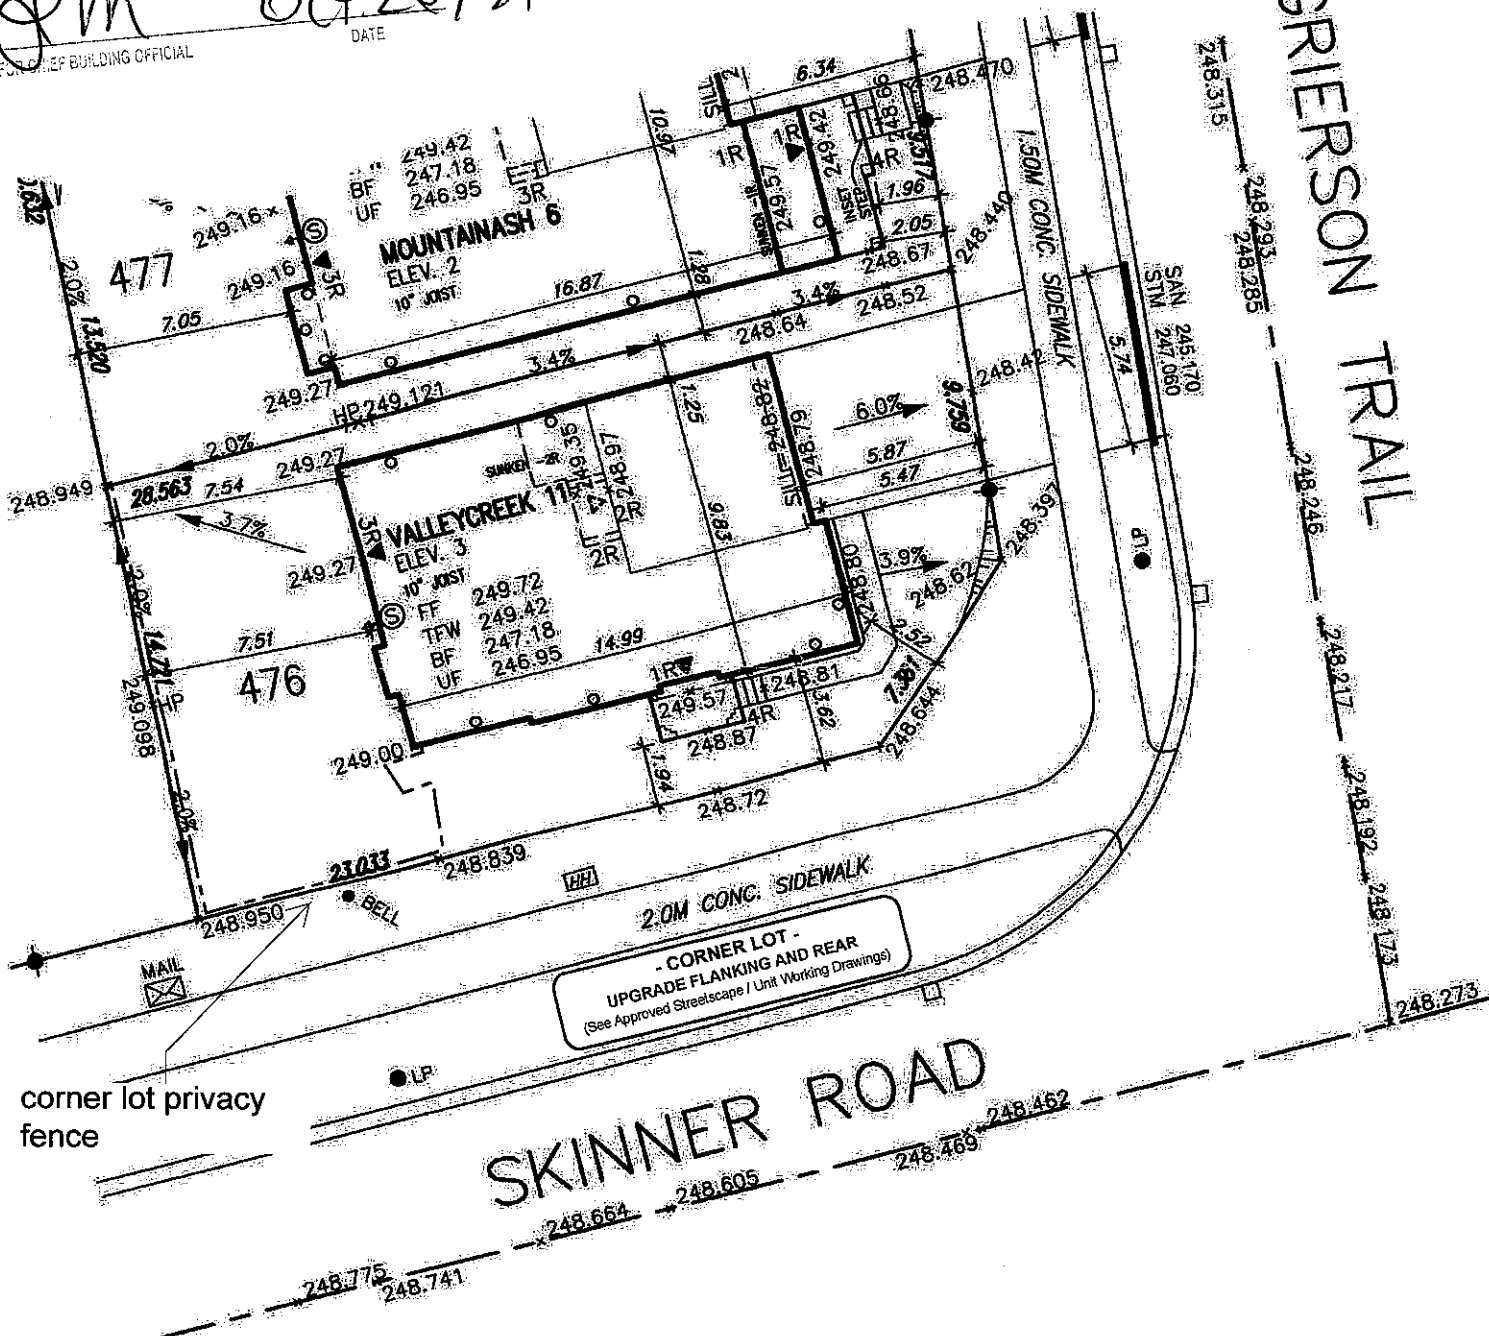

LOT 476		
LOT No.	LOT WIDTH (M) (± 5.8m)	LOT AREA (M²)
476	14.759	403.53

**Grading Notes:**  
It shall be the responsibility of the builder to have all grades and services verified and checked before construction by an approved grading engineer. These grades and the placement of storm and sanitary services off the street are to meet the requirements of the municipality having jurisdiction.

VA3 Design Inc. is to be notified promptly of any discrepancies of least 1 (one) week prior to excavation commences in order that the building can be re-sited. Failure to observe these conditions may require expensive remedial action that will not be the responsibility of or cost to VA3 Design Inc. Foundation wall shall be poured to a minimum of 6\"/>

Finished grade lines as indicated on the house prototype are for reference only and do not necessarily depict finish grading conditions of any particular lot.

These drawings are to be read in conjunction with municipal approved site engineering drawings prepared by Metropolitan Consulting Inc.

NOTE: REFER TO LANDSCAPE DRAWINGS FOR ALL FENCING TYPES, HEIGHTS AND LOCATIONS. CONTRACTOR TO VERIFY PRIOR TO INSTALLATION.

- PROPOSED VALUE  
LP LIGHT POLE  
H HYDRANT  
WATER SERVICE  
TRANSFORMER  
DOUBLE STL/SAN. CONNECTION  
SINGLE STL/SAN. CONNECTION  
CATCH BASIN  
CABLE TELEVISION PEDESTAL  
BELL PEDESTAL

- NO. OF RISERS  
FF FINISHED FLOOR ELEVATION  
ML FINISHED MAIN LEVEL ELEVATION  
UF UNDERSIDE FOOTING ELEVATION  
PFL FIN. BASEMENT FLOOR SLAB  
TFW TOP OF FOUNDATION WALL  
UFR UNDERSIDE FOOTING AT REAR  
UFR UNDERSIDE FOOTING AT FRONT  
UFS UNDERSIDE FOOTING AT SIDE  
W.O.D. WALK-OUT DECK  
W.O.B. WALK-OUT BASEMENT  
REV. REVERSE PLAN

- STREET SIGN  
MAIL BOX  
RETAINING WALL  
CHAIN LINK FENCE (SEE LANDSCAPE PLAN)  
ACROUSTICAL FENCE (SEE LANDSCAPE PLAN)  
WOOD SCREEN FENCE (SEE LANDSCAPE PLAN)  
HYDRO SERVICE LATERAL  
HYDRO METER  
GAS METER  
SEWERAGE (ST SLOPE unless otherwise noted)

- PROVIDE 3/4\"/>



no.	description	date	by
9			
8			
7			
6			
5			
4			
3			
2			
1	ISSUED FOR PERMIT	AUG 27/21	GW

The undersigned has reviewed and takes responsibility for this design and has the qualifications and meets the requirements set out in the Ontario Building Code to be a Designer.

Richard Vink 24488  
signature  
name  
registration information  
VA3 Design Inc. 42658

Builder to verify location of all hydrants, street lights, transformers and other services. If position/conditions are not maintained, builder is to relocate at his own expense.  
Builder to verify service connection elevations prior to constructing foundations. Drawings NOT to be used as

**VA3 DESIGN**  
255 Consumers Rd Suite 120  
Toronto ON M2J 1R4  
416.630.2255 / 416.630.4782  
va3design.com

**Greenpark**  
project name: RUSSELL GARDENS PHASE 4  
municipality: HAMILTON  
date: JUL 2021  
drawn by: \_\_\_\_\_  
checked by: \_\_\_\_\_  
scale: 1:250  
file name: 20027-RG4-SITE-LAYOUTS.dwg  
date: Aug 27, 2021 9:04 AM

lot/block no. 476  
registered plan no. 62M-1266  
project no. 20027  
drawing no. 1