BELLINED

NOV 0 3 2021

CONSTRUCTION SUMMARY

Mountainview Heights 3 (G) - Russell Gardens Building Ltd.

PURCHASERS: Hassan AZEEM and Faiza HASSAN

TEL: RES.: 647-649-6409

380 / 4 62M-1266	Mountainash Five (5 Bedroom) Elev 2	a ,

CABINETRY ACCESSORIES	
1 - KITCHEN CABINETRY UPPER - ANGLED CORNER CABINET - FITS TALL UPPER CABINETS - PER UNIT - STANDARD	
28Oct21 Note:	
1 - KITCHEN CABINETRY - RELOCATE FRIDGE TO SERVERY WALL	
28Oct21 Note:	
1 - KITCHEN CABINETRY UPPER - FULL DEPTH ABOVE FRIDGE - WITH GABLES - 600MM - PRICE IS EACH - STANDARD	
28Oct21 Note:	
1 - PANTRY UNIT UPGRADE - TO GO FROM 300MM TO 600MM DEEP - PRICE IS PER FOOT - STANDARD	
28Oct21 Note:	
1 - CABINETRY FEE FOR FLUSH CUTOUT ON WALL OVEN/MICROWAVE COMBO CABINET ONLY	
28Oct21 Note:	8
1 - KITCHEN CABINETRY - BUILT-IN MICROWAVE/OVEN COMBO - STANDARD	
28Oct21 Note:	*
1 - KITCHEN CABINETRY BASE - COOKTOP CABINET WITH POT DRAWERS (2 DRAWERS) - STANDARD	
28Oct21 Note:	
CERAMIC TILE	я
1 - PRICE IS FOR LABOUR ONLY - INSTALL TILE IN A STAGGERED PATTERN BATHROOM 4/5 - SHOWER	
28Oct21 Note:	
1 - PRICE IS FOR LABOUR ONLY - INSTALL TILE IN A STAGGERED PATTERN BATHROOM 2/3 - SHOWER	
28Oct21 Note:	
1 - PRICE IS FOR LABOUR ONLY - INSTALL TILE IN A STAGGERED PATTERN ENSUITE WALL TILE - SHOWER	
28Oct21 Note:	
1 - TILE - UPGRADE 1 WALL TILE BATHROOM 4/5 - SHOWER	>
28Oct21 Note:	
1 - TILE - UPGRADE 1 WALL TILE BATHROOM 2/3 - SHOWER	
28Oct21 Note:	
1 - TILE - UPGRADE 1 WALL TILE ENSUITE WALL TILE - SHOWER	
280ct21 Note:	
1 - TILE - UPGRADE 1 FLOOR TILE ENSUITE BATHROOM - FLOOR	
28Oct21 Note:	
CONSTRUCTION	
CONSTRUCTION CONSTRUCTION WINDOW IS 30 INCHES X 24 INCHES	
3 - ENLARGE BASEMENT WINDOWS (MAY REQUIRE WINDOW WELLS) - WINDOW IS 30 INCHES X 24 INCHES	
25May21 Note:	0
COUNTER TOP	
1 - COUNTERTOP CUTOUT PROVISION FOR COOKTOP	

ELECTRICAL

280ct21 Note:

CONSTRUCTION SUMMARY

Mountainview Heights 3 (G) - Russell Gardens Building Ltd.

PURCHASERS: Hassan AZEEM and Faiza HASSAN

TEL: RES.: 647-649-6409

TURCHASERS: Hassan 7 kg				
LOT / PHASE 380 / 4	REG. PLAN#	HOUSE TYPE Mountainash Five (5 Bedroom) Elev 2		
		IGHT TO BE CENTERED OVER STAIRCASE - IF COM	ISTRUCTION PERMIT	s
28Oct21 Note:	OTTER HALLWATE.	KOTT TO BE CENTERED OF EACH		
1 - PLUG - ELECTRICAL P	LUG - TO BE INSTALL	ED OVER FIREPLACE		
280ct21 Note:				
1 - POT LIGHT - LED - FIRS	ST FLOOR INSTALLAT	TION - BREAKFAST - TO BE INSTALLED ON A SEPA	RATE SWITCH FROM	
STANDARD LIGHT 28Oct21 Note:				-
1 - POT LIGHT - LED - FIR	ST FLOOR INSTALLA	TION - LIVING/DINING ROOM - TO BE INSTALLED	ON A SEPARATE SWIT	ГСН
FROM STANDARD LIGHT 28Oct21 Note:				
1 - POT LIGHT - LED - FIR	ST FLOOR INSTALLA	TION - FAMILY ROOM - TO BE INSTALLED ON A SI	EPARATE SWITCH FRO	OM
STANDARD LIGHT 28Oct21 Note:				
1 - STANDARD DINING RO	OOM LIGHT TO BE CE	NTERED BETWEEN LIVING AND DINING ROOM		
28Oct21 Note:				
1 - RELOCATE STANDARI	D KITCHEN LIGHT TO	BE CENTERED OVER ISLAND		
28Oct21 Note:				
1 - BUILT IN OVEN AND O	COOKTOP PROVISION	- PROVISION ONLY - ELECTRICAL ONLY		
280ct21 Note:				
1 - 200 AMP ELECTRICAL	SERVICE			
25May21 Note:				
FIREPLACE AND ACC				
1 - GAS LINE ROUGH-IN I 28Oct21 Note:	FOR STOVE (INCLUDE	ES ELECTRICAL OUTLET) - FIRST FLOOR		
28Oct21 Note.				
HARDWOOD FLOORI		A TOTAL OF A 1/4 DIGUNATURAL DED OAV FAMIL	V ROOM	· · · · · · · · · · · · · · · · · · ·
1 - HARDWOOD - GROUP 28Oct21 Note:	B SERIES 5 INCH - IN	LIEU OF 2 1/4 INCH NATURAL RED OAK FAMII	, i koow	
1 - HARDWOOD - GROUP	B SERIES 5 INCH - IN	LIEU OF 2 1/4 INCH NATURAL RED OAK LIBRA	RY/DEN	
28Oct21 Note:				
1 - HARDWOOD - GROUP	B SERIES 5 INCH - IN	LIEU OF 2 1/4 INCH NATURAL RED OAK LIVIN	G AND DINING ROOM	
28Oct21 Note:				
1 - HARDWOOD - GROUP 28Oct21 Note:	B SERIES 5 INCH - IN	LIEU OF 2 1/4 INCH NATURAL RED OAK MAIN	HALL	
PLUMBING				
1 - DELETE SERVERY SI	NK			
280ct21 Note:				
3 - TOE TESTER - ADD TO	DE TESTER TO SHOW	ER		
25May21 Note:				

CONSTRUCTION SUMMARY

Mountainview Heights 3 (G) - Russell Gardens Building Ltd.

PURCHASERS: Hassan AZEEM and Faiza HASSAN

TEL: RES.: 647-649-6409

LOT / PHASE	REG. PLAN #	HOUSE TYPE	
380 / 4	62M-1266	Mountainash Five (5 Bedroom) Elev 2	

1 - 5 FOOT SHOWER WITH SLIDING GLASS CHROME DOORS IN LIEU OF TUB

25May21 Note: ENSUITE 3/4

PROMOTIONAL

1 - LESS BALANCE OF CREDIT FROM PURCHASER EXTRA SHEET IN OFFER

28Oct21 Note:

1 - LESS CREDIT FROM PURCHASER EXTRA SHEET IN OFFER

25May21 Note: NEW PROMO BALANCE \$4200.00

STAIRS AND RAILINGS

7 y 11

EXTRAS AS PER OFFER

FAMILY ROOM FIREPLACE CAN NOT PROJECT INTO SIDE YARD DUE TO LOT REQUIREMENTS Worksheet Note:	
PURCHASER(S) ACKNOWLEDGES THAT THE PURCHASE PRICE IS INCLUSIVE OF ALL CREDITS AND PROMOTIONAL PACKAGES AVAILABLE AT TIME OF PURCHASE. Worksheet Note:	
(1) The Vendor agrees that notwithstanding any other term or provision in this Agreement included in the Purchase Price and in addition to those items detailed in Schedule GP to the Agreement of Purchase and Sale, the Purchaser is entitled to a credit of Worksheet Note:	я
Granite kitchen counter top, from Vendor?s standard samples Worksheet Note:	

This Document is Extremely Time Sensitive - Printed $\underline{28 \ \text{Oct } 21}$ at $\underline{13:25}$

INTERIOR COLOUR SCHEME

Purchasers:

Hassan AZEEM & Faiza HASSAN

Property: 380

Telephone Res. / Bus: (647) 649-6409 /

Project: Russell Gardens Building Ltd.

Decor Advisor: Lock Date:

Aly Aversa 28-Oct-21

Model and Elevation: Mountainash Five (5 Bedroom) Elev 2

28-Oct-21

62M-1266 Plan #:

1. Cabinetry	Style and Colour		Hardware 448SA			
itchen / Breakfast	CONTINENTAL 823 DRIFT WOOD					
aundry Room	ELISSE					
	CONTINENTAL 350 PLATINUM SILVER					
laster Ensuite Bathroom						
nsuite Bath - Bedroom 2/3 CONTINENTAL 823 DRIFT WOOD						
	CONTINENTAL 823 DRIFT WOOD					
appliances:	Built In Appliances Yes No	Slide In Stove O				
ishwasher Cabinet	○ Closed ● Open 41" Upper Cabinets ● Y					
tove Opening		NOTE: If not specified, opening will be set to builder's standard opening of approximately 30" width				
ridge Opening NOTE: If not specified, opening will be set to builder's standard opening of approximation of the control of th			width v 74" hair			
		ilder's standard opening of approximately 37"	WIGHT X 74 Heig			
		ilder's standard opening of approximately 37"	WIGHT X 74 TIES			
* Refer to Construction S	ummary		WIGHT X 74 Heig			
* Refer to Construction S	ummary	Edge	WIGHT X 74 Heig			
Refer to Construction S Counters Citchen / Breakfast	ummary		WIGHT X 74 Heigh			
Refer to Construction S Counters Citchen / Breakfast Laundry Room	ummary Counter GRANITE-GRIGIO SARDO		WIGHT X 74 TIES			
Refer to Construction S Counters Citchen / Breakfast Laundry Room Powder Room	ummary Counter GRANITE-GRIGIO SARDO N/A		WIGHT X 74 TIES			
* Refer to Construction S 2. Counters Kitchen / Breakfast Laundry Room Powder Room Master Ensuite Bathroom	Counter GRANITE-GRIGIO SARDO N/A LAMINATE-KALAHARI TOPAZ 4588K-07		WIGHT X 74 TIES			
* Refer to Construction S 2. Counters Kitchen / Breakfast Laundry Room Powder Room Master Ensuite Bathroom Ensuite Bath - Bedroom 2/3	Counter GRANITE-GRIGIO SARDO N/A LAMINATE-KALAHARI TOPAZ 4588K-07 LAMINATE-WHITE TIGRIS 4783-60		WIGHT X 74 TIES			
Kitchen / Breakfast Laundry Room Powder Room Master Ensuite Bathroom Ensuite Bath - Bedroom 2/3	Counter GRANITE-GRIGIO SARDO N/A LAMINATE-KALAHARI TOPAZ 4588K-07 LAMINATE-WHITE TIGRIS 4783-60 LAMINATE-PALOMA BISQUE 6729-46		WIGHT X 74 TIES			

** Refer to Construction Summary



INTERIOR COLOUR SCHEME Greenpark. Property: 380 Hassan AZEEM & Faiza HASSAN Purchasers: Project: Russell Gardens Building Ltd. Telephone Res. / Bus: (647) 649-6409 / Model and Elevation: Mountainash Five (5 Bedroom) Elev 2 Decor Advisor: Aly Aversa 62M-1266 Plan #: 28-Oct-21 28-Oct-21 Lock Date: 3. Ceramic Flooring At a 45 Threshold-If App. Metal Strip Where Applic. Entrance Vestibule TILE-GARDA GREY 13X13 HARDWOOD Main Hall TILE-GARDA GREY 13X13 Kitchen / Breakfast TILE-ESSENZE BIANCO 13X13 Laundry Room TILE-GARDA GREY 13X13 **Powder Room** TILE-CRAFT COTTON 12X24 Master Ensuite Bathroom TILE-GARDA SAND 13X13 Ensuite Bath - Bedroom 2/3 Ensuite Bath - Bedroom 4/5 TILE- ESSENZE GRIGIO 13X13 TILE-GARDA GREY 13X13 **Mud Room** ** Refer to Construction Summary 4. Ceramic Wall Tile Describe Master Ensuite Bathroom Selection Tub Deck Wall N/A Tub Deck N/A Tub Deck Skirt N/A TO BE LAID STAGGERED Shower Stall TILE-CRAFT COTTON 12X24 Bathtub Enclosure Walls N/A TO BE LAID STAGGERED TILE-ANDE SABBIA 12X24 Ensuite Bath - Bedroom 2/3 TO BE LAID STAGGERED TILE-STONE WHITE 12X24 Ensuite Bath - Bedroom 4/5 **Mud Room** N/A Kitchen Backsplash ** Refer to Construction Summary - STANDARD GROUT THROUGHOUT UNLESS SPECIFIED 5. Plumbing Fixtures Whirlpool White All Bathrooms Yes ■ No Dishwasher Rough-In Yes No Waterline for Fridge Yes No ** Refer to Construction Summary

6. Trim Carpentry
Interior Doors
Interior Trim
As Per Construction Specifications
Door Handles
Exterior Front Door Handle
As Per Construction Specifications

As Per Construction Specifications

Exterior Front Door Handle
As Per Construction Specifications

** Refer to Construction Summary



CHOOM	ork		INTE	RIOR COLOUR S	SCHEME		
Greenp	ark						
Purchasers:	Hassa	an AZEEM & Faiza	a HASSAN	Property	: 380		
Telephone Res. / E		649-6409 /	Project	ardens Building Ltd.			
Decor Advisor:	Aly Av		odel and Elevation	: Mountaina	ash Five (5 Bedroom) Elev 2		
	28-Oc		28-Oct-21		Plan #:	62M-1266	
Lock Date:		,ι−∠ ı	20 000 21				
Main Hall		ARDWOOD-VINTAGI	NORTHERN SOL	ID SAWN COLLECTION	CHARACTER	R UV UR. OIL WHITE OAK 5" APOLLO	
Living Room	H	RDWOOD-VINTAGE-NORTHERN SOLID SAWN COLLECTION CHARACTER UV UR. OIL WHITE OAK 5" APOLL(
Dining Room HARDWOOD-VINTAGE-NORTHERN SOLID SAWN COLLECTION CHARACT				I CHARACTER	R UV UR. OIL WHITE OAK 5" APOLLO		
Family Room	V Room HARDWOOD-VINTAGE-NORTHERN SOLID SAWN COLLECTION CHARACTER UV UR. OIL WHITE OAK					R UV UR. OIL WHITE OAK 5" APOLL(
Den / Library / Study HARDWOOD-VINTAGE-NORTHERN SOLID SAWN COLLECTION CHARACTER UV					R UV UR. OIL WHITE OAK 5" APOLL(
Basement Landing(If A	Applies) N	/A					
Lower Landing (If App	lies) H	ARDWOOD-VINTAGI	E-NORTHERN SOI	ID SAWN COLLECTION	I CHARACTE	R UV UR. OIL WHITE OAK 5" APOLLO	
Upper Landing					I CHARACTE	R UV UR. OIL WHITE OAK 5" APOLL(
Upper Hall		AMINATE-LEXINGTO					
Master Bedroom		AMINATE-LEXINGTO					
Bedroom #2		AMINATE-LEXINGTO					
Bedroom #3		AMINATE-LEXINGTO					
Bedroom #4		AMINATE-LEXINGTO					
Bedroom #5	L	AMINATE-LEXINGTO	N-LANDEN OAK-1	L-LVV1318			
** Refer to Constr	uction Sum	ımary					
8. Railings an	d Pickets						
_	V-GROOVE			Complimenting Co	lour VINTAG	GE-WHITE OAK-APOLLO	
1 (2	EUROLINE '	1		Complimenting Colour BLACK			
Stringer / Riser	AS PER CO	ONSTRUCTION S	SPECIFICATIO	Complimenting Colour VINTAGE-WHITE OAK-APOLLO			
Treads	AS PER CO	ONSTRUCTION S	SPECIFICATIO	Complimenting Co	lour VINTAG	GE-WHITE OAK-APOLLO	
Ireaus	Red Oak S		● No				
** Refer to Cons AND RAILS (ST FLOORS.	struction Si	ummary THE S), WILL NOT BE A	STAIN COLOUI AN EXACT MA	RS OR FINISH AVAI TCH TO PREFINISH	LABLE ON HED HARDI	RISERS, TREADS, PICKETS WOOD OR LAMINATE	
9. Wall Paint I				Master Dadus are		22 WARM GREY	
Main & Upper Hal	II	22 WARM GREY		Master Bedroom Bedroom #2		22 WARM GREY	
Living Room		22 WARM GREY				22 WARM GREY	
Dining Room 22 WARM GREY			204.00				
Kitchen / Breakfast 22 WARM GREY			Deditoon //				
Family Room 22 WARM GREY			Bedroom #5 22 WARM GREY Master Ensuite 22 WARM GREY				
Powder Room				droom 2/2			
Laundry Room 22 WARM GREY							
Den/Library		22 WARM GREY		Ensuite Bath - Be	:u100111 4/3	ZZ VVAINIVI GINL I	
Trim & Door Pain	t-Semi Glos	ssBIRCH WHITE					

No



Smooth Ceilings First Floor Yes


** Refer to Construction Summary

INTERIOR COLOUR SCHEME Greenpark. Property: 380 Hassan AZEEM & Faiza HASSAN Purchasers: Project: Russell Gardens Building Ltd. Telephone Res. / Bus: (647) 649-6409 / Model and Elevation: Mountainash Five (5 Bedroom) Elev 2 Decor Advisor: Aly Aversa 62M-1266 Plan #: 28-Oct-21 Lock Date: 28-Oct-21 10. Plaster Mouldings and Medallions Kitchen/Breakfast **Entrance Vestibule** Den/Library Main Hall Lower Landing Living Room **Dining Room Family Room** ** Refer to Construction Summary 11. Fireplace Other Room - Specify Family Room Living Room As Per Plan N/A N/A Purchased N/A Purchased As Per Plan Purchased As Per Plan As Per Construction Specifications Fireplace Type MANTLE M1-STANDARD Mantle Type AS PER CONSTRUCTION SPECIFICATIONS Colour / Stain EMPERADORA DARK Surround N/A Hearth ** Refer to Construction Summary 12. Heating and Air Conditioning **Gas Provisions Stove** YES **Air Conditioning** NO NO **Gas Provisions Barbecue** NO Gas Provisions Dryer Comment ** Refer to Construction Summary 13. Electrical Above Kitchen Cabinet Light Yes No Standard Plugs and Switches White Below Kitchen Cabinet Light Yes No STANDARD WHITE **Hood Fan Microwave Gas Stove Appliances Built in Cooktop Built in Oven** O No Yes No Yes Yes O No Yes O No Dishwasher Rough-in ** Refer to Construction Summary 14. General Comments ** Refer to Construction Summary **Disclaimers and Notes** Colours of all materials are as close as possible to builder's selection, but not necessarily identical due to variances in manufacturing. 2) Any extras listed above are null and void unless accompanied by a separate invoice/amendment. Said invoice must be paid in full. The Purchaser agrees that this colour selection is final and that no changes will be permitted, unless required by the Vendor. The Purchaser acknowledges reading and accepting document which contains other miscellaneous disclaimers.

Signature:


Date:

Signature:

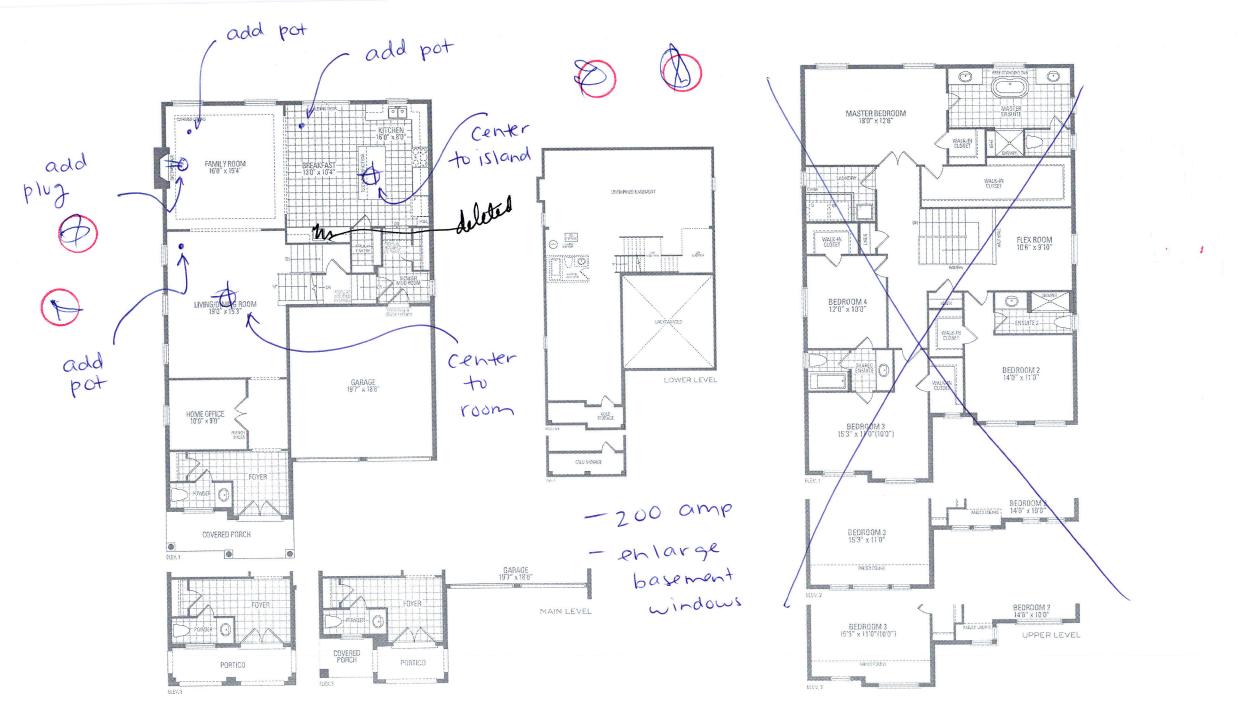


MOUNTAINASH FIVE ELEV. 1 · 3,288 sq.ft. | ELEV. 2 · 3,291 sq.ft. | ELEV. 3 · 3,298 sq.ft.

Onentation of home may be reversed and purchaser agrees to account some. Stens and purchas may vary of any extender entrance ways due to grading variance. Actual upplied lines space may vary from the stated layer areas. All renderings are artists concept. Dimensions, specific enters and architectural detailing subject to encritications. Rooting and adjoining model types night vary due to string. E. & U.E. May 2021

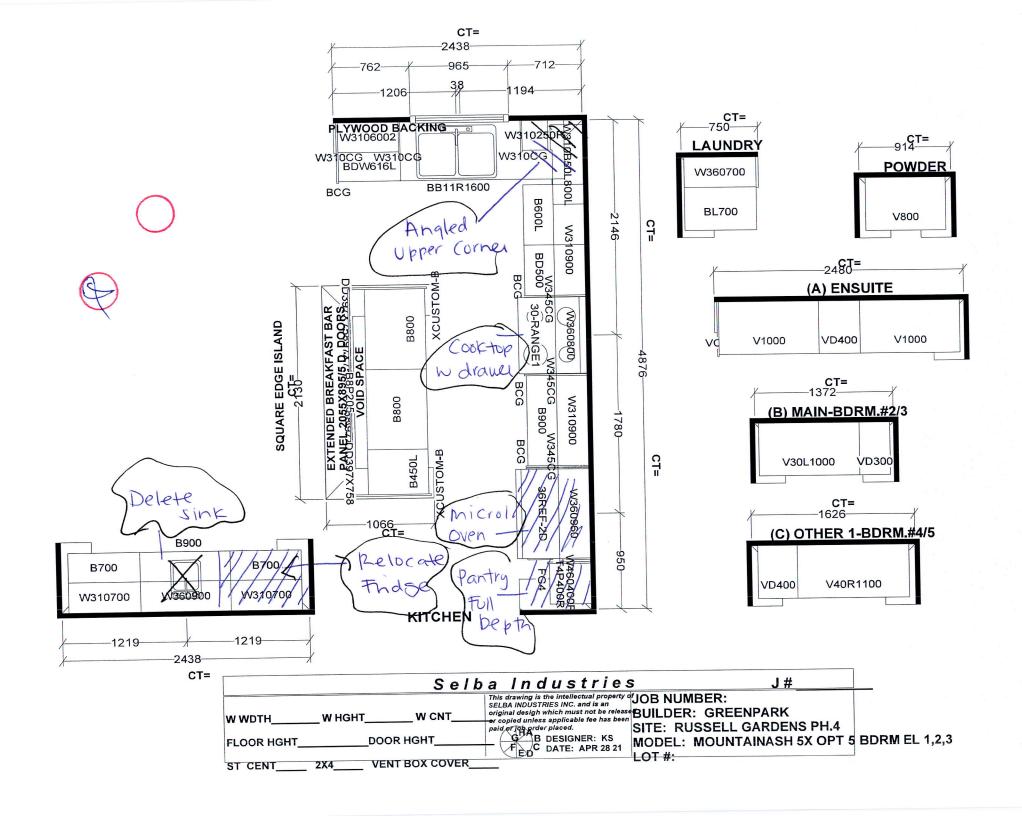

5 BEDROOM LAYOUT

MOUNTAINASH FIVE
ELEV. 1 · 3,288 sq.ft. | ELEV. 2 · 3,291 sq.ft. | ELEV. 3 · 3,298 sq.ft.

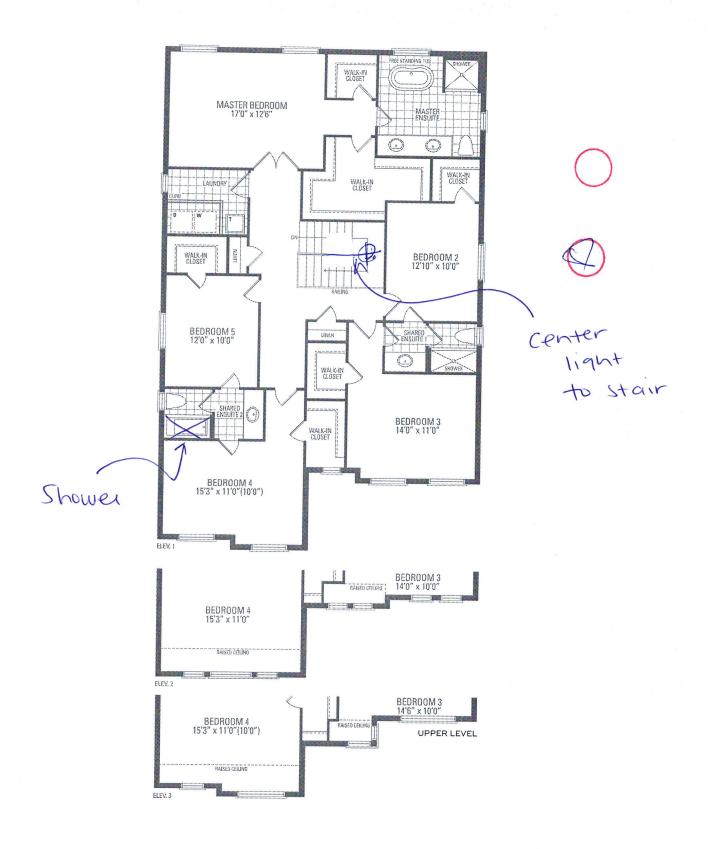



Purchaser: Lot:

Schedule SMART Russell Gardens Building Ltd. (Phase 4)

Smart Home System includes:

- 1. One (1) Smart Home Hub installed in a location as determined by the Vendor;
- 2. One (1) Doorbell camera supplied and installed at front door;
- 3. One (1) smart home thermostat to be installed in a location as determined by the Vendor;
- 4. One (1) smart Flood sensor to be installed in a location as determined by the Vendor which is designed to detect water in the location of the senor only;
- 5. Smart light switches to be installed in such locations as determined by the Vendor;

Certain devices for The Smart Home System require a fully functioning WiFi network and internet connection and others work on the Zwave wireless network. Provision of WiFi, internet access and functionality shall be the sole responsibility of the Purchaser and the Vendor assumes no responsibility or obligation with respect to the functionality or performance of a homeowner's internet or WiFi network. The Vendor does not guarantee that networks, equipment, or services will meet all

The Purchaser will be required to download the Homewave Smart Connect App (the "App") in order to configure and set up the Smart Home System devices. The Purchaser is responsible to ensure that they have the appropriate technology to download the App and any charges and fees for download and/or data usage shall be at the Purchaser's sole cost and expense. Access to the App shall be provided free of charge for 1 year from the Closing Date and thereafter the Purchaser may enter into an agreement with Homewave Smart Connect to continue the services for a monthly fee (currently \$10.00/month plus HST). Fees subject to change without notice.

Purchasers are responsible for configuring all security features. The Vendor does not warrant or represent that any network or Smart Home System devices are secure or can prevent all privacy intrusions, malware, or cyber-attacks, even when correctly configured. The products and services for the Smart Home System are provided by third parties, and not the Vendor. The Vendor does not guarantee any equipment or services provided by third parties. If the Purchaser contracts with the third-party provider to upgrade or purchase further devices, the Vendor has no responsibly for same, including but not limited to, the installation, service, safety or functionality of said products.

Energy claims are not based upon specific testing of an individual home but are general assumptions. Savings will vary due to many variables, including but not limited to, actual utility rates and fees, actual construction, floor plan, occupancy, appliance usage, thermostat settings, weather conditions, number of individuals occupying the home and orientation of the home.

The Vendor is providing only those Smart Home System's devices and components listed in this Schedule. Please see the balance of your Agreement of Purchase and Sale for additional information, disclosures, and disclaimers relating to your home and its features. The specific features in a home may vary from home to home and from one community to another. The Vendor reserves the right to substitute equipment, material, appliances and brand names with items of equal or higher value, in its sole and unfettered discretion. The Vendor reserves the right, in its sole and absolute discretion, to omit installation of the Smart Home System, in part or in whole, and the Purchaser shall have no claim for abatement or reduction the Purchase Price or to any delay in closing. Installation of the Smart Home System may result in the elimination of other features listed in Schedule GP or other information material, such as but not limited to set back thermostat, rough-in for alarm or other features deemed redundant as a result of the installation of the Smart Home System.

