
Greenpark.

RECEIVED NOV 0 3 2021

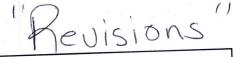

CONSTRUCTION SUMMARY

CHASERS: Thi Phuon	g Lan PHAM and Nuong T	/ Heights 3 (G) - Russell Gardens Building I hi NGUYEN // Van Viet TRAN	TEL: RES.: 905-617
LOT / PHASE 404 / 4	REG. PLAN # 62M-1266	HOUSE TYPE Mountainash Three (4 Bedroom) Elev 1	
BINETRY ACCESSO	ORIES		
PANTRY UNIT UPGRA	DE - TO GO FROM 300M	M TO 600MM DEEP - PRICE IS PER FOOT - STAN	DARD
Oct21 Note:			
		PROVEDENDES WITH GARLES - 600MM - PRICE	E IS EACH - STANDARD
	UPPER - FULL DEPTH	ABOVE FRIDGE - WITH GABLES - 600MM - PRICE	
Oct21 Note:			
NSTRUCTION		WINDOW WELLS) WINDOW IS 30 INCHES	X 24 INCHES
	Γ WINDOWS (MAY REQU	UIRE WINDOW WELLS) - WINDOW IS 30 INCHES	
5Jun21 Note:			
LECTRICAL		ION - LIVING/DINING ROOM - TO BE INSTALLED	O ON A SEPARATE SWITCH
- POT LIGHT - LED - FI ROM STANDARD LIGH	RST FLOOR INSTALLAT	ION - EIVING/DINING ROOM 18 22 1	
80ct21 Note: REFE	R TO SKETCH		
		TO DE INSTALLE	O ON A SEPARATE SWITCH
- POT LIGHT - LED - FI	RST FLOOR INSTALLAT	TON - KITCHEN/BREAKFAST - TO BE INSTALLEI	, (1,1,1,2,1,1,1,1,1,1,1,1,1,1,1,1,1,1,1,1
ROM STANDARD LIGH 80ct21 Note: REFE	R TO SKETCH		
- PLUG - ELECTRICAL	PLUG - TO BE INSTALL	ED OVER FIREPLACE	
050ct21 Note:			
	TO THE TO	DE CENTERED OVER ISLAND	
	RD KITCHEN LIGHT TO	BE CENTERED OVER ISLAND	
050ct21 Note:			
2 - POT LIGHT - LED - F	IRST FLOOR INSTALLAT	ΓΙΟΝ - LIVING/DINING ROOM - TO BE INSTALLE	D ON A SEPARATE SWITCH
FROM STANDARD LIGI	HT - REFER TO SKETCH		
05Oct21 Note:			
1 DILIC ELECTRICAL	PLUG WITH GFLAND S	WITCH - FOR FESTIVE LIGHTING	
15Jun21 Note:	TLOG WITH GIVE		
130 1112			
8 - POT LIGHT - LED - F	FIRST FLOOR INSTALLA	TION	
15Jun21 Note:			
1 - 200 AMP ELECTRIC.	AL SERVICE		
15Jun21 Note:			
المراجع			
MIRRORS AND GLA	SS	DIGITIES OF THE CHROME KNO	R AND HINGES
	- FRAMELESS GLASS SH	IOWER ENCLOSURE – INCLUDES CHROME KNO	B AND INVOIS
15.Jun21 Note:			
OF 5 (HILISTER)			
PLUMBING			
1 - WATER LINE FOR F	FRIDGE - ROUGH-IN ONI	Y	
15Jun21 Note:			
	TOP TROTTED TO CHOW	ED	
	TOE TESTER TO SHOW	EK	
15.Jun21 Note:			

PROMOTIONAL

1 - NO FURTHER CHANGES

280ct21 Note:

Greenpark.

CONSTRUCTION SUMMARY

Mountainview Heights 3 (G) - Russell Gardens Building Ltd.

PURCHASERS: Thi Phuong Lan PHAM and Nuong Thi NGUYEN // Van Viet TRAN


TEL: RES.: 905-617-2469

PURCHASERS: Thi Phuon			
LOT / PHASE 404 / 4	REG. PLAN # 62M-1266	HOUSE TYPE Mountainash Three (4 Bedroom) Elev 1	1
- LESS CREDIT FROM PURCHASER EXTRA SHEET IN OFFER			
15 Jun 21 Note:			

EXTRAS AS PER OFFER

PURCHASER(S) ACKNOWLEDGES THAT THE PURCHASE PRICE IS INCLUSIVE OF ALL CREDITS AND PROMOTIONAL PACKAGES AVAILABLE AT TIME OF PURCHASE. Worksheet Note:	
Granite kitchen counter top, from Vendor?s standard samples Worksheet Note:	
(1) The Vendor agrees that notwithstanding any other term or provision in this Agreement included in the Purchase Price and in addition to those items detailed in Schedule GP to the Agreement of Purchase and Sale, the Purchaser is entitled to a credit of <i>Worksheet</i> Note:	¥.

This Document is Extremely Time Sensitive - Printed 29 Oct 21 at 13:17

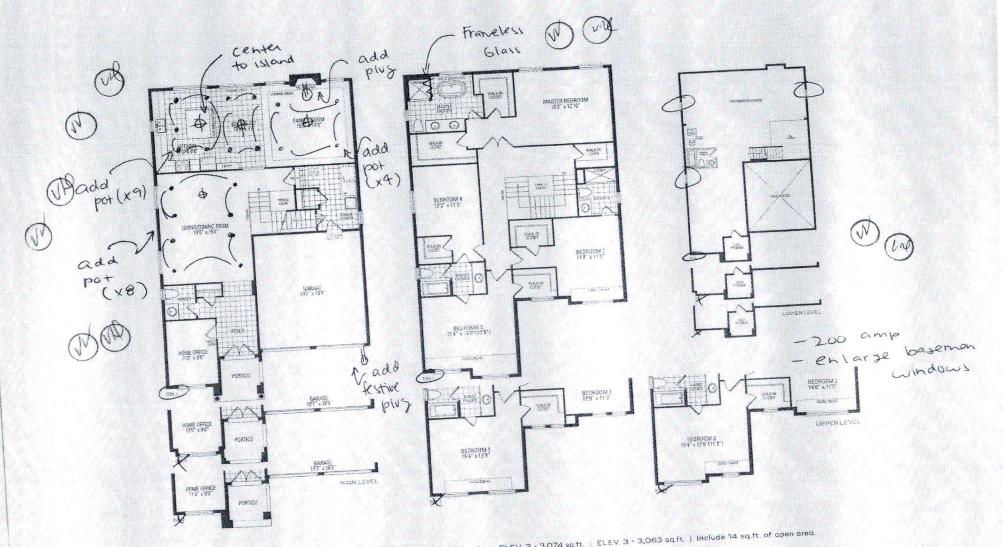

MOUNTAINASH THREE ELEV. 1 · 3,085 sq.ft. | ELEV. 2 · 3,074 sq.ft. | ELEV. 3 · 3,063 sq.ft. | Include 14 sq.ft. of open area.

Beforetens a literacting of the read and perform squeeces to be all raths. Note that performs along experies that the read of the read of