

CONSTRUCTION SUMMARY				
Mountainview Heights 3 (G) - Russell Gardens Building Ltd.				TEL: RES.: 905-320-0030
PURCHASERS: Rajwinder SINGH and Sabrina Kaur SINGH				
LOT / PHASE	REG. PLAN #	HOUSE TYPE		
344 / 4	62M-1266	Valleycreek Three Elev 3		

CABINETRY

1 - CABINETRY PROVISION - FARMERS SINK PROVISION 08Feb22 Note:	
1 - CABINETRY - KITCHEN - LIGHT VALENCE - NO ELECTRICAL 08Feb22 Note:	
1 - CABINETRY PROVISION - PROVISION FOR PLUG ON ISLAND (PLUG EXTRA ORDERED SEPARATELY) 08Feb22 Note:	
1 - CABINETRY - KITCHEN - HARDWARE UPGRADE 1 08Feb22 Note:	
1 - KITCHEN CABINETRY - TWO COLOUR KITCHEN - FLAT FEE 08Feb22 Note:	
1 - CABINETRY - KITCHEN - UPGRADE 2 08Feb22 Note:	

CABINETRY ACCESSORIES


1 - KITCHEN CABINETRY BASE - PULLOUT RECYCLE 2 BIN - PRICE IS EACH 25Feb22 Note:	New ★	
1 - KITCHEN - SHIFT FRIDGE TO ACCOMMODATE BUILT-IN APPIANCES 08Feb22 Note:		
1 - KITCHEN HOOD CABINETS - CONTEMPORARY WOOD HOOD – UPGRADE 2 08Feb22 Note: PURCAHSE TO SUPPLY AND INSTALL HOOD FAN AFTER CLOSING		
1 - KITCHEN CABINETRY BASE - BANK OF DRAWERS - UPGRADE 2 08Feb22 Note:		
1 - KITCHEN CABINETRY UPPER - FULL DEPTH ABOVE FRIDGE - WITH GABLES - 600MM - PRICE IS EACH - UPGRADE 2 08Feb22 Note:		
1 - KITCHEN CABINETRY - BUILT-IN MICROWAVE/OVEN COMBO - UPGRADE 2 08Feb22 Note:		
1 - KITCHEN CABINETRY BASE - COOKTOP CABINET WITH POT DRAWERS (2 DRAWERS) - UPGRADE 2 08Feb22 Note:		

CERAMIC TILE

1 - DELETE ALL CERAMIC BATHROOM ACCESSORIES - DELETE TOWEL BAR, PAPER HOLDER & SOAP DISH THROUGHOUT 08Feb22 Note:	
1 - TILE - UPGRADE 1 WALL TILE - - ENSUITE WALL TILE - SHOWER 08Feb22 Note:	
1 - TILE - UPGRADE 4 MOSAIC FLOOR TILE - - ENSUITE BATHROOM - FLOOR 08Feb22 Note:	

CONSTRUCTION

- Upg 2 Sonata Cabinetry
- 2nd Colour Cabinetry.
- Upg. 1 Hardware

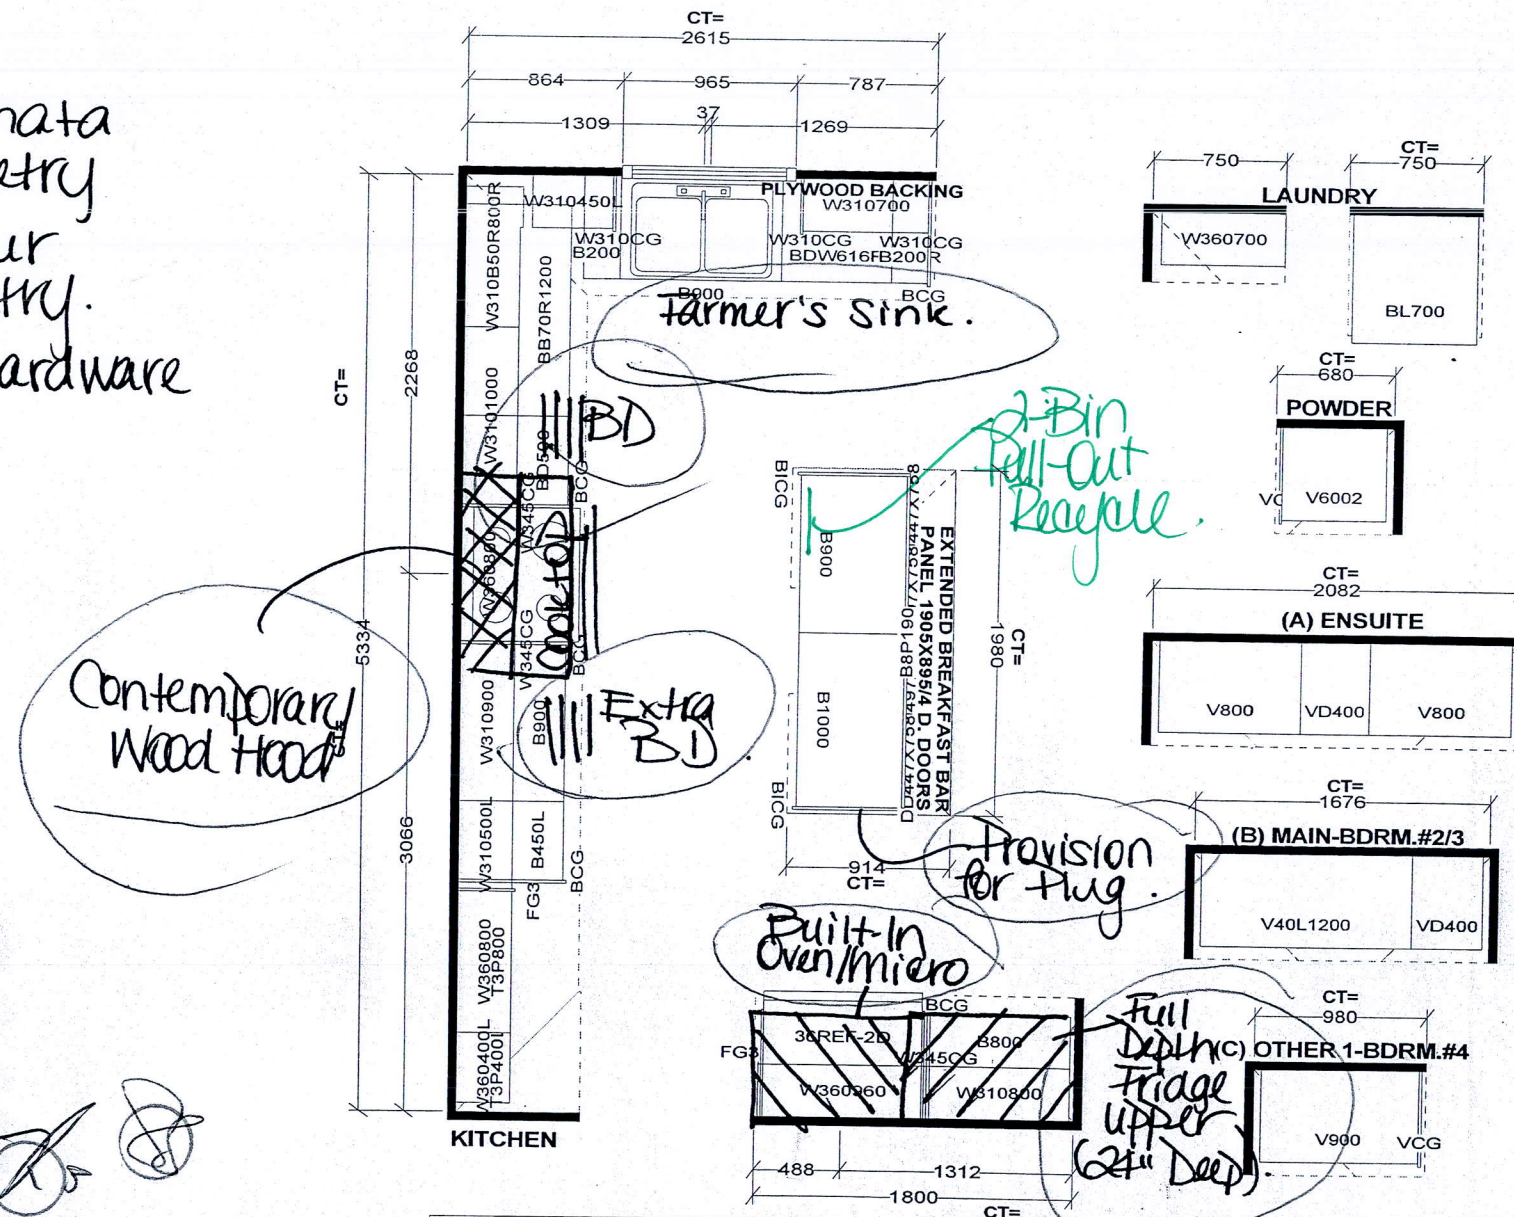

13

*This drawing is the Intellectual property of
SELBA INDUSTRIES INC. and is an
original design which must not be released
or copied unless applicable fee has been
paid or job order placed.*



DESIGNER: KS
DATE: MAY 13 20

BUILDER: GREENPARK
SITE: RUSSELL GARDENS PH.3
MODEL: VALLEYCREEK 3X EL 1,2,3
LOT #: