

| CONSTRUCTION SUMMARY | | | | |
|--|-------------|---|-------------------------|--|
| Mountainview Heights 3 (G) - Russell Gardens Building Ltd. | | | | |
| PURCHASERS: Atulkumar R. BADIANI and Jayshree Atulku BADIANI | | | TEL: RES.: 905-315-9900 | |
| LOT / PHASE | REG. PLAN # | HOUSE TYPE | | |
| 351 / 4 | 62M-1266 | Springfield Two (4 Bed with Guest Suite) Elev 3 | | |

CABINETRY ACCESSORIES

| | |
|---|--|
| 1 - PANTRY UNIT UPGRADE - TO GO FROM 300MM TO 600MM DEEP - PRICE IS PER FOOT - STANDARD 25Mar22 Note: | |
| 1 - KITCHEN CABINETRY UPPER - FULL DEPTH ABOVE FRIDGE - WITH GABLES - 600MM - PRICE IS EACH - STANDARD 25Mar22 Note: | |

CERAMIC TILE

| | |
|--|--|
| 1 - DELETE ALL CERAMIC BATHROOM ACCESSORIES - DELETE TOWEL BAR, PAPER HOLDER & SOAP DISH THROUGHOUT 25Mar22 Note: | |
|--|--|

CONSTRUCTION

| | |
|--|--|
| 1 - SMOOTH CEILINGS ON FIRST FLOOR ONLY - DET 25Mar22 Note: | |
|--|--|

ELECTICAL

| | |
|--|--|
| 1 - PLUG - ROUGH-IN FOR ELECTRIC CAR PLUG IN GARAGE - FOR FUTURE ELECTRIC CAR - 60 AMP - 240V 25Mar22 Note: SPECIFICATIONS REQUIRED | |
|--|--|

ELECTRICAL

| | |
|--|--|
| 1 - PLUG - ELECTRICAL PLUG - INSTALLED 5' FROM FLOOR - FLEX ROOM 25Mar22 Note: | |
| 1 - PLUG - ELECTRICAL PLUG - INSTALLED 5' FROM FLOOR - MASTER BEDROOM 25Mar22 Note: | |
| 4 - PLUG - ELECTRICAL PLUG WITH GFI - INSTALLED NEXT TO TOILETS - ALL BATHROOMS 25Mar22 Note: | |
| 1 - PLUG - ELECTRICAL PLUG - MASTER ENSUITE BATHROOM 25Mar22 Note: | |
| 4 - FAN - BATHROOM EXHAUST FAN - ENERGY STAR 80 CFM - IN LIEU OF STANDARD FAN - ALL BATHROOMS 25Mar22 Note: | |
| 1 - FRONT PORTICO - RELOCATE STANDARD LIGHT ON SOFFIT - IF CONSTRUCTION PERMITS - SEE SKETCH 25Mar22 Note: | |
| 1 - PLUG - ELECTRICAL PLUG - INSTALLED 5' FROM FLOOR - GUEST SUITE 25Mar22 Note: | |
| 1 - PLUG - ELECTRICAL PLUG - TO BE INSTALLED OVER FIREPLACE 25Mar22 Note: | |
| 1 - RELOCATE STANDARD KITCHEN LIGHT TO BE CENTERED OVER ISLAND 25Mar22 Note: | |
| 1 - PLUG - ELECTRICAL PLUG WITH GFI AND SWITCH - FOR FESTIVE LIGHTING 25Mar22 Note: | |
| 1 - STANDARD DINING ROOM LIGHT TO BE CENTERED BETWEEN LIVING AND DINING ROOM 25Mar22 Note: | |

| CONSTRUCTION SUMMARY | | | | |
|---|-------------------------|---|-------------------------|--|
| Mountainview Heights 3 (G) - Russell Gardens Building Ltd. | | | TEL: RES.: 905-315-9900 | |
| PURCHASERS: Atulkumar R. BADIANI and Jayshree Atulku BADIANI | | | | |
| LOT / PHASE 351 / 4 | REG. PLAN # 62M-1266 | HOUSE TYPE Springfield Two (4 Bed with Guest Suite) Elev 3 | | |
| 1 - 200 AMP ELECTRICAL SERVICE 14Jul21 Note: | | | | |
| FIREPLACE AND ACCESSORIES | | | | |
| 1 - GAS LINE ROUGH-IN FOR STOVE (INCLUDES ELECTRICAL OUTLET) - FIRST FLOOR 25Mar22 Note: | | | | |
| HARDWOOD FLOORING | | | | |
| 1 - LAMINATE – UPGRADE TO PARKLANE SERIES IN LIEU OF STANDARD LAMINATE 25Mar22 Note: | | | | |
| MIRRORS AND GLASS | | | | |
| 1 - MASTER ENSUITE – FRAMELESS GLASS SHOWER ENCLOSURE – INCLUDES CHROME KNOB AND HINGES 14Jul21 Note: | | | | |
| PLUMBING | | | | |
| 3 - TOE TESTER - ADD TOE TESTER TO SHOWER 14Jul21 Note: | | | | |
| PROMOTIONAL | | | | |
| 1 - LESS BALANCE OF CREDIT FROM PURCHASER EXTRA SHEET IN OFFER 25Mar22 Note: | | | | |
| 1 - LESS CREDIT FROM PURCHASER EXTRA SHEET IN OFFER 14Jul21 Note: NEW PROMO BALANCE \$4155.00 | | | | |
| EXTRAS AS PER OFFER | | | | |
| (1) The Vendor agrees that notwithstanding any other term or provision in this Agreement included in the Purchase Price and in addition to those items detailed in Schedule GP to the Agreement of Purchase and Sale, the Purchaser is entitled to a credit of Worksheet Note: | | | | |
| Granite kitchen counter top, from Vendor?s standard samples Worksheet Note: | | | | |
| PURCHASER(S) ACKNOWLEDGES THAT THE PURCHASE PRICE IS INCLUSIVE OF ALL CREDITS AND PROMOTIONAL PACKAGES AVAILABLE AT TIME OF PURCHASE. Worksheet Note: | | | | |
| Purchase Price includes a walk up from the basement to the rear of the dwelling unit, and the obligation to construct the house with the walk up is subject to the Vendor?s approval, in its sole and unfettered discretion. The Purchaser acknowledges and ag Worksheet Note: | | | | |
| (8?6? Pour) If the Purchaser has purchased or been provided with an 8-foot 6-inch basement concrete pour (being an increase from the Vendor?s standard basement depth) the depth is measured from the top of footing to the top of foundation wall. The incre Worksheet Note: | | | | |
| 10 foot ceiling height on Main Level. The Purchaser acknowledges that as a result of the increased ceiling height from the Vendor?s standard ceiling height, various modifications to the interior and exterior of the dwelling unit may be made, including bu Worksheet Note: | | | | |
| Purchase Price includes 3 enlarged basement windows, and the obligation to construct the house with the enlarged basement windows is subject to the Vendors approval, in its sole and unfettered discretion The Purchaser acknowledges and agrees that the loc Worksheet Note: | | | | |

| CONSTRUCTION SUMMARY | | | | |
|--|-------------|---|--|-------------------------|
| Mountainview Heights 3 (G) - Russell Gardens Building Ltd. | | | | |
| PURCHASERS: Atulkumar R. BADIANI and Jayshree Atulku BADIANI | | | | TEL: RES.: 905-315-9900 |
| LOT / PHASE | REG. PLAN # | HOUSE TYPE | | |
| 351 / 4 | 62M-1266 | Springfield Two (4 Bed with Guest Suite) Elev 3 | | |

This Document is Extremely Time Sensitive - Printed 25 Mar 22 at 11:38

Purchasers:Atulkumar R. BADIANI & Jayshree Atulku BADIA

Property: 351

Telephone Res. / Bus: (905) 315-9900 /

Project: Russell Gardens Building Ltd.

Decor Advisor: Candace Forza

Model and Elevation: Springfield Two (4 Bed with Guest Suite) |

Lock Date: 25-Mar-22

25-Mar-22

Plan #: 62M-1266

Layout Changes: ☒ Yes ☐ No

Sketch Attached: ☒ Yes ☐ No

Exterior Colour Scheme:

1. Cabinetry

| | Style and Colour | Hardware |
|----------------------------|----------------------|----------|
| Kitchen / Breakfast | EVEREST | 467SA |
| Laundry Room | ELISSE | Standard |
| Powder Room | DORAL K44 TITAN GREY | 467SA |
| Master Ensuite Bathroom | DORAL K44 TITAN GREY | 467SA |
| Ensuite Bath - Bedroom 2/3 | DORAL K44 TITAN GREY | 467SA |
| Ensuite Bath - Bedroom 4 | DORAL K44 TITAN GREY | 467SA |
| | N/A | N/A |
| | N/A | N/A |
| | N/A | N/A |

Appliances:

Built In Appliances ☐ Yes ☒ No

Slide In Stove ☐ Yes ☒ No

☐ Closed ☒ Open

41" Upper Cabinets ☒ Yes ☐ No

Please NOTE: Standard Cabinet Height is 30"

NOTE: If not specified, opening will be set to builder's standard opening of approximately 30" width

NOTE: If not specified, opening will be set to builder's standard opening of approximately 37" width x 74" height

** Refer to Construction Summary

2. Counters

| | Counter | Edge |
|----------------------------|--------------------------------|------|
| Kitchen / Breakfast | GRANITE-NERO IMPALA | #360 |
| Laundry Room | N/A | |
| Powder Room | LAMINATE-WHITE CARRARA 4924-38 | |
| Master Ensuite Bathroom | LAMINATE-WHITE CARRARA 4924-38 | |
| Ensuite Bath - Bedroom 2/3 | LAMINATE-WHITE CARRARA 4924-38 | |
| Ensuite Bath - Bedroom 4 | LAMINATE-WHITE CARRARA 4924-38 | |
| | N/A | |
| | N/A | |
| | N/A | |

** Refer to Construction Summary

Initials:

ACE

Purchasers:

Telephone Res. / Bus:

Decor Advisor:

Lock Date:

Atulkumar R. BADIANI & Jayshree Atulku BADIANI

(905) 315-9900 /

Candace Forza

25-Mar-22

Property: 351

Project: Russell Gardens Building Ltd.

Model and Elevation: Springfield Two (4 Bed with Guest Suite) |

Plan #: 62M-1266

3. Ceramic Flooring

At a 45 Threshold-If App.

| | | | |
|----------------------------|---------------------------|--------------------------|------------------------------|
| Entrance Vestibule | TILE-ESSENZE GRIGIO-13X13 | <input type="checkbox"/> | metal strip where applicable |
| Main Hall | STRIP | <input type="checkbox"/> | |
| Kitchen / Breakfast | TILE-ESSENZE GRIGIO-13X13 | <input type="checkbox"/> | |
| Laundry Room | TILE-ESSENZE GRIGIO-13X13 | <input type="checkbox"/> | |
| Powder Room | N/A | <input type="checkbox"/> | |
| Master Ensuite Bathroom | TILE-ESSENZE GRIGIO-13X13 | <input type="checkbox"/> | |
| Ensuite Bath - Bedroom 2/3 | TILE-ESSENZE GRIGIO-13X13 | <input type="checkbox"/> | |
| Ensuite Bath - Bedroom 4 | TILE-ESSENZE GRIGIO-13X13 | <input type="checkbox"/> | |
| MUDROOM | TILE-ESSENZE GRIGIO-13X13 | <input type="checkbox"/> | |
| GUEST ENSUITE BATH | TILE-ESSENZE GRIGIO-13X13 | <input type="checkbox"/> | |
| | N/A | <input type="checkbox"/> | |

** Refer to Construction Summary

4. Ceramic Wall Tile

Describe

| | | |
|----------------------------|------------------------|--|
| Master Ensuite Bathroom | Selection | |
| Tub Deck Wall | N/A | |
| Tub Deck | N/A | |
| Tub Deck Skirt | N/A | |
| Shower Stall | TILE-BIANCO MATTE-8X16 | |
| Bathtub Enclosure Walls | N/A | |
| Ensuite Bath - Bedroom 2/3 | TILE-BIANCO MATTE-8X16 | |
| Ensuite Bath - Bedroom 4 | TILE-BIANCO MATTE-8X16 | |
| MUDROOM | N/A | |
| GUEST ENSUITE BATH | TILE-BIANCO MATTE-8X16 | |
| | N/A | |
| Kitchen Backsplash | N/A | |

** Refer to Construction Summary - STANDARD GROUT THROUGHOUT UNLESS SPECIFIED

5. Plumbing Fixtures

Whirlpool

All Bathrooms

White

N/A

N/A

☐ Yes ☒ No

Dishwasher Rough-In ☒ Yes ☐ No

Waterline for Fridge ☐ Yes ☒ No

** Refer to Construction Summary

6. Trim Carpentry

| | |
|----------------------------|------------------------------------|
| Interior Doors | CARRARA-SMOOTH |
| Interior Trim | As Per Construction Specifications |
| Door Handles | As Per Construction Specifications |
| Exterior Front Door Handle | As Per Construction Specifications |

** Refer to Construction Summary

Purchasers:

Atulkumar R. BADIANI & Jayshree Atulku BADIANI

Telephone Res. / Bus:

(905) 315-9900 /

Decor Advisor:

Candace Forza

Lock Date:

25-Mar-22

Property:

351

Project:

Russell Gardens Building Ltd.

Model and Elevation:

Springfield Two (4 Bed with Guest Suite) |

Plan #:

62M-1266

| 7. Other Flooring | | |
|------------------------------|--|------|
| Main Hall | STRIP-NATURAL RED OAK SEMI-GLOSS-2 1/4" | |
| Living Room | STRIP-NATURAL RED OAK SEMI-GLOSS-2 1/4" | |
| Dining Room | STRIP-NATURAL RED OAK SEMI-GLOSS-2 1/4" | |
| Family Room | STRIP-NATURAL RED OAK SEMI-GLOSS-2 1/4" | |
| Den / Library / Study | N/A | |
| Basement Landing(If Applies) | N/A | |
| Lower Landing (If Applies) | N/A | |
| Upper Landing | N/A | |
| Upper Hall | LAMINATE-PARKLANE-NEWCASTLE OAK BROWN-TL-EL-3582 | |
| Master Bedroom | LAMINATE-PARKLANE-NEWCASTLE OAK BROWN-TL-EL-3582 | |
| Bedroom #2 | LAMINATE-PARKLANE-NEWCASTLE OAK BROWN-TL-EL-3582 | |
| Bedroom #3 | LAMINATE-PARKLANE-NEWCASTLE OAK BROWN-TL-EL-3582 | |
| Bedroom #4 | LAMINATE-PARKLANE-NEWCASTLE OAK BROWN-TL-EL-3582 | |
| Bedroom #5 | N/A | |
| GUEST SUITE | STRIP-NATURAL RED OAK SEMI-GLOSS-2 1/4" | |
| FLEX ROOM | LAMINATE-PARKLANE-NEWCASTLE OAK BROWN-TL-EL-3582 | |
| | N/A | |
| Underpad | Type | Area |
| | | |

** Refer to Construction Summary

8. Railings and Pickets

Railing Type

AS PER CONSTRUCTION SPECIFICATIONS

Picket Type

AS PER CONSTRUCTION SPECIFICATIONS

Stringer / Riser

AS PER CONSTRUCTION SPECIFICATIO

Treads

AS PER CONSTRUCTION SPECIFICATIO

Complimenting Colour

NATURAL RED OAK

Complimenting Colour

NATURAL RED OAK

Complimenting Colour

NATURAL RED OAK

Complimenting Colour

NATURAL RED OAK

Red Oak Stairs

☒ Yes ☐ No

** Refer to Construction Summary

THE STAIN COLOURS OR FINISH AVAILABLE ON RISERS, TREADS, PICKETS AND RAILS (STAIRCASES), WILL NOT BE AN EXACT MATCH TO PREFINISHED HARDWOOD OR LAMINATE FLOORS.

9. Wall Paint Flat Finish

Main & Upper Hall

22 WARM GREY

Living Room

22 WARM GREY

Dining Room

22 WARM GREY

Kitchen / Breakfast

22 WARM GREY

Family Room

22 WARM GREY

Powder Room

N/A

Laundry Room

22 WARM GREY

Den/Library

22 WARM GREY

Trim & Door Paint-Semi Gloss

BIRCH WHITE

N/A

N/A

Master Bedroom

22 WARM GREY

Bedroom #2

22 WARM GREY

Bedroom #3

22 WARM GREY

Bedroom #4

22 WARM GREY

Bedroom #5

N/A

Master Ensuite

22 WARM GREY

Ensuite Bath - Bedroom 2/3

22 WARM GREY

Ensuite Bath - Bedroom 4

22 WARM GREY

GUEST ENSUITE

22 WARM GREY

FLEX ROOM

22 WARM GREY

GUEST SUITE

22 WARM GREY

Smooth Ceilings First Floor

☒ Yes ☐ No

** Refer to Construction Summary

Initials:

ADK

JS

Purchasers:Atulkumar R. BADIANI & Jayshree Atulku BADIANI

Telephone Res. / Bus: (905) 315-9900 /

Decor Advisor: Candace Forza

Lock Date: 25-Mar-22

Property: 351

Project: Russell Gardens Building Ltd.

Model and Elevation: Springfield Two (4 Bed with Guest Suite) |

Plan #: 62M-1266

10. Plaster Mouldings and Medallions

| | | | | | |
|--------------------|-----|-----|-------------------|-----|-----|
| Entrance Vestibule | N/A | N/A | Kitchen/Breakfast | N/A | N/A |
| Main Hall | N/A | N/A | Den/Library | N/A | N/A |
| Living Room | N/A | N/A | Lower Landing | N/A | N/A |
| Dining Room | N/A | N/A | | N/A | N/A |
| Family Room | N/A | N/A | | | |

** Refer to Construction Summary

11. Fireplace

| | Living Room | | | Family Room | | | Other Room - Specify | | |
|----------------|-----------------------|-----------------------|----------------------------------|------------------------------------|----------------------------------|-----------------------|-----------------------|-----------------------|----------------------------------|
| | Purchased | As Per Plan | N/A | Purchased | As Per Plan | N/A | Purchased | As Per Plan | N/A |
| | <input type="radio"/> | <input type="radio"/> | <input checked="" type="radio"/> | <input type="radio"/> | <input checked="" type="radio"/> | <input type="radio"/> | <input type="radio"/> | <input type="radio"/> | <input checked="" type="radio"/> |
| Fireplace Type | N/A | | | FLAT ON WALL | | | N/A | | |
| Mantle Type | N/A | | | MANTLE M2-STANDARD | | | N/A | | |
| Colour / Stain | N/A | | | AS PER CONSTRUCTION SPECIFICATIONS | | | N/A | | |
| Surround | N/A | | | NERO | | | N/A | | |
| Hearth | N/A | | | NO | | | N/A | | |

** Refer to Construction Summary

12. Heating and Air Conditioning

| | | | |
|----------------------|----|-------------------------|----|
| Air Conditioning | NO | Gas Provisions Stove | NO |
| Gas Provisions Dryer | NO | Gas Provisions Barbecue | NO |
| Comment | | | |

** Refer to Construction Summary

13. Electrical

| | | | | | |
|---------------------|--|-------------------------------------|-----------------------------|---------------------------|-------------------------------------|
| Plugs and Switches | <input checked="" type="radio"/> White | DECOR | Above Kitchen Cabinet Light | <input type="radio"/> Yes | <input checked="" type="radio"/> No |
| Hood Fan | STANDARD WHITE | | Below Kitchen Cabinet Light | <input type="radio"/> Yes | <input checked="" type="radio"/> No |
| Appliances | Built in Cooktop | | Gas Stove | <input type="radio"/> Yes | <input checked="" type="radio"/> No |
| | <input type="radio"/> Yes | <input checked="" type="radio"/> No | Microwave | <input type="radio"/> Yes | <input checked="" type="radio"/> No |
| Dishwasher Rough-in | Yes | | | | |


** Refer to Construction Summary

14. General Comments


** Refer to Construction Summary

Disclaimers and Notes


- 1) Colours of all materials are as close as possible to builder's selection, but not necessarily identical due to variances in manufacturing.
- 2) Any extras listed above are null and void unless accompanied by a separate invoice/amendment. Said invoice must be paid in full.
- 3) The Purchaser agrees that this colour selection is final and that no changes will be permitted, unless required by the Vendor.
- 4) The Purchaser acknowledges reading and accepting document which contains other miscellaneous disclaimers.
- 5) In the event of a conflict between the Standard Features schedule of the Agreement of Purchase and Sale and the Interior Colour Scheme, the Interior Colour Scheme shall prevail.

Signature:  Atulkumar R. Badiani

Date: 25th March 2022

Signature:  Jayshree A. Badiani


Date: 25th March 2022

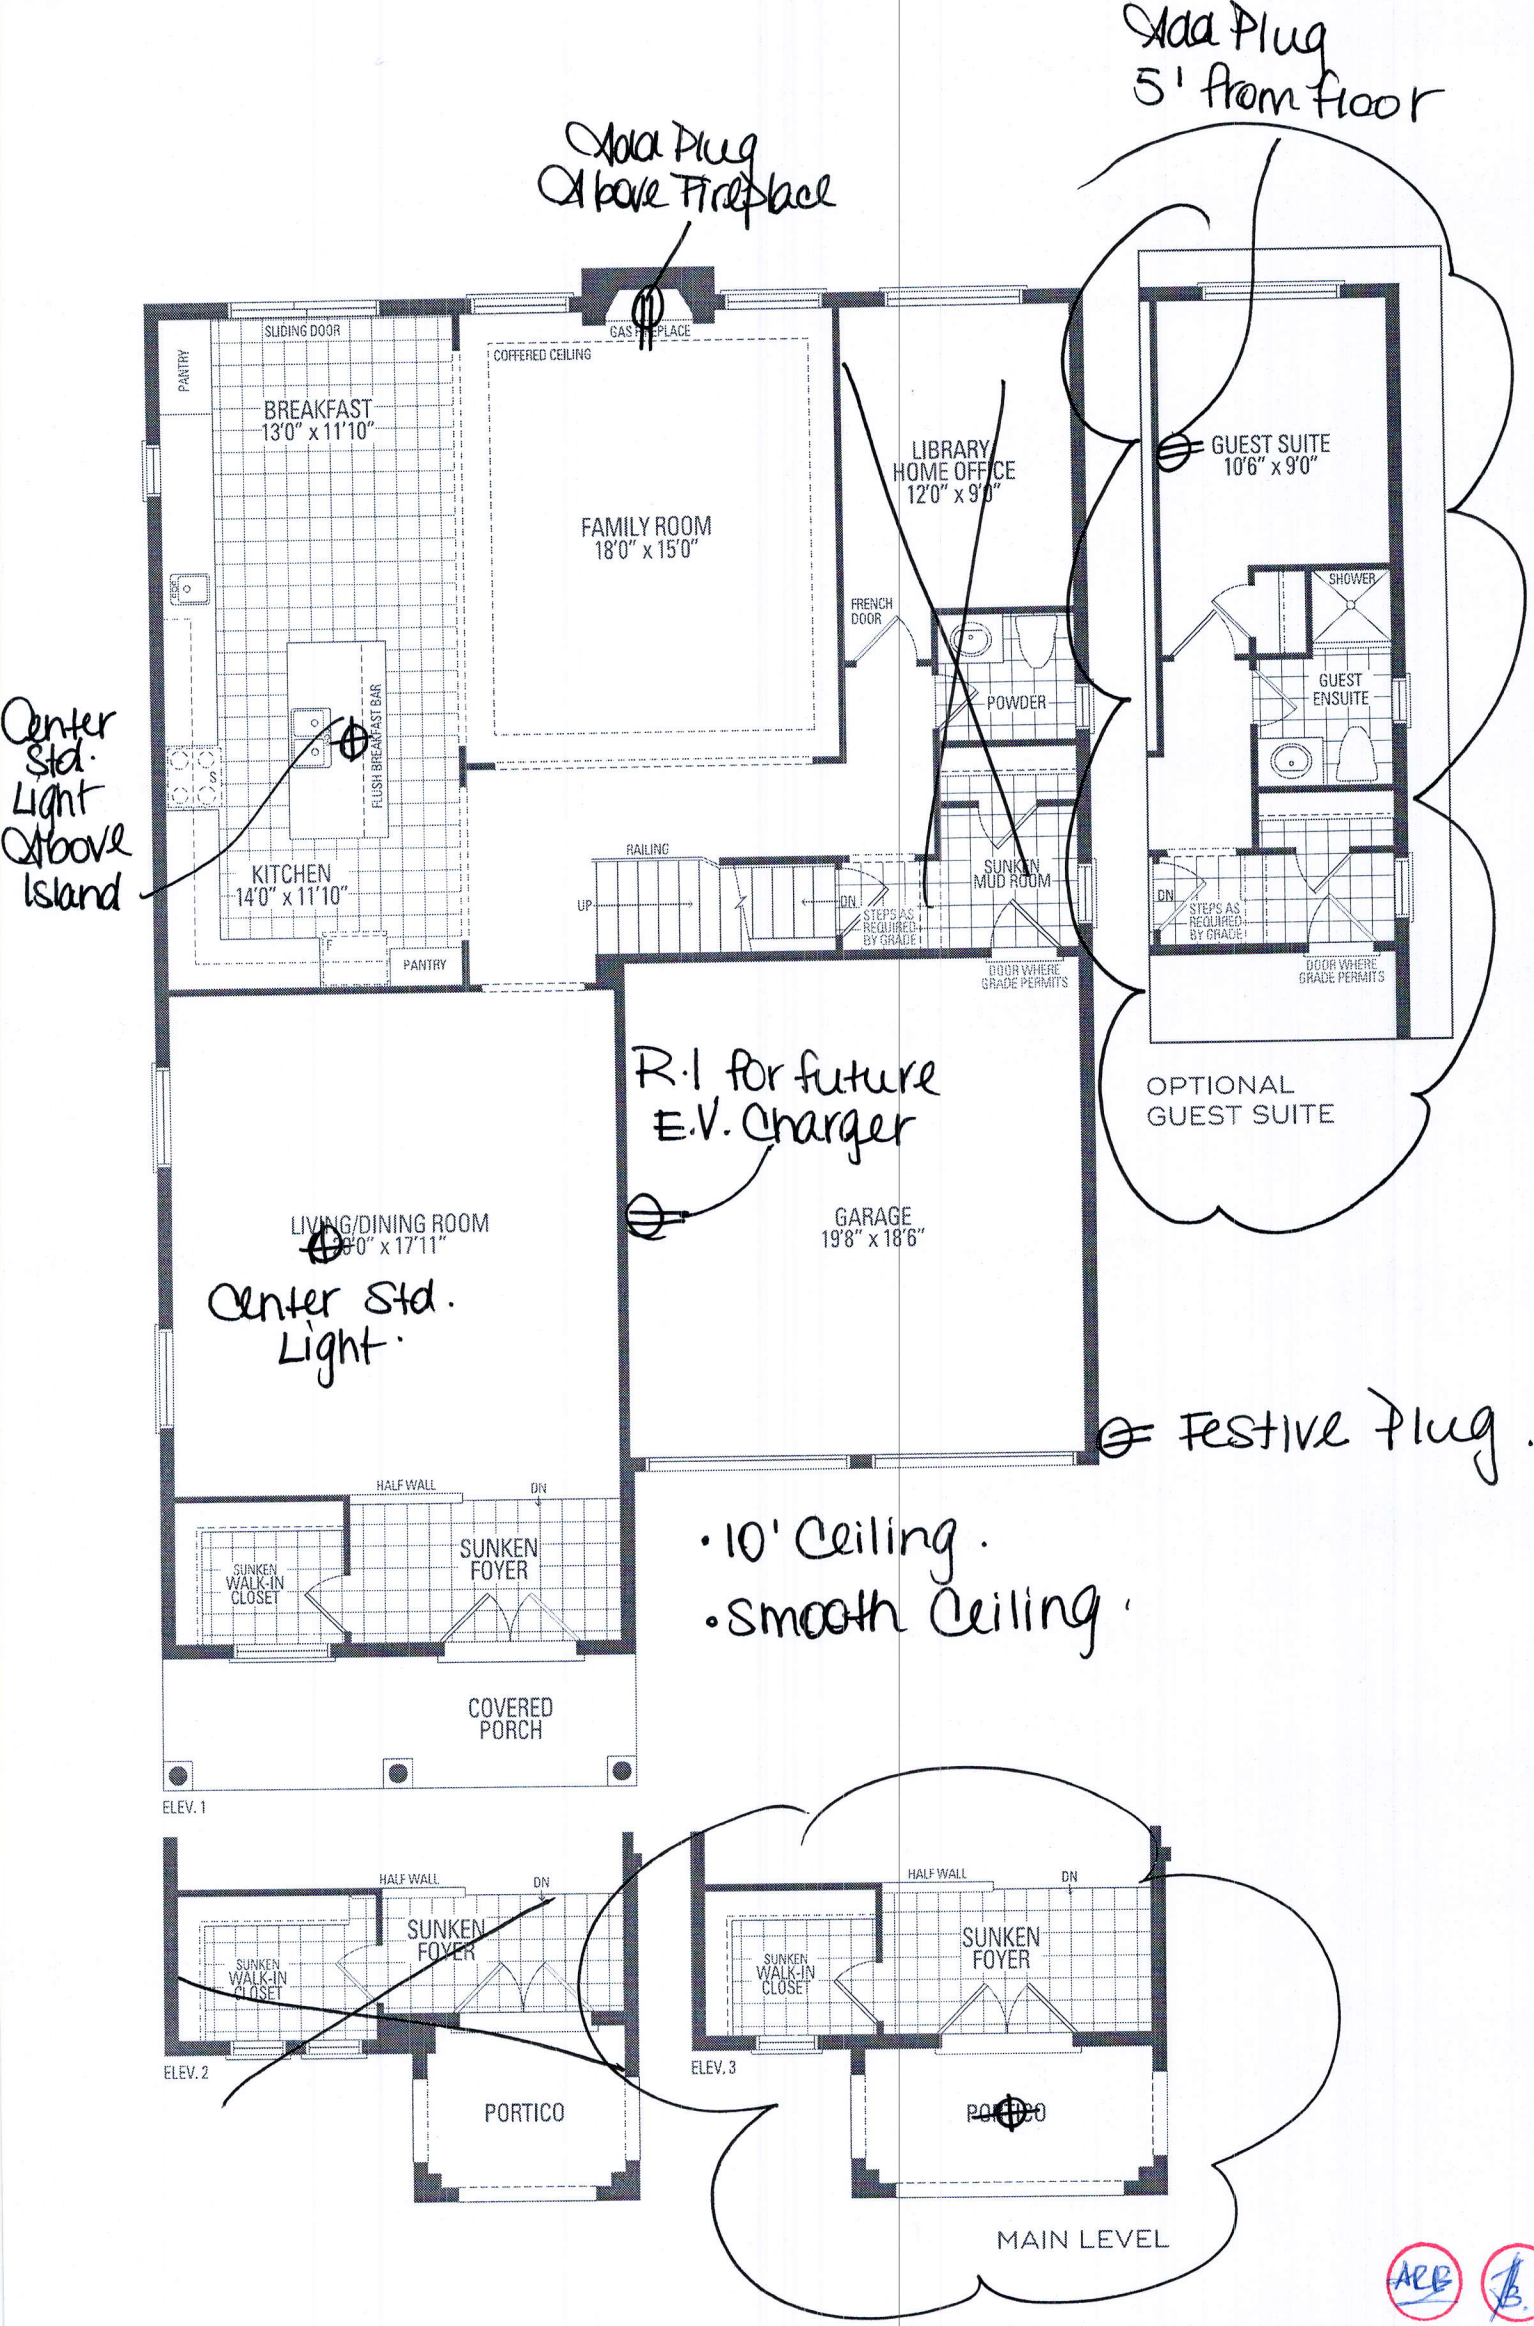


SPRINGFIELD TWO ELEV. 1

Orientation of home may be reversed and purchaser agrees to accept same. Steps and stated floor areas. All renderings are artist's concept. Dimensions, specifications and arc


Delete Walls
Frameless Glass
Shower Enclosure

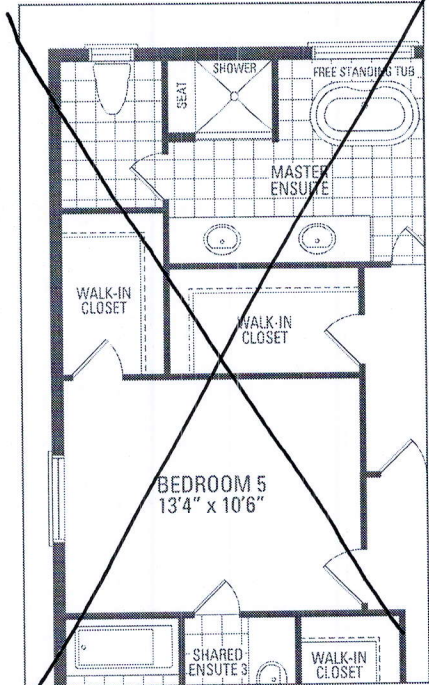


OPTIONAL 5 BEDROOM

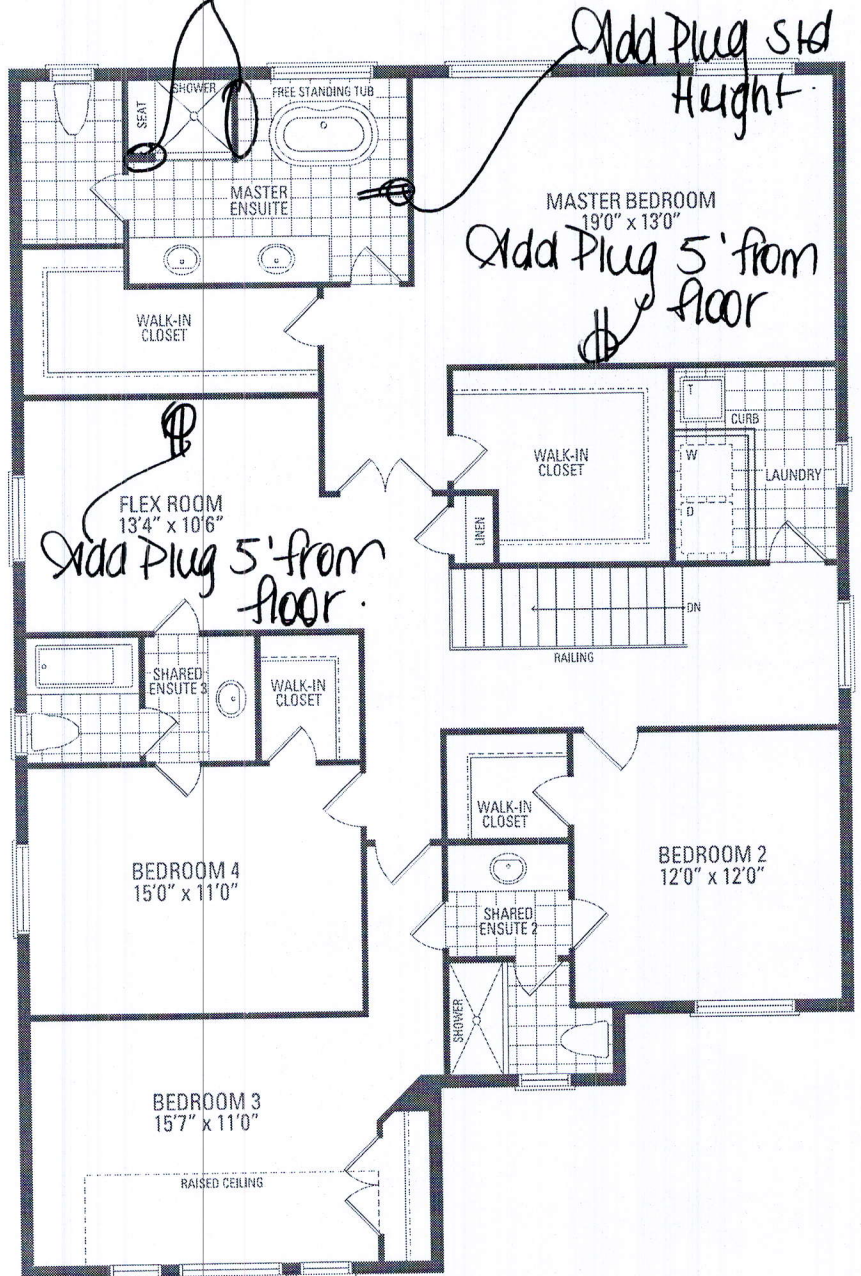

ELEV. 1

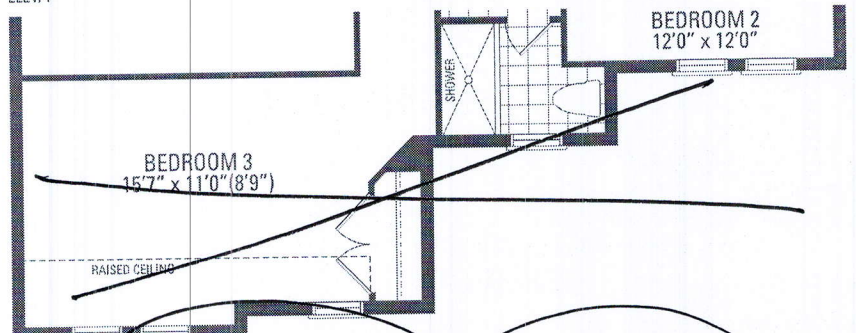

ELEV. 2

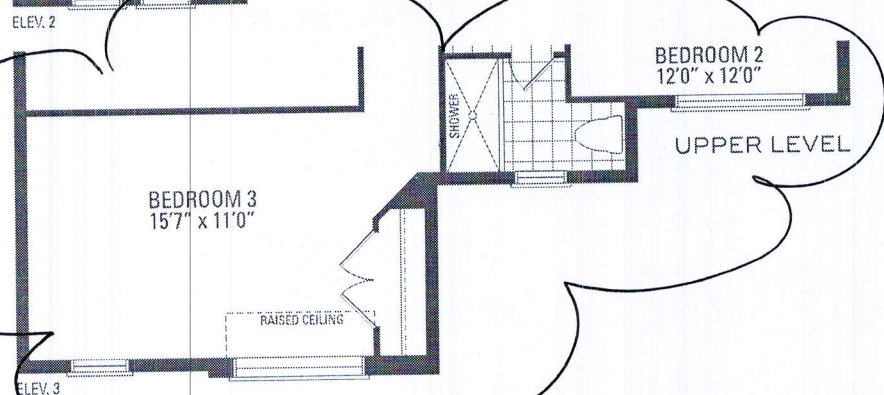


ELEV. 3

ELEV. 1 • 3,551 sq.ft. | ELEV. 2 • 3,530 sq.ft. | ELEV. 3 • 3,547 sq.ft.

and porches may vary at any exterior entrance ways due to grading variance. Actual usable floor space may vary from the architectural detailing subject to modifications. Roofline and adjoining model types may vary due to siting. E. & O.E May 2021



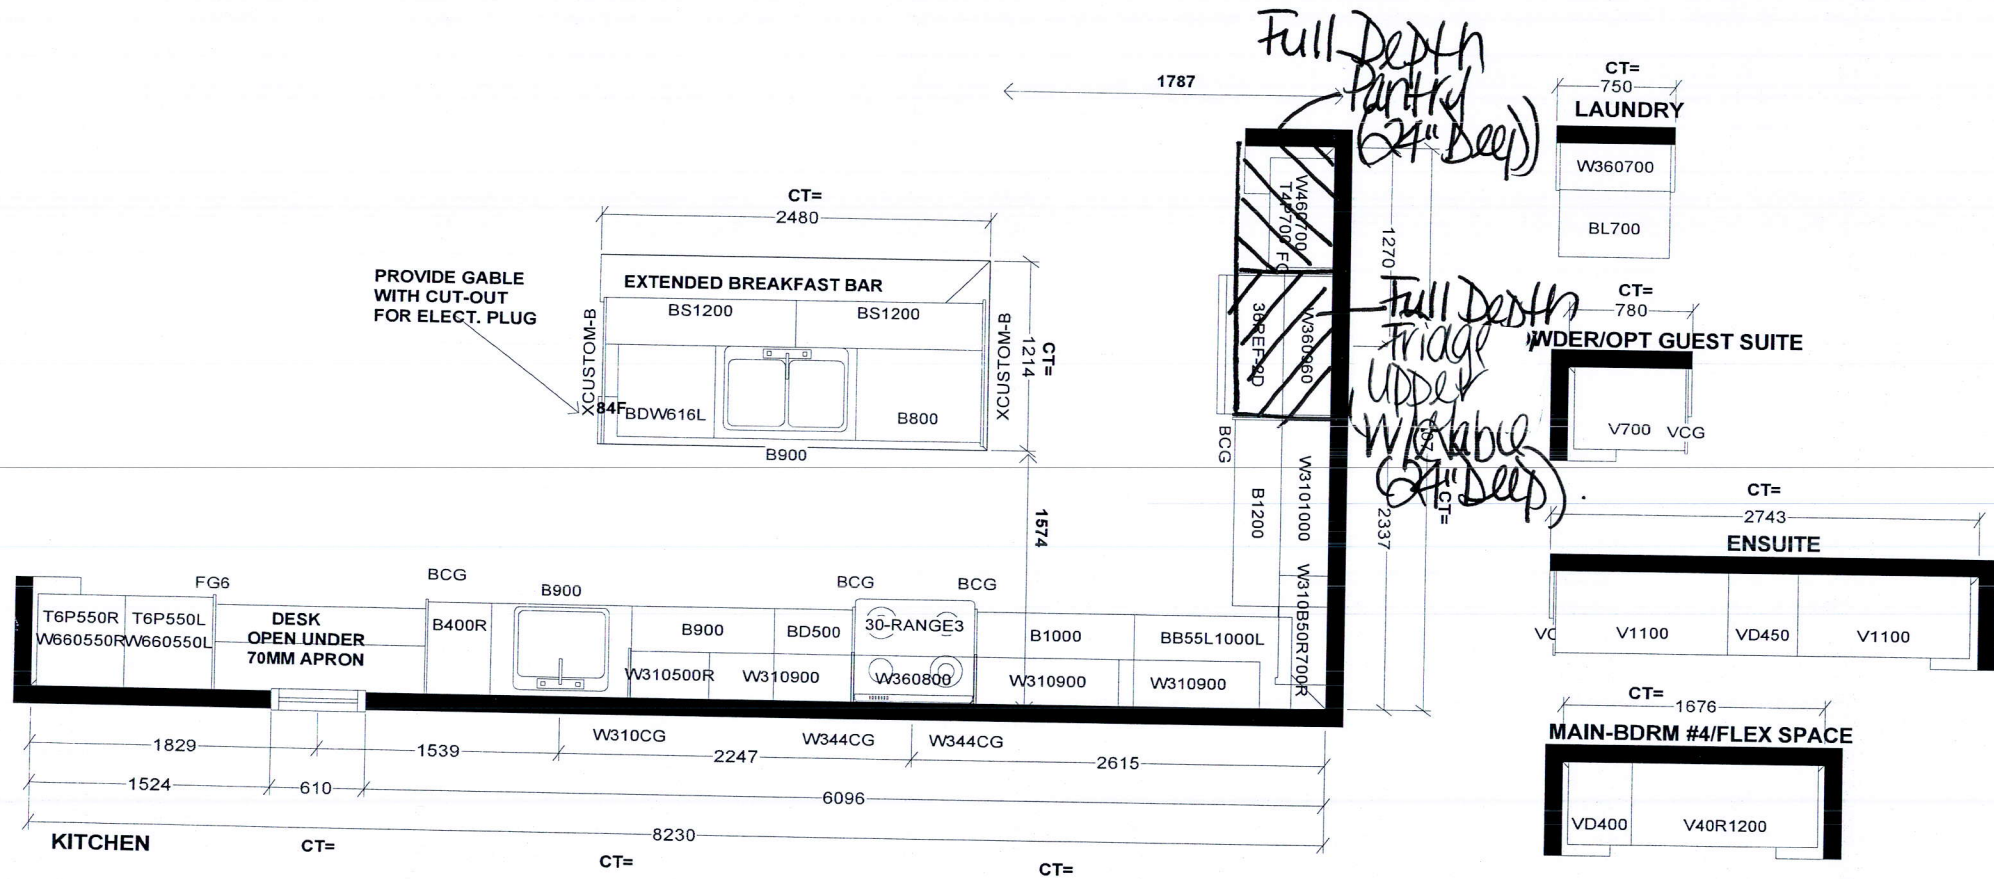

| Selba Industries | | | J# |
|---|-----------|----------------|--|
| W WDTH | W HGHT | W CNT | JOB NUMBER: BUILDER: GREENPARK SITE: RUSSELL GARDENS PH.4 MODEL: SPRINGFIELD 2X EL 1,2,3 LOT #: |
| FLOOR HGHT | DOOR HGHT | | |
| ST CENT | 2X4 | VENT BOX COVER | |
| <small>This drawing is the intellectual property of SELBA INDUSTRIES INC. and is an original design which must not be released or copied unless applicable fee has been paid or job order placed.</small> | | | |
| DESIGNER: LR DATE: APR 28 21 REV'D SEPT 22 21 | | | |

APR

LB

Purchaser:
Lot:

Schedule SMART
Russell Gardens Building Ltd. (Phase 4)

Smart Home System includes:

1. One (1) Smart Home Hub installed in a location as determined by the Vendor;
2. One (1) Doorbell camera supplied and installed at front door;
3. One (1) smart home thermostat to be installed in a location as determined by the Vendor;
4. One (1) smart Flood sensor to be installed in a location as determined by the Vendor which is designed to detect water in the location of the sensor only;
5. Smart light switches to be installed in such locations as determined by the Vendor;



Certain devices for The Smart Home System require a fully functioning WiFi network and internet connection and others work on the Zwave wireless network. Provision of WiFi, internet access and functionality shall be the sole responsibility of the Purchaser and the Vendor assumes no responsibility or obligation with respect to the functionality or performance of a homeowner's internet or WiFi network. The Vendor does not guarantee that networks, equipment, or services will meet all homeowner needs.

The Purchaser will be required to download the Homewave Smart Connect App (the "App") in order to configure and set up the Smart Home System devices. The Purchaser is responsible to ensure that they have the appropriate technology to download the App and any charges and fees for download and/or data usage shall be at the Purchaser's sole cost and expense. Access to the App shall be provided free of charge for 1 year from the Closing Date and thereafter the Purchaser may enter into an agreement with Homewave Smart Connect to continue the services for a monthly fee (currently \$10.00/month plus HST). Fees subject to change without notice.

Purchasers are responsible for configuring all security features. The Vendor does not warrant or represent that any network or Smart Home System devices are secure or can prevent all privacy intrusions, malware, or cyber-attacks, even when correctly configured. The products and services for the Smart Home System are provided by third parties, and not the Vendor. The Vendor does not guarantee any equipment or services provided by third parties. If the Purchaser contracts with the third-party provider to upgrade or purchase further devices, the Vendor has no responsibility for same, including but not limited to, the installation, service, safety or functionality of said products.

Energy claims are not based upon specific testing of an individual home but are general assumptions. Savings will vary due to many variables, including but not limited to, actual utility rates and fees, actual construction, floor plan, occupancy, appliance usage, thermostat settings, weather conditions, number of individuals occupying the home and orientation of the home.

The Vendor is providing only those Smart Home System's devices and components listed in this Schedule. Please see the balance of your Agreement of Purchase and Sale for additional information, disclosures, and disclaimers relating to your home and its features. The specific features in a home may vary from home to home and from one community to another. The Vendor reserves the right to substitute equipment, material, appliances and brand names with items of equal or higher value, in its sole and unfettered discretion. The Vendor reserves the right, in its sole and absolute discretion, to omit installation of the Smart Home System, in part or in whole, and the Purchaser shall have no claim for abatement or reduction the Purchase Price or to any delay in closing. Installation of the Smart Home System may result in the elimination of other features listed in Schedule GP or other information material, such as but not limited to set back thermostat, rough-in for alarm or other features deemed redundant as a result of the installation of the Smart Home System.

| | |
|--|--|
| Purchaser Initials  | Purchaser Initials  |
|--|--|