

4
+ nohvy



J# 3800 x 7
017

APR 8 22
FRIEDA

JOB NUMBER: 2110017
BUILDER: GREENPARK
SITE: RUSSELL GARDENS PH.3
MODEL: VALLEYCREEK 1Y EL 1,2,3
LOT #: 327

THIS DRAWING IS THE PROPERTY OF SELBA INDUSTRIES INC. and is on original design which must not be released or copied unless applicable too has been paid for and order placed.


SELBA INDUSTRIES INC.
 B. DATE: MAY 13 2004
 C. DATE: MAY 13 2004
 D. DATE: MAY 13 2004

W WIDTH _____ W HGT _____ W CNT _____
FLOOR HGT _____ DOOR HGT _____

ST CENT _____ 2X4 _____ VENT BOX COVER _____

RECEIVED
APR 13 2022


RUSSELL
GARDENS
LOT 327

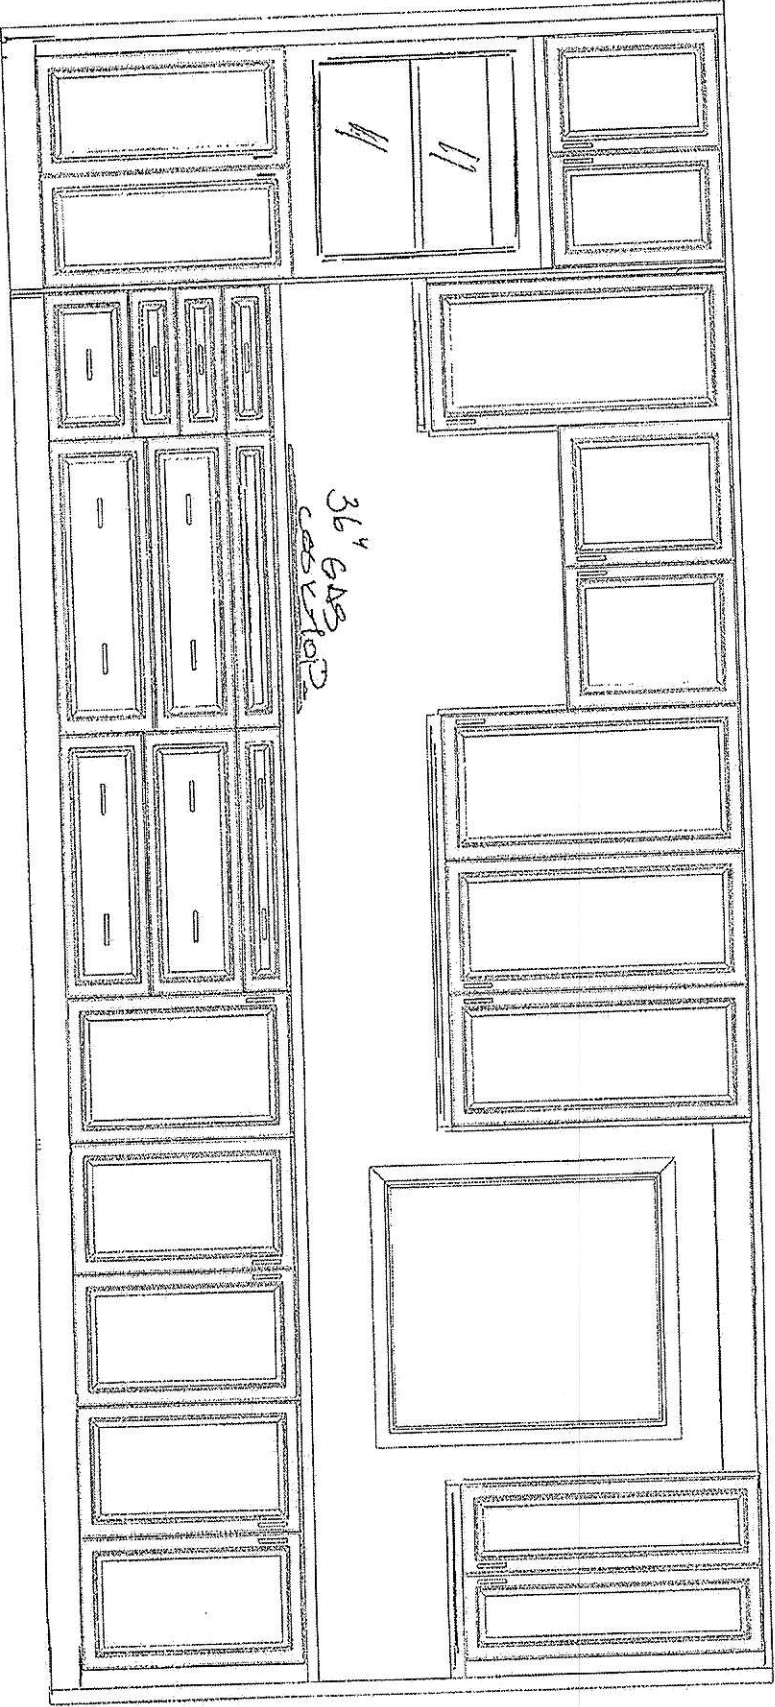

SINGLE
FLEX
OVEN

CS


RUSSELL GARDENS
LOT 327

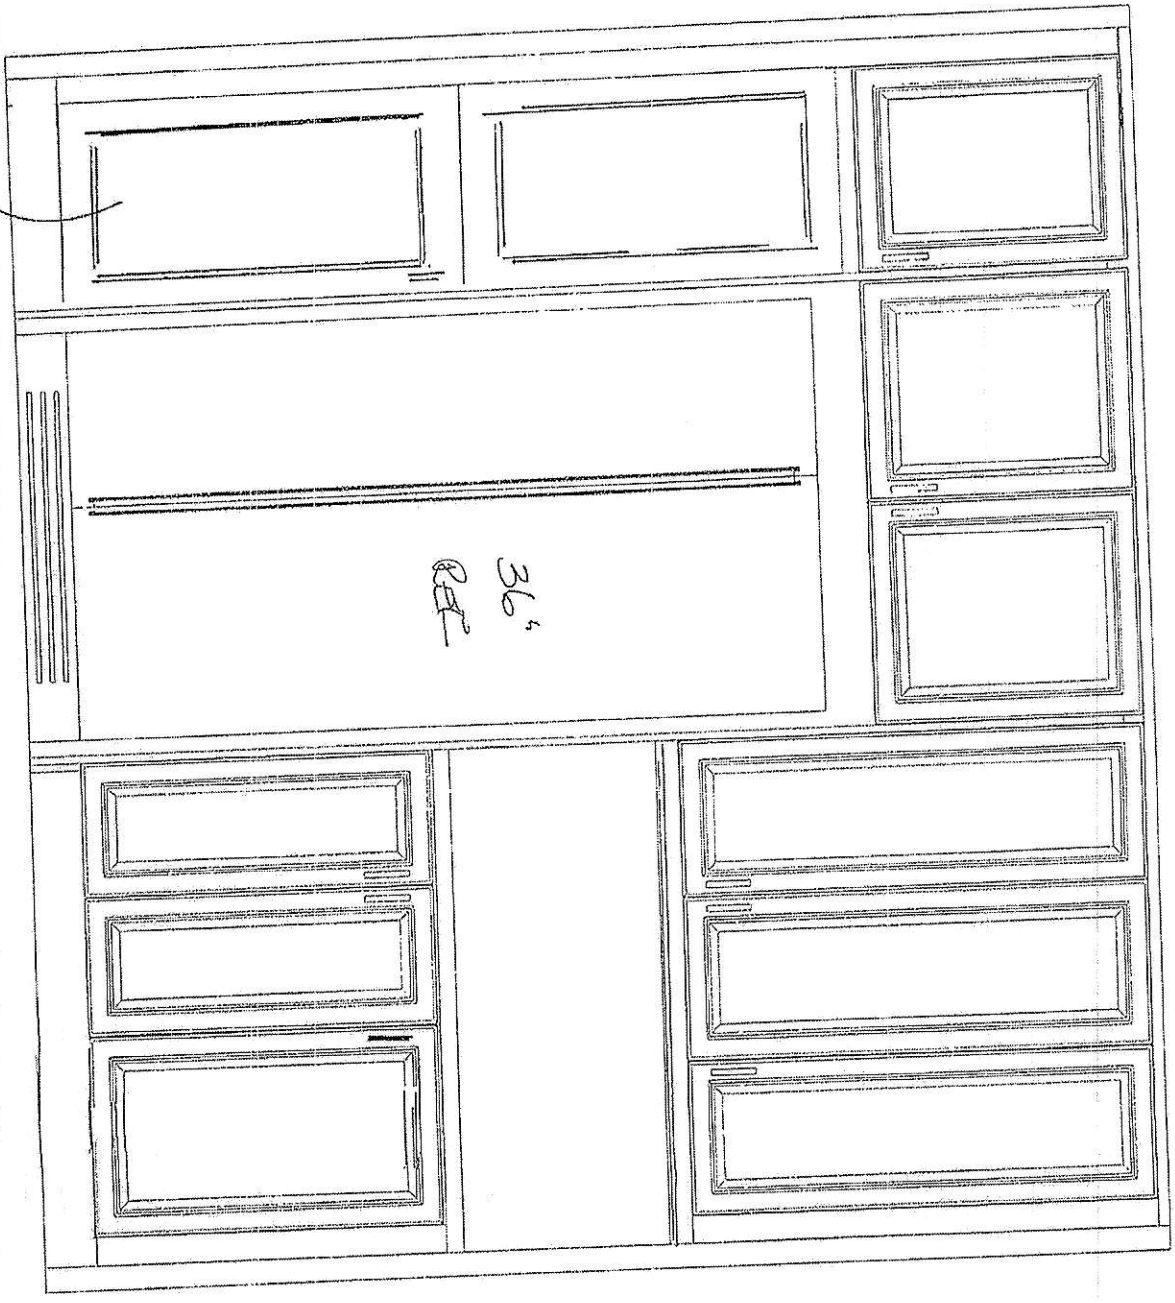

PANTRY
24" DEEP

Q

RUSSELL GARRETS
LOT 327

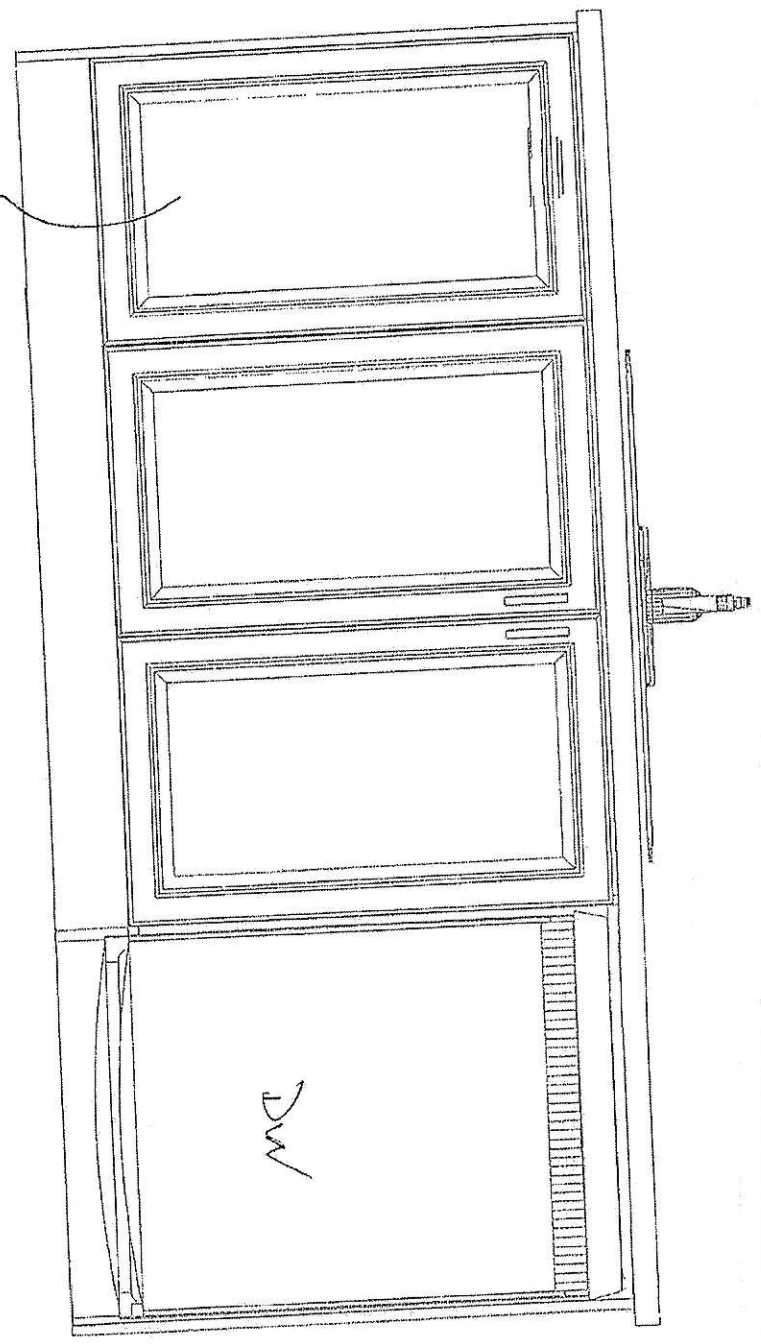


2 BIN
WASTE
RECYCLE

ISLAND FACING FRIDGE

CS


RUSSELL GARDEN LOT
307

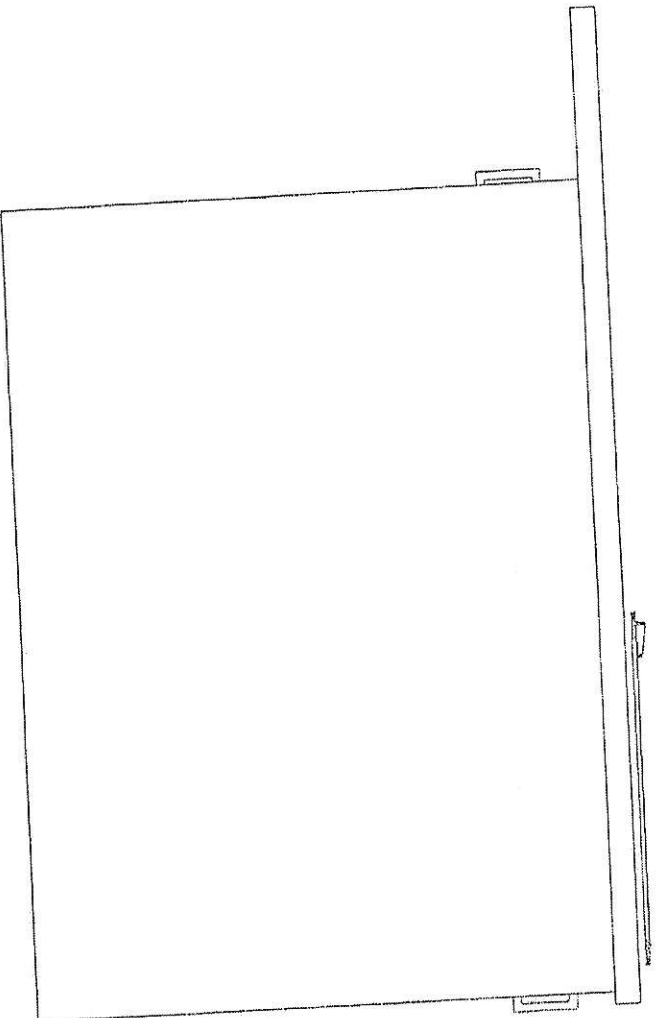

CS

GRAND ENDS

RUSSELL GARDEN
LOT 327-

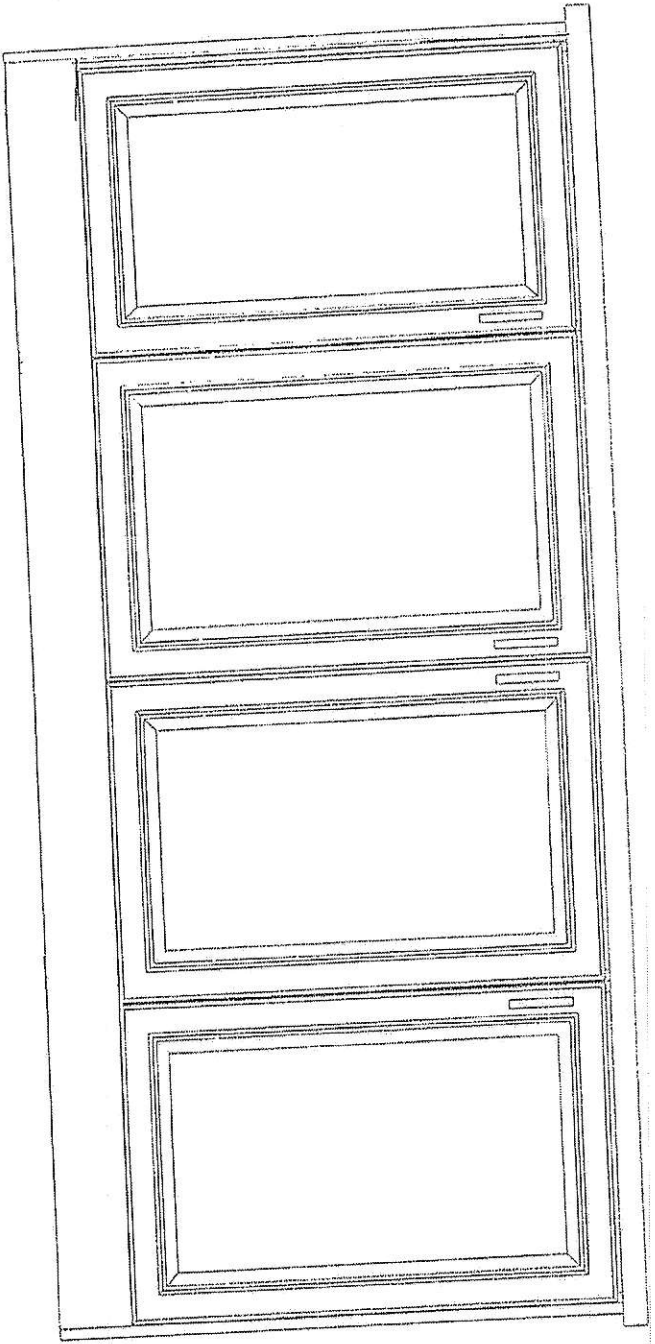

(CS)

ISLAND FACING BREAKFAST
AREA