

CONSTRUCTION SUMMARY

Mountainview Heights 3 (G) - Russell Gardens Building Ltd.

RECEIVED

PURCHASER: PONNUTHURAI CHANDRAGIRI

APR 21 2022

TEL:

LOT / PHASE	REG. PLAN #	HOUSE TYPE		
155 / 3	62M-1266	Mountainash Three (5 Bedroom) Elev 3		

COUNTER TOP

1 - QUARTZ BACKSPLASH - UPGRADE - KITCHEN 14Apr21 Note:	
1 - COUNTER TOP - UPGRADE - KITCHEN COUNTER TOP 14Apr21 Note:	
1 - COUNTER TOP - PROMO - POWER ROOM VANITY COUNTER TOP 14Apr21 Note:	
1 - COUNTER TOP - UPGRADE - ENSUITE BATHROOM VANITY COUNTER TOP 14Apr21 Note:	
2 - SHAMPOO NICHE 24" WIDE X 20" HIGH AS PER SKETCH – MARBLE, GRANITE OR QUARTZ – IF CONSTRUCTION PERMITS - REQUIRES PROVISION FROM CONSTRUCTION - ENSUITE 2/3 & ENSUITE 4/5 BATHROOMS 14Apr21 Note: SUPPLY & INSTALL	
1 - SHAMPOO NICHE 14" WIDE X 20" HIGH AS PER SKETCH – MARBLE, GRANITE OR QUARTZ – IF CONSTRUCTION PERMITS - REQUIRES PROVISION FROM CONSTRUCTION - MASTER ENSUITE BATHROOM 14Apr21 Note: SUPPLY & INSTALL	


DOORS AND TRIM

1 - THROUGHOUT INTERIOR DOORS ONLY - PLAIN BLACK HINGES 18Jan22 Note:	
1 - DOORS INTERIOR - LINCON SMOOTH HALLOW IN LIEU OF STANDARD SERIES - PRICE IS PER DOOR 14Apr21 Note:	
1 - TRIM - UPGRADE 2- 7-¼" ONE STEP BASEBOARD AND BB ONE STEP CASING 14Apr21 Note:	

ELECTRICAL

1 - KITCHEN - REVISE KITCHEN LAYOUT - SWAP LOCATIONS OF FRIDGE AND PANTRY AS PER SKETCH 18Apr22 Note:	New	★
1 - KITCHEN - RELOCATE FRIDGE TO ACCOMMODATE BUILT-IN OVEN AND MICRO 14Apr21 Note:		
1 - PLUG - ELECTRICAL PLUG - ADD TO ISLAND 14Apr21 Note:		
1 - KITCHEN - CANOPY HOOD FAN - 36" CYCLONE 550 CFM #SC50136 (GLASS CANOPY) 14Apr21 Note:		
1 - MAIN HALL - DELETE STANDARD LIGHTS TO ACCOMMODATE POTLIGHTS 14Apr21 Note:		
2 - SWITCH - DIMMER SWITCH IN LIEU OF EXISTING SWITCH - PRICE IS EACH - FAMILY ROOM AND DINING ROOM - ON POTLIGHTS ONLY 14Apr21 Note:		
2 - POT LIGHT - LED - FIRST FLOOR INSTALLATION - INSTALLED ON SEPERATE SWITCH FROM STANDARD LIGHT - POWDER ROOM 14Apr21 Note:		

RUSSELL GARRENS  
LOT 155.

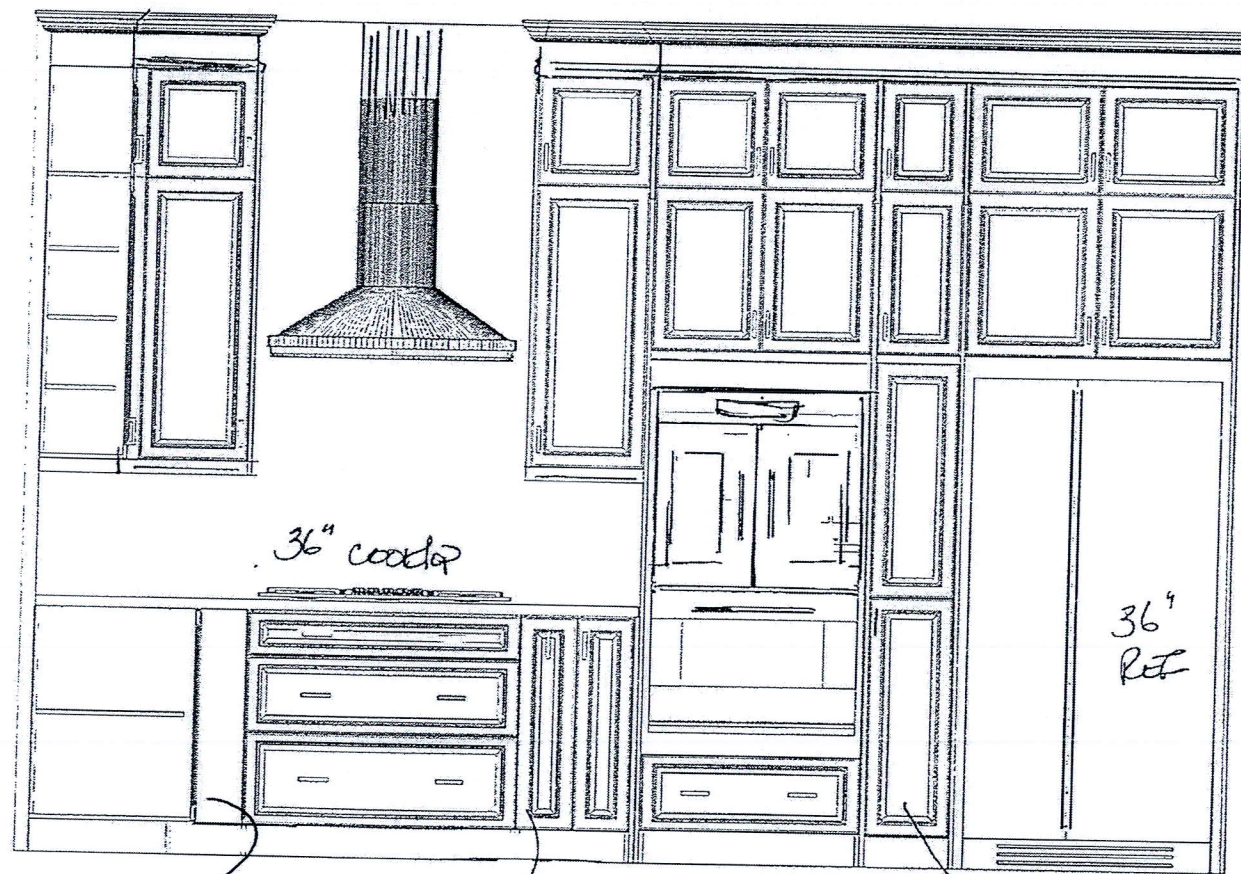

FILLER


SINK  
Pull  
OUT

OVEN  
French  
Doors

Pantry

RSW 7



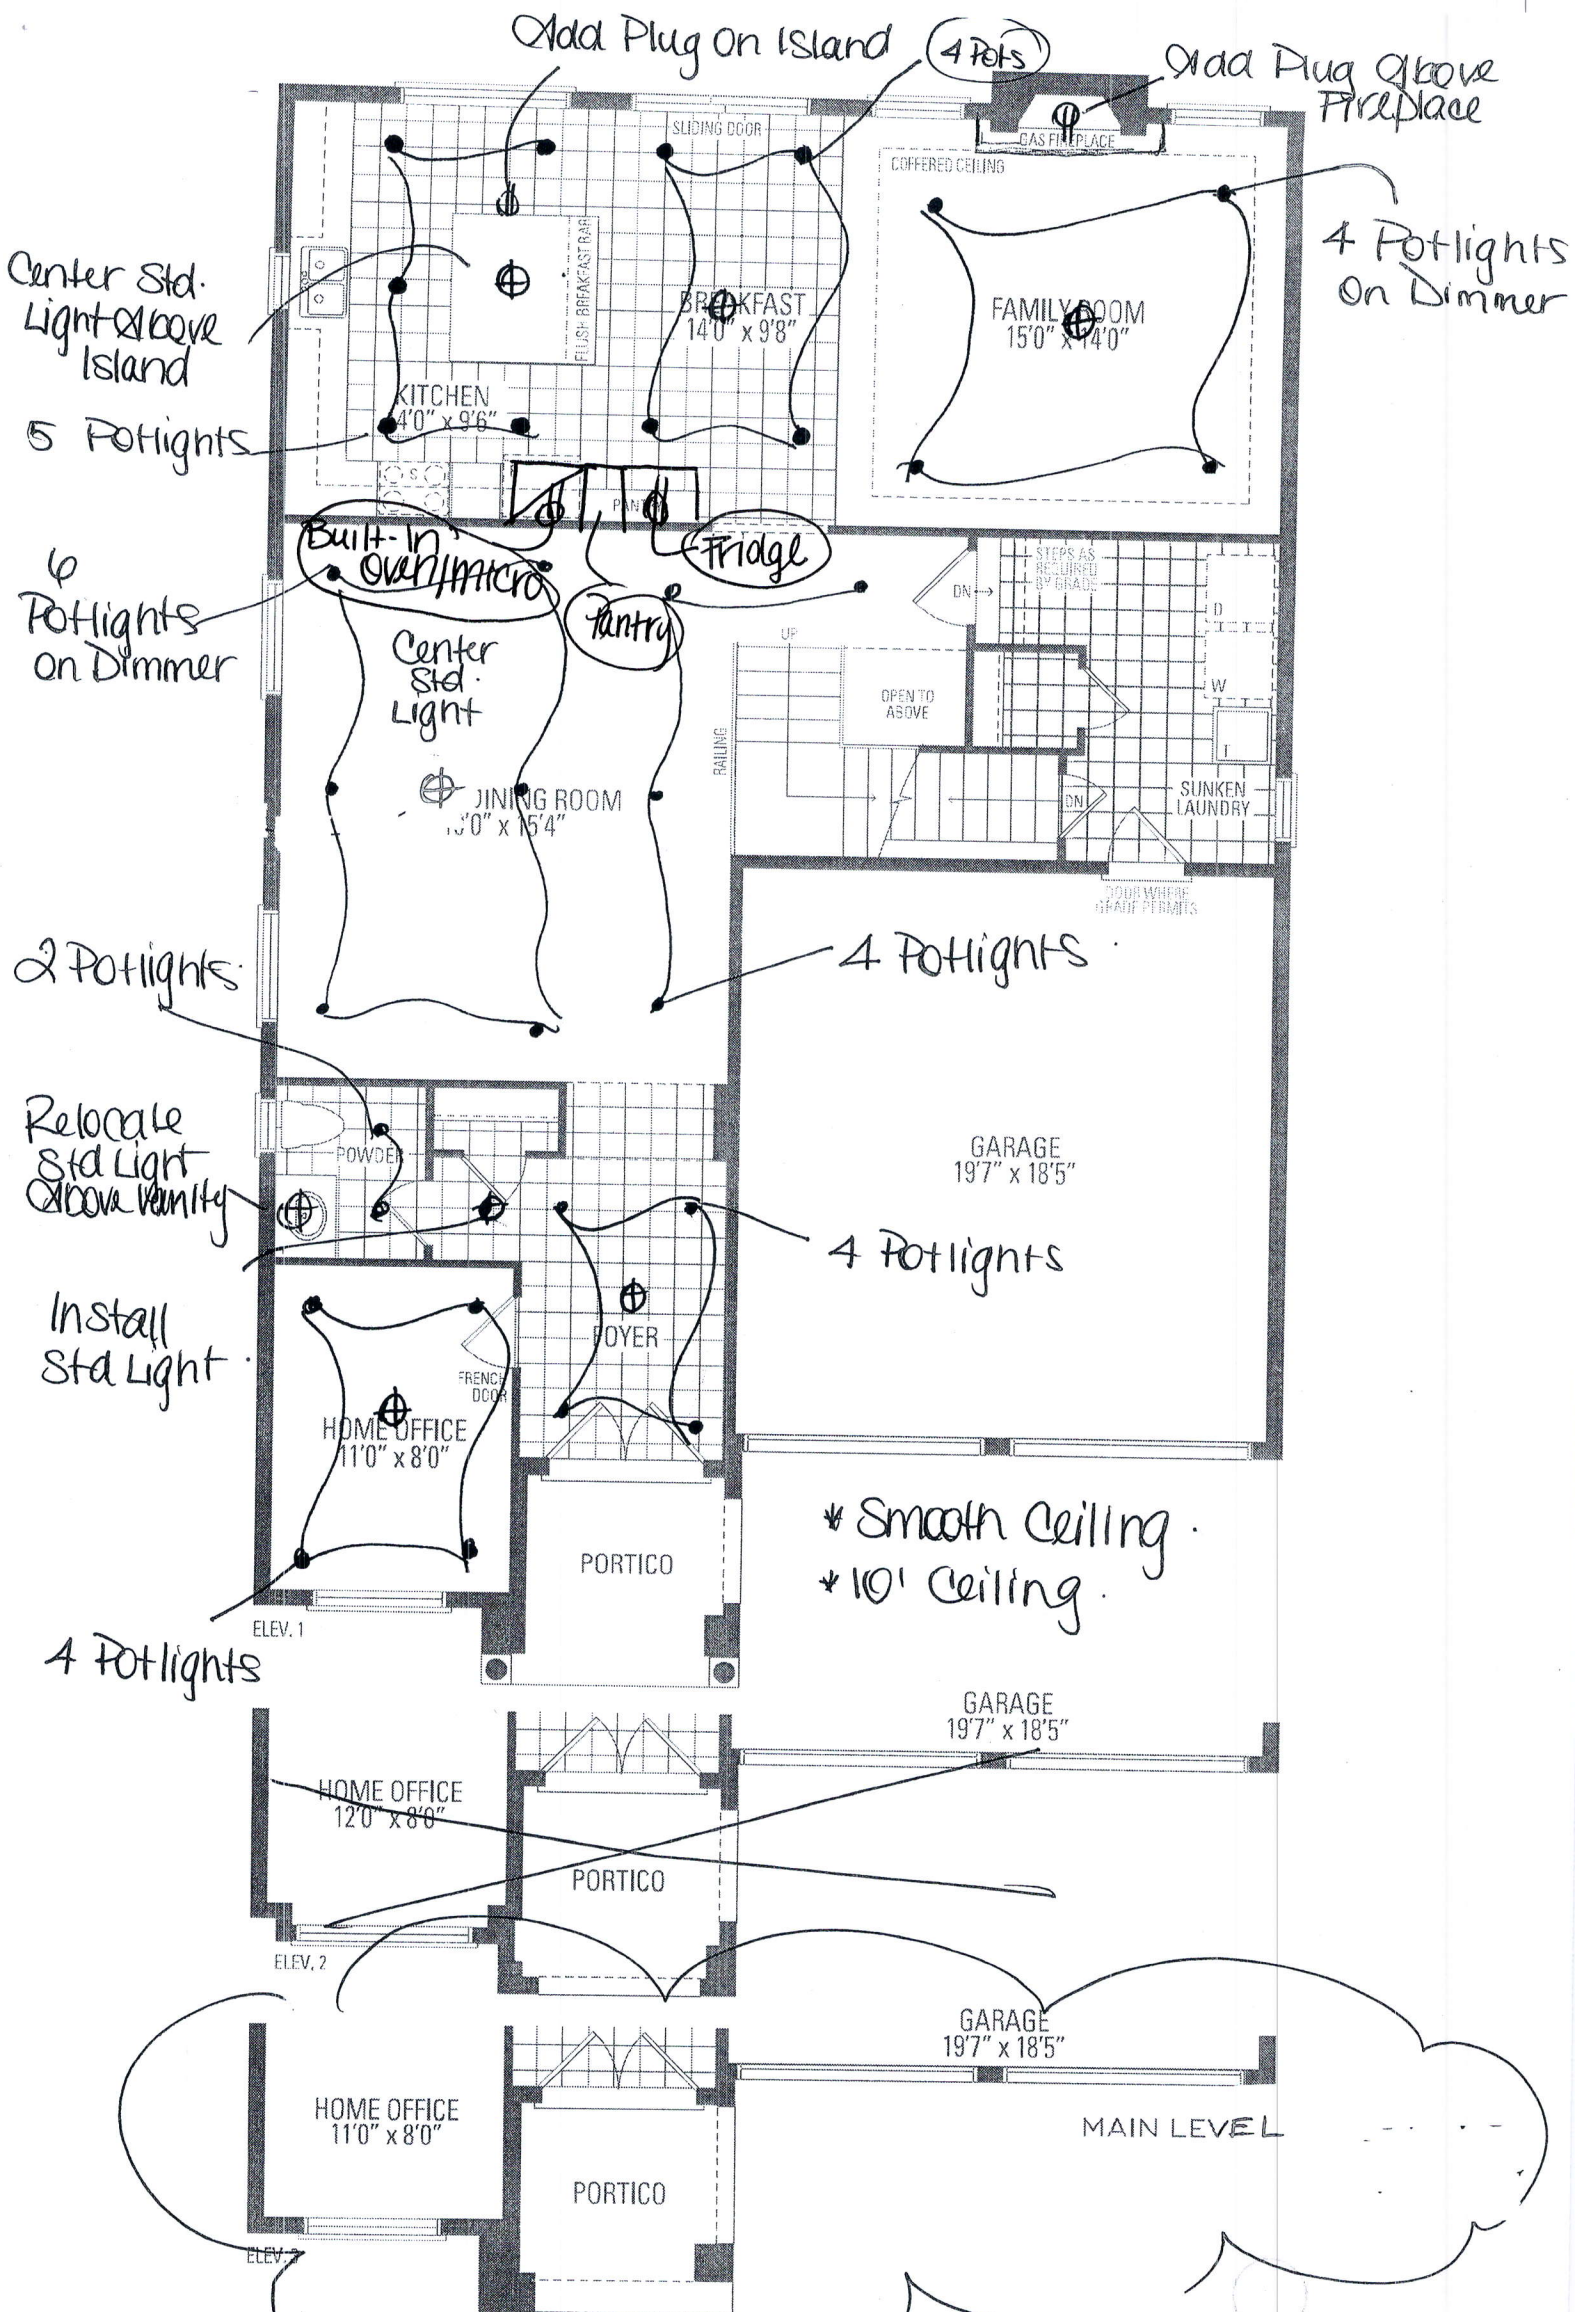

## MOUNTAINASH THRI

Orientation of home may be reversed and purchaser agrees the stated floor areas. All renderings are artist's concept. Dimen