


LOT 539  
RUSSELL GARDENS  
PHASE 4  
MOUNTAINVIEW HEIGHTS

VALLEYCREEK 3  
ELEV. 2

REVISIONS:

- 1. FAMILY ROOM FIREPLACE  
CAN NOT PROJECT INTO  
SIDE YARD DUE TO LOT  
REQUIREMENTS.

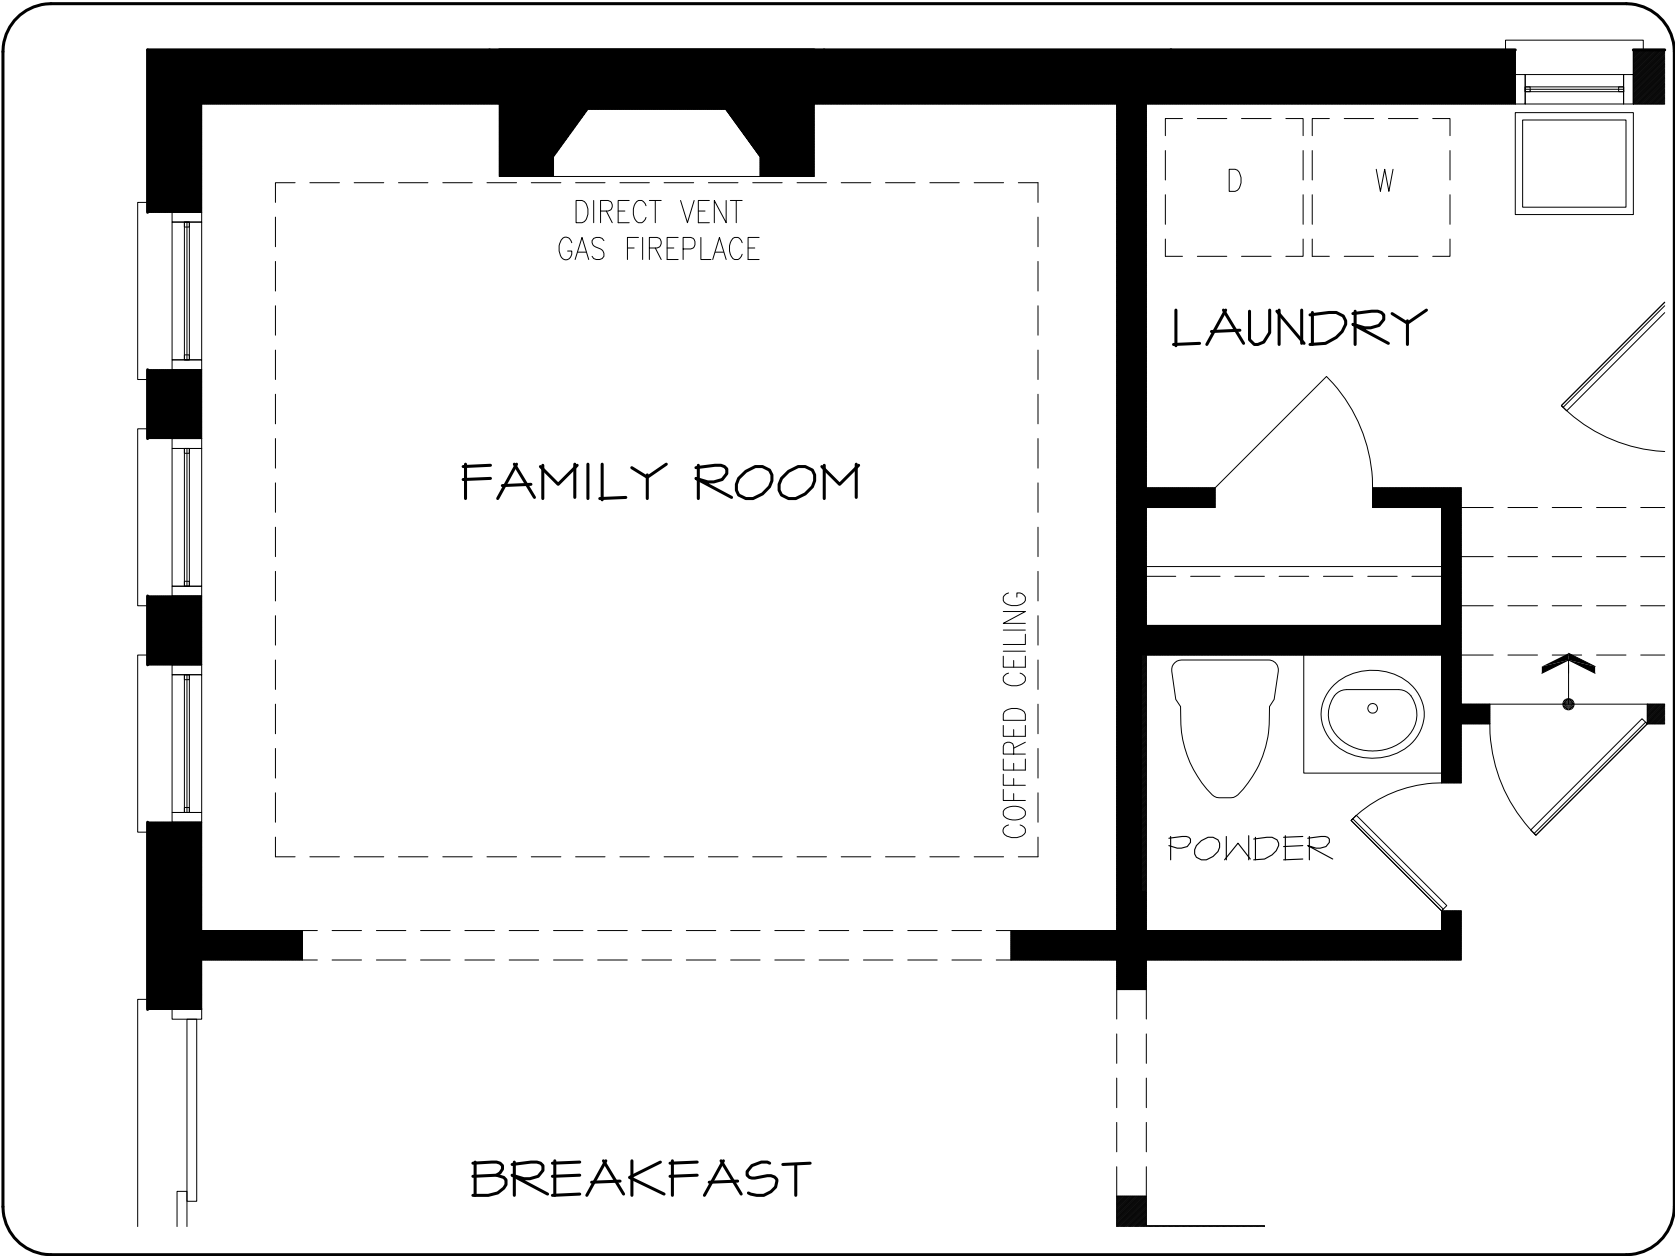

MAIN LEVEL

DISCLAIMERS: SKETCH NOT TO SCALE. DIMENSIONS, SPECIFICATIONS AND ARCHITECTURAL DETAILS SUBJECT TO MODIFICATION BY THE VENDOR. SKETCH IS ONLY FOR THE PURPOSE OF ILLUSTRATING REVISIONS REQUESTED BY THE PURCHASER AND ALL REVISIONS ARE SUBJECT TO VENDOR'S FINAL APPROVAL. ONLY REVISIONS ACCEPTED IN WRITING BY THE PURCHASER AND VENDOR ON A PURCHASER'S EXTRA SHEET WILL BE INCORPORATED INTO THE PLANS FILED WITH THE MUNICIPALITY. E. & O.E.



SCALE	
N.T.S.	
BY	PAGE No.
MB	1 OF 1

