	CON	STRUCTION SUMMARY	the last of the second of the	
		Heights 3 (G) - Russell Gardens Building Lt	d. RECEIVED	
PURCHASERS: SIDRA M.	ANZOOR BHUTTO and MAN	NZOOR AHMED BHUTTO	JUL 6 - 2022	TEL:
LOT / PHASE	REG. PLAN#	HOUSE TYPE		
368 / 4	62M-1266	Valleycreek Two Elev 3		
CONSTRUCTION				
	IN KITCHEN IF CONSTRUC	CTION PERMITS		
04Jul22 Note:				
ELECTRICAL				
	D KITCHEN LIGHT TO BE C	CENTERED OVER ISLAND		
04Jul22 Note:				
1 - PLUG - FLECTRICAL P	LUG WITH GELAND SWITC	CH - FOR FESTIVE LIGHTING		
04Jul22 Note:	boo will dirand swite	on Town Editive Blomming		
1 - PLUG - ELECTRICAL P	LUG - TO BE INSTALLED O	OVER FIREPLACE		
04Jul22 Note:				
HARDWOOD FLOORIN	l <b>G</b>			
	SERIES 3 1/4 INCH - IN LIE	EU OF 2 1/4 INCH NATURAL RED OAK MAIN F	IALL	
04Jul22 Note:				
1 HARDWOOD BROMO	SEDIES 2 1/4 INCH IN LIE	SU OF 2 1/4 INCH NATURAL RED OAK FAMIL'	V DOOM	
04Jul22 Note:	SERIES 5 1/4 INCH - IN LIE	O OF 2 1/4 INCH NATURAL RED OAK FAMIL	I KOOM	
1 - HARDWOOD - PROMO	SERIES 3 1/4 INCH - IN LIE	CU OF 2 1/4 INCH NATURAL RED OAK DINING	ROOM	
04Jul22 Note:				
MIRRORS AND GLASS				
	RAMELESS GLASS SHOWER	R ENCLOSURE – INCLUDES CHROME KNOB AN	D HINGES	
10Jun21 Note:				
PROMOTIONAL				
I - LESS BALANCE OF CR	EDIT FROM PURCHASER E	EXTRA SHEET IN OFFER		
04Jul22 Note:				
1 I FCC CDEDIT FDOM DI	JRCHASER EXTRA SHEET	DI OPPED		
	ROMO BALANCE \$5765.0			
TAIRS AND RAILINGS				
	ANDARD STAIRCASE - PRIC	CE IS PER SET		
04Jul22 Note:	INDINED STAINCTION THE	00 10 1 DK 001		
	EXT	TRAS AS PER OFFER		
		THIS AS TEN OTTEN		
		term or provision in this Agreement included in th		
addition to those items deta Worksheet Note:	iled in Schedule GP to the	Agreement of Purchase and Sale, the Purchaser is	entitled to a credit of	
	o, from Vendor?s standard sa	amples		
Worksheet Note:				
		URCHASE PRICE IS INCLUSIVE OF ALL CRE	EDITS AND	
PROMOTIONAL PACKA <i>Worksheet</i> Note:	GES AVAILABLE AT TIN	ME OF PURCHASE.		

## **CONSTRUCTION SUMMARY**

Mountainview Heights 3 (G) - Russell Gardens Building Ltd.

PURCHASERS: SIDRA MANZOOR BHUTTO and MANZOOR AHMED BHUTTO

TEL:

LOT / PHASE	REG. PLAN #	HOUSE TYPE	
	REG. I EAN #	HOUSETTTE	
368 / 4	62M-1266	Valleycreek Two Elev 3	

This Document is Extremely Time Sensitive - Printed  $\underline{4 \text{ Jul } 22}$  at  $\underline{12:38}$ 

Printed 7/4/2022 12:45:41

## INTERIOR COLOUR SCHEME

		Project: Russell Ga	
			rdens Building Ltd.
Look Datos		I and Elevation: Valleycreel	Two Elev 3
Lock Date.	I-Jul-22 4-Jul-22	Plan #:	62M-1266
	s ○ No Sketch Attached: ● Yes	No Exterior Colour S	Scheme:
1. Cabinetry	Style and Colour		Hardware
Kitchen / Breakfast	MONACO 823 DRIFT WOOD		465SA
Laundry Room	ELISSE		Standard
Powder Room	MONACO 821 INDUSTRIAL GRAPHITE		465SA
Master Ensuite Bathroom	MONACO 821 INDUSTRIAL GRAPHITE		465SA
Ensuite Bath - Bedroom 2	MONACO 821 INDUSTRIAL GRAPHITE		465SA
Ensuite Bath - Bedroom 3/4	MONACO 821 INDUSTRIAL GRAPHITE		465SA
Appliances:	Built In Appliances Yes No	CILA	a la Ctaux O Vas A Na
Dishwasher Cabinet			e In Stove Yes No Please NOTE: Standard Cabinet Height is 30
Stove Opening		Cabinets Yes No	
Fridge Opening			
riuge Opening	NOTE: If not specified, o	pening will be set to builder's standard open	ing of approximately 37" width x 74" height
2. Counters			
	Counter	Edge	
Kitchen / Breakfast	GRANITE - NEW CALEDONIA (G)	Edge #360 EDGE	
Kitchen / Breakfast Laundry Room	GRANITE - NEW CALEDONIA (G) N/A		
Kitchen / Breakfast _aundry Room Powder Room	GRANITE - NEW CALEDONIA (G)  N/A  LAMINATE-PORTICO MARBLE 7735-58		
Kitchen / Breakfast ∟aundry Room Powder Room Master Ensuite Bathroom	GRANITE - NEW CALEDONIA (G)  N/A  LAMINATE-PORTICO MARBLE 7735-58  LAMINATE-PORTICO MARBLE 7735-58		
Kitchen / Breakfast Laundry Room Powder Room Master Ensuite Bathroom Ensuite Bath - Bedroom 2	GRANITE - NEW CALEDONIA (G)  N/A  LAMINATE-PORTICO MARBLE 7735-58  LAMINATE-PORTICO MARBLE 7735-58  LAMINATE-PORTICO MARBLE 7735-58		
Kitchen / Breakfast Laundry Room Powder Room Master Ensuite Bathroom Ensuite Bath - Bedroom 2	GRANITE - NEW CALEDONIA (G)  N/A  LAMINATE-PORTICO MARBLE 7735-58  LAMINATE-PORTICO MARBLE 7735-58		
Kitchen / Breakfast Laundry Room Powder Room Master Ensuite Bathroom Ensuite Bath - Bedroom 2	GRANITE - NEW CALEDONIA (G)  N/A  LAMINATE-PORTICO MARBLE 7735-58  LAMINATE-PORTICO MARBLE 7735-58  LAMINATE-PORTICO MARBLE 7735-58		
Kitchen / Breakfast Laundry Room Powder Room Master Ensuite Bathroom Ensuite Bath - Bedroom 2 Ensuite Bath - Bedroom 3/4	GRANITE - NEW CALEDONIA (G)  N/A  LAMINATE-PORTICO MARBLE 7735-58  LAMINATE-PORTICO MARBLE 7735-58  LAMINATE-PORTICO MARBLE 7735-58  LAMINATE-PORTICO MARBLE 7735-58		
Kitchen / Breakfast Laundry Room Powder Room Master Ensuite Bathroom Ensuite Bath - Bedroom 2 Ensuite Bath - Bedroom 3/4	GRANITE - NEW CALEDONIA (G)  N/A  LAMINATE-PORTICO MARBLE 7735-58  LAMINATE-PORTICO MARBLE 7735-58  LAMINATE-PORTICO MARBLE 7735-58  LAMINATE-PORTICO MARBLE 7735-58  CAMINATE-PORTICO MARBLE 7735-58  Summary		

Initials:\_\_

Page 1 of 4

## Greenpark. INTERIOR COLOUR SCHEME Purchasers: SIDRA MANZOOR BHUTTO & MANZOOR AHMIProperty: 368 Telephone Res. / Bus: / Project: Russell Gardens Building Ltd. Decor Advisor: Aly Aversa Model and Elevation: Valleycreek Two Elev 3 Lock Date: 4-Jul-22 4-Jul-22 Plan #: 62M-1266 3. Ceramic Flooring At a 45 Threshold-If App. **Entrance Vestibule** TILE-UNISTONE 609 WHITE 13X13 Metal Strip Where Applic. Main Hall HARDWOOD Kitchen / Breakfast TILE-UNISTONE 609 WHITE 13X13 Laundry Room TILE-UNISTONE 609 WHITE 13X13 **Powder Room** TILE-UNISTONE 609 WHITE 13X13 Master Ensuite Bathroom TILE - RAINBOW LIGHT GREY 13X13 Ensuite Bath - Bedroom 2 TILE - RAINBOW LIGHT GREY 13X13 Ensuite Bath - Bedroom 3/4 TILE - RAINBOW LIGHT GREY 13X13 \*\* Refer to Construction Summary 4. Ceramic Wall Tile Master Ensuite Bathroom Selection Describe Tub Deck Wall N/A Tub Deck N/A Tub Deck Skirt N/A Shower Stall TILE - SILVIA WHITE 8X16 Bathtub Enclosure Walls N/A Ensuite Bath - Bedroom 2 TILE - SILVIA WHITE 8X16 TILE - SILVIA WHITE 8X16 Ensuite Bath - Bedroom 3/4 Kitchen Backsplash \*\* Refer to Construction Summary - STANDARD GROUT THROUGHOUT UNLESS SPECIFIED Plumbing Fixtures

All Bathrooms	White	Whirlpool
		Dishwasher Rough-In ● Yes ○ No Waterline for Fridge ○ Yes ● No
Refer to Construc	tion Summary	

Interior Doors	As Per Construction Specifications	
Interior Trim	As Per Construction Specifications	
Door Handles As Per Construction Specifications		
Exterior Front Door Handle	As Per Construction Specifications	
** Refer to Construction Sur	nmarv	

Initials:\_\_\_\_\_

Purchasers:

### INTERIOR COLOUR SCHEME

SIDRA MANZOOR BHUTTO & MANZOOR AHMIProperty: 368

Telephone Res. / Bus:	1	Project: Russell Gardens Building Ltd.			
Decor Advisor:	Aly Aversa	Model and Elevation: Valleycreek Two Elev 3			
Lock Date:	4-Jul-22	4-Jul-22	Plan #:	62M-1266	
1. Unler Flooring					
Main Hall	HARDWOOD-N	MIRAGE-ADMIRATION COLLECTIO	N-WATERLOO-RED OAK 3	1/4 CASHMERE	
Living Room	N/A	N/A			
Dining Room	HARDWOOD-N	//IRAGE-ADMIRATION COLLECTIO	N-WATERLOO-RED OAK 3	1/4 CASHMERE	
Family Room	HARDWOOD-N	HARDWOOD-MIRAGE-ADMIRATION COLLECTION-WATERLOO-RED OAK 3 1/4 CASHMERE			
Den / Library / Study	N/A				
Basement Landing(If Applie	s) N/A				
Lower Landing (If Applies)		MIRAGE-ADMIRATION COLLECTIO			
Upper Landing		MIRAGE-ADMIRATION COLLECTIO		1/4 CASHMERE	
Upper Hall		LAMINATE-LEXINGTON-WALCOURT HICKORY-TL-LW1315			
Master Bedroom		LAMINATE LEXINGTON WALCOURT HICKORY-TL-LW1315			
Bedroom #2		LAMINATE LEXINGTON WALCOURT HICKORY-TL-LW1315			
Bedroom #3		LAMINATE-LEXINGTON-WALCOURT HICKORY-TL-LW1315			
Bedroom #4		LAMINATE-LEXINGTON-WALCOURT HICKORY-TL-LW1315			
Bedroom #5	N/A				
Underpad	Typo		Area		
Onderpad	Туре		Alea .		
** Refer to Constructio					
Stringer / Riser AS P Treads AS P Red  ** Refer to Construct	ER CONSTRUCTION SPECIFICATIONS   Complimenting Colour   MIRAGE-RED OAK-WATERLOO   ER CONSTRUCTION SPECIFICATIO   Complimenting Colour   MIRAGE-RED OAK-WATERLOO   ER CONSTRUCTION SPECIFICATIO   Complimenting Colour   MIRAGE-RED OAK-WATERLOO   Dak Stairs   Yes   No   Iton Summary   THE STAIN COLOURS OR FINISH AVAILABLE ON RISERS, TREADS, PICKETS   ASES), WILL NOT BE AN EXACT MATCH TO PREFINISHED HARDWOOD OR LAMINATE				
9. Wall Paint Flat F	inish				
Main & Upper Hall	22 WARM	GREY Master	Bedroom	22 WARM GREY	
Living Room	N/A	Bedroo	om #2	22 WARM GREY	
Dining Room	22 WARM	GREY Bedroo	om #3	22 WARM GREY	
Kitchen / Breakfast	22 WARM	GREY Bedroo	om #4	22 WARM GREY	
Family Room	22 WARM	GREY <b>Bedro</b> c	om #5	N/A	
Powder Room	22 WARM		Ensuite	22 WARM GREY	
Laundry Room	22 WARM (		Bath - Bedroom 2	22 WARM GREY	
Den/Library	N/A		Bath - Bedroom 3/4	22 WARM GREY	
Trim & Door Paint-Sem					
2 2 2 2					
Smooth Ceilings First	Floor Yes	● No			
** Refer to Constructio		- 110			
Refer to constructio	ii Suiiiiiai y				

#### **Greenpark** INTERIOR COLOUR SCHEME Purchasers: SIDRA MANZOOR BHUTTO & MANZOOR AHMIProperty: 368 Telephone Res. / Bus: Project: Russell Gardens Building Ltd. **Decor Advisor:** Aly Aversa Model and Elevation: Valleycreek Two Elev 3 Lock Date: 4-Jul-22 4-Jul-22 Plan #: 62M-1266 10. Plaster Mouldings and Medallions **Entrance Vestibule** Kitchen/Breakfast Main Hall Den/Library Living Room Lower Landing **Dining Room Family Room** \*\* Refer to Construction Summary 11. Fireplace Living Room Family Room Other Room - Specify Purchased As Per Plan N/A Purchased As Per Plan N/A Purchased As Per Plan N/A 0 Fireplace Type As Per Construction Specifications Mantle Type MANTLE M1-STANDARD Colour / Stain AS PER CONSTRUCTION SPECIFICATIONS Surround NERO Hearth N/A \*\* Refer to Construction Summary 12. Heating and Air Conditioning Air Conditioning NO **Gas Provisions Stove** NO Gas Provisions Dryer NO Gas Provisions Barbecue NO Comment \*\* Refer to Construction Summary 13. Electrical Plugs and Switches White Standard Above Kitchen Cabinet Light Yes No **Hood Fan** STANDARD WHITE Below Kitchen Cabinet Light O Yes No **Appliances Built in Cooktop Built in Oven Gas Stove Microwave** ( ) Yes No Yes No Yes No Yes No Dishwasher Rough-in Yes


#### **Disclaimers and Notes**

**14. General Comments**\*\* Refer to Construction Summary


\*\* Refer to Construction Summary

- 1) Colours of all materials are as close as possible to builder's selection, but not necessarily identical due to variances in manufacturing.
- 2) Any extras listed above are null and void unless accompanied by a separate invoice/amendment. Said invoice must be paid in full.
- The Purchaser agrees that this colour selection is final and that no changes will be permitted, unless required by the Vendor.
- 4) The Purchaser acknowledges reading and accepting document which contains other miscellaneous disclaimers.
- 5) In the event of a conflict between the Standard Features schedule of the Agreement of Purchase and Sale and the Interior Colour Scheme, the Interior Colour Scheme shall prevail.

Signature: Date: Date:		A Co	1. 1 1272	
	Signature:		Date: Date: Signature:	Date:

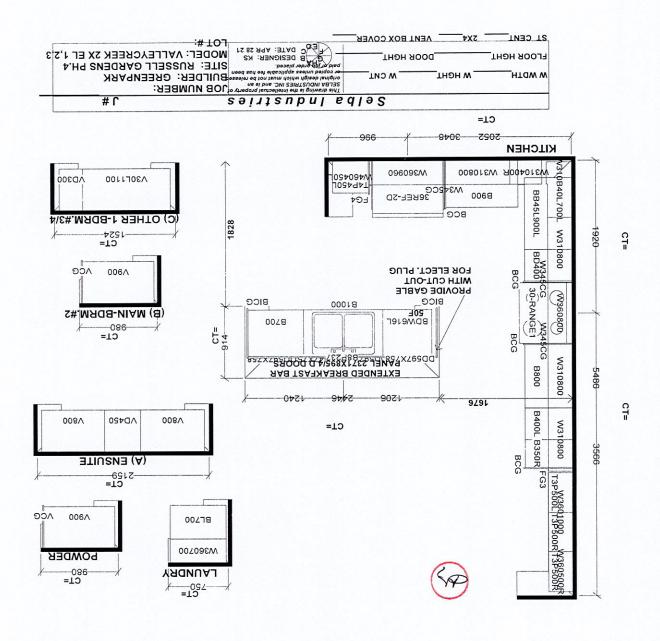



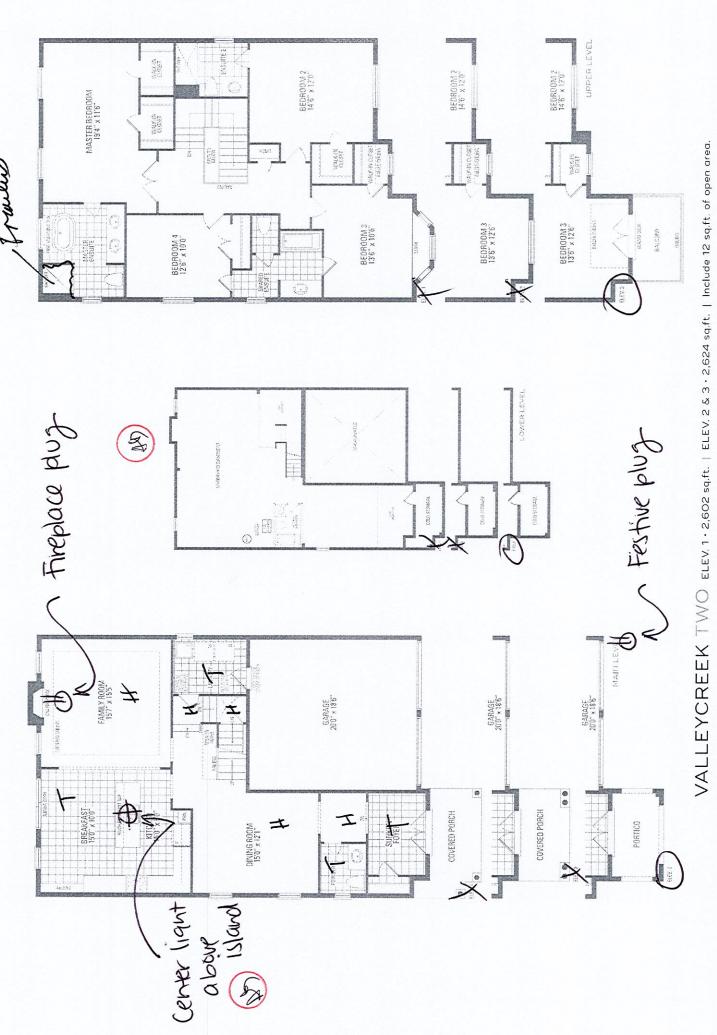

Bremation of forms may be recented and purmissor agrees to sorigin since. Steps and no rices may virus at any extence certained converted which may be recently for the production of the proof of the properties of the properties of the proof of the proo