


Jussell

Gardens

zenpark
GROUP

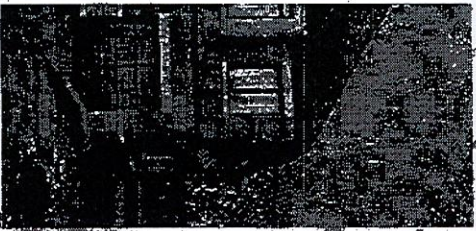

Was Line for BPO

Soap Dispenser

Shad plug
about
third day

-Hose Bib
Location, ○

Ada Plug,
S.E. Park
#1001

Delete wall
Frameless
Shower door
1 Panel

Peacock
Sta Light
Oahu Island

248.1 Microfilm

Page

Revised
See
Station

Tiles
45 degree

admitt

GRANDVILLE THREE ELEV. 1 • 4,597 sq.ft. | ELEV. 2 • 4,605 sq.ft. | ELEV. 3 • 4,596 sq.ft. | Include 17 sq.ft. of open area.

- Smooth ceilings

Shower
in new
of tub

Std
Light

- 4 Enlarged Basement Windows
- Walk-Out
- 2000 sqft

• 10. Getting

Chad Light

Shower
in lieu
of tub

Shad
Light

— Soda Light ✓