

*SELBA = CONST.
(REVISION) SKETCH INDICATING LOCATION OF PIE CUT

CONSTRUCTION SUMMARY - PARTIAL ONLY

Mountainview Heights 3 (G) - Russell Gardens Building Ltd.

WITH LAZY SUSAN RECEIVED

PURCHASER: Venugopal Reddy CHUKKALURI

OCT - 4 2022

TEL:

LOT NUMBER	PHASE	HOUSE TYPE	REG. PLAN #		
361	4	Springfield Three (4 Bed with Guest Suite) Elev 3	62M-1266		

INV#	QTY	EXTRA / CHANGE
------	-----	----------------

CABINETRY ACCESSORIES

26,556 10Feb22	1 - KITCHEN CABINETRY - BUILT-IN MICROWAVE/OVEN COMBO - UPGRADE 2 Note:
26,556 10Feb22	1 - KITCHEN CABINETRY BASE - PIE CUT CORNER CABINET WITH LAZY SUSAN (WHITE POLYMER) - UPGRADE 2 Note: AT CORNER CLOSEST TO B/I OVEN TOWER ***SEE SKETCH
26,556 10Feb22	1 - KITCHEN CABINETRY BASE - PULLOUT RECYCLE 2 BIN - PRICE IS EACH Note:
26,556 10Feb22	1 - KITCHEN HOOD CABINETS - TRANSITIONAL WOOD HOOD (DHB) 800-1000 WIDE - UPGRADE 2 Note:
26,556 10Feb22	2 - CABINETRY DECORATIVE ITEMS - POSTS - TALL POSTS (80 WIDE) - PRICE IS EACH - (NOT AV. IN STANDARD LINE) Note:
26,556 10Feb22	2 - CABINETRY DECORATIVE ITEMS - POSTS - BASE POSTS (80 WIDE) - PRICE IS EACH - (NOT AV. IN STANDARD LINE) Note:
26,556 10Feb22	2 - KITCHEN CABINETRY UPPER - GLASS DOOR - GLK340 CORD GLASS - FINISHED INTERIOR - FITS TALL UPPER CABINETS ONLY - PRICE IS PER DOOR - UPGRADE 2 Note:
26,556 10Feb22	6 - KITCHEN CABINETRY ACCESSORY - GLASS SHELVES - STRAIGHT - PRICE IS EACH Note:
26,556 10Feb22	1 - KITCHEN CABINETRY BASE - PIE CUT CORNER CABINET - BASE CABINETRY - UPGRADE 2 Note:
26,556 10Feb22	2 - KITCHEN CABINETRY UPPER - ANGLED CORNER CABINET - FITS TALL UPPER CABINETS - PER UNIT - UPGRADE 2 Note:
26,556 10Feb22	1 - KITCHEN CABINETRY BASE - POT/PAN DRAWERS (CABINET) - UPGRADE 2 Note:
26,556 10Feb22	1 - CABINETRY FEE FOR FLUSH CUTOUT ON WALL OVEN/MICROWAVE COMBO CABINET ONLY Note:
26,556 10Feb22	2 - CABINETRY DECORATIVE ITEMS - POSTS - LARGE BASE POSTS - KITCHEN ISLAND Note:


This Document is Extremely Time Sensitive - Printed 3 Oct 22 at 16:00

FILE NAME:
RUSSELL GARDENS LOT 361 PH4

RUSSELL GARDENS LOT 361 PH4
PROTOTYPE FOR EXTRAS

FEB 24 22 FO
REV MAR 10 22 PB

THIS LAYOUT CONTAINS EXTRAS
THAT ARE NOT PART OF CONTRACT

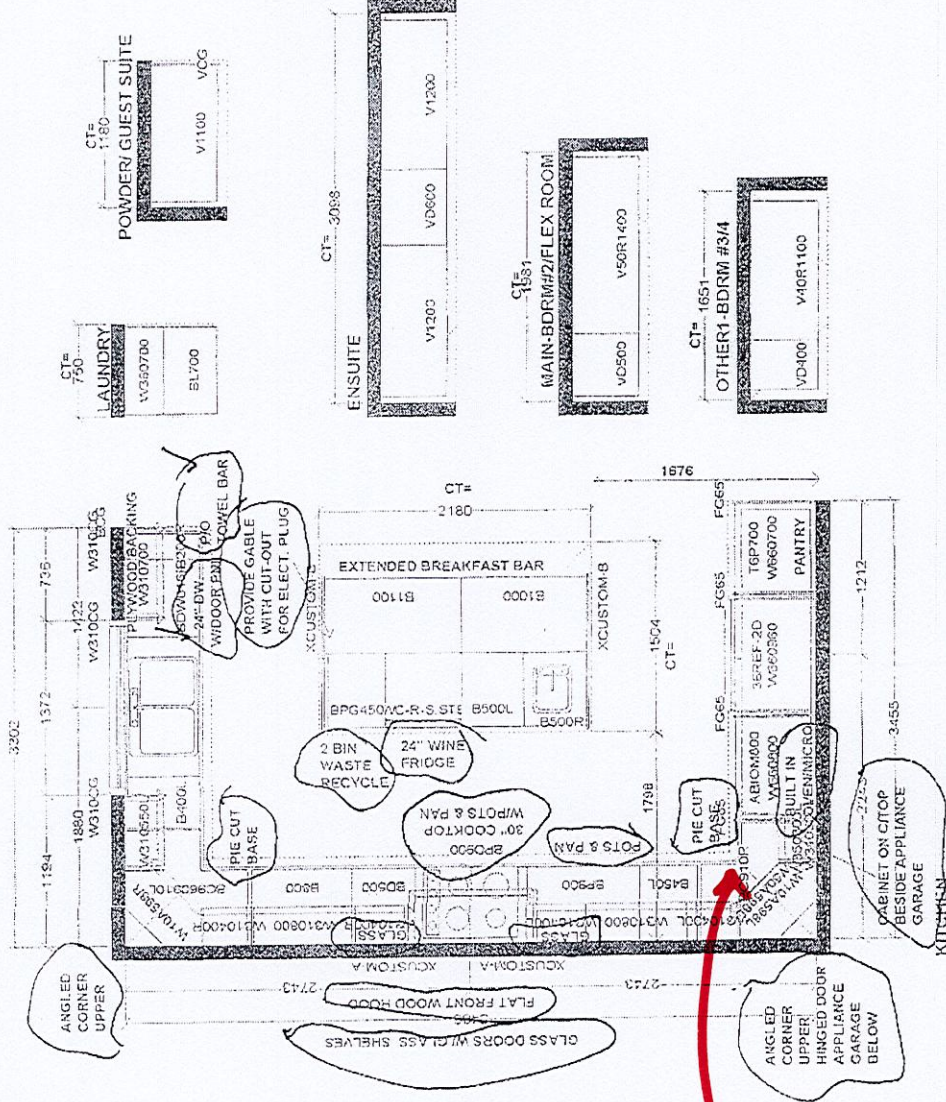

Base Pie
with Lazy
Susan

Selba Industries		J#	
W WIDTH _____ W RIGHT _____ W CENT _____ FLOOR RIGHT _____ DOOR RIGHT _____ ST CENT _____ 2X4 _____ VENT BOX COVER _____		JOB NUMBER: _____ BUILDER: GREENPARK SITE: RUSSELL GARDENS PH 4 MODEL: SPRINGFIELD 3X 465 BD OPT GR FLR EL 1.33 LOT # 361 DESIGNER: LQ DATE: APR 21 81	

01

CUT

ADDED
CORNER
UPPER

APPLIANCE GARAGE
W/ HINGED DOOR

ADDITIONAL CABINET
TO REST ON
STOP

BUILT IN

OVEN / MICRO

36"
REF

PANTRY

24" DEEP

3/4" CUT BASE
with Lazy Susan

This drawing is the intellectual property of
SELBA INDUSTRIES INC. and is an
artistic
interpretation of the general
appearance of the design. It is
not meant to be an exact rendition.

2022
TECHNOLOGIES

Designed: 2/23/2022
Printed: 2/23/2022

RUSSELL GARDENS LOT 361 PH4

LAYOUT

Drawing #: 1

361 Russell Gardens
Phase 4
Oct 3/22

UVC9360SLSS


Universal Custom Hood Insert

DIMENSIONS AND INSTALLATION INFORMATION (IN INCHES)

Installation Information: Before installing, consult installation instructions, packed with product, for current dimensional data.

Accessories:
UXCF9J – Charcoal Filter
UXN70 – Recirculation Kit

AMP RATING	
120V	3.0

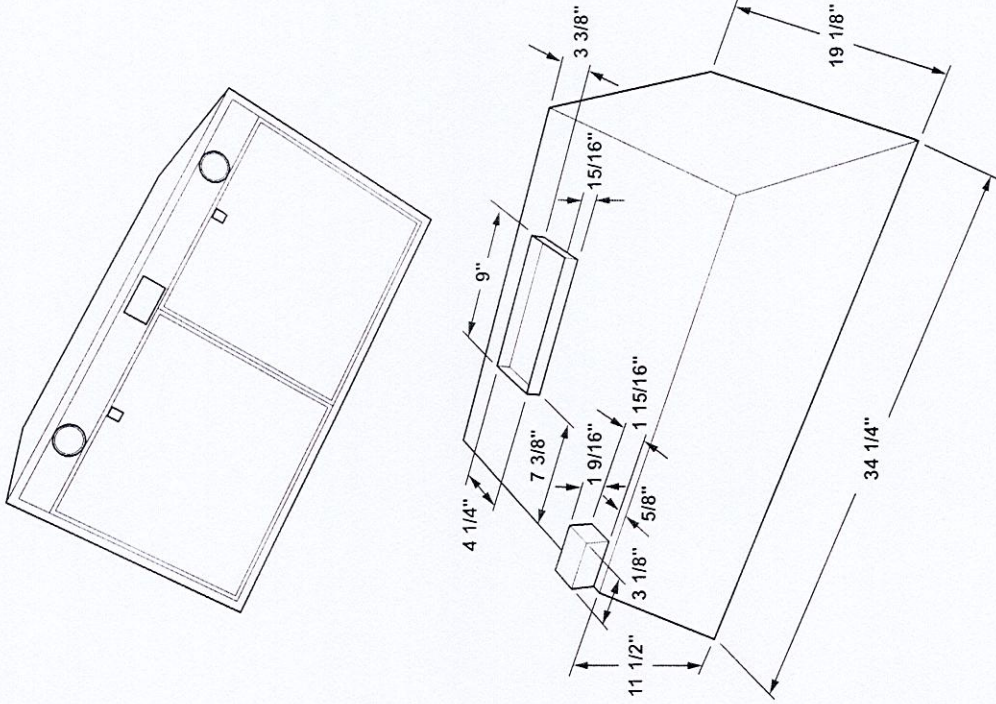

For answers to your Monogram, GE Café™ Series, GE Profile™ Series or GE Appliances product questions, visit our website at geappliances.com or call GE Answer Center® Service, 800.626.2000.

361 Russell Gardens
Phase 4 - Oct. 3/22

UVC9360SLSS

Universal Custom Hood Insert

FEATURES AND BENEFITS

- Adjustable CFM blower – High powered 610 CFM blower adjustable downward to either 370 or 290 maximum CFM to accommodate different installation needs
 - Triple LED dimmable lighting - bulbs included – LED modules ensure bright lighting for the entire cooking environment
 - Premium Baffle Stainless Steel Filters – removes odors and grease from your cooking area and easy to clean in your dishwasher
 - WiFi Connect – Control appliances with a smart device or just the sound of your voice
 - Electronic backlit controls – Add a sophisticated look with this up-front, easy-to-use display
 - Chef Connect – Automatically control the hood's lights and fan by syncing with the range
 - Remote control included – Activate and adjust your hood functions from anywhere in the kitchen
 - Four-speed fan control – Helps draw smoke, grease, odors and moisture out of the kitchen air
- Model UVC9360SLSS – Stainless steel

