



ADD Plug →
ABOVE
FIRE PLACE


ADD LIGHT
IN LIVING ROOM

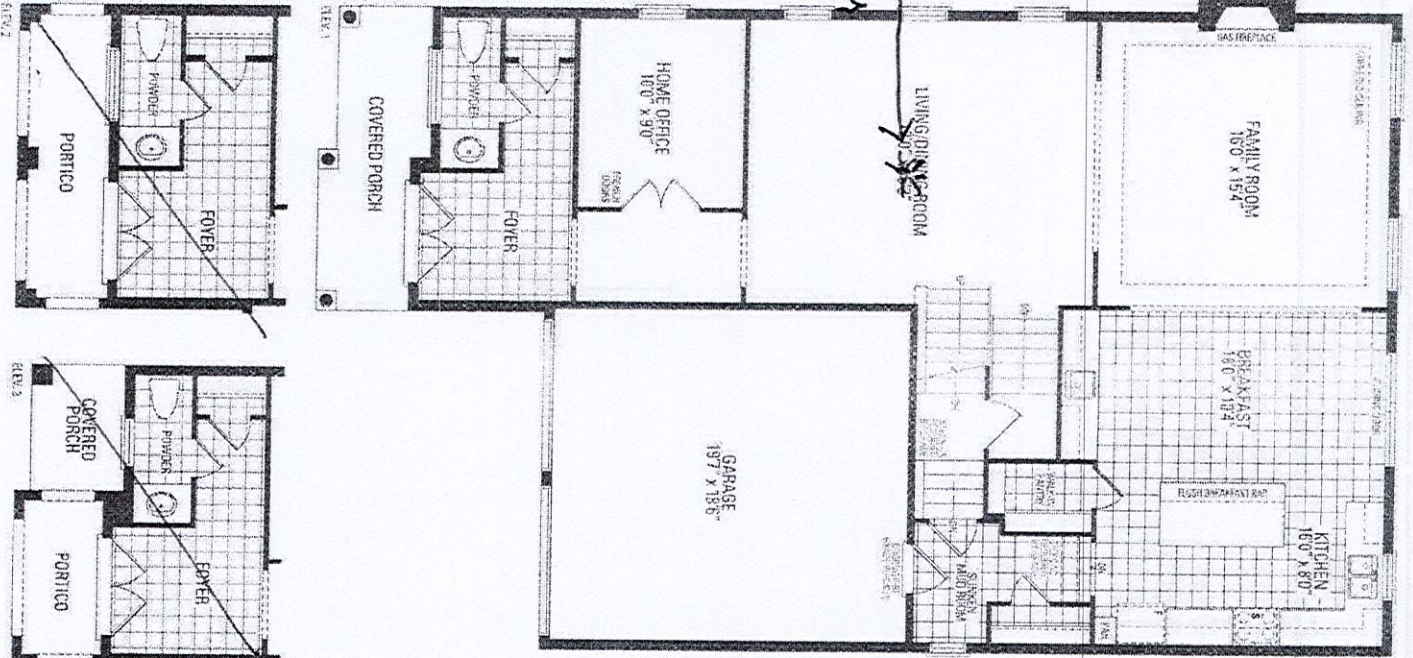

MAIN LEVEL

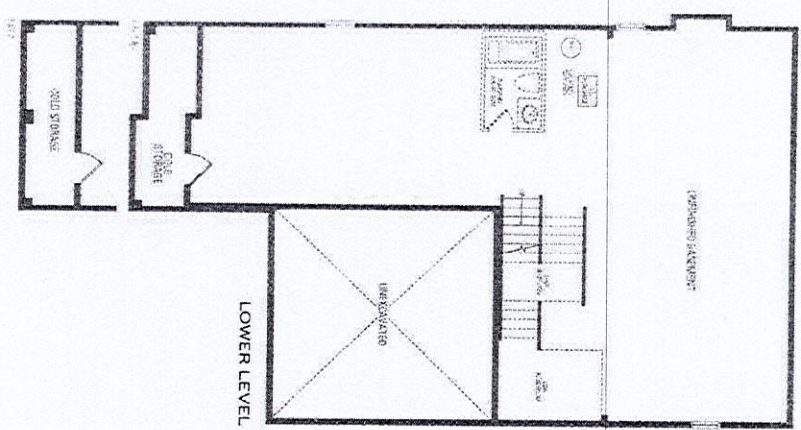

TUB
TO
SHOWER

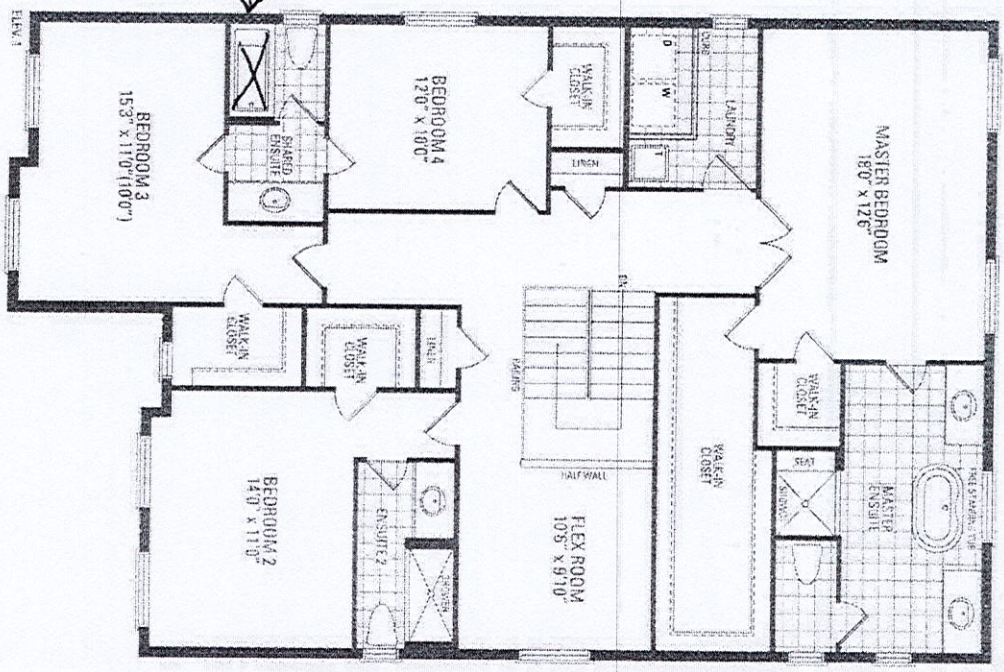

UPPER LEVEL

