

CONSTRUCTION SUMMARY
Red Oaks - Roundel Homes Inc.

PURCHASER: Yong Zhen FENG TEL: RES.: 647-338-9006

LOT / PHASE 166 / 1	REG. PLAN # 65M-4737	HOUSE TYPE Glenrowan 1 Elev 3		
------------------------	-------------------------	----------------------------------	--	--

ELECTRICAL

1 - RELOCATE STANDARD KITCHEN LIGHT TO BE CENTERED OVER ISLAND 15Nov22 Note:	
1 - ELECTRIC VEHICLE ROUGH-IN PROVISION ONLY FOR FUTURE ELECTRIC CAR (CONDUIT FROM BASEMENT INTO JUNCTION BOX IN GARAGE WITH PULL STRING, NO WIRE) 15Nov22 Note: SEE SKETCH FOR LOCATION - IF CONSTRUCTION PERMITS	

PLUMBING

2 - HOSE BIB - EXTERIOR FROST FREE 15Nov22 Note: 1 @ EXTERIOR 1 @ GARAGE	
1 - TUB TO SHOWER CONVERSION - 5 FOOT SHOWER WITH SLIDING GLASS CHROME DOORS IN LIEU OF TUB 15Nov22 Note: ENSUITE 3/4	

PROMOTIONAL

1 - LESS CREDIT FROM PURCHASER EXTRA SHEET IN OFFER 15Nov22 Note: NEW PROMO BALANCE \$5,785.00	
---	--

This Document is Extremely Time Sensitive - Printed 16 Nov 22 at 13:18

Glenrowan¹



ELEV. 3 • 2,624 sq.ft.

Includes 12 sq.ft. of open area.

991-166

Relocate Std.
Kitchen light to
be centered over
island

Electric
Vehicle
Rough-in
(conduit)

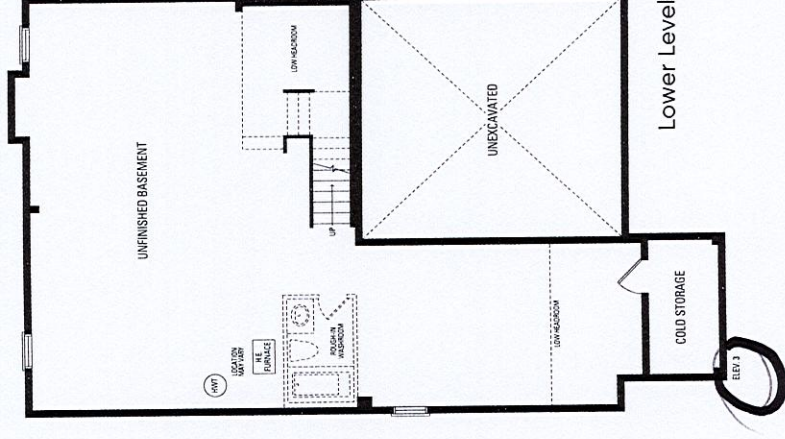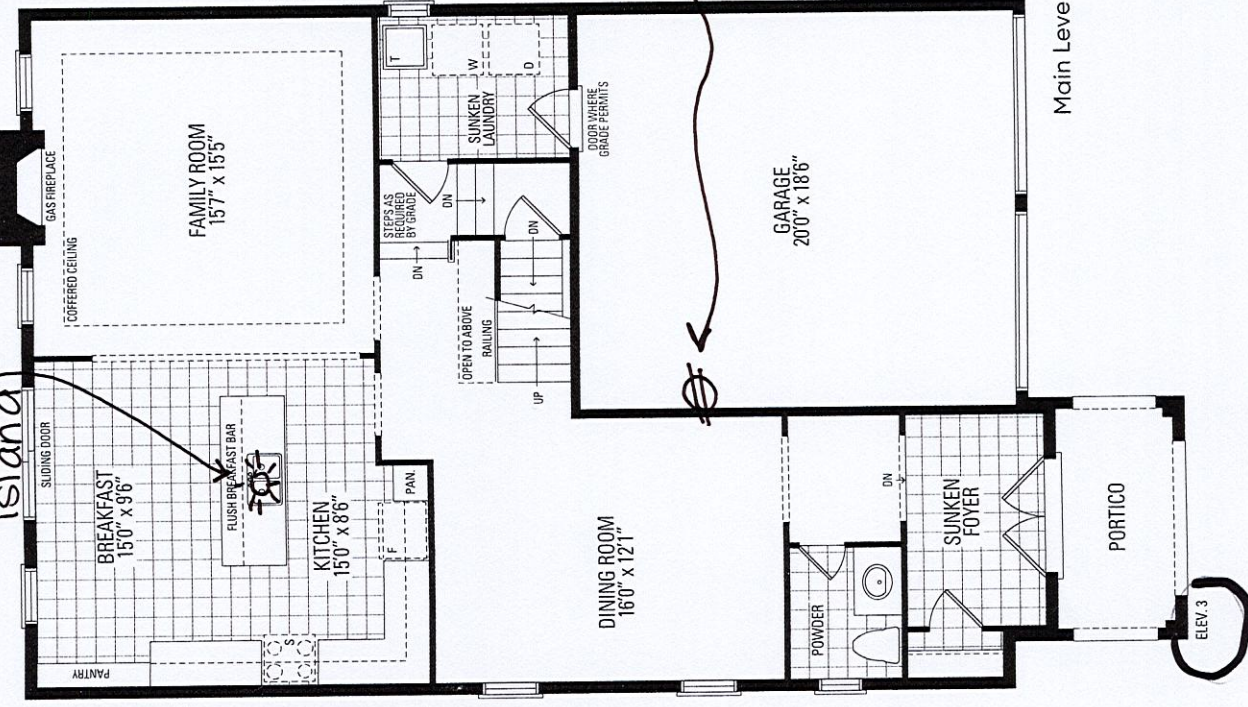

convert -
tub to -
snow

