

ROOM USE	FAM	LV/DN	KIT	LIB	LAUN	W/R	FOY	MUD			WOD	BAS
EXP. WALL	36	30	37	19	12	18	18	30			47	182
CLG. HT.	10	10	10	10	9	10	10	11			8	8
GRS.WALL AREA	360	300	370	190	108	180	180	330			376	1119
GLAZING	LOSS GAIN	LOSS GAIN	LOSS GAIN	LOSS GAIN	LOSS GAIN	LOSS GAIN	LOSS GAIN	LOSS GAIN			LOSS GAIN	LOSS GAIN
NORTH	21.8 14.9	0 0 0	0 0 0	0 0 0	0 0 0	0 0 0	0 0 0	7 152 105			0 0 0	4 87 60
EAST	21.8 38.4	0 0 0	0 0 0	0 0 0	0 0 0	22 479 845	6 131 230	0 0 0			0 0 0	0 0 0
SOUTH	21.8 23.1	0 0 0	42 915 971	0 0 0	14 305 324	7 152 162	0 0 0	0 0 0			0 0 0	8 174 185
WEST	21.8 38.4	28 610 1075	0 0 0	51 1111 1958	0 0 0	0 0 0	0 0 0	0 0 0			0 0 0	0 0 0
SKYL.T.	38.1 101.5	0 0 0	0 0 0	0 0 0	0 0 0	0 0 0	0 0 0	0 0 0			14 305 537	0 0 0
DOORS	25.8 4.3	0 0 0	0 0 0	10 258 43	0 0 0	0 0 0	40 1034 170	0 0 0			0 0 0	0 0 0
NET EXPOSED WALL	4.6 0.8	332 1517 250	258 1179 194	309 1412 232	176 804 132	101 461 76	158 722 119	134 612 101	323 1476 243		0 0 0	0 0 0
NET EXPOSED BSMT WALL ABOVE GR	3.7 0.6	0 0 0	0 0 0	0 0 0	0 0 0	0 0 0	0 0 0	0 0 0	0 0 0		268 987 162	338 1243 205
EXPOSED CLG	1.3 0.6	0 0 0	0 0 0	0 0 0	0 0 0	192 252 113	0 0 0	0 0 0	0 0 0		0 0 0	0 0 0
NO ATTIC EXPOSED CLG	2.8 1.3	0 0 0	0 0 0	0 0 0	0 0 0	0 0 0	0 0 0	0 0 0	0 0 0		0 0 0	0 0 0
EXPOSED FLOOR	2.6 0.4	0 0 0	0 0 0	0 0 0	0 0 0	0 0 0	0 0 0	0 0 0	0 0 0		0 0 0	0 0 0
BASEMENT/CRAWL HEAT LOSS		0	0	0	0	0	0	0	0		0	5864
SLAB ON GRADE HEAT LOSS		0	0	0	0	0	0	0	0		0	
SUBTOTAL HT LOSS		2127	2094	2781	1109	866	1201	1777	1628		1292	7885
SUB TOTAL HT GAIN		1324	1165	2233	456	351	963	501	347		700	534
LEVEL FACTOR / MULTIPLIER	0.30 0.51	0.30 0.51	0.30 0.51	0.30 0.51	0.30 0.51	0.20 0.27	0.30 0.51	0.30 0.51	0.30 0.51		0.50	1.17
AIR CHANGE HEAT LOSS	1081	1064	1414	564	237	611	903	828				10775
AIR CHANGE HEAT GAIN		90	173	35	27	75	39	27				95
DUCT LOSS	0	0	0	0	0	0	0	0				0
DUCT GAIN		0	0	0	0	0	0	0				0
HEAT GAIN PEOPLE	240	0	0	0	0	0	0	0	0		0	0
HEAT GAIN APPLIANCES/LIGHTS		584	564	564	564	564	0	0			0	564
TOTAL HT LOSS BTU/H	3208	3158	4195	1673	1103	1812	2680	2456			1292	18661
TOTAL HT GAIN x 1.3 BTU/H	2589	2366	3861	1372	1225	1349	702	487			910	1553

RECEIVED
 09/12/2022
 BUILDING DIVISION
 CHASE RICHMOND HILL

Per:maddy.toalaalejandro

TOTAL HEAT GAIN BTU/H:	36997	TONS: 3.08	LOSS DUE TO VENTILATION LOAD BTU/H: 2004	STRUCTURAL HEAT LOSS: 59884	TOTAL COMBINED HEAT LOSS BTU/H: 61888
------------------------	-------	------------	--	-----------------------------	---------------------------------------

SITE NAME: ROUNDEL HOMES INC
BUILDER: GREENPARK HOMES

OPT 2ND
TYPE: TERRACOTA 2

DATE: May-21

GFA: 3389 LO# 90742

HEATING CFM 1122 COOLING CFM 1122
TOTAL HEAT LOSS 59,884 TOTAL HEAT GAIN 36,667
AIR FLOW RATE CFM 18.74 AIR FLOW RATE CFM 30.6

furnace pressure 0.6
furnace filter 0.05
a/c coil pressure 0.2
available pressure for s/a & r/a 0.35

#GOODMAN
GMEC960803BNA 80

AFUE = 96 %
INPUT (BTU/H) = 80,000
OUTPUT (BTU/H) = 76,800

RUN COUNT	4th	3rd	2nd	1st	Bas
S/A	0	0	15	8	4
R/A	0	0	6	2	1

plenum pressure s/a 0.18 r/a pressure 0.17
max s/a dif press. loss 0.02 r/a grille press. Loss 0.02
min adjusted pressure s/a 0.16 adjusted pressure r/a 0.15

FAN SPEED LOW
MEDLOW
MEDIUM 885
MEDIUM HIGH 1005
HIGH 1122

DESIGN CFM = 1122
CFM @ .6" E.S.P.

TEMPERATURE RISE 63 °F

All S/A diffusers 4"x10" unless noted otherwise on layout.
All S/A runs 5"Ø unless noted otherwise on layout.

RUN #	1	2	3	4	5	6	7	8	9	10	11	12	13	14	15	16	17	18	19	20	21	22	23	24
ROOM NAME	MBR	ENS	WIC	BED-3	BED-4	BED-5	ENS-4/5	BED-2	WIC-3	MBR	ENS-2/3	FAM	LV/DN	KIT	KIT	LIB	LAUN	W/R	FOY	MUD	BAS	BAS	BAS	BAS
RM LOSS MBH.	1.64	2.26	0.60	2.30	1.90	1.31	0.60	1.60	0.73	1.64	0.44	3.21	3.16	2.10	2.10	1.67	1.10	1.81	2.68	2.46	4.99	4.99	4.99	4.99
CFM PER RUN HEAT	31	42	11	43	36	24	11	30	14	31	8	60	59	39	39	31	21	34	50	46	93	93	93	93
RM GAIN MBH.	1.85	1.40	0.18	2.63	2.40	1.82	0.34	1.79	0.64	1.85	0.16	2.59	2.37	1.93	1.93	1.37	1.22	1.35	0.70	0.49	0.62	0.62	0.62	0.62
CFM PER RUN COOLING	57	43	6	80	74	56	10	55	19	57	5	79	72	59	59	42	37	41	21	15	19	19	19	19
ADJUSTED PRESSURE	0.17	0.17	0.17	0.17	0.17	0.17	0.17	0.17	0.17	0.17	0.17	0.17	0.17	0.17	0.17	0.17	0.17	0.17	0.17	0.17	0.16	0.16	0.16	0.16
ACTUAL DUCT LGH.	37	56	39	59	56	34	34	51	45	39	39	22	10	40	31	27	20	33	41	44	38	19	5	31
EQUIVALENT LENGTH	190	160	150	130	170	200	220	160	110	130	150	140	130	150	160	140	180	110	90	140	140	120	140	130
TOTAL EFFECTIVE LENGTH	227	216	189	189	226	234	254	211	155	169	189	162	140	190	191	167	200	143	131	184	178	139	145	161
ADJUSTED PRESSURE	0.08	0.08	0.09	0.09	0.08	0.07	0.07	0.08	0.11	0.1	0.09	0.11	0.12	0.09	0.09	0.1	0.09	0.12	0.13	0.09	0.09	0.12	0.11	0.1
ROUND DUCT SIZE	5	5	4	6	6	6	4	6	4	5	4	5	5	5	5	4	4	4	4	4	6	6	6	6
HEATING VELOCITY (ft/min)	228	308	126	219	184	122	126	153	161	228	92	441	433	286	286	356	241	390	574	528	474	474	474	474
COOLING VELOCITY (ft/min)	419	316	69	408	377	286	115	280	218	419	57	580	529	433	433	482	424	470	241	172	97	97	97	97
OUTLET GRILL SIZE	3X10	3X10	3X10	4X10	4X10	4X10	3X10	4X10	3X10	3X10	3X10	3X10	3X10	3X10	3X10	3X10	3X10	3X10	3X10	3X10	4X10	4X10	4X10	4X10
TRUNK	B	A	B	D	C	C	C	A	D	B	D	B	D	A	A	C	B	C	C	A	A	B	D	C

RUN #	25	26	27
ROOM NAME	BED-3	BED-4	ENS-2/3
RM LOSS MBH.	2.30	1.90	0.44
CFM PER RUN HEAT	43	36	8
RM GAIN MBH.	2.63	2.40	0.16
CFM PER RUN COOLING	80	74	5
ADJUSTED PRESSURE	0.17	0.17	0.17
ACTUAL DUCT LGH.	52	48	36
EQUIVALENT LENGTH	120	170	140
TOTAL EFFECTIVE LENGTH	172	218	176
ADJUSTED PRESSURE	0.1	0.08	0.1
ROUND DUCT SIZE	6	6	4
HEATING VELOCITY (ft/min)	219	184	92
COOLING VELOCITY (ft/min)	408	377	57
OUTLET GRILL SIZE	4X10	4X10	3X10
TRUNK	D	C	D

Initials:

PXV

HVAC REVIEWED
City of Richmond Hill
Building Division

SUPPLY AIR TRUNK SIZE

	TRUNK CFM	STATIC PRESS.	ROUND DUCT	RECT DUCT	VELOCITY (ft/min)		TRUNK CFM	STATIC PRESS.	ROUND DUCT	RECT DUCT	VELOCITY (ft/min)
TRUNK A	289	0.08	8.8	10	x	8	520				
TRUNK B	536	0.08	11.1	14	x	8	689				
TRUNK C	315	0.07	9.4	10	x	8	567				
TRUNK D	583	0.07	11.8	16	x	8	656				
TRUNK E	0	0.00	0	0	x	8	0				
TRUNK F	0	0.00	0	0	x	8	0				
TRUNK G	0	0.00	0	0							
TRUNK H	0	0.00	0	0							
TRUNK I	0	0.00	0	0							
TRUNK J	0	0.00	0	0							
TRUNK K	0	0.00	0	0							
TRUNK L	0	0.00	0	0							

RETURN AIR TRUNK SIZE

	TRUNK CFM	STATIC PRESS.	ROUND DUCT	RECT DUCT	VELOCITY (ft/min)
TRUNK O	0	0.05	0	0	0
TRUNK P	0	0.05	0	0	0
TRUNK Q	0	0.05	0	0	0
TRUNK R	0	0.05	0	0	0
TRUNK S	0	0.05	0	0	0
TRUNK T	0	0.05	0	0	0
TRUNK U	0	0.05	0	0	0
TRUNK V	0	0.05	0	0	0
TRUNK W	0	0.05	0	0	0
TRUNK X	1032	0.05	16	20	619
TRUNK Y	695	0.05	13.8	16	569
TRUNK Z	445	0.05	11.6	16	501
DROP	1122	0.05	16.5	24	673

RETURN AIR #	1	2	3	4	5	6	7	8	9	10	11	12	13	14	15	16	17	18	19	20	21	22	23	24
AIR VOLUME	90	85	90	90	85	75	360	85	0	0	0	0	0	0	0	0	0	0	0	0	0	0	0	0
PLENUM PRESSURE	0.15	0.15	0.15	0.15	0.15	0.15	0.15	0.15	0.15	0.15	0.15	0.15	0.15	0.15	0.15	0.15	0.15	0.15	0.15	0.15	0.15	0.15	0.15	0.15
ACTUAL DUCT LGH.	41	52	53	58	53	59	45	41	1	1	1	1	1	1	1	1	1	1	1	1	1	1	1	1
EQUIVALENT LENGTH	185	195	165	165	215	265	165	190	0	0	0	0	0	0	0	0	0	0	0	0	0	0	0	0
TOTAL EFFECTIVE LH	226	247	218	223	268	324	210	231	1	1	1	1	1	1	1	1	1	1	1	1	1	1	1	1
ADJUSTED PRESSURE	0.07	0.06	0.07	0.07	0.06	0.05	0.07	0.06	14.80	14.80	14.80	14.80	14.80	14.80	14.80	14.80	14.80	14.80	14.80	14.80	14.80	14.80	14.80	14.80
ROUND DUCT SIZE	5.9	6	5.9	5.9	6	6	9.9	6	0	0	0	0	0	0	0	0	0	0	0	0	0	0	0	0
INLET GRILL SIZE	8	8	8	8	8	8	8	8	0	0	0	0	0	0	0	0	0	0	0	0	0	0	0	0
INLET GRILL SIZE	X	X	X	X	X	X	X	X	X	X	X	X	X	X	X	X	X	X	X	X	X	X	X	X
INLET GRILL SIZE	14	14	14	14	14	14	30	14	0	0	0	0	0	0	0	0	0	0	0	0	0	0	0	0

RECEIVED
09/22/2022
CITY OF RICHMOND HILL
BUILDING DIVISION
Per: maddy.toalalefarturo

TYPE: TERRACOTA 2
SITE NAME: ROUNDEL HOMES INC

LO # 90742

OPT-2ND

RESIDENTIAL MECHANICAL VENTILATION DESIGN SUMMARY
**CITY OF RICHMOND HILL
BUILDING DIVISION**
09/22/2022
RECEIVED
Per: maddy.toalaalejandro

COMBUSTION APPLIANCES		9.32.3.1(1)
a)	<input checked="" type="checkbox"/> Direct vent (sealed combustion) only	
b)	<input type="checkbox"/> Positive venting induced draft (except fireplaces)	
c)	<input type="checkbox"/> Natural draft, B-vent or induced draft gas fireplace	
d)	<input type="checkbox"/> Solid Fuel (including fireplaces)	
e)	<input type="checkbox"/> No Combustion Appliances	

HEATING SYSTEM	
<input checked="" type="checkbox"/> Forced Air	<input type="checkbox"/> Non Forced Air
<input type="checkbox"/> Electric Space Heat	

HOUSE TYPE		9.32.1(2)
<input checked="" type="checkbox"/> I	Type a) or b) appliance only, no solid fuel	
<input type="checkbox"/> II	Type I except with solid fuel (including fireplaces)	
<input type="checkbox"/> III	Any Type c) appliance	
<input type="checkbox"/> IV	Type I, or II with electric space heat	
<input type="checkbox"/>	Other: Type I, II or IV no forced air	

SYSTEM DESIGN OPTIONS		O.N.H.W.P.
<input type="checkbox"/> 1	Exhaust only/Forced Air System	
<input type="checkbox"/> 2	HRV with Ducting/Forced Air System	
<input checked="" type="checkbox"/> 3	HRV Simplified/connected to forced air system	
<input type="checkbox"/> 4	HRV with Ducting/non forced air system	
<input type="checkbox"/>	Part 6 Design	

TOTAL VENTILATION CAPACITY		9.32.3.3(1)
Basement + Master Bedroom	2 @ 21.2 cfm	42.4 cfm
Other Bedrooms	4 @ 10.6 cfm	42.4 cfm
Kitchen & Bathrooms	5 @ 10.6 cfm	53 cfm
Other Rooms	7 @ 10.6 cfm	74.2 cfm
Table 9.32.3.A. TOTAL		212.0 cfm

PRINCIPAL VENTILATION CAPACITY REQUIRED		9.32.3.4.(1)
1 Bedroom	31.8	cfm
2 Bedroom	47.7	cfm
3 Bedroom	63.6	cfm
4 Bedroom	79.5	cfm
5 Bedroom	95.4	cfm
TOTAL		95.4 cfm

SUPPLEMENTAL VENTILATION CAPACITY		9.32.3.5.
Total Ventilation Capacity	212	cfm
Less Principal Ventil. Capacity	95.4	cfm
Required Supplemental Capacity	116.6	cfm

PRINCIPAL EXHAUST FAN CAPACITY	
Model:	VANEE V150H
Location:	BSMT
95.4 cfm	3.0 sones
<input checked="" type="checkbox"/> HVI Approved	

PRINCIPAL EXHAUST HEAT LOSS CALCULATION			
CFM	ΔT °F	FACTOR	% LOSS
95.4 CFM	78 F	1.08	0.25

SUPPLEMENTAL FANS		PANASONIC		
Location	Model	cfm	HVI	Sones
ENS	FV-05-11VK1	50	<input checked="" type="checkbox"/>	0.3
ENS-4/5	FV-05-11VK1	50	<input checked="" type="checkbox"/>	0.3
ENS-2/3	FV-05-11VK1	50	<input checked="" type="checkbox"/>	0.3
W/R	FV-05-11VK1	50	<input checked="" type="checkbox"/>	0.3

HEAT RECOVERY VENTILATOR		9.32.3.11.
Model:	VANEE V150H	
150 cfm high	35 cfm low	
75 % Sensible Efficiency	<input checked="" type="checkbox"/> HVI Approved	
@ 32 deg F (0 deg C)		

LOCATION OF INSTALLATION	
Lot:	Concession
Township	Plan:
Address	
Roll #	Building Permit #

BUILDER:		GREENPARK HOMES
Name:		
Address:		
City:		
Telephone #:	Fax #:	

INSTALLING CONTRACTOR	
Name:	
Address:	
City:	
Telephone #:	Fax #:

DESIGNER CERTIFICATION	
I hereby certify that this ventilation system has been designed in accordance with the Ontario Building Code.	
Name:	HVAC Designs Ltd.
Signature:	<i>Michael O'Rourke</i>
HRAI #	001820
Date:	May-21

I REVIEW AND TAKE RESPONSIBILITY FOR THE DESIGN WORK AND AM QUALIFIED IN THE APPROPRIATE CATEGORY AS AN "OTHER DESIGNER" UNDER DIVISION C, 3.2.5 OF THE BUILDING CODE.

INDIVIDUAL BCIN: 19669

MICHAEL O'ROURKE

Michael O'Rourke
Initials:
PXV
HVAC REVIEWED
City of Richmond Hill Building Division

CSA F280-12 Residential Heat Loss and Heat Gain Calculations
Formula Sheet (For Air Leakage / Ventilation Calculation)

LO#: 90742

Model: TERRACOTA 2

Builder: GREENPARK HOMES

Date: 2021-05-10

Volume Calculation

House Volume			
Level	Floor Area (ft²)	Floor Height (ft)	Volume (ft³)
Bsmt	1500	8	12000
First	1500	10	15000
Second	1889	9	17001
Third	0	9	0
Fourth	0	9	0
Total:			44,001.0 ft³
Total:			1246.0 m³

Air Change & Delta T Data

WINTER NATURAL AIR CHANGE RATE	0.352
SUMMER NATURAL AIR CHANGE RATE	0.110

Design Temperature Difference				
	Tin °C	Tout °C	ΔT °C	ΔT °F
Winter DTDh	22	-21	43	78
Summer DTDc	24	31	7	13

5.2.3.1 Heat Loss due to Air Leakage

$$HL_{airb} = LR_{airh} \times \frac{V_b}{3.6} \times DTD_h \times 1.2$$

$$0.352 \times 346.10 \times 43^\circ\text{C} \times 1.2 = 6316 \text{ W}$$

$$= 21551 \text{ Btu/h}$$

6.2.6 Sensible Gain due to Air Leakage

$$HG_{salb} = LR_{airc} \times \frac{V_b}{3.6} \times DTD_c \times 1.2$$

$$= 0.110 \times 346.10 \times 7^\circ\text{C} \times 1.2 = 324 \text{ W}$$

$$= 1106 \text{ Btu/h}$$

5.2.3.2 Heat Loss due to Mechanical Ventilation

$$HL_{vairb} = PVC \times DTD_h \times 1.08 \times (1 - E)$$

$$95 \text{ CFM} \times 78^\circ\text{F} \times 1.08 \times 0.25 = 2004 \text{ Btu/h}$$

6.2.7 Sensible heat Gain due to Ventilation

$$HL_{vairb} = PVC \times DTD_h \times 1.08 \times (1 - E)$$

$$95 \text{ CFM} \times 13^\circ\text{F} \times 1.08 \times 0.25 = 330 \text{ Btu/h}$$

5.2.3.3 Calculation of Air Change Heat Loss for Each Room (Floor Multiplier Section)

$$HL_{airr} = \text{Level Factor} \times HL_{airbv} \times \{(HL_{agcr} + HL_{bgcr}) \div (HL_{agclevel} + HL_{bgclevel})\}$$

Level	Level Factor (LF)	HLairve Air Leakage + Ventilation Heat Loss (Btu/h)	Level Conductive Heat Loss: (HL _{clevel})	Air Leakage Heat Loss Multiplier (LF x HLairbv / HLlevel)
1	0.5	21,551	9,177	1.174
2	0.3		12,716	0.508
3	0.2		15,729	0.274
4	0		0	0.000
5	0		0	0.000

*HLairbv = Air leakage heat loss + ventilation heat loss

*For a balanced or supply only ventilation system HLairve = 0

CITY OF RICHMOND HILL
BUILDING DIVISION
09/22/2022
RECEIVED
Per:maddy.toalalejandro

HEAT LOSS AND GAIN SUMMARY SHEET

MODEL:	TERRACOTA 2	OPT 2ND	BUILDER: TY GREEN PARK HOMES HILL
SFQT:	3389	LO#	90742
DESIGN ASSUMPTIONS			SITE: BOUNDED HOMES INC
			09/22/2022
			RECEIVED
HEATING	°F	COOLING	°F
OUTDOOR DESIGN TEMP.	-6	OUTDOOR DESIGN TEMP.	88
INDOOR DESIGN TEMP.	72	INDOOR DESIGN TEMP. (MAX 75°F)	75

BUILDING DATA

ATTACHMENT:	DETACHED	# OF STORIES (+BASEMENT):	3
FRONT FACES:	EAST	ASSUMED (Y/N):	Y
AIR CHANGES PER HOUR:	3.57	ASSUMED (Y/N):	Y
AIR TIGHTNESS CATEGORY:	AVERAGE	ASSUMED (Y/N):	Y
WIND EXPOSURE:	SHELTERED	ASSUMED (Y/N):	Y
HOUSE VOLUME (ft³):	44001.0	ASSUMED (Y/N):	Y
INTERNAL SHADING:	BLINDS/CURTAINS	ASSUMED OCCUPANTS:	6
INTERIOR LIGHTING LOAD (Btu/h/ft²):	1.27	DC BRUSHLESS MOTOR (Y/N):	Y
FOUNDATION CONFIGURATION	BCIN_1	DEPTH BELOW GRADE:	5.5 ft
LENGTH: 54.0 ft	WIDTH: 37.0 ft	EXPOSED PERIMETER:	182.0 ft

2012 OBC - COMPLIANCE PACKAGE		Compliance Package A1	
Component		Nominal	Min. Eff.
Ceiling with Attic Space Minimum RSI (R)-Value		60	59.22
Ceiling Without Attic Space Minimum RSI (R)-Value		31	27.65
Exposed Floor Minimum RSI (R)-Value		31	29.80
Walls Above Grade Minimum RSI (R)-Value		22	17.03
Basement Walls Minimum RSI (R)-Value		20 ci	21.12
Below Grade Slab Entire surface > 600 mm below grade Minimum RSI (R)-Value		-	-
Edge of Below Grade Slab ≤ 600 mm Below Grade Minimum RSI (R)-Value		10	10
Heated Slab or Slab ≤ 600 mm below grade Minimum RSI (R)-Value		10	11.13
Windows and Sliding Glass Doors Maximum U-Value		0.28	-
Skylights Maximum U-Value		0.49	-
Space Heating Equipment Minimum AFUE		0.96	-
HRV Minimum Efficiency		75%	-
Domestic Hot Water Heater Minimum EF		0.8	-

INDIVIDUAL BCIN: 19669

MICHAEL O'ROURKE



CITY OF RICHMOND HILL
BUILDING DIVISION


08/22/2022

RECEIVED

Per:maddy.toalaalejandro

Residential Foundation Thermal Load Calculator

Supplemental tool for CAN/CSA-F280

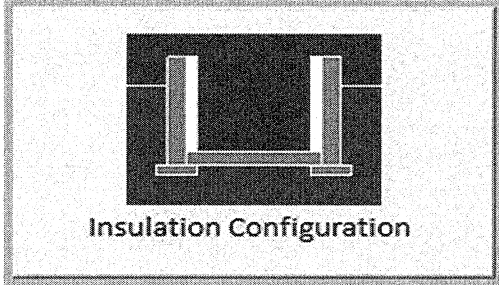Weather Station Description		
Province:	Ontario	
Region:	Richmond Hill	
Site Description		
Soil Conductivity:	Normal conductivity: dry sand, loam, clay	
Water Table:	Normal (7-10 m, 23-33 ft)	
Foundation Dimensions		
Floor Length (m):	16.5	 Insulation Configuration
Floor Width (m):	11.3	
Exposed Perimeter (m):	0.0	
Wall Height (m):	2.4	
Depth Below Grade (m):	1.68	
Window Area (m ²):	2.4	
Door Area (m ²):	1.9	
Radiant Slab		
Heated Fraction of the Slab:	0	
Fluid Temperature (°C):	33	
Design Months		
Heating Month	1	
Foundation Loads		
Heating Load (Watts):		1718

TYPE: TERRACOTA 2
LO# 90742

OPT 2ND

CITY OF RICHMOND HILL
BUILDING DIVISION

09/22/2022

RECEIVED

Per: maddy.toalaalejandro

Air Infiltration Residential Load Calculator

Supplemental tool for CAN/CSA-F280

Weather Station Description			
Province:	Ontario		
Region:	Richmond Hill		
Weather Station Location:	Open flat terrain, grass		
Anemometer height (m):	10		
Local Shielding			
Building Site:	Suburban, forest		
Walls:	Heavy		
Flue:	Heavy		
Highest Ceiling Height (m):	7.62		
Building Configuration			
Type:	Detached		
Number of Stories:	Two		
Foundation:	Full		
House Volume (m ³):	1246.0		
Air Leakage/Ventilation			
Air Tightness Type:	Present (1961-) (3.57 ACH)		
Custom BDT Data:	ELA @ 10 Pa.	1660.9 cm ²	
	3.57	ACH @ 50 Pa	
Mechanical Ventilation (L/s):	Total Supply	Total Exhaust	
	45.0	45.0	
Flue Size			
Flue #:	#1	#2	#3
Diameter (mm):	0	0	0
			#4
			0
Natural Infiltration Rates			
Heating Air Leakage Rate (ACH/H):	0.352		
Cooling Air Leakage Rate (ACH/H):	0.110		

Initials:


PXV

HVAC REVIEWED

Richmond Hill
City of Richmond Hill
Building Division

TYPE: TERRACOTA 2
LO# 90742

OPT 2ND

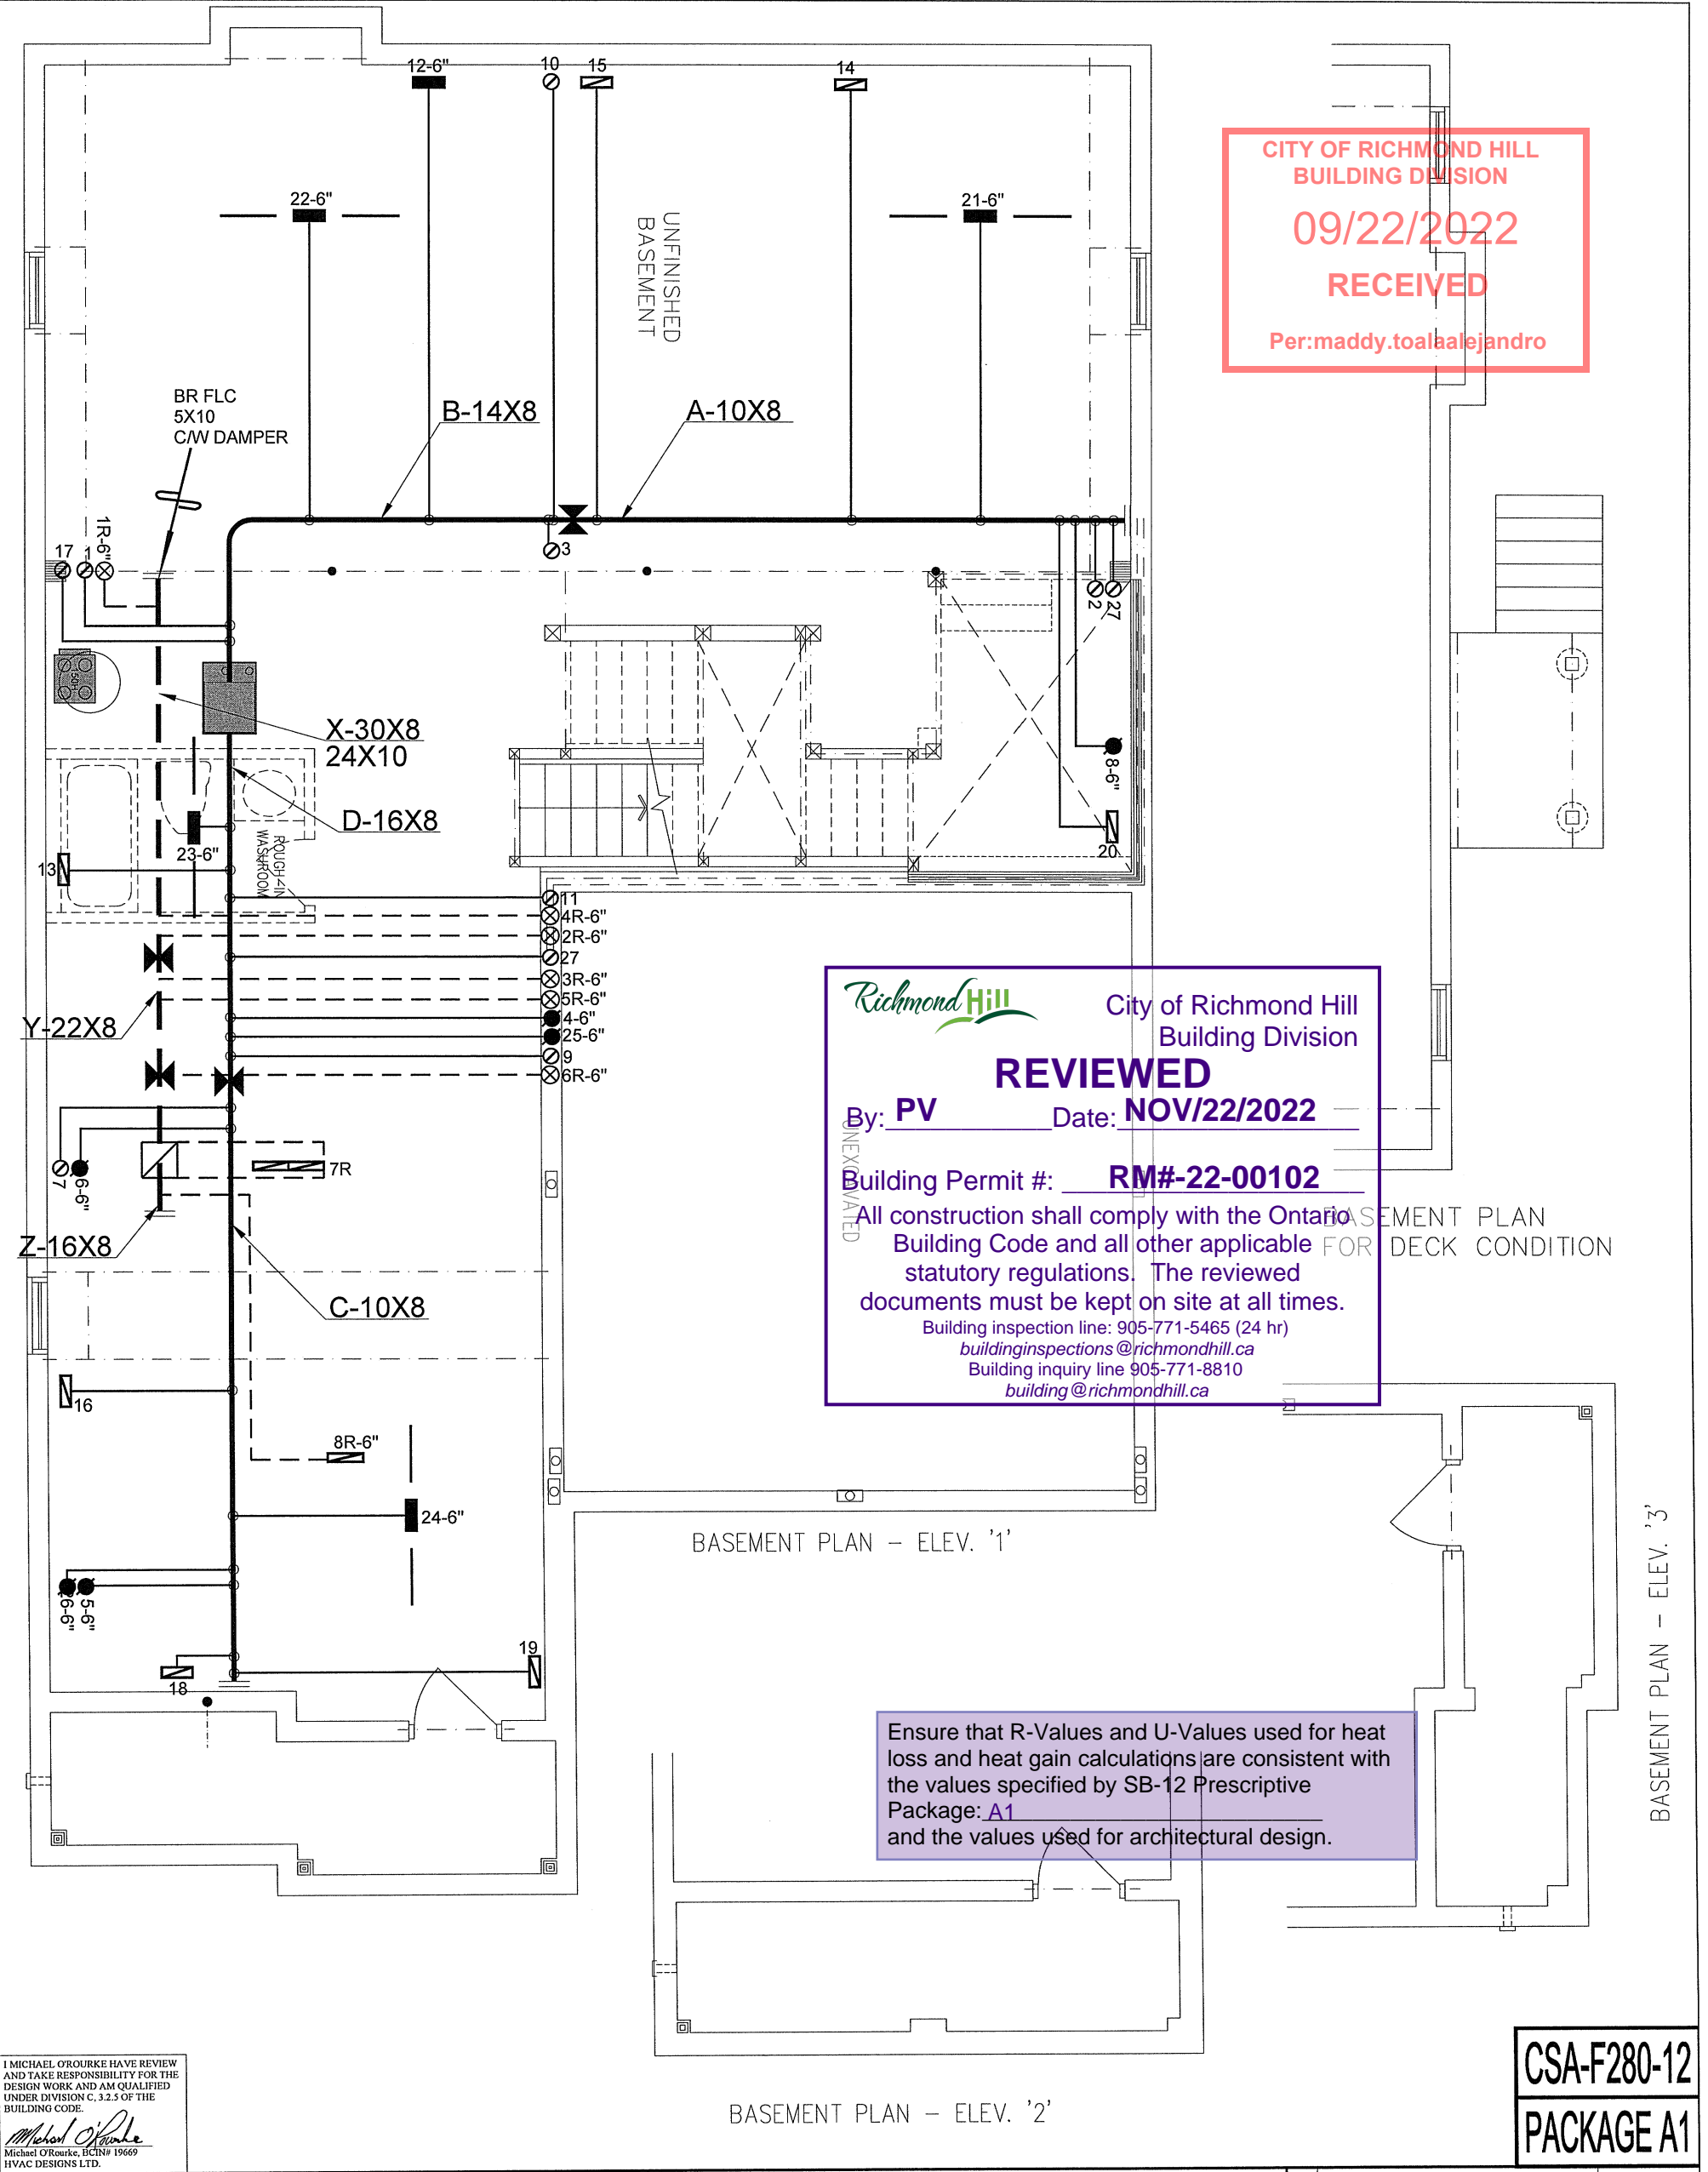


I MICHAEL O'ROURKE HAVE REVIEWED AND TAKE RESPONSIBILITY FOR THE DESIGN WORK AND AM QUALIFIED UNDER DIVISION C, 3.2.5 OF THE BUILDING CODE.

Michael O'Rourke
Michael O'Rourke, BCIN# 19669
HVAC DESIGNS LTD.

HVAC LEGEND							3.		
SYMBOL	DESCRIPTION	SYMBOL	DESCRIPTION	SYMBOL	DESCRIPTION	SYMBOL	DESCRIPTION	2.	
	SUPPLY AIR GRILLE		6" SUPPLY AIR BOOT ABOVE		14"x8" RETURN AIR GRILLE		RETURN AIR STACK ABOVE	1.	
	SUPPLY AIR GRILLE 6" BOOT		SUPPLY AIR STACK FROM 2nd FLOOR		30"x8" RETURN AIR GRILLE		RETURN AIR STACK 2nd FLOOR	No.	Description Date
	SUPPLY AIR BOOT ABOVE		6" SUPPLY AIR STACK 2nd FLOOR		FRA- FLOOR RETURN AIR GRILLE		REDUCER	REVISIONS	


ALL DRAWINGS, CALCULATIONS AND SPECIFICATIONS ARE THE PROPERTY OF HVAC DESIGNS LTD.© AND MAY NOT BE REPRODUCED, MODIFIED OR ALTERED WITHOUT EXPRESSED WRITTEN CONSENT. THE DRAWINGS ARE DATED AND USE OF THESE DRAWINGS AFTER ONE YEAR FROM THE DATED NOTED IS NOT AUTHORIZED. CONTRACTOR SHALL CHECK ALL CONDITIONS BEFORE PROCEEDING WITH WORK. LATEST MUNICIPAL APPROVED DRAWINGS ONLY TO BE USED DURING INSTALLATION OF HEATING SYSTEM. HVAC DESIGNS LTD. IS NOT LIABLE FOR ANY CLAIMS ARISING FROM UNAUTHORIZED USE OF THE DRAWINGS OR FROM ANY CHANGES TO ACCEPTED STANDARDS AND/OR THE ONTARIO BUILDING CODE.

Client		<div><div><div>HVAC</div><div>DESIGNS LTD.</div></div><div>375 Finley Ave. Suite 202 - Ajax, Ontario L1S 2E2 Tel. 905.619.2300 - 905.420.5300 Fax 905.619.2375 Email: info@hvacdesigns.ca Web: www.hvacdesigns.ca Specializing in Residential Mechanical Design Services</div><div>Installation to comply with the latest Ontario Building Code. All supply branch outlets shall be equipped with a manual balancing damper. Ductwork which passes through the garage or unheated spaces shall be adequately insulated and be gas-proofed.</div></div>	HEAT LOSS 61847 BTU/H UNIT DATA		# OF RUNS			S/A	R/A	FANS	Sheet Title		
GREENPARK HOMES			MAKE	GOODMAN		3RD FLOOR						BASEMENT HEATING LAYOUT	
Project Name			MODEL	GMEC960803BNA		2ND FLOOR			15	6	3	Date	
ROUNDEL HOMSE INC RICHMOND HILL, ONTARIO			INPUT	80	MBTU/H	1ST FLOOR			8	2	3	MAY/2021	
			OUTPUT	76.8	MBTU/H	BASEMENT			4	1	0	Scale	
			COOLING	3.0	TONS	ALL S/A DIFFUSERS 4 "x10" UNLESS NOTED OTHERWISE ON LAYOUT. ALL S/A RUNS 5"Ø UNLESS NOTED OTHERWISE ON LAYOUT. UNDERCUT DOORS 1" min. FOR R/A			3/16" = 1'-0"				
OPT 2ND TERRACOTA 2		FAN SPEED	1122	cfm @ 0.6" w.g.				BCIN# 19669				LO# 90742	
3389 sqft													

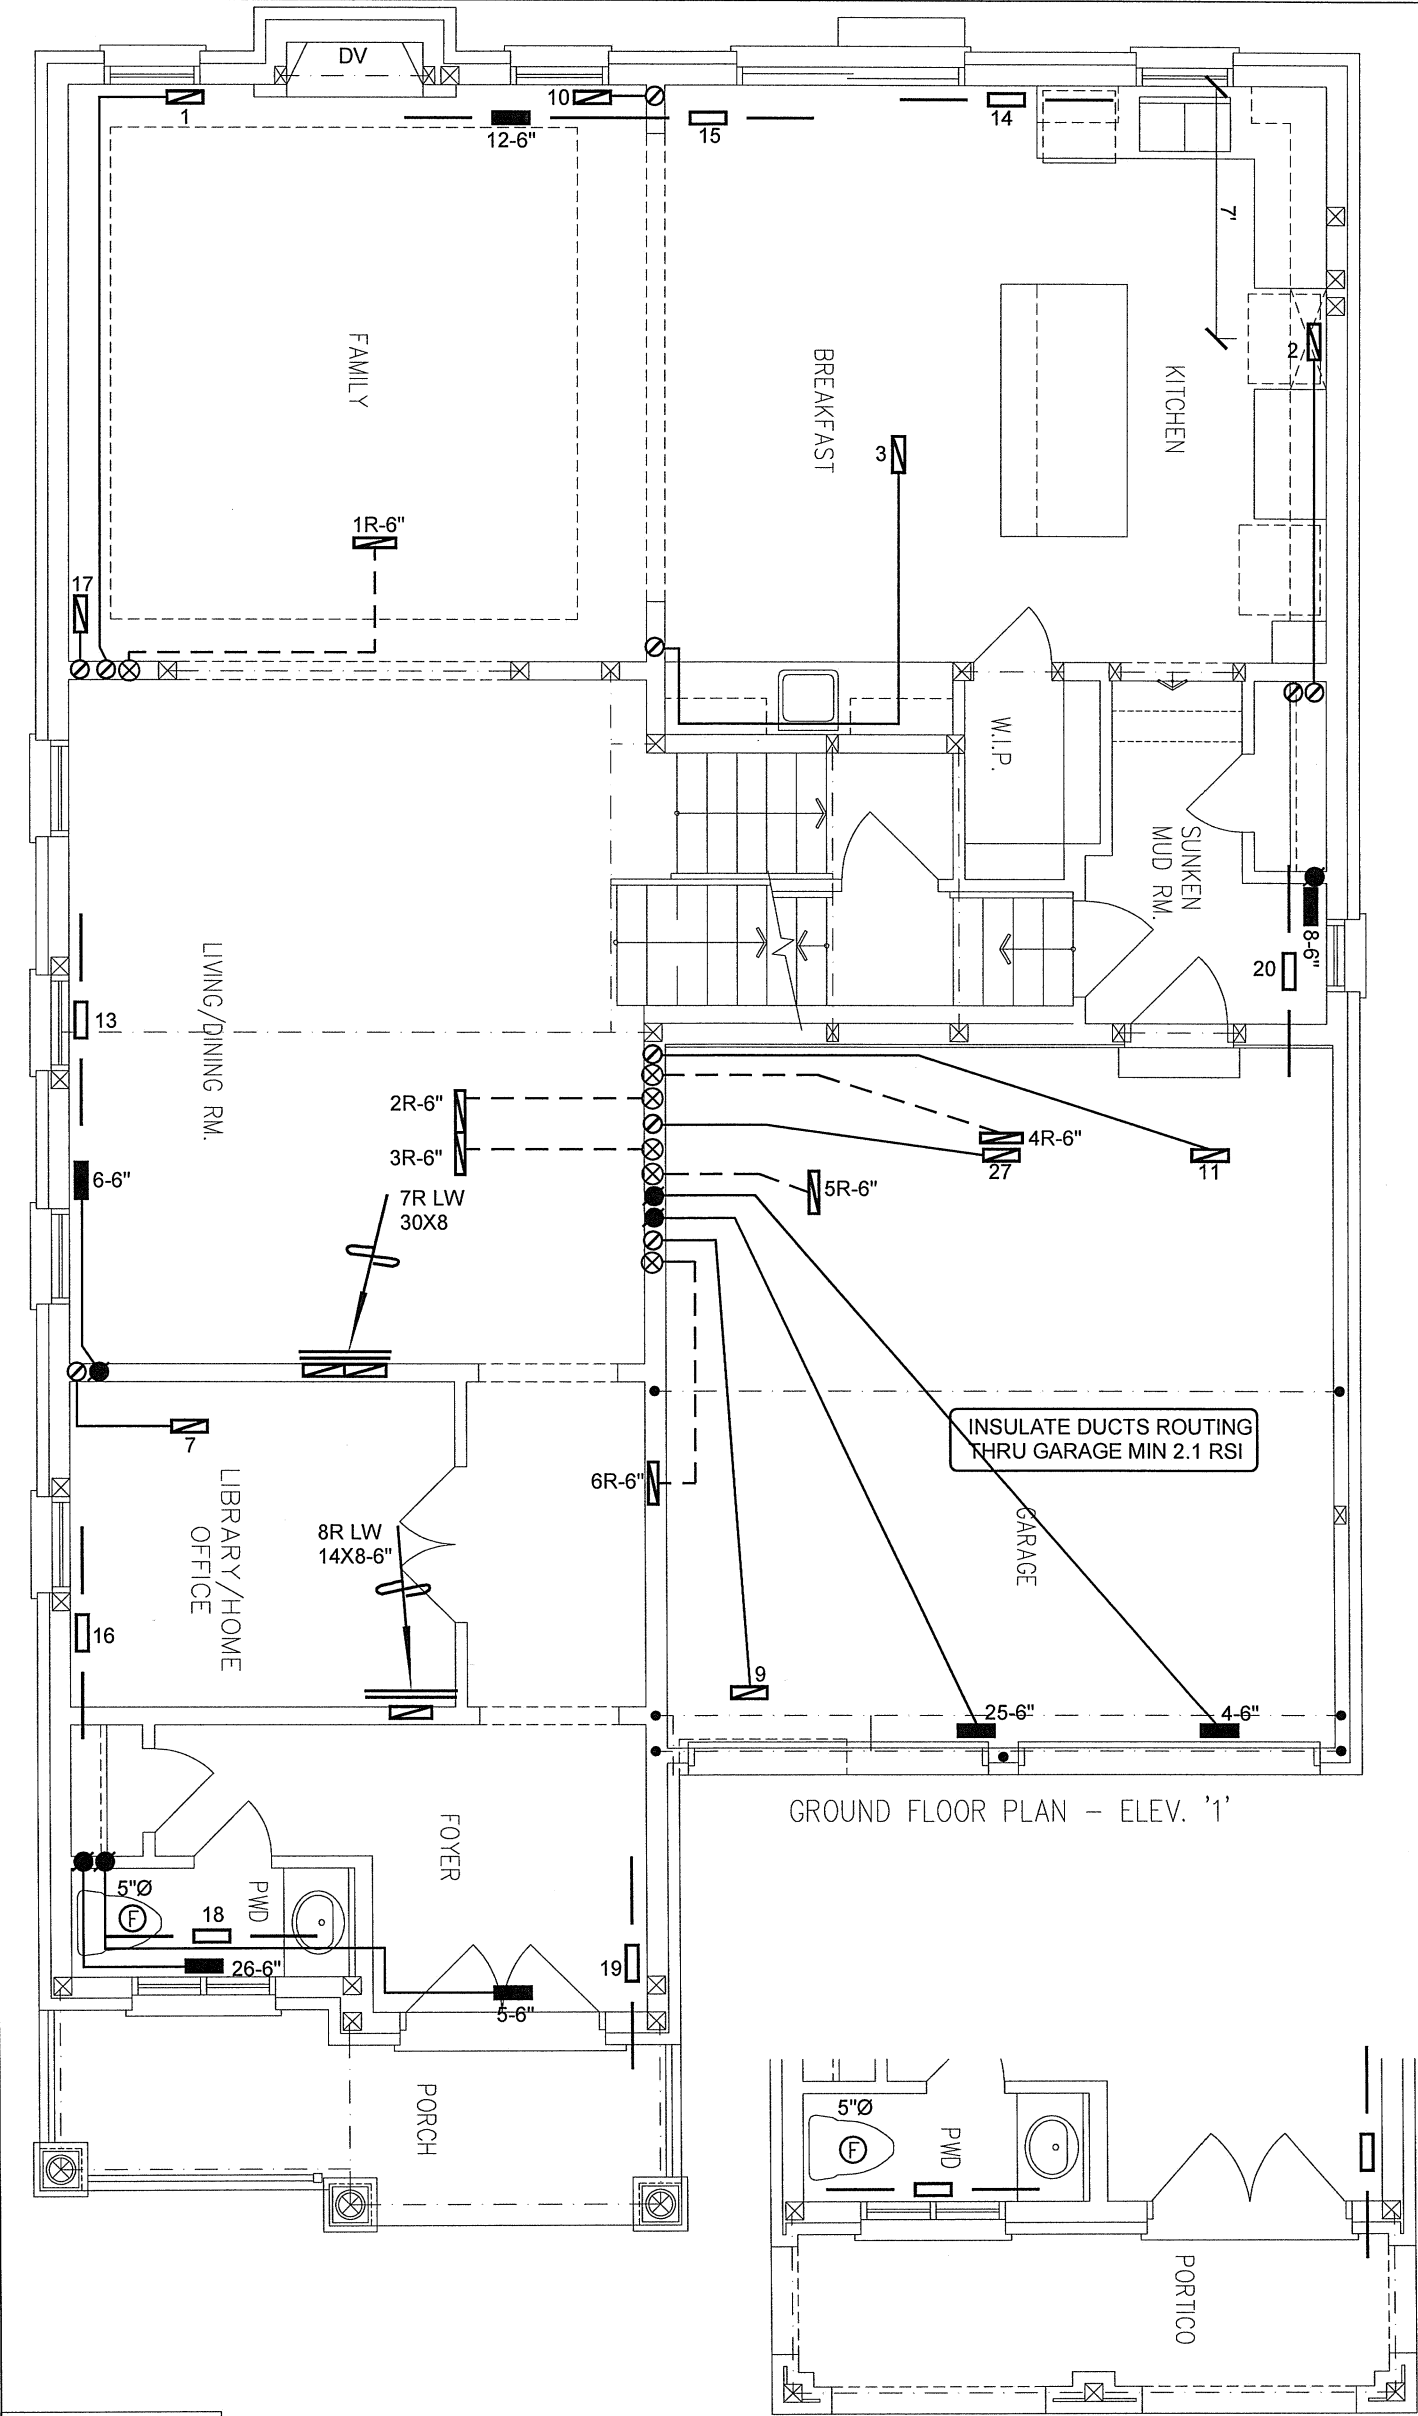

CITY OF RICHMOND HILL
BUILDING DIVISION
09/22/2022
RECEIVED
Per:maddy.toalaalejandro

- 1.Laundry dryer exhaust duct shall be provided as per OBC 2012 Div.B 6.2.3.8(7).
- 2.Kitchen hood exhaust duct shall be provided as per OBC 2012, Div.B 9.32.3.10, 9.32.3.5(2).
- 3.Minimum R-12 Insulation Value required for ducts installed at unheated or exposed condition (OBC 2012 Div.B 6.2.4.3(10) and seal the ducts as per 6.2.4.3(11) & HRAI Digest 2005, Clause 4.5.
- 4.Penetration of Air Barrier System by ducts, wires, conduits or building materials shall be sealed as per OBC 2012, Div.B 9.25.3.3.(9) & (10).
- 5.Volume control dampers to all branches to be installed per OBC 2012, Div.B, 6.2.4.5.
- 6.Space between studs and joists used as return ducts shall be separated from unused portion as per OBC 2012 Div.B 6.2.4.7(6)

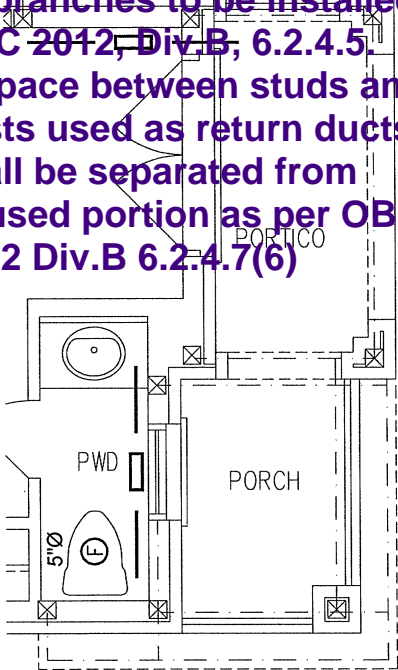


I MICHAEL O'ROURKE HAVE REVIEW AND TAKE RESPONSIBILITY FOR THE DESIGN WORK AND AM QUALIFIED UNDER DIVISION C, 3.2.5 OF THE BUILDING CODE.
Michael O'Rourke
Michael O'Rourke, BCIN# 19669
HVAC DESIGNS LTD.

CSA-F280-12
PACKAGE A1

HVAC LEGEND							3.		
SYMBOL	DESCRIPTION	SYMBOL	DESCRIPTION	SYMBOL	DESCRIPTION	SYMBOL	DESCRIPTION	2.	
	SUPPLY AIR GRILLE		6" SUPPLY AIR BOOT ABOVE		14"x8" RETURN AIR GRILLE		RETURN AIR STACK ABOVE	1.	
	SUPPLY AIR GRILLE 6" BOOT		SUPPLY AIR STACK FROM 2nd FLOOR		30"x8" RETURN AIR GRILLE		RETURN AIR STACK 2nd FLOOR	No.	Description Date
	SUPPLY AIR BOOT ABOVE		6" SUPPLY AIR STACK 2nd FLOOR		FRA- FLOOR RETURN AIR GRILLE		REDUCER	REVISIONS	

ALL DRAWINGS, CALCULATIONS AND SPECIFICATIONS ARE THE PROPERTY OF HVAC DESIGNS LTD.© AND MAY NOT BE REPRODUCED, MODIFIED OR ALTERED WITHOUT EXPRESSED WRITTEN CONSENT. THE DRAWINGS ARE DATED AND USE OF THESE DRAWINGS AFTER ONE YEAR FROM THE DATED NOTED IS NOT AUTHORIZED. CONTRACTOR SHALL CHECK ALL CONDITIONS BEFORE PROCEEDING WITH WORK. LATEST MUNICIPAL APPROVED DRAWINGS ONLY TO BE USED DURING INSTALLATION OF HEATING SYSTEM. HVAC DESIGNS LTD. IS NOT LIABLE FOR ANY CLAIMS ARISING FROM UNAUTHORIZED USE OF THE DRAWINGS OR FROM ANY CHANGES TO ACCEPTED STANDARDS AND/OR THE ONTARIO BUILDING CODE.

Client GREENPARK HOMES		<div><p>375 Finley Ave. Suite 202 - Ajax, Ontario L1S 2E2 Tel. 905.619.2300 - 905.420.5300 Fax 905.619.2375 Email: info@hvacdesigns.ca Web: www.hvacdesigns.ca Specializing in Residential Mechanical Design Services</p><p>Installation to comply with the latest Ontario Building Code. All supply branch outlets shall be equipped with a manual balancing damper. Ductwork which passes through the garage or unheated spaces shall be adequately insulated and be gas-proofed.</p></div>	Sheet Title FIRST FLOOR HEATING LAYOUT	
Project Name ROUNDEL HOMSE INC RICHMOND HILL, ONTARIO			Date MAY/2021	
OPT 2ND TERRACOTA 2 3389 sqft			Scale 3/16" = 1'-0"	
			BCIN# 19669	
			LO# 90742	

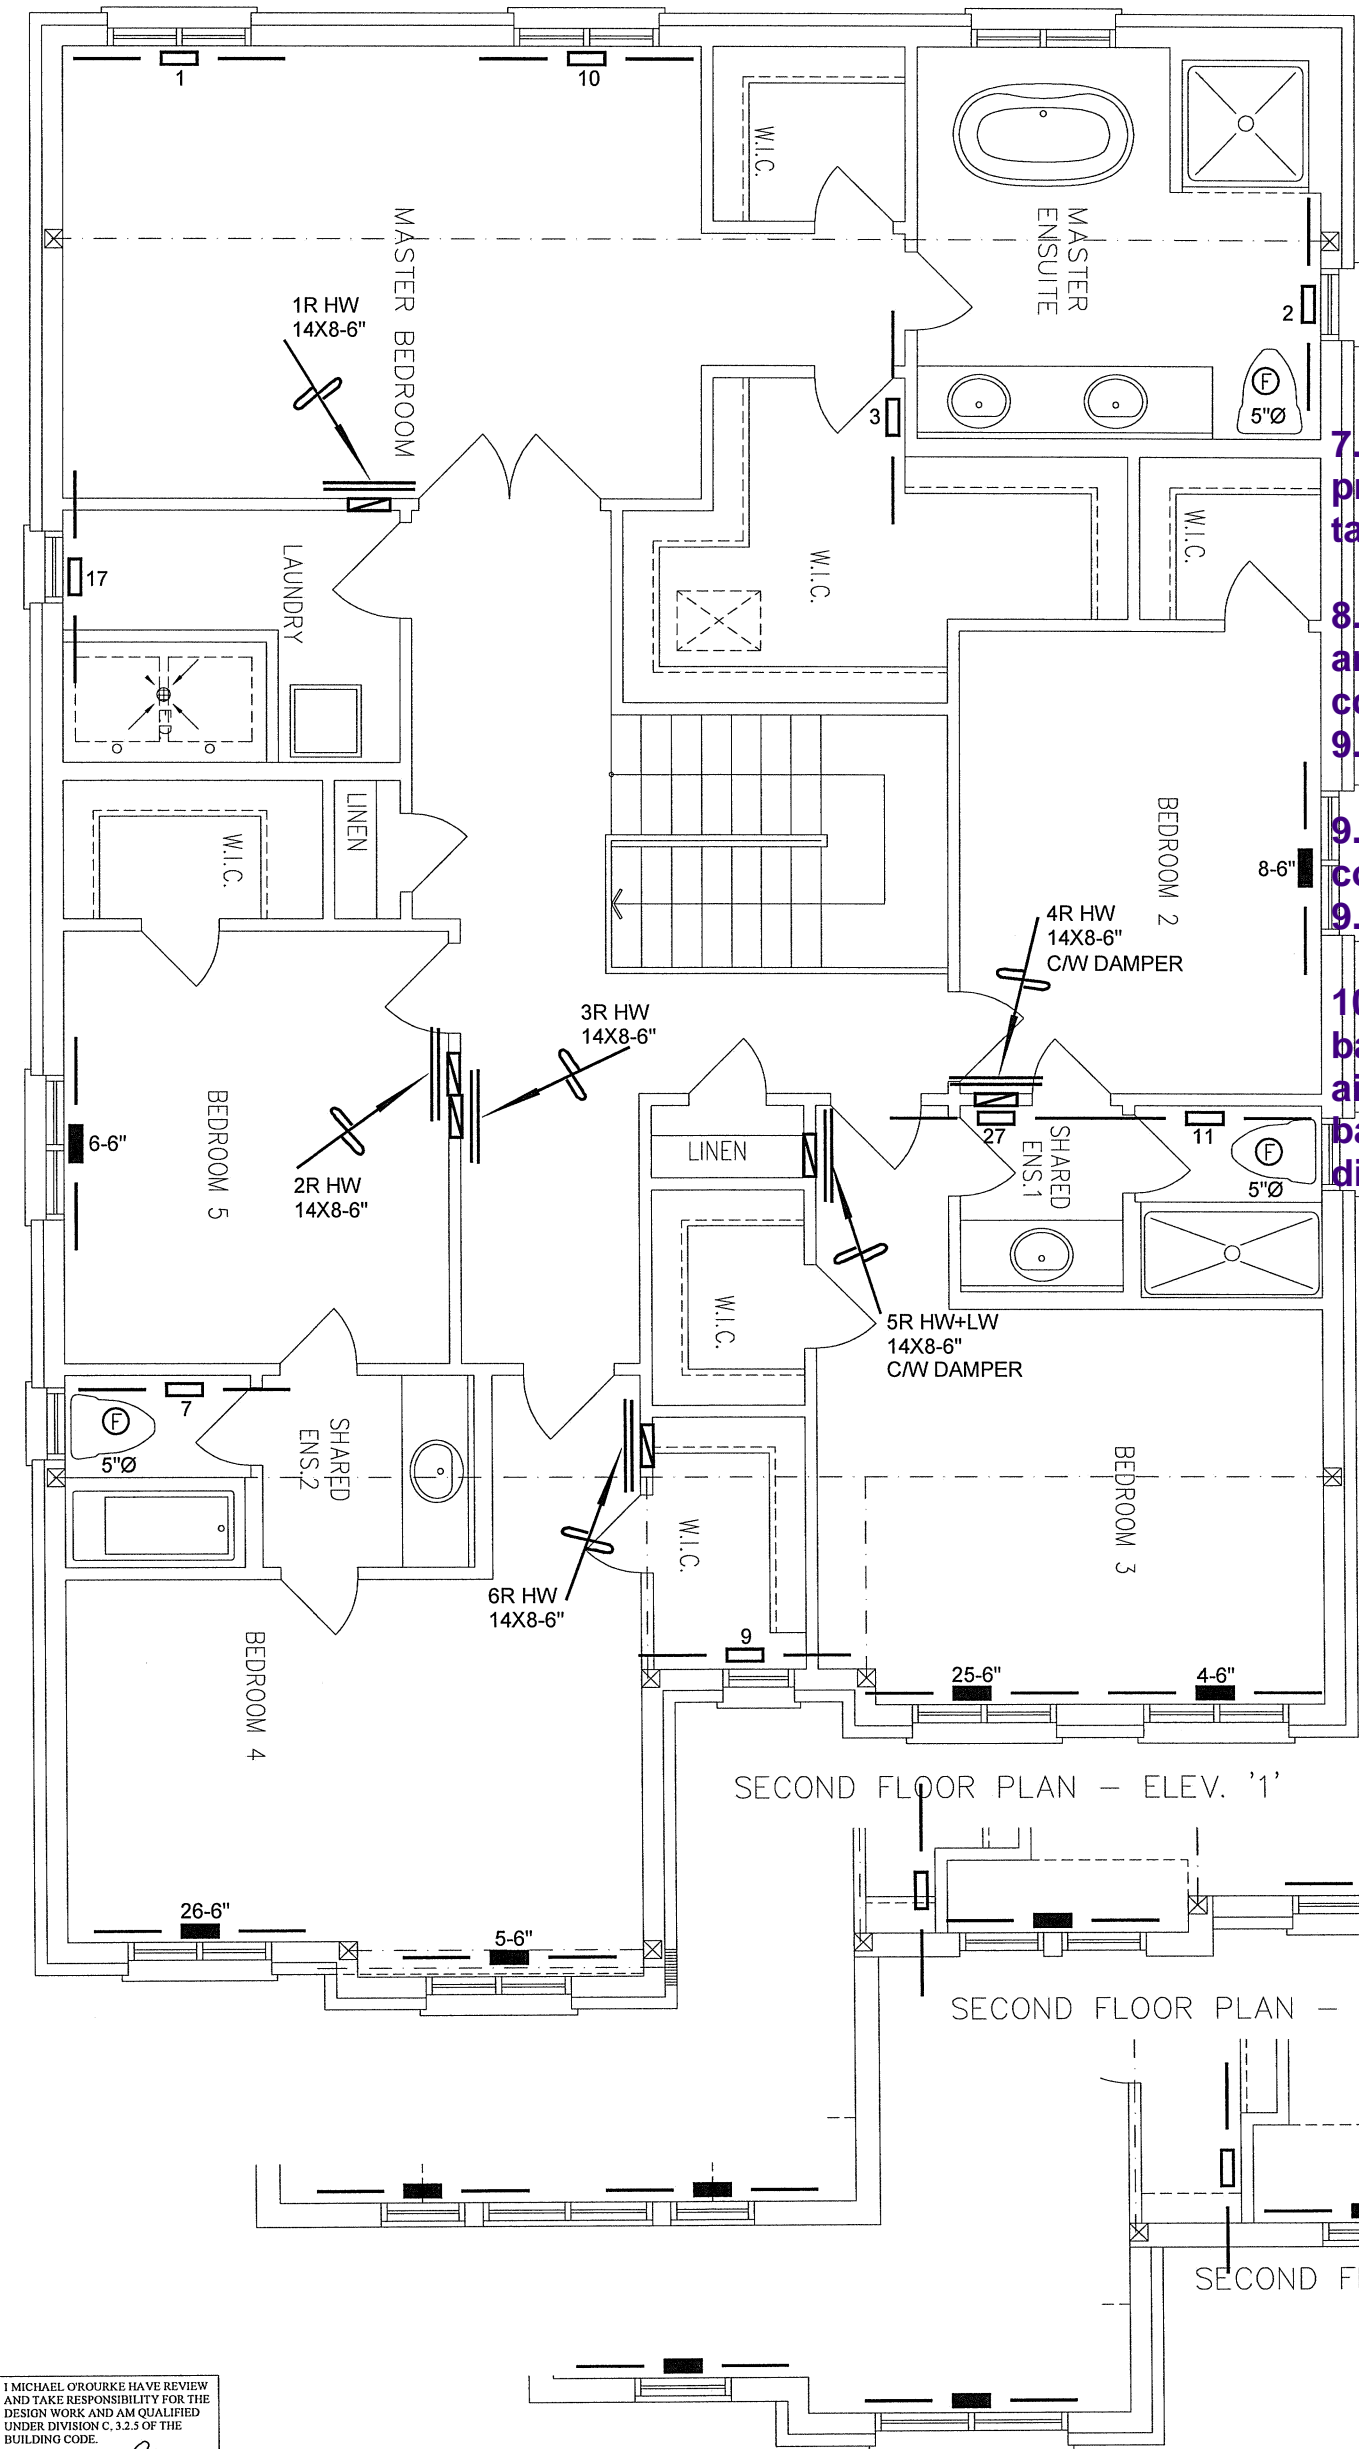

CITY OF RICHMOND HILL
BUILDING DIVISION
09/22/2022
RECEIVED
Per:maddy.toalaalejandro

7. Combustion air supply shall be provided to the furnace and hot water tank.

8.HRV installation, testing, startup and commissioning shall be in compliance with OBC 2012, Div.B 9.32.3.11, 9.32.3.11(7)&(10)

9. HRV duct connection shall be in compliance with OBC 2012 Div.B 9.32.3.6(3) & 9.32.3.4(7).

10. Supply air grill at finished basement shall be at low level. Return air grill for finished or unfinished basement shall be at low level. HRAI Digest 2005, clause 7.7(3).

13.Exterior insulation effective R-Value for wall, roof or exposed floor shall be maintained at the respective location where duct or sanitary pipes are routed inside exterior envelope.

14. Return air intake shall be provided as recommended in HRAI Digest 2005 Section 4.7 Return air inlet should be positioned so that short circuiting of supply air is avoided. A high and low wall return air combination shall be provided when a combined cooling & heating system is installed.

15. For simplified HRV/ERV installation, with stale air and fresh air connected to return air plenum, stale air intake and fresh air supply shall be separated minimum 3' or as recommended by HRV/ERV Manufacturer.

I MICHAEL O'ROURKE HAVE REVIEW AND TAKE RESPONSIBILITY FOR THE DESIGN WORK AND AM QUALIFIED UNDER DIVISION C.3.2.3 OF THE BUILDING CODE.
Michael O'Rourke
Michael O'Rourke, BCIN# 19669
HVAC DESIGNS LTD.

HVAC LEGEND							
	SUPPLY AIR GRILLE		6" SUPPLY AIR BOOT ABOVE		14"x8" RETURN AIR GRILLE		RETURN AIR STACK ABOVE
	SUPPLY AIR GRILLE 6" BOOT		SUPPLY AIR STACK FROM 2nd FLOOR		30"x8" RETURN AIR GRILLE		RETURN AIR STACK 2nd FLOOR
	SUPPLY AIR BOOT ABOVE		6" SUPPLY AIR STACK 2nd FLOOR		FRA- FLOOR RETURN AIR GRILLE		REDUCER

ALL DRAWINGS, CALCULATIONS AND SPECIFICATIONS ARE THE PROPERTY OF HVAC DESIGNS LTD.© AND MAY NOT BE REPRODUCED, MODIFIED OR ALTERED WITHOUT EXPRESSED WRITTEN CONSENT. THE DRAWINGS ARE DATED AND USE OF THESE DRAWINGS AFTER ONE YEAR FROM THE DATED NOTED IS NOT AUTHORIZED. CONTRACTOR SHALL CHECK ALL CONDITIONS BEFORE PROCEEDING WITH WORK. LATEST MUNICIPAL APPROVED DRAWINGS ONLY TO BE USED DURING INSTALLATION OF HEATING SYSTEM. HVAC DESIGNS LTD. IS NOT LIABLE FOR ANY CLAIMS ARISING FROM UNAUTHORIZED USE OF THE DRAWINGS OR FROM ANY CHANGES TO ACCEPTED STANDARDS AND/OR THE ONTARIO BUILDING CODE.

Client GREENPARK HOMES		<div><p>375 Finley Ave. Suite 202 - Ajax, Ontario L1S 2E2 Tel. 905.619.2300 - 905.420.5300 Fax 905.619.2375 Email: info@hvacdesigns.ca Web: www.hvacdesigns.ca Specializing in Residential Mechanical Design Services</p></div>	Sheet Title SECOND FLOOR HEATING LAYOUT	
Project Name ROUNDEL HOMSE INC RICHMOND HILL, ONTARIO			Date MAY/2021	
OPT 2ND TERRACOTA 2 3389 sqft		Scale 3/16" = 1'-0"		
		BCIN# 19669		
		LO#	90742	