

CONSTRUCTION SUMMARY
Hazel Glenn - Barlassina Construction Inc.

PURCHASER: Aman SHARMA

TEL: RES.: 438-334-5655

LOT / PHASE 73 / 1	REG. PLAN #	HOUSE TYPE Garden 1 Elev 3 (3 Bedroom)		
-----------------------	-------------	---	--	--

CONSTRUCTION

2 - ENLARGE BASEMENT WINDOWS (MAY REQUIRE WINDOW WELLS) - WINDOW IS 30 INCHES X 24 INCHES 14Dec22 Note:	
--	--

PROMOTIONAL

1 - PARTIAL REDEMPTION OF PROMOTIONAL PACKAGE \$1,300 BALANCE FORWARD \$8,700 TO BE USED AT A LATER DATE. ORIGINAL PROMOTIONAL PACKAGE OF \$10,000 AS PER SCHEDULE PE 14Dec22 Note:	
---	--

This Document is Extremely Time Sensitive - Printed 14 Dec 22 at 15:48

LOT 73 

HAZEL
GLENN




AREA

Garden 1

ELEVATION 1 & 2 - 2,190 sq.ft. • ELEVATION 3 - 2,194 SQ.FT.

Includes 12 sq.ft. of open area

enlarged
Basement
Windows

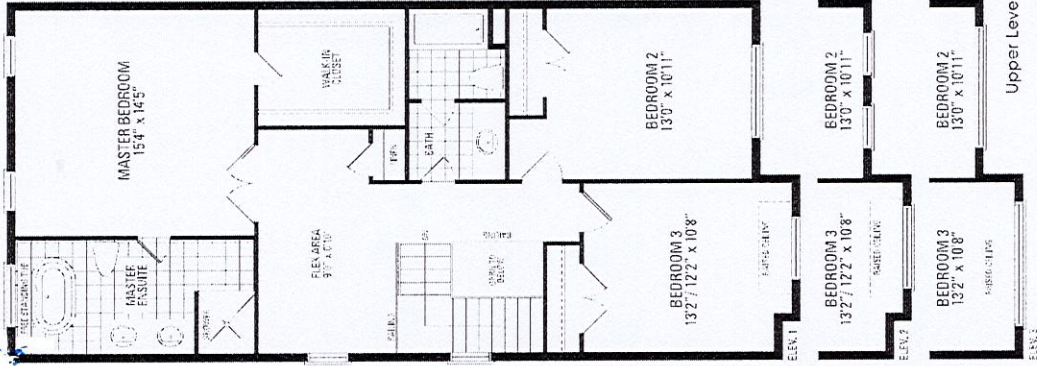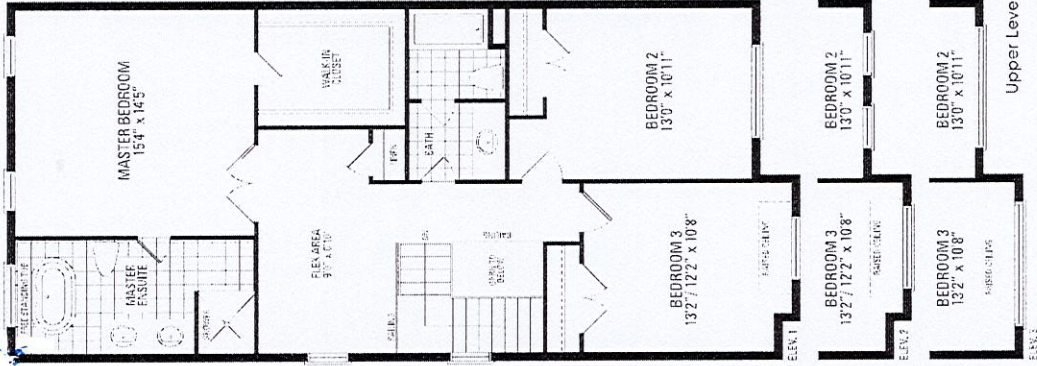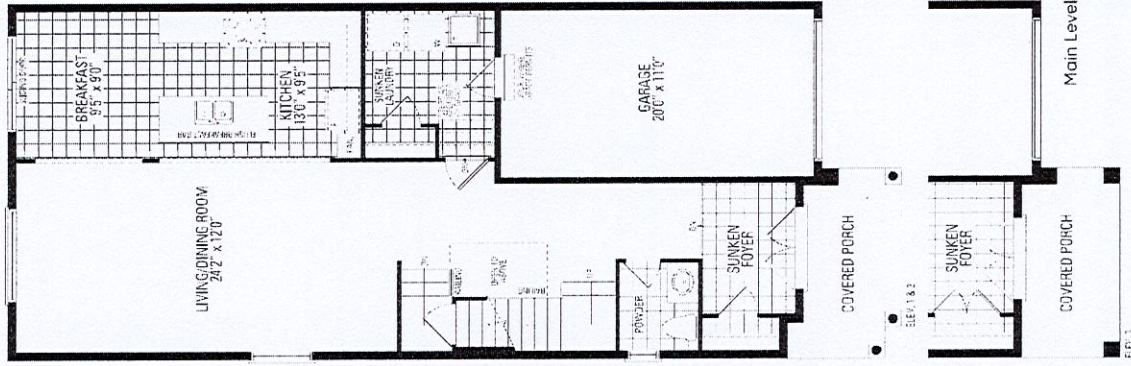

Orientation of home may be reversed and purchaser agrees to accept the same. Steps and porches may vary at any exterior entrance ways due to grading variance. Actual usable floor space may vary from the stated floor areas. All renderings are artist's concept. Dimensions, specifications and architectural detailing subject to modifications. Roofline and adjoining model types may vary due to siting. E. & O.E. October 2022