

PRELIMINARY

CONSTRUCTION SUMMARY

Hazel Glenn - Barlassina Construction Inc.

PURCHASERS: Amjad ALI and Salma ZUBAIR

TEL: RES.: 647-965-3174

LOT / PHASE 110 / 1	REG. PLAN #	HOUSE TYPE Garden 9 Elev 1 (4 Bedroom)		
------------------------	-------------	---	--	--

CONSTRUCTION

3 - ENLARGE BASEMENT WINDOWS (MAY REQUIRE WINDOW WELLS) - WINDOW IS 30 INCHES X 24 INCHES 06Dec22 Note:	
--	--

PROMOTIONAL

1 - PARTIAL REDEMPTION OF PROMOTIONAL PACKAGE \$1,950 BALANCE FORWARD \$8,050 TO BE USED AT A LATER DATE. ORIGINAL PROMOTIONAL PACKAGE OF \$10,000 AS PER SCHEDULE PE 06Dec22 Note:	
---	--



This Document is Extremely Time Sensitive - Printed 16 Dec 22 at 8:27

LOT # 110

Garden 9

ELEVATION 1 - 2,490 sq.ft.

3 enlarged Basement windows

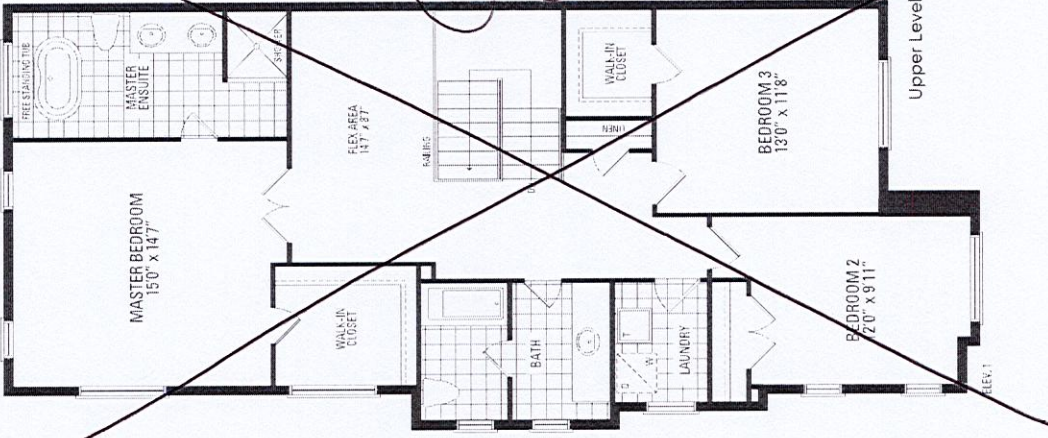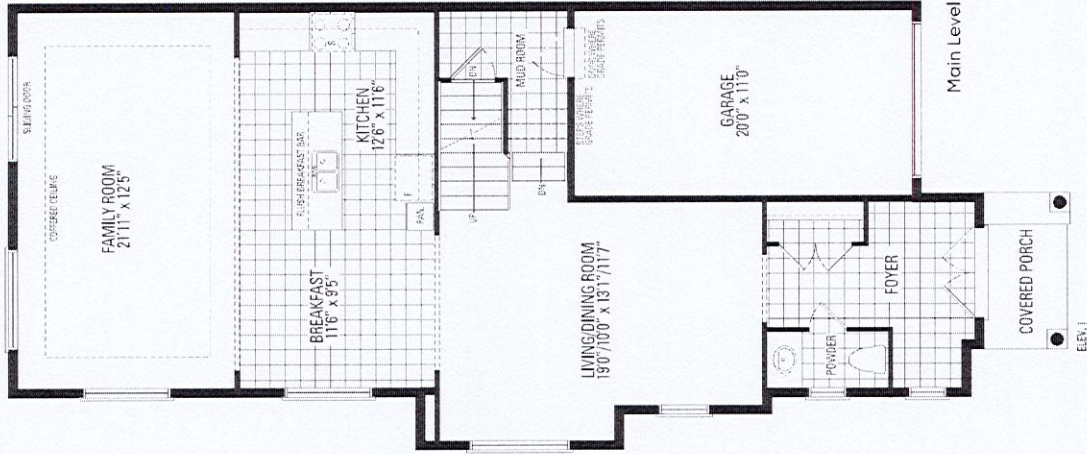

4 Bedroom PLAN.

Orientation of home may be reversed and purchaser agrees to accept the same. Steps and porches may vary at any exterior entrance ways due to grading variance. Actual usable floor space may vary from the stated floor areas. All renderings are artist's concept. Dimensions, specifications and architectural detailing subject to modifications. Roofline and adjoining model types may vary due to siting. E. & O.E. October 2022


SKETCH

Garden 9

ELEVATION 1 - 2,490 sq.ft.

4 Bedroom
December 1, 2022

LOT #110
Barhassina

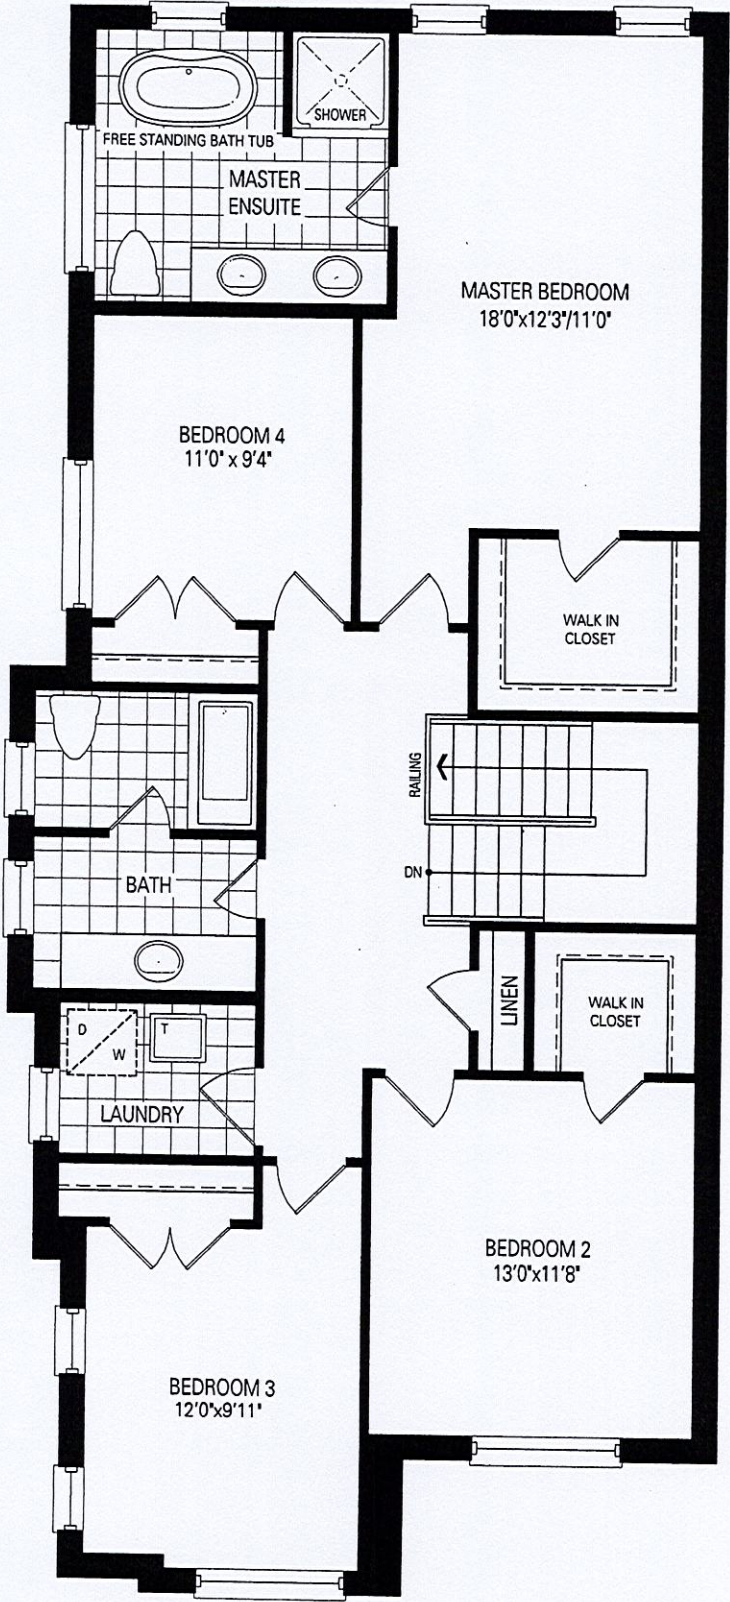

DocuSigned by:
Salma Zubaip
9B66813CE23641A...

01-Dec-22

Upper Level
4 Bedroom Layout

DocuSigned by:
SALMA ZUBAIP
0F50B2CA35F2430...

01-Dec-22

Orientation of home may be reversed and purchaser agrees to accept the same. Steps and porches may vary at any exterior entrance ways due to grading variance. Actual usable floor space may vary from the stated floor areas. All renderings are artist's concept. Dimensions, specifications and architectural detailing subject to modifications. Roofline and adjoining model types may vary due to siting. E. & O.E. October 2022