

CONSTRUCTION SUMMARY Hazel Glenn - Barlassina Construction Inc.	
PURCHASER: Kuljeet KAUR	TEL: RES.: 647-671-7646

LOT / PHASE 82 / 1	REG. PLAN #	HOUSE TYPE Garden 3 Elev 2 (4 Bedroom)		
-----------------------	-------------	---	--	--

CONSTRUCTION

3 - ENLARGE BASEMENT WINDOWS (MAY REQUIRE WINDOW WELLS) - WINDOW IS 30 INCHES X 24 INCHES <i>12Dec22</i> Note:	
--	--

PROMOTIONAL

1 - LESS BALANCE OF CREDIT FROM PURCHASER EXTRA SHEET IN OFFER <i>12Dec22</i> Note: PROMO BALANCE REMAINING - \$8,050.00	
--	--




This Document is Extremely Time Sensitive - Printed 14 Dec 22 at 10:52

LOT#82

HAZEL
GLENN
LENN

Garden 3

ELEVATION 1 & 2 - 2,400 sq.ft. • ELEVATION 3 - 2,415 SQ.FT.

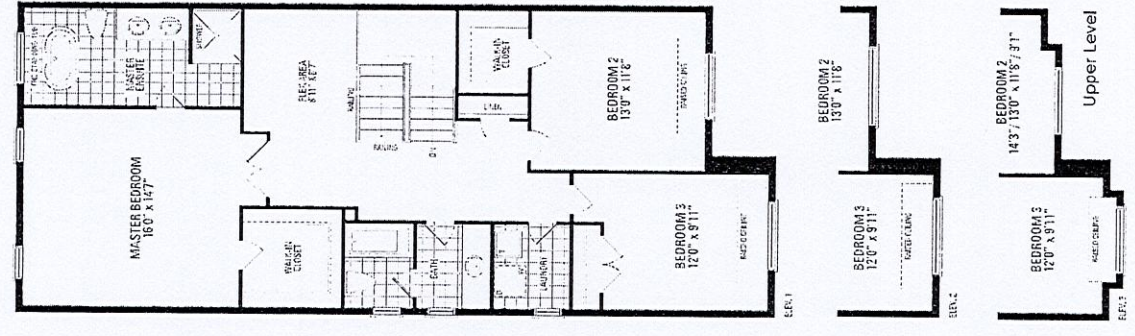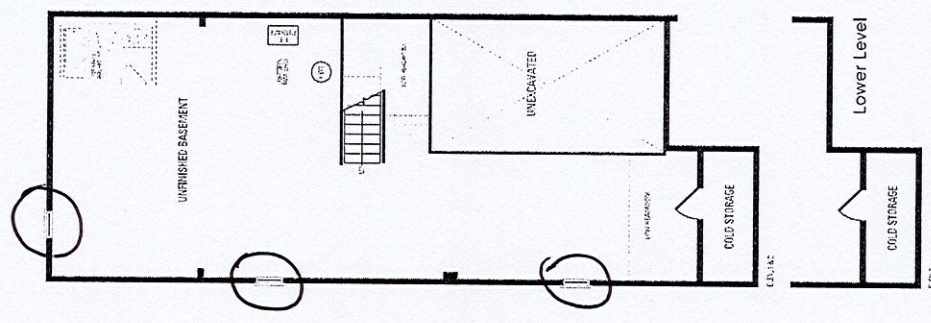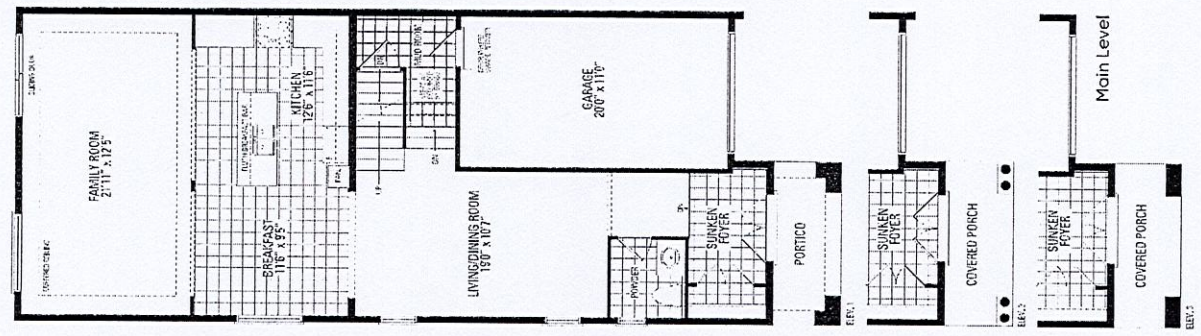

* Enlarge Basement Windows

Orientation of home may be reversed and purchaser agrees to accept the same. Steps and porches may vary at any exterior entrance ways due to grading variance. Actual usable floor space may vary from the stated floor areas. All renderings are artist's concept. Dimensions, specifications and architectural detailing subject to modifications. Roofline and adjoining model types may vary due to siting. E. & O.E. October 2022