

CONSTRUCTION SUMMARY

Red Oaks - Roundel Homes Inc.

RECEIVED

DEC 20 2022

TEL:

PURCHASERS: MEI-HUNG LEUNG and Huy, Minh TRUONG

LOT / PHASE 28 / 1	REG. PLAN # 65M-4737	HOUSE TYPE Pinetree 3 Elev 1		
-----------------------	-------------------------	---------------------------------	--	--

PLUMBING

1 - WATER LINE FOR FRIDGE - ROUGH-IN ONLY 08Dec22 Note:	
--	--

PROMOTIONAL

1 - PARTIAL REDEMPTION OF PROMOTIONAL PACKAGE \$395.00 BALANCE FORWARD (\$9,605.00) TO BE USED AT A LATER DATE. ORIGINAL PROMOTIONAL PACKAGE OF \$10,000.00 AS PER SCHEDULE PE DATED 11/02/2022 08Dec22 Note:	
--	--

EXTRAS AS PER OFFER



The Vendor agrees that notwithstanding any other term or provision in this Agreement included in the Purchase Price and in addition to those items detailed in Schedule GP to the Agreement of Purchase and Sale, the Purchaser is entitled to a credit of Ten Worksheet Note:	
---	--

This Document is Extremely Time Sensitive - Printed 20 Dec 22 at 9:01

Lot 28

Pinetree 3

ELEV. 1 • 2,682 sq.ft. | ELEV. 2 • 2,673 sq.ft. | ELEV. 3 • 2,686 sq.ft.
Includes 38 sq.ft. of open area.

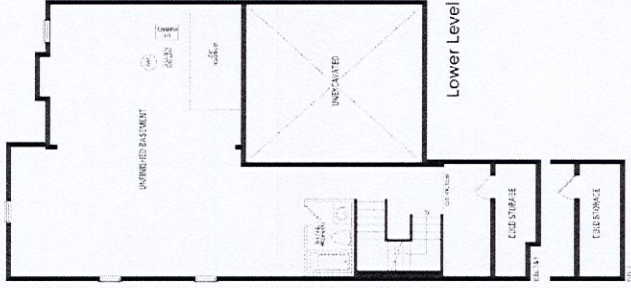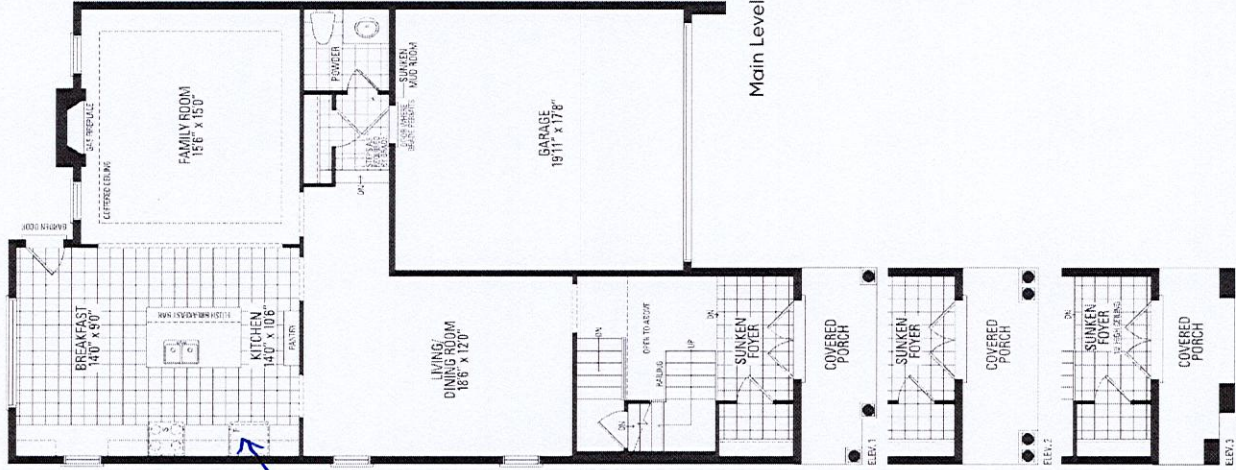

lot 28

Orientation of home may be reversed and purchaser agrees to accept the same. Steps and porches may vary at any exterior entrance ways due to grading variance. Actual usable floor space may vary from the stated floor areas. All renderings are artist's concept. Dimensions, specifications and architectural detailing subject to modifications. Roofline and adjoining model types may vary due to siting. E. & O. E. June 2022