

"PRELIMINARY"
RECEIVED

PK

CONSTRUCTION SUMMARY

Red Oaks - Roundel Homes Inc.

DEC 20 2022

TEL: RES.: 416-854-7082

PURCHASER: Zhuanyi SU

LOT / PHASE 161 / 1	REG. PLAN # 65M-4737	HOUSE TYPE Glenrowan 2 Elev 2		
------------------------	-------------------------	----------------------------------	--	--

ELECTRICAL

1 - ELECTRIC VEHICLE ROUGH-IN PROVISION ONLY FOR FUTURE ELECTRIC CAR (CONDUIT FROM BASEMENT INTO JUNCTION BOX IN GARAGE WITH PULL STRING, NO WIRE) 16Dec22 Note: **SEE SKETCH FOR REQUESTED LOCATION - IF CONSTRUCTION PERMITS	
---	--

HEATING AND AIR CONDITIONING

1 - HUMIDIFIER 16Dec22 Note:	
---------------------------------	--

PROMOTIONAL




1 - PARTIAL REDEMPTION OF PROMOTIONAL PACKAGE \$1,250.00. BALANCE FORWARD TO BE USED AT A LATER DATE \$8,750.00. ORIGINAL PROMOTIONAL PACKAGE OF \$10,000.00AS PER SCHEDULE PE DATED DEC 16/22 OCT 30/22 16Dec22 Note:	
--	--

This Document is Extremely Time Sensitive - Printed 16 Dec 22 at 14:44

LOT #161

Glenrowan 2

ELEV. 1 • 2,827 sq.ft. | ELEV. 2 • 2,818 sq.ft. | ELEV. 3 • 2,829 sq.ft.
Includes 10 sq.ft. of open area.

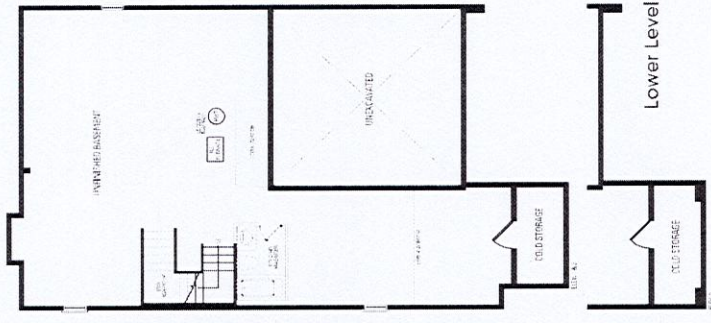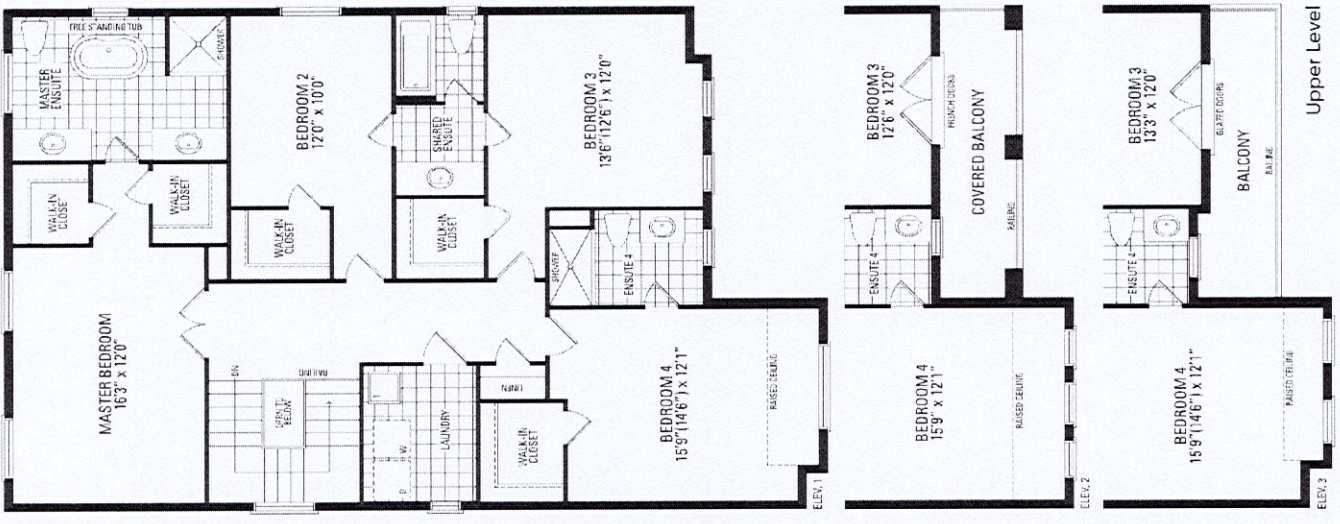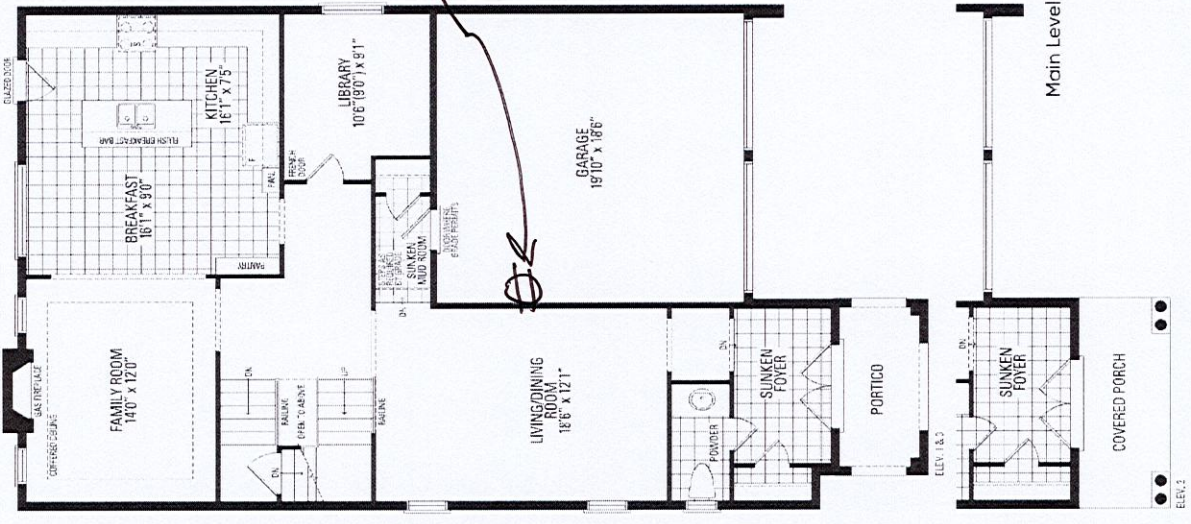

Orientation of home may be reversed and purchaser agrees to accept the same. Steps and porches may vary at any exterior entrance ways due to grading variance. Actual usable floor space may vary from the stated floor areas. All renderings are artist's concept. Dimensions, specifications and architectural detailing subject to modifications. Roofline and adjoining model types may vary due to siting. E. & O. E. June 2022