

CONSTRUCTION SUMMARY
Red Oaks - Roundel Homes Inc.

"Preliminary"
RECEIVED
FEB - 1 2023

PURCHASER: K. H. Jonathan LOO

TEL:

LOT / PHASE	REG. PLAN #	HOUSE TYPE		
91 / 1	65M-4737	Terracotta 2S (4 Bedroom) Elev 1		

CABINETRY

1 - CABINETRY PROVISION - PROVISION FOR PLUG ON ISLAND (PLUG EXTRA ORDERED SEPARATELY) 06Jan23 Note: FACING KITCHEN SINK	
---	--

CABINETRY ACCESSORIES

1 - KITCHEN BASE CABINETRY - BAR FRIDGE PROVISION 06Jan23 Note: - SEE SKETCH NEXT TO BAR SINK - SEE SKETCH	
--	--

CONSTRUCTION

1 - SMOOTH CEILINGS ON SECOND FLOOR 25Jan23 Note:  NEW	
1 - PROVISION FOR SHAMPOO NICHE APPROX. 14" WIDE X 20" HIGH AS PER SKETCH - IF CONSTRUCTION PERMITS 06Jan23 Note: MASTER ENSUITE	
1 - SMOOTH CEILINGS ON FIRST FLOOR ONLY - DET 06Jan23 Note:	

COUNTER TOP

1 - SHAMPOO NICHE 14" WIDE X 20" HIGH AS PER SKETCH - MARBLE, GRANITE OR QUARTZ - IF CONSTRUCTION PERMITS - REQUIRES PROVISION FROM CONSTRUCTION 06Jan23 Note: SUPPLY & INSTALL MASTER ENSUITE	
---	--

ELECTRICAL

2 - POT LIGHT - LED - SECOND FLOOR INSTALLATION - FLEX ROOM **SEE SKETCH FOR LOCATION 06Jan23 Note: STANDARD LIGHT TO REMAIN ON SEPERATE SWITCH	
3 - POT LIGHT - LED - FIRST FLOOR INSTALLATION - KITCHEN *SEE SKETCH FOR LOCATION 06Jan23 Note: STANDARD LIGHT TO REMAIN ON SEPERATE SWITCH	
4 - POT LIGHT - LED - FIRST FLOOR INSTALLATION - BREAKFAST AREA **SEE SKETCH FOR LOCATION 06Jan23 Note: STANDARD LIGHT TO REMAIN ON SEPERATE SWITCH	
4 - POT LIGHT - LED - FIRST FLOOR INSTALLATION - FAMILY ROOM **SEE SKETCH FOR LOCATION 06Jan23 Note: STANDARD LIGHT TO REMAIN ON SEPERATE SWITCH	
4 - POT LIGHT - LED - FIRST FLOOR INSTALLATION - LIVING ROOM/DINING ROOM **SEE SKETCH FOR LOCATION 06Jan23 Note: STANDARD LIGHT TO REMAIN ON SEPERATE SWITCH	
4 - POT LIGHT - LED - FIRST FLOOR INSTALLATION - LIBRARY **SEE SKETCH FOR LOCATION 06Jan23 Note: STANDARD LIGHT TO REMAIN ON SEPERATE SWITCH	

CONSTRUCTION SUMMARY

Red Oaks - Roundel Homes Inc.

PURCHASER: K. H. Jonathan LOO

TEL:

LOT / PHASE	REG. PLAN #	HOUSE TYPE		
91 / 1	65M-4737	Terracotta 2S (4 Bedroom) Elev 1		

1 - PLUG - ELECTRICAL PLUG - ADD TO ISLAND 06Jan23 Note: FACING KITCHEN SINK	
1 - PLUG - ELECTRICAL PLUG - FOR BAR FRIDGE 06Jan23 Note: - SEE SKETCH NEXT TO BAR SINK	
3 - FAN - BATHROOM EXHAUST FAN - ENERGY STAR 80 CFM - IN LIEU OF STANDARD FAN 06Jan23 Note: MASTER ENSUITE ENSUITE 3/4 ENSUITE 2	
1 - PLUG - ELECTRICAL PLUG - TO BE INSTALLED OVER FIREPLACE 06Jan23 Note: FAMILY ROOM	
3 - PLUG - ELECTRICAL PLUG WITH GFI - NEXT TO TOILET 06Jan23 Note: MASTER ENSUITE ENSUITE 3/4 ENSUITE 2	
1 - STANDARD DINING ROOM LIGHT TO BE CENTERED BETWEEN LIVING AND DINING ROOM 06Jan23 Note:	
1 - RELOCATE STANDARD KITCHEN LIGHT TO BE CENTERED OVER ISLAND 06Jan23 Note:	
7 - POT LIGHT - EXTERIOR - SOFFIT MOUNT - REGULAR VOLTAGE 06Jan23 Note: SEE SKETCH FOR LOCATION	
1 - PLUG - ELECTRICAL PLUG WITH GFI AND SWITCH - FOR FESTIVE LIGHTING 06Jan23 Note: **SEE REQUESTED LOCATION - IF CONSTRUCTION PERMITS	
1 - ELECTRIC VEHICLE ROUGH-IN PROVISION ONLY FOR FUTURE ELECTRIC CAR (CONDUIT FROM BASEMENT INTO JUNCTION BOX IN GARAGE WITH PULL STRING, NO WIRE) 06Jan23 Note: **SEE SKETCH FOR REQUESTED LOCATION - IF CONSTRUCTION PERMITS	

FIREPLACE AND ACCESSORIES

1 - GAS LINE ROUGH-IN FOR STOVE (INCLUDES ELECTRICAL OUTLET) - FIRST FLOOR 06Jan23 Note:	
---	--

MIRRORS AND GLASS

1 - FRAMELESS GLASS SHOWER DOOR - INCLUDES CHROME KNOB & HINGES 06Jan23 Note: MASTER ENSUITE	
---	--

PLUMBING

2 - HOSE BIB - EXTERIOR FROST FREE 06Jan23 Note: 1 @ GARAGE/ 1 @ EXTERIOR	
3 - HOT WATER VALVE NEXT TO TOILET - PRICE IS EACH 06Jan23 Note: MASTER ENSUITE ENSUITE 3/4 ENSUITE 2	
1 - WATER LINE FOR FRIDGE - ROUGH-IN ONLY 06Jan23 Note:	

PROMOTIONAL

CONSTRUCTION SUMMARY
Red Oaks - Roundel Homes Inc.

PURCHASER: K. H. Jonathan LOO TEL:

LOT / PHASE 91 / 1	REG. PLAN # 65M-4737	HOUSE TYPE Terracotta 2S (4 Bedroom) Elev 1		
-----------------------	-------------------------	--	--	--

1 - LESS CREDIT FROM PURCHASER EXTRA SHEET IN OFFER 06Jan23 Note:	
--	--

EXTRAS AS PER OFFER


The Vendor agrees that notwithstanding any other term or provision in this Agreement included in the Purchase Price and in addition to those items detailed in Schedule GP to the Agreement of Purchase and Sale, the Purchaser is entitled to a credit of Ten Worksheet Note:	
---	--

This Document is Extremely Time Sensitive - Printed 30 Jan 23 at 10:34


LOT #91

Terracotta 2S


ELEV. 1 - 3,363 sq. ft.

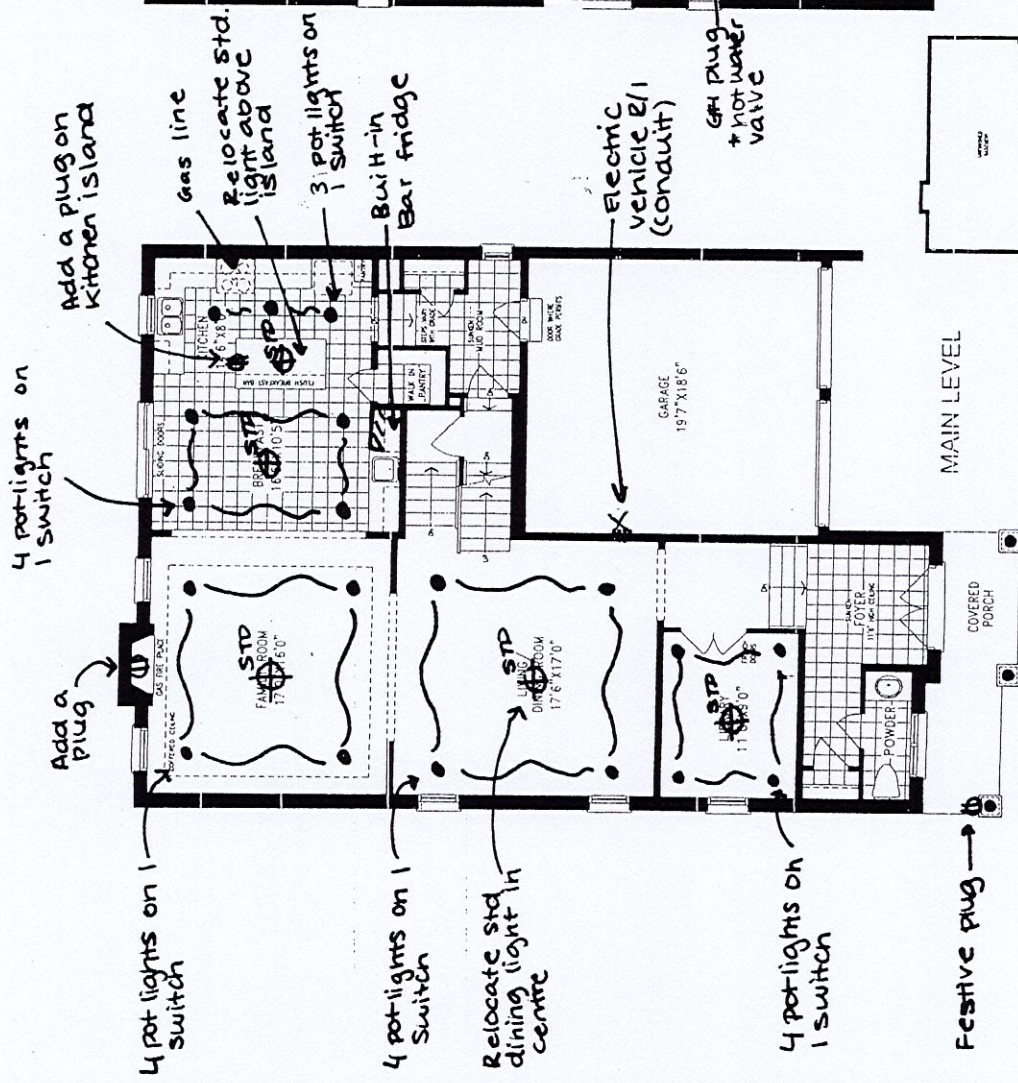


#smooth ceiling 1st+2nd floor
#gas line R/I for stove
#water line R/I

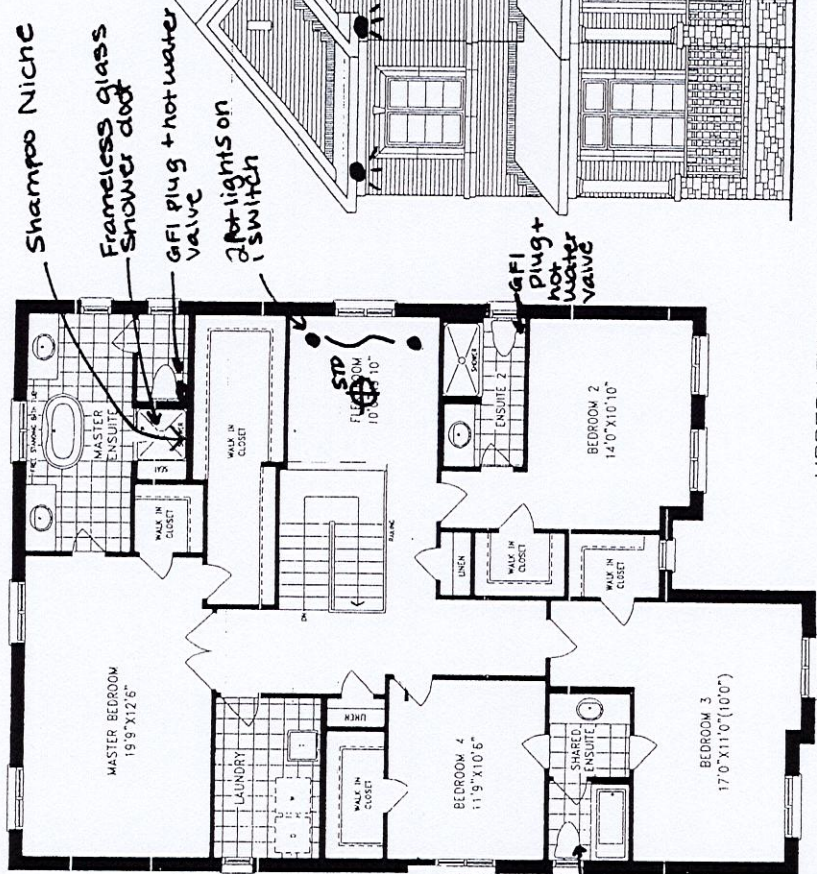

UPPER LEVEL

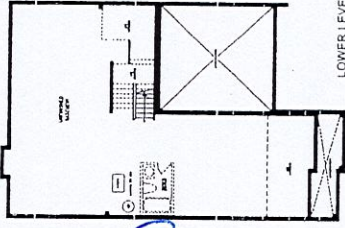

LOWER LEVEL

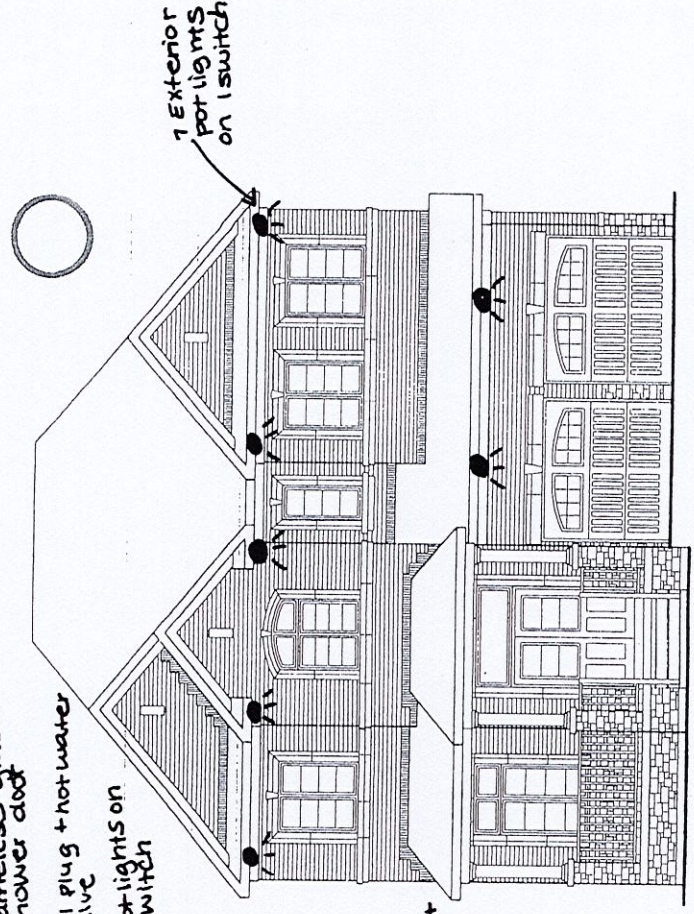

FRONT ELEVATION 1

ORIENTATION OF HOME MAY BE REVERSED AND PURCHASER AGREES TO ACCEPT THE SAME. STEPS AND PORCHES MAY VARY AT ANY EXTERIOR ENTRANCE WAYS DUE TO GRADING VARIANCE. ACTUAL USABLE FLOOR SPACE MAY VARY FROM THE STATED FLOOR AREA. ALL RENDERINGS ARE ARTIST'S CONCEPT. DIMENSIONS, SPECIFICATIONS AND ARCHITECTURAL DETAILING SUBJECT TO MODIFICATIONS. ROOFLINE AND ADJOINING MODEL TYPES MAY VARY DUE TO SITING. E. & O.E. APR. 2022