

CONSTRUCTION SUMMARY - PARTIAL ONLY
Mountainview Heights 3 (G) - Russell Gardens Building Ltd.

RECEIVED
FEB 24 2023

PURCHASERS: Mile NIKSIC and Mirjana M. BELAVIC

TEL:

LOT NUMBER	PHASE	HOUSE TYPE	REG. PLAN #		
553	4	Valleycreek Five A Elev 2	62M-1266		

INV#	QTY	EXTRA / CHANGE
------	-----	----------------

CONSTRUCTION

28,274	1 - KITCHEN - BULKHEAD TO CONTINUE ABOVE FRIDGE WALL CABINETS AND ABOVE PANTRY - SAME SIZE BULKHEAD AS CURRENTLY ABOVE STOVE WALL CABINETS
24Feb23	Note:

This Document is Extremely Time Sensitive - Printed 24 Feb 23 at 10:26

Construction
+
Selba

LOT 553
RUSSELL GARDENS
PHASE 4
MOUNTAINVIEW HEIGHTS


VALLEYCREEK 5A
ELEV. 2

REVISIONS:


- REAR WALL OF HOUSE PUSHED IN 1'-4" TO FIT LOT CONDITIONS.
- DELETE 1'-4" FROM FAMILY ROOM.
DELETE 1'-4" FROM BREAKFAST.
REDUCE ISLAND BY 12" TO INCREASE BREAKFAST TO 8'-8".
- DELETE 1'-4" FROM MASTER BEDROOM. REDUCE WALK-IN CLOSET BY 4" TO MAKE BEDROOM 16'-0".
- DELETE MASTER ENSUITE BY 1'-4". REDUCE BEDROOM 2 BY 4" AND ADD TO ENSUITE. REDUCE WATER CLOSET BY 4" AND ADD TO ENSUITE. WALL REMOVED FROM END OF VANITY TO OPEN SPACE UP.

NEW TOTAL GROSS AREA =
2,848 SQ.FT.

cont.
current Bulkhead

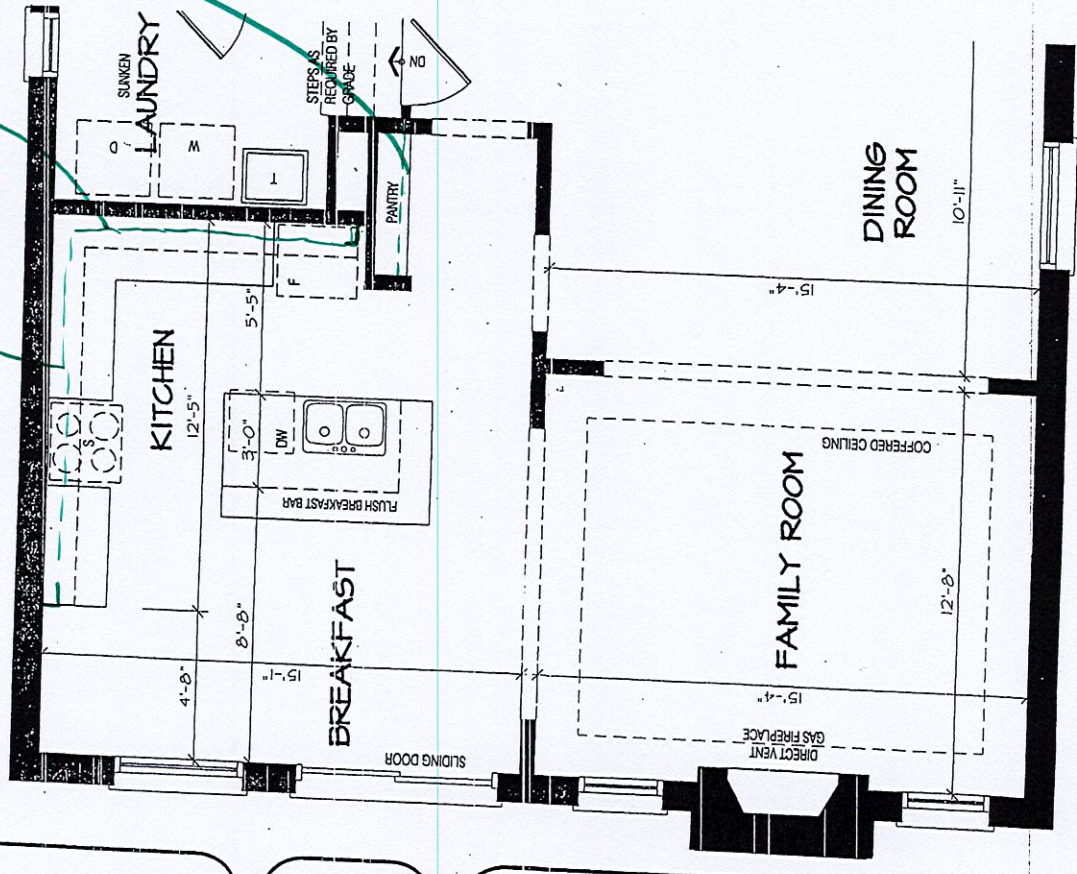

MAIN LEVEL

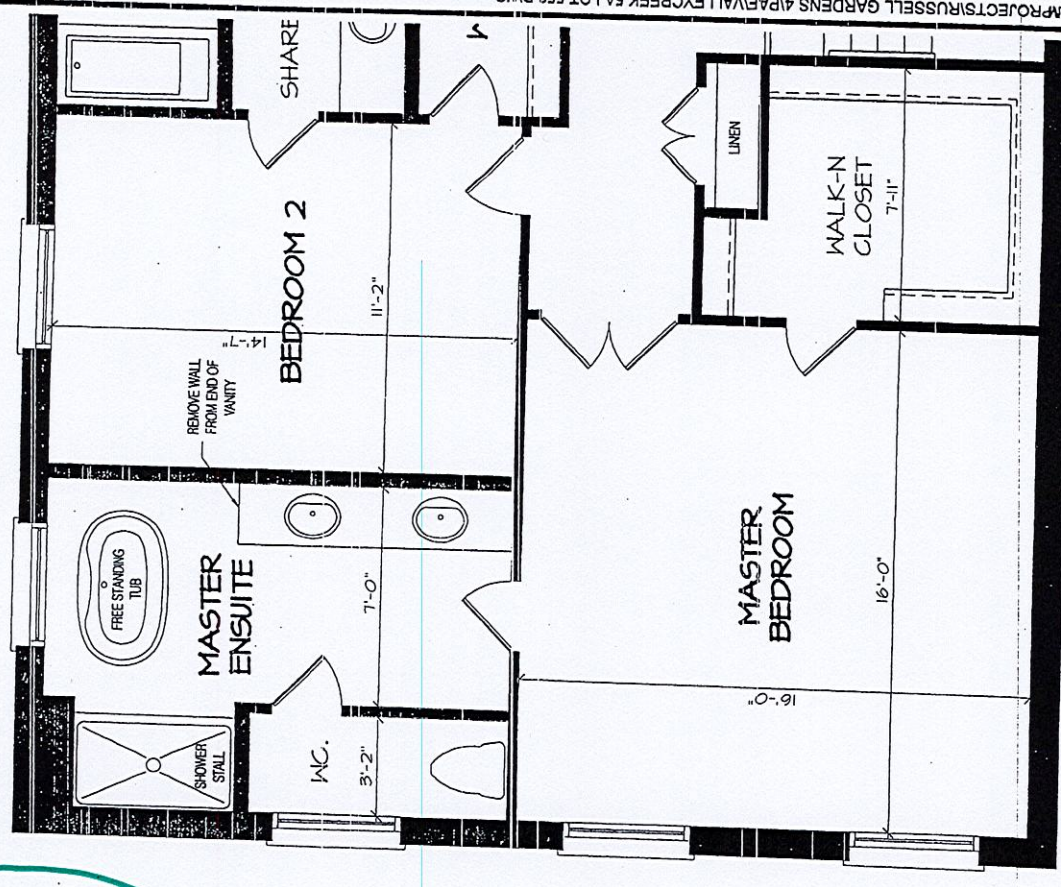

UPPER LEVEL

DISCLAIMERS: SKETCH NOT TO SCALE. DIMENSIONS, SPECIFICATIONS AND ARCHITECTURAL DETAILS SUBJECT TO MODIFICATION BY THE VENDOR. SKETCH IS ONLY FOR THE PURPOSE OF ILLUSTRATING REVISIONS REQUESTED BY THE PURCHASER AND ALL REVISIONS ARE SUBJECT TO VENDOR'S FINAL APPROVAL. ONLY REVISIONS ACCEPTED IN WRITING BY THE PURCHASER AND VENDOR ON A PURCHASER'S EXTRA SHEET WILL BE INCORPORATED INTO THE PLANS FILED WITH THE MUNICIPALITY. E. & O.E.

REGION
DESIGN
INC.

SCALE
BY MB
PAGE No.
1 OF 1

Greenpark™