


NON-LOADBEARING INTERIOR
WALLS ARE NOT TO BE FRAMED IN
UNFINISHED BASEMENTS

It is the builder's complete responsibility to ensure that all plans submitted for approval fully comply with the Architectural Code and all applicable regulations and requirements including zoning provisions and any provisions in the applicable agreement. The Council is not responsible for the accuracy of the drawings or the appropriateness of the proposed work. This is to certify that these plans comply with the applicable Architectural Code and all applicable regulations and requirements including zoning provisions and any provisions in the applicable agreement. The Council is not responsible for the accuracy of the drawings or the appropriateness of the proposed work. This is to certify that these plans comply with the applicable Architectural Code and all applicable regulations and requirements including zoning provisions and any provisions in the applicable agreement. The Council is not responsible for the accuracy of the drawings or the appropriateness of the proposed work.

6.10m TOWNS
CHERRY
MODELS
TH-31 TO TH-36

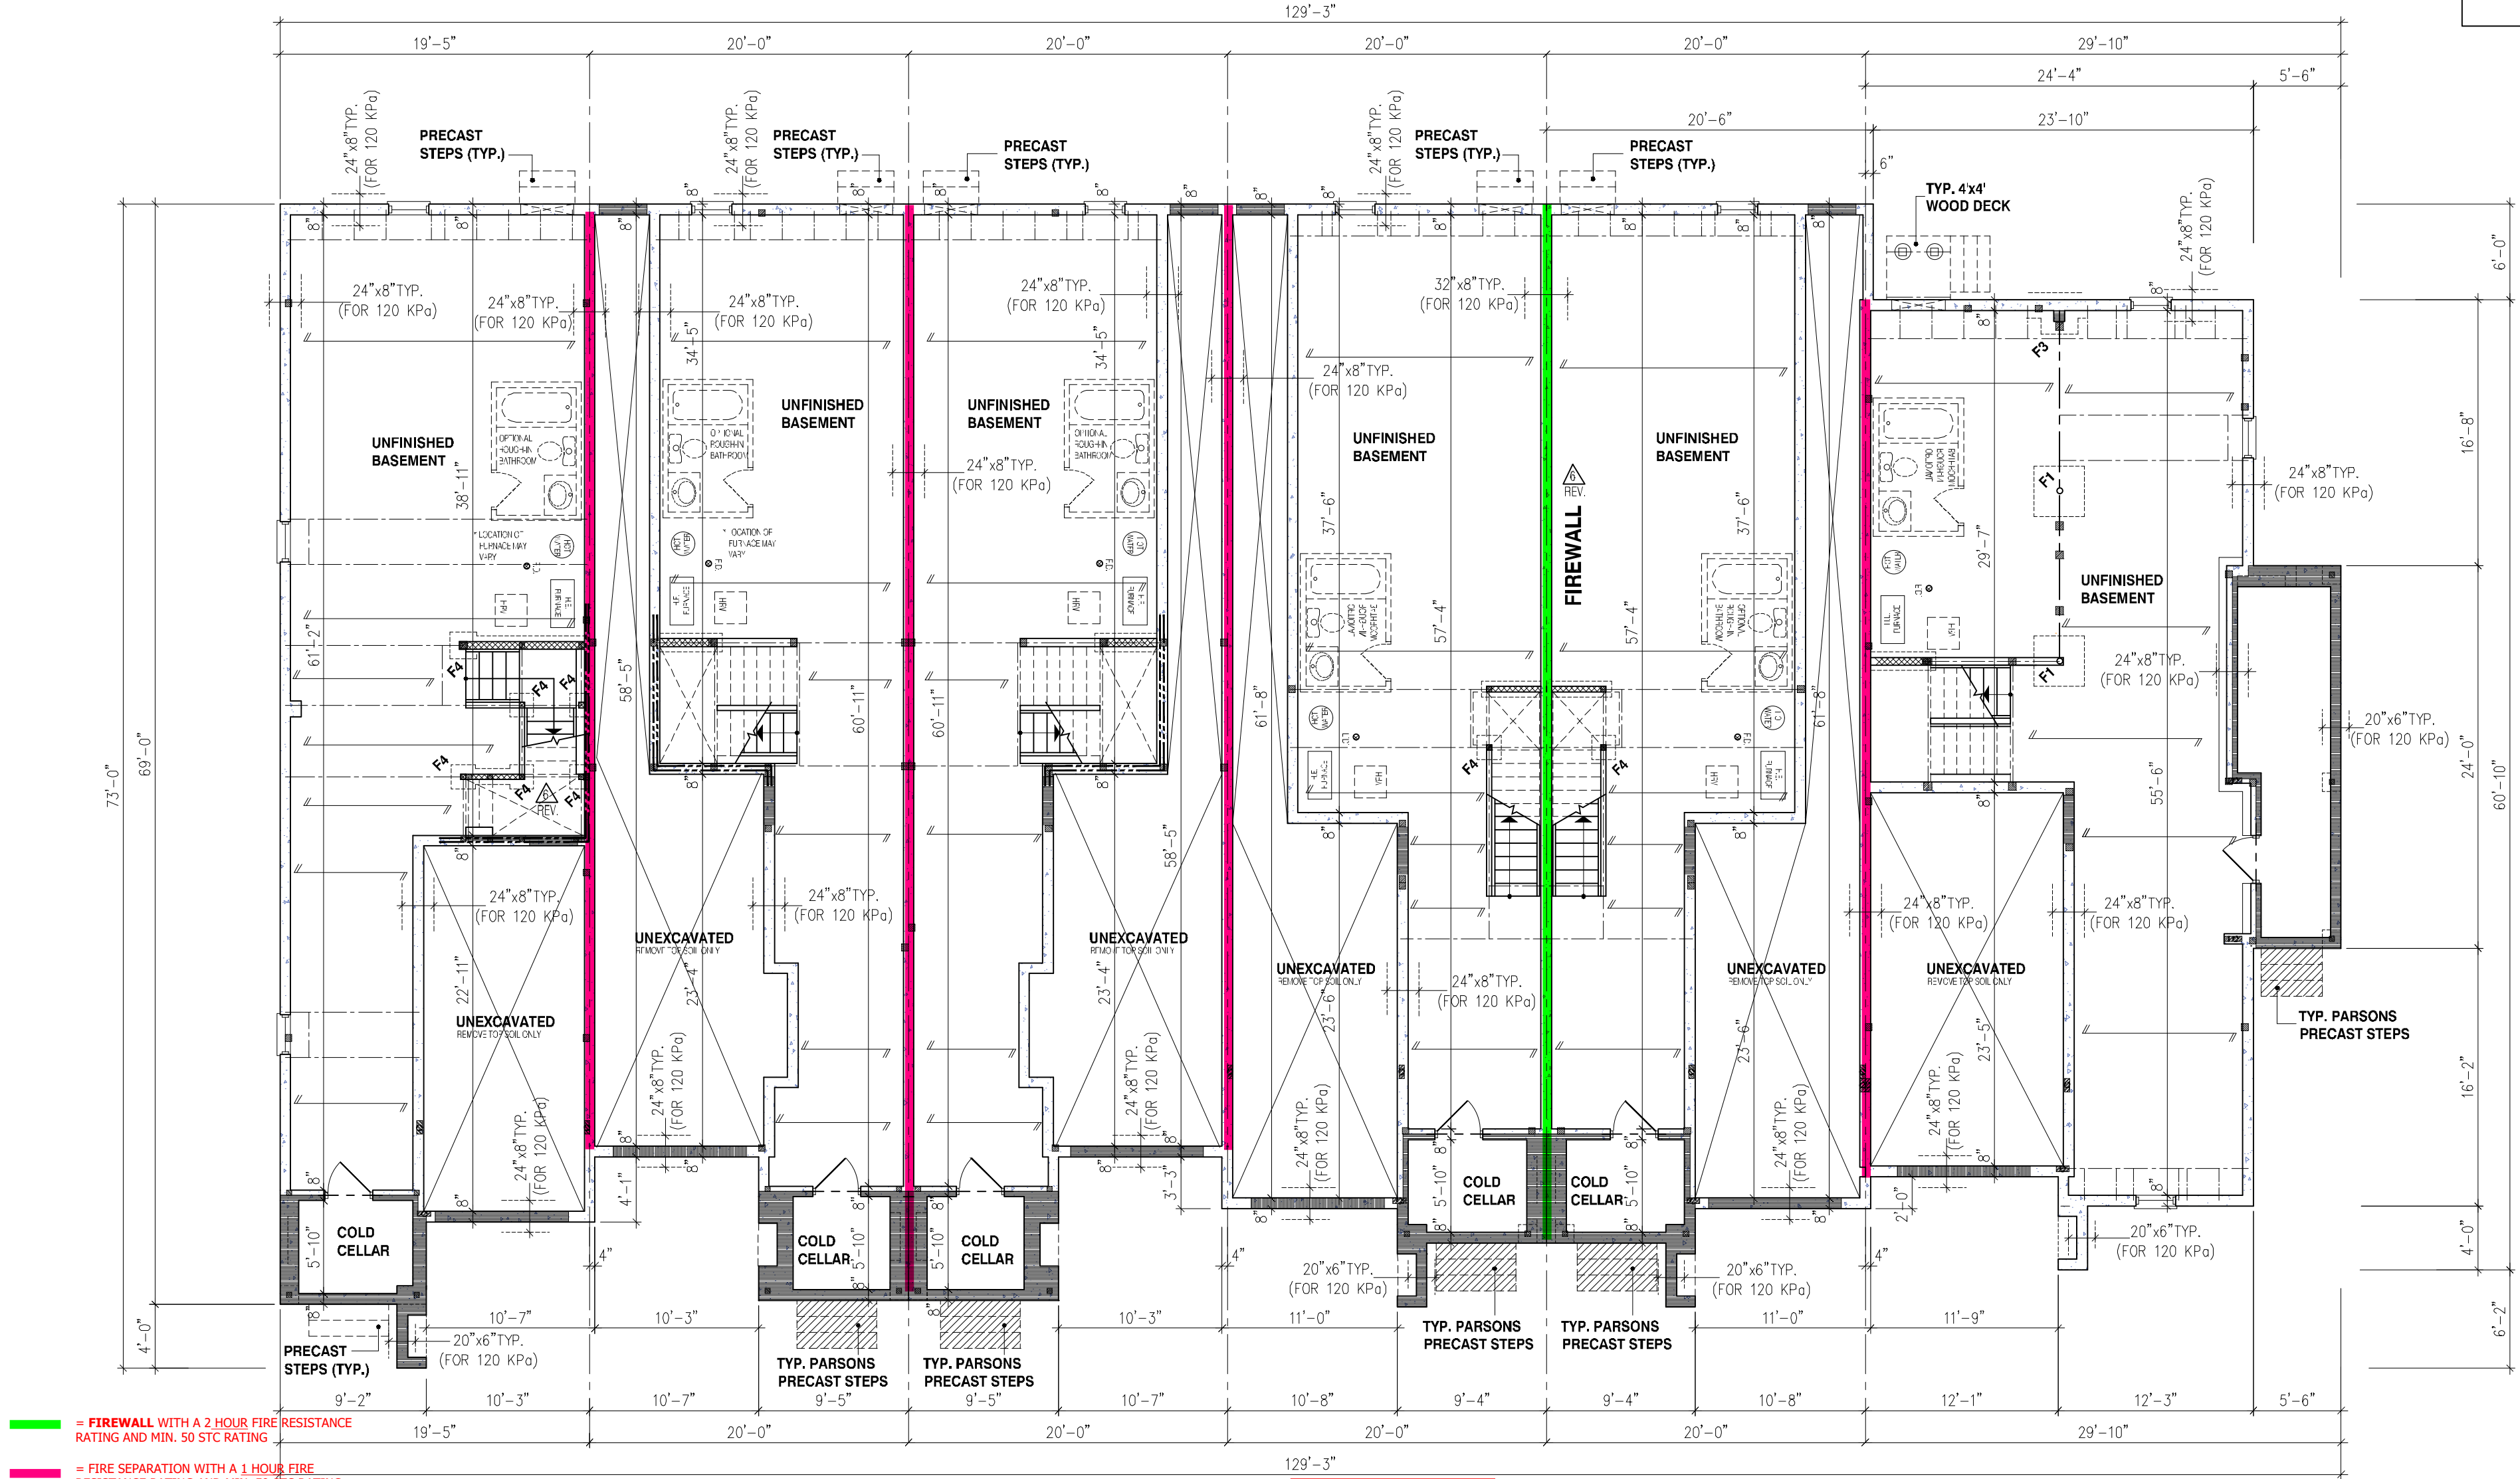

- TH-31 CHERRY 3E EL-1**
- TH-32 CHERRY 2 EL-1**
- TH-33 CHERRY 2 EL-1**
- TH-35 CHERRY 1 EL-1**
- TH-36 CHERRY 12 EL-1**

REFER TO INDIVIDUAL UNITS FOR THE FOLLOWING:

- GROUND FLOOR ROOF STRUCTURE
- BASEMENT AND GROUND FLOOR LINTELS
- GROUND FLOOR AND SECOND FLOOR STRUCTURE
- DOUBLE VOLUME WALL LOCATION AND DETAILS
- CONCRETE SLABS

NOTE:
THESE DRAWINGS ARE TO BE READ IN CONJUNCTION WITH ENGINEER APPROVED FLOOR TRUSS DRAWINGS BY MANUFACTURER

NOTE:
REFER TO GRADING PLAN FOR NUMBER OF STEPS

NOTE:
ALL GARAGE SLABS, PORCH SLABS, STAIRS (EXPOSED CONC. FLAT WORK) TO BE 32 MPa WITH 5-8% AIR ENTRAINMENT

NOTE:
WHEN VENEER CUT IS GREATER THAN 26" A 10" POURED CONC. FOUNDATION WALL IS REQUIRED. (FOUNDATION PLAN TO BE REVIEWED IN CONJUNCTION WITH SITE PLAN)

TYPICAL PAD FOOTING

120 KPa NATIVE SOIL 90 KPa ENGINEERED FILL SOIL

F1 = 42"x42"x18" CONCRETE PAD F1 = 48"x48"x20" CONCRETE PAD
F2 = 36"x36"x16" CONCRETE PAD F2 = 40"x40"x16" CONCRETE PAD
F3 = 30"x30"x12" CONCRETE PAD F3 = 34"x34"x14" CONCRETE PAD
F4 = 24"x24"x12" CONCRETE PAD F4 = 28"x28"x12" CONCRETE PAD
F5 = 18"x18"x8" CONCRETE PAD F5 = 18"x18"x8" CONCRETE PAD

(REFER TO FLOOR PLAN FOR UNUSUAL SIZE PADS NOT ON CHART)

STRIP FOOTINGS - FOR 2 STOREY CHERRY SERIES TOWNHOUSES

REFER TO FOUNDATION PLAN FOR DIMENSIONS AND FOOTING DETAIL FOR REINFORCEMENT

FOOTINGS ON NATIVE SOIL (120 kPa / 17.4 psi)
20"x6" CONCRETE STRIP FOOTINGS BELOW EXTERIOR WALLS AS NOTED ON PLANS
24"x8" CONCRETE STRIP FOOTINGS BELOW EXTERIOR WALLS (UNLESS OTHERWISE NOTED.)
24"x8" CONCRETE STRIP FOOTINGS (WITH REINF.) BELOW PARTY WALLS
32"x8" CONCRETE STRIP FOOTINGS (WITH REINF.) BELOW FIRE WALL

FOOTINGS ON ENGINEERED FILL (90 kPa / 13.0 psi)
24"x8" CONCRETE STRIP FOOTINGS - WITH REINF., AS NOTED ON PLANS
32"x8" CONCRETE STRIP FTGS BELOW EXT. WALLS - WITH REINF. (UNLESS OTHERWISE NOTED.)
32"x8" CONCRETE STRIP FOOTINGS - WITH REINF., BELOW PARTY WALLS
44"x8" CONCRETE STRIP FOOTINGS - WITH REINF., BELOW FIRE WALL

ASSUMED 120 kPa / 17.4 psi BEARING CAPACITY FOR NATIVE SOIL OR 90 kPa / 13.0 psi FOR ENGINEERED FILL TO BE VERIFIED ON SITE

WATER METER TO BE INSTALLED WITHIN 2m (6'-6") FROM THE POINT THE WATER SERVICE PIPE MEETS THE BUILDING LINE

ENERGY PERFORMANCE LABELS FOR ALL GLAZING PRODUCTS IDENTIFYING THE CERTIFIED VALUES SHALL REMAIN ON FOR REVIEW DURING CONSTRUCTION

ALL NEW WINDOWS AND SLIDING GLASS DOORS TO COMPLY WITH THE THERMAL REQUIREMENTS OF SB-12, MAX U-1.6, ER-25

MAX. HOT WATER TEMP. SHALL NOT EXCEED 49°C (120°F) EXCEPT FOR DISHWASHERS AND CLOTHES WASHERS

SIDING MATERIALS SHALL CONFORM TO SECTION 9.2.7 OF DIVISION B OR HAVE A CCMC OR BMCC APPROVAL, OR A MINISTERS RULING

FLOORING IN KITCHENS, WASHROOMS, LAUNDRY, AND STORAGE AREAS, SHALL CONSIST OF FELTED-SYNTHETIC-FIBRE FLOOR COVERING, CONCRETE, TILE, OR OTHER FLOORING PROVIDING A SIMILAR WATER RESISTANCE.

- FLOOR JOIST LAYOUTS & INSTALLATION MANUAL SHALL BE AVAILABLE AT FRAMING INSPECTION.
 - BLOCKING REQUIRED UNDER ALL POINT LOADS MUST BE TO SUITABLE BEARING.
 - SEE ATTACHED REQUIREMENTS FOR FIELD GLUED FLOORS WHERE REQUIRED.
- NO MODIFICATIONS TO FLOOR FRAMING DESIGN SHALL BE MADE UNLESS A REVISION HAS BEEN SUBMITTED FOR REVIEW AND APPROVED BY BUILDING DEPT. PRIOR TO FRAMING INSPECTION
- REINFORCING REQUIRED IN FOUNDATION WALL OR PORCH SLAB SHALL BE REVIEWED PRIOR TO POURING CONCRETE (see inspector)
- PROVIDE P.ENG APPROVED TRUSS & FLOOR DRAWINGS AND SPECIFICATIONS TO BUILDING INSPECTOR AT FRAMING INSPECTION
- MAIN BATHROOM TO HAVE STUD BLOCKING FOR FUTURE INSTALLATION OF GRAB BARS ADJACENT TO SHOWER/TUB AND TOILET
- TIGHTLY FIT ELECTRICAL BOXES WHERE BOXES ARE LOCATED ON BOTH SIDES OF A WALL PROVIDING A F.R.R., OFFSET BOXES AT LEAST ONE STUD SPACE TO MAINTAIN INTEGRITY OF FIRE SEPARATION

THE ONTARIO BUILDING CODE REQUIRES THAT A SMOKE ALARM BE INSTALLED ON EACH FLOOR LEVEL AND WITHIN EACH SLEEPING ROOM. ALL SMOKE ALARMS SHALL BE INTERCONNECTED. EACH DEVICE SHALL HAVE A VISUAL SIGNALING COMPONENT IN ADDITION TO THE TEMPORAL PATTERN IN CONFORMANCE WITH 18.5.3. OF "LIGHT, COLOUR AND PULSE CHARACTERISTICS" OF NFPA 72

A CARBON MONOXIDE DETECTOR SHALL BE LOCATED ADJACENT TO SLEEPING AREAS

FIRESTOPPING IN FIRE SEPARATION SHALL BE OF THE BATT INSULATION TYPE TO MAINTAIN REQUIRED STC RATING

UNPROTECTED COMBUSTIBLE PIPING NOT ALLOWED TO PENETRATE A FIRE SEPARATION OR A MEMBRANE FORMING PART OF AN ASSEMBLY REQUIRED TO PROVIDE A FIRE-RESISTANCE RATING

SINGLES - WEEPING TILE REQ'D AROUND EACH UNIT CONNECTED TO SEPARATE SUMPS/DRYWELLS
TOWNHOUSES - WEEPING TILE MAY CIRCLE ENTIRE BUILDING AND BE CONNECTED TO 1 SUMP/DRYWELL

A SEPARATE PERMIT IS REQUIRED FOR THE FINISHING OF ALL ROUGH PLUMBING FIXTURES

STRUDET INC.

REGISTERED PROFESSIONAL ENGINEER
B. MARINKOVIC
January 11, 2023
FOR STRUCTURE ONLY

10	
9	
8	
7	
6	
5	JAN. 5, 2023 REV. AS PER CITY COMMENTS
4	AUG. 31, 2022 ISSUED FOR PERMIT
3	AUG. 29, 2022 COORDINATED FLOOR, ROOF AND ENGINEER COMMENTS
2	JUN. 20, 2022 PREPARED TO PRE-COORDINATION STAGE & ISSUED TO CLIENT
1	MAR. 28, 2022 ISSUED TO CLIENT FOR BROCHURE
	MAR. 8, 2022 PREPARED AND ISSUED TO CLIENT FOR A.C. PRELIMINARY REVIEW
No:	DATE WORK DESCRIPTION:

jardin
DESIGN GROUP INC
64 JARDIN DR. SUITE 3A
VAUGHAN ONT. L4K 3P3
TEL: 905 660-3377 FAX: 905 660-3713
EMAIL: info@jardindesign.ca

The undersigned has reviewed and takes responsibility for this design and has the qualifications and meets the requirements set out in the Ontario Building Code to be a designer

QUALIFICATION INFORMATION
Required unless design is exempt under Division C, Subsection 3.2.5 of the building code

Walter Botter 27031
NAME REGISTRATION INFORMATION BCIN

Required unless design is exempt under Division C, Subsection 3.2.4 of the building code

jardin design group inc. 27763
FIRM NAME BCIN

BASEMENT PLAN ELEV-1


BARLASSINA CONSTRUCTION
CAMBRIDGE, ONTARIO

BILD

TYPE T AREA ---
SCALE: 1/8" = 1'-0"
PROJ. No. 21-35 DWG. No. 1

6.10m TOWNS
CHERRY
MODELS
TH-31 TO TH-36

It is the builder's complete responsibility to ensure that all plans submitted for approval fully comply with the Architectural Guidelines and all applicable regulations and ensure that all necessary permits and approvals are obtained prior to construction. The Council of the City of Cambridge is not responsible for any error or omission in the drawings or for any error or omission in the construction of the building. This is to certify that these plans comply with the applicable Architectural Guidelines approved by the City of Cambridge.

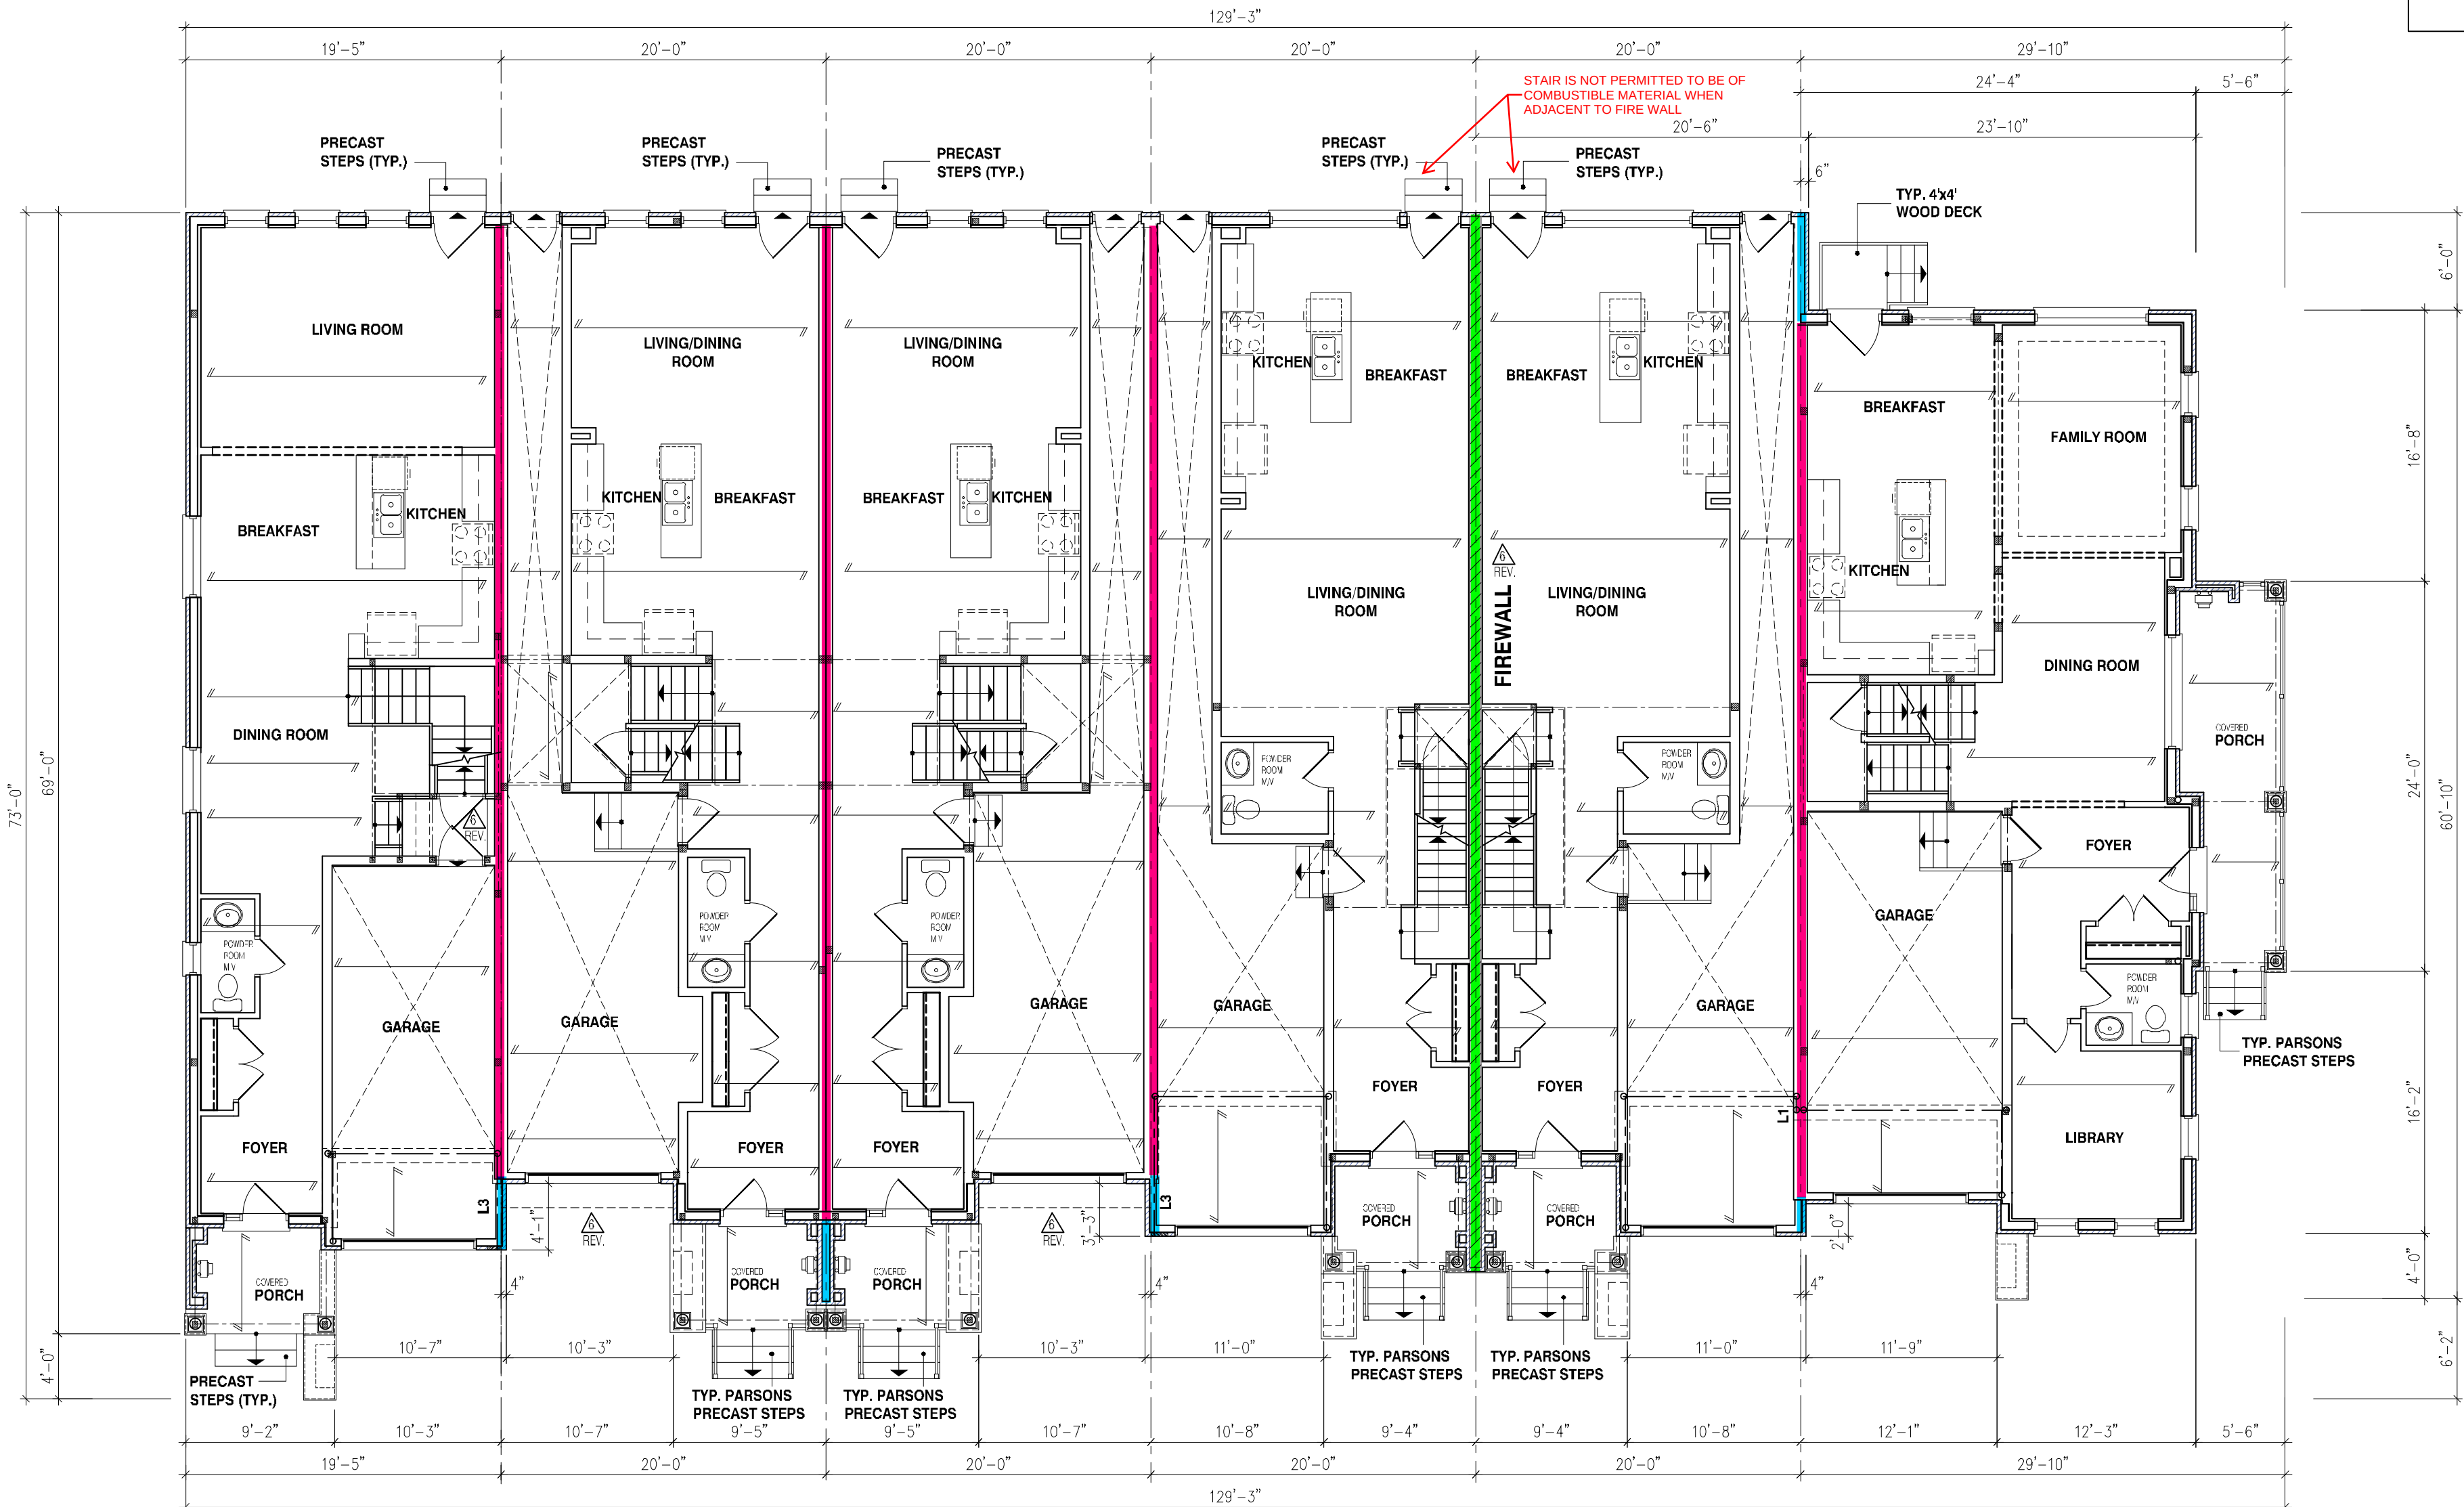

TH-31
CHERRY 3E
EL-1

TH-32
CHERRY 2
EL-1

TH-33
CHERRY 2
EL-1

TH-34
CHERRY 1
EL-1

TH-35
CHERRY 1
EL-1

TH-36
CHERRY 12
EL-1

BLOCK 119

REFER TO INDIVIDUAL UNIT
DRAWINGS FOR
CONSTRUCTION INFORMATION.

BUILDING AREA	
IN ACCORDANCE WITH OBC, DIV. A 1.4.1.2.	
BLOCK 119 EL-1 TH-31 TO TH-34	
BUILDING AREA =	4890 SQ. FT.
	= 454.30 m ²

BUILDING AREA	
IN ACCORDANCE WITH OBC, DIV. A 1.4.1.2.	
BLOCK 119 EL-1 TH-35 TO TH-36	
BUILDING AREA =	2580 SQ. FT.
	= 239.69 m ²

NOTE:
REFER TO INDIVIDUAL PLANS FOR
STANDARD WOOD, STEEL BEAMS AND
LINTELS OVER WINDOWS

NOTE:
THESE DRAWINGS ARE TO BE READ IN
CONJUNCTION WITH ENGINEER
APPROVED ROOF TRUSS DRAWINGS BY
MANUFACTURER

STEEL LINTELS:

L1 = 3 1/2" x 3 1/2" x 1/4" (90 x 90 x 6)
L2 = 4" x 3 1/2" x 5/16" (100 x 90 x 8)
L3 = 5" x 3 1/2" x 5/16" (125 x 90 x 8)
L4 = 6" x 3 1/2" x 3/8" (150 x 90 x 10)
L5 = 6" x 4" x 3/8" (150 x 100 x 10)
L6 = 7" x 4" x 3/8" (180 x 100 x 10)

BRICK VENEER LINTELS:

WL1 = 3 1/2" x 3 1/2" x 1/4" (90 x 90 x 6) - 2" x 8" SPR.
WL2 = 4" x 3 1/2" x 5/16" (100 x 90 x 8) - 2" x 8" SPR.
WL3 = 5" x 3 1/2" x 5/16" (125 x 90 x 8) - 2" x 10" SPR.
WL4 = 6" x 3 1/2" x 3/8" (150 x 90 x 10) - 2" x 12" SPR.
WL5 = 6" x 4" x 3/8" (150 x 100 x 10) - 2" x 12" SPR.
WL6 = 5" x 3 1/2" x 5/16" (125 x 90 x 8) - 2" x 10" SPR.
WL7 = 5" x 3 1/2" x 5/16" (125 x 90 x 8) - 3" x 10" SPR.
WL8 = 5" x 3 1/2" x 5/16" (125 x 90 x 8) - 3" x 12" SPR.
WL9 = 6" x 4" x 3/8" (150 x 100 x 10) - 3" x 12" SPR.

WOOD LINTELS:


WB1 = 2" x 8" SPRUCE BEAM
WB2 = 3" x 8" SPRUCE BEAM
WB3 = 2" x 10" SPRUCE BEAM
WB4 = 3" x 10" SPRUCE BEAM
WB5 = 2" x 12" SPRUCE BEAM
WB6 = 3" x 12" SPRUCE BEAM
WB7 = 5" x 12" SPRUCE BEAM
WB8 = 4" x 8" SPRUCE BEAM
WB9 = 4" x 10" SPRUCE BEAM
WB10 = 4" x 12" SPRUCE BEAM
WB11 = 4" x 10" SPRUCE BEAM
WB12 = 4" x 12" SPRUCE BEAM
LSL = TIMBERSTRAND BOARD

FIRST FLOOR PLAN ELEV-1	
BARLASSA CONSTRUCTION CAMBRIDGE, ONTARIO	
TYPE	T
SCALE	1/8" = 1'-0"
PROJ. No.	21-35
DWG. No.	2

NOT THE GRANTING OF A PERMIT NOR REVIEWING OF SPECS
& DRAWINGS NOR INSPECTIONS MADE DURING INSTALLATION
BY THE OFFICIAL HAVING JURISDICTION SHALL RELIEVE THE
OWNER FROM REQUIREMENTS OF THE ONTARIO BUILDING
CODE AND ANY OTHER REFERENCED REQUIREMENTS.

6.10m TOWNS
CHERRY
MODELS
TH-31 TO TH-36

It is the builder's complete responsibility to ensure that all items submitted for approval comply with the applicable building code and all applicable regulations and standards in the jurisdiction. The Contractor is not responsible for any error or omission of any kind in the drawings or specifications. The Contractor is to verify the accuracy of all information and to ensure that all items submitted for approval are in accordance with the applicable building code and all applicable regulations and standards in the jurisdiction. The Contractor is to verify the accuracy of all information and to ensure that all items submitted for approval are in accordance with the applicable building code and all applicable regulations and standards in the jurisdiction.

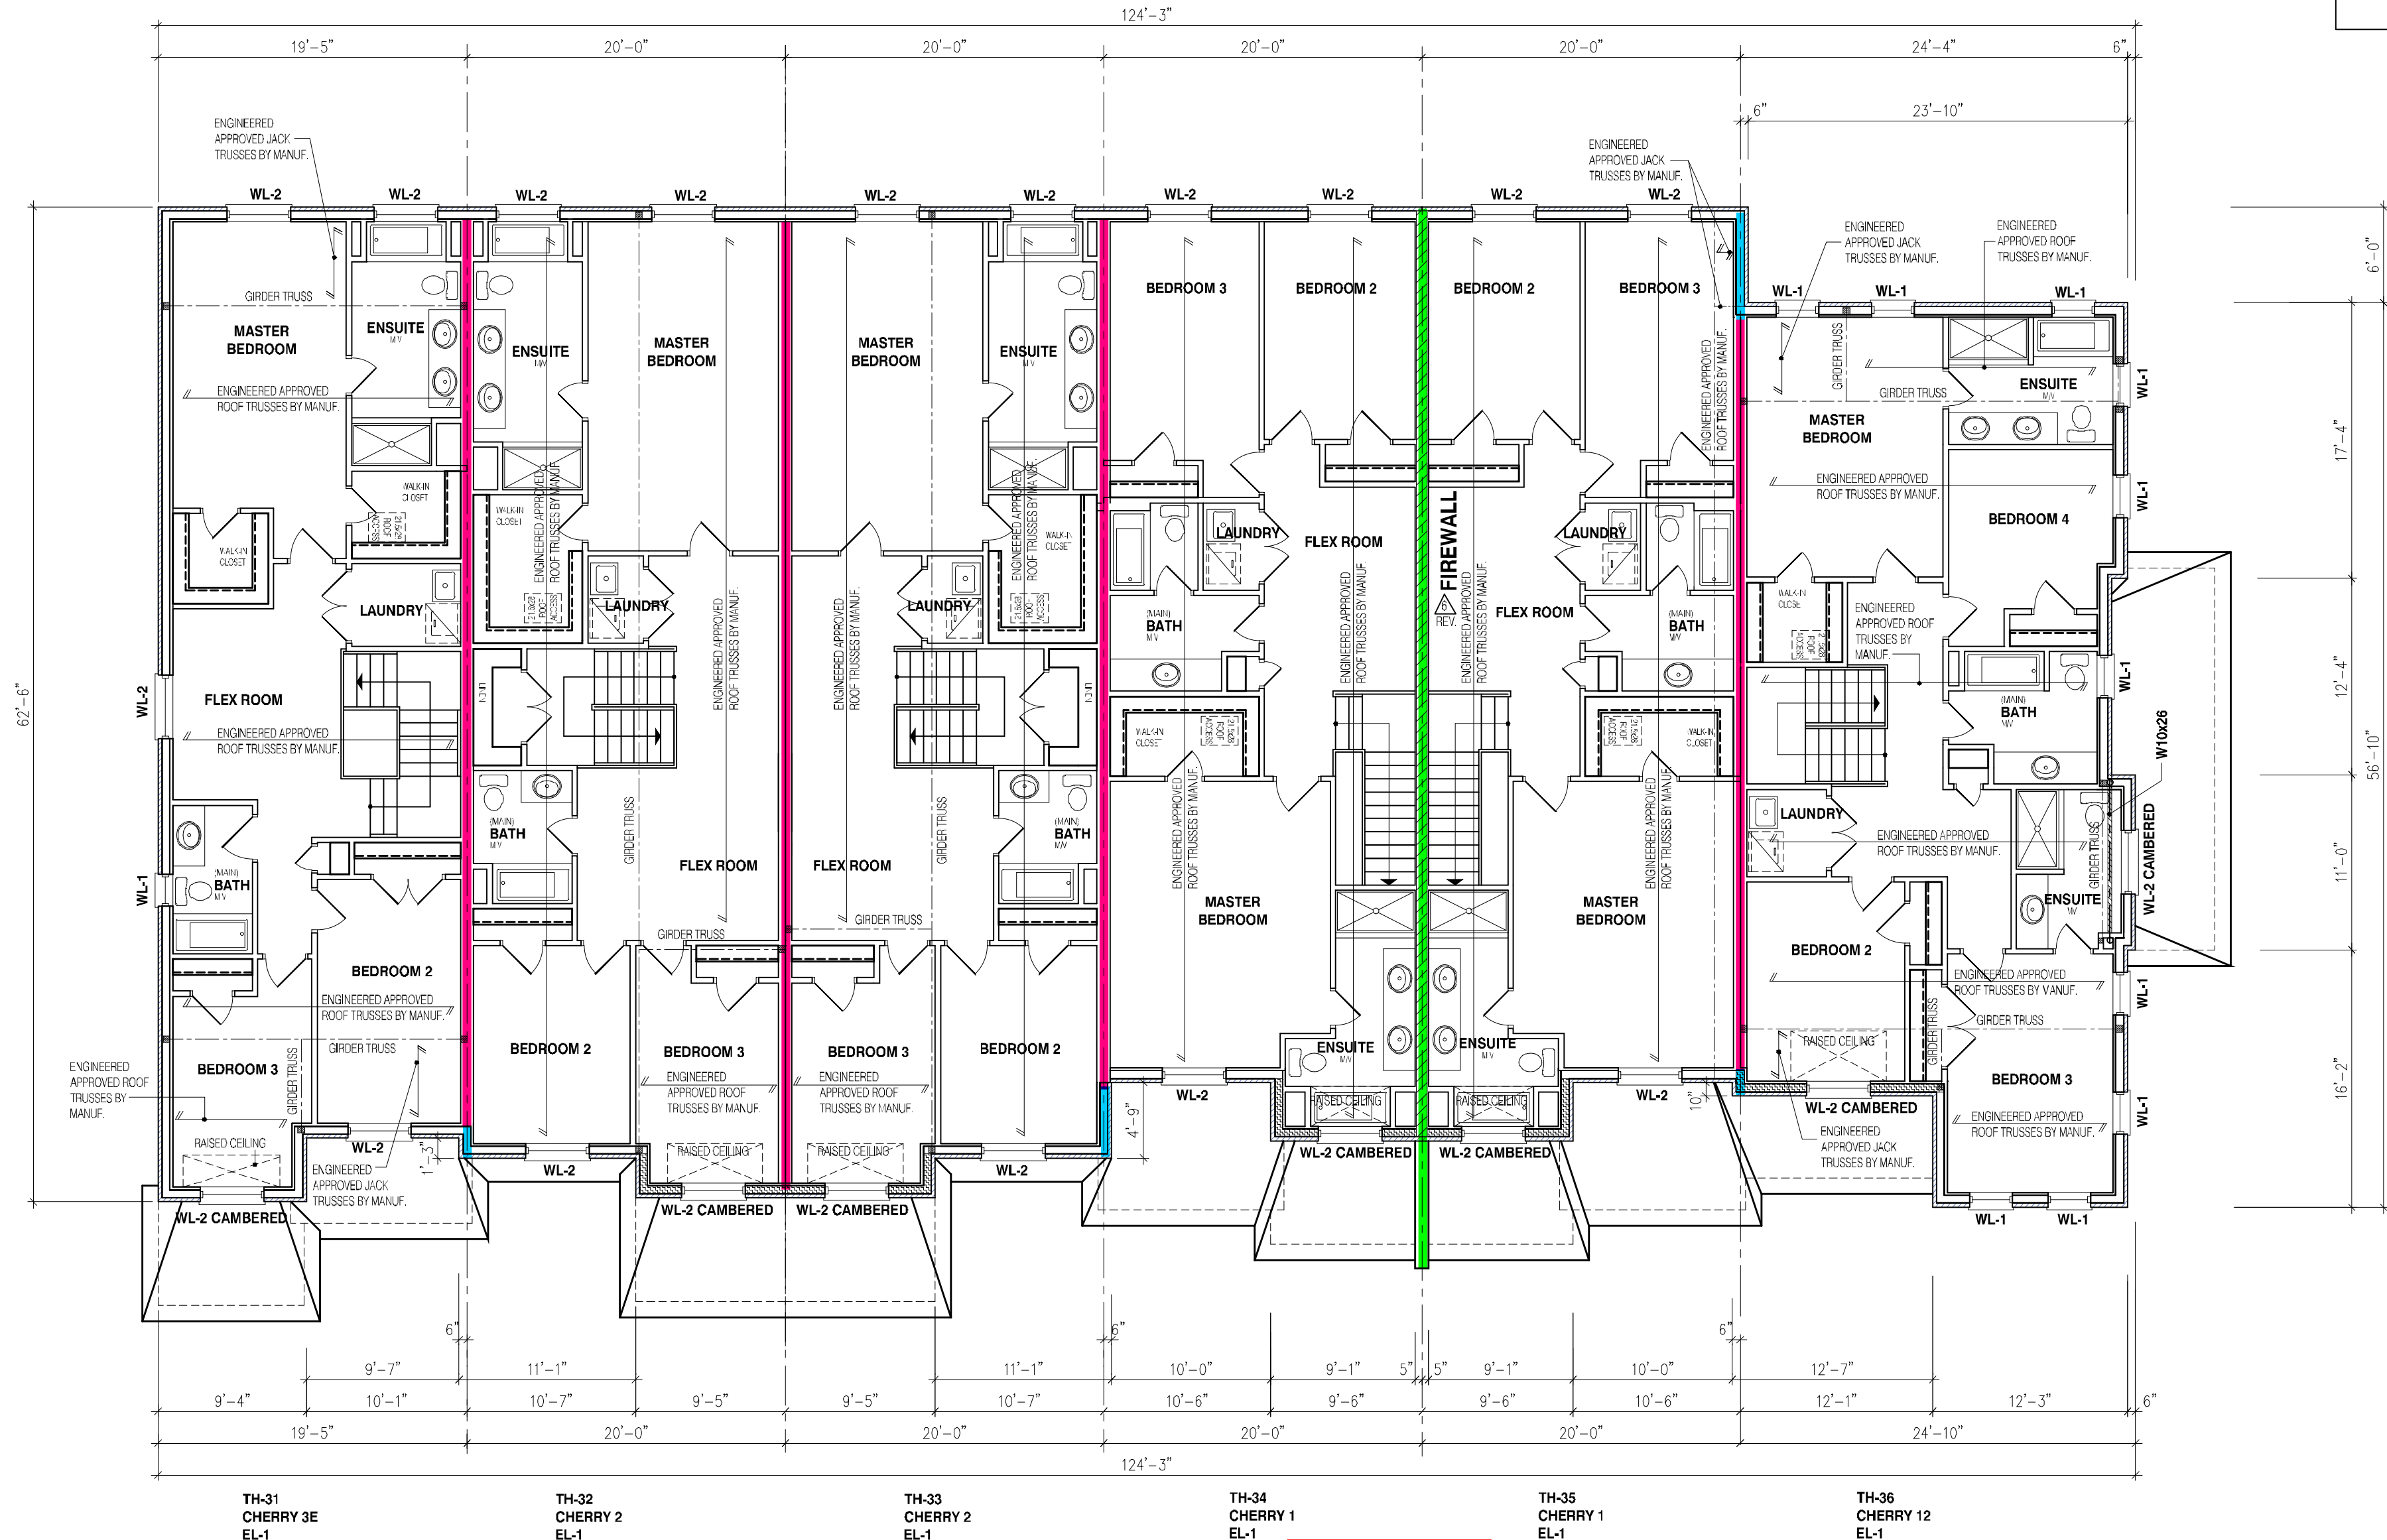

TH-31
CHERRY 3E
EL-1

TH-32
CHERRY 2
EL-1

TH-33
CHERRY 2
EL-1

TH-34
CHERRY 1
EL-1

TH-35
CHERRY 1
EL-1

TH-36
CHERRY 12
EL-1

BLOCK 119

REFER TO INDIVIDUAL UNIT
DRAWINGS FOR
CONSTRUCTION INFORMATION.

NOT THE GRANTING OF A PERMIT NOR REVIEWING OF SPECS & DRAWINGS NOR INSPECTIONS MADE DURING INSTALLATION BY THE OFFICIAL HAVING JURISDICTION SHALL RELIEVE THE OWNER FROM REQUIREMENTS OF THE ONTARIO BUILDING CODE AND ANY OTHER REFERENCED REQUIREMENTS.

NOTE:
REFER TO INDIVIDUAL PLANS FOR
STANDARD WOOD, STEEL BEAMS AND
LINTELS OVER WINDOWS

NOTE:
THESE DRAWINGS ARE TO BE READ IN
CONJUNCTION WITH ENGINEER
APPROVED ROOF TRUSS DRAWINGS BY
MANUFACTURER

STEEL LINTELS:
L1 = 3 1/2" x 3 1/2" x 1 1/4" (90 x 90 x 6)
L2 = 4" x 3 1/2" x 5/16" (100 x 90 x 8)
L3 = 5" x 3 1/2" x 5/16" (125 x 90 x 8)
L4 = 6" x 3 1/2" x 3/8" (150 x 90 x 10)
L5 = 6" x 4" x 3/8" (150 x 100 x 10)
L6 = 7" x 4" x 3/8" (180 x 100 x 10)

BRICK VENEER LINTELS:
WL1 = 3 1/2" x 3 1/2" x 1 1/4" (90 x 90 x 6) - 2" x 8" SPR.
WL2 = 4" x 3 1/2" x 5/16" (100 x 90 x 8) - 2" x 8" SPR.
WL3 = 5" x 3 1/2" x 5/16" (125 x 90 x 8) - 2" x 10" SPR.
WL4 = 6" x 3 1/2" x 3/8" (150 x 90 x 10) - 2" x 12" SPR.
WL5 = 6" x 4" x 3/8" (150 x 100 x 10) - 2" x 12" SPR.
WL6 = 5" x 3 1/2" x 5/16" (125 x 90 x 8) - 2" x 12" SPR.
WL7 = 5" x 3 1/2" x 5/16" (125 x 90 x 8) - 2" x 10" SPR.
WL8 = 5" x 3 1/2" x 5/16" (125 x 90 x 8) - 2" x 12" SPR.
WL9 = 6" x 4" x 3/8" (150 x 100 x 10) - 1 3/4" x 12" SPR.

WOOD LINTELS:
WB1 = 2" x 8" SPRUCE BEAM
WB2 = 3" x 8" SPRUCE BEAM
WB3 = 2" x 10" SPRUCE BEAM
WB4 = 3" x 10" SPRUCE BEAM
WB5 = 2" x 12" SPRUCE BEAM
WB6 = 3" x 12" SPRUCE BEAM
WB7 = 5" x 2" x 12" SPRUCE BEAM
WB8 = 4" x 2" x 12" SPRUCE BEAM
WB9 = 4" x 2" x 12" SPRUCE BEAM
WB10 = 4" x 2" x 12" SPRUCE BEAM
WB11 = 4" x 2" x 12" SPRUCE BEAM
WB12 = 4" x 2" x 12" SPRUCE BEAM
LSL = TIMBERSTRAND BOARD


SECOND FLOOR PLAN ELEV-1

BARLASSINA CONSTRUCTION
CAMBRIDGE, ONTARIO

TYPE T AREA ---
SCALE: 1/8" = 1'-0"
PROJ. No. 21-35 TAG. No. 3

It is the Auditor's complete responsibility to ensure that all plans submitted for approval fully comply with the Architectural Guidelines and all applicable building codes and requirements. The Auditor is not responsible for any error or omission of any kind, including but not limited to, the accuracy or completeness of the information provided, the appropriateness of the design, or the appropriateness of the materials or construction methods. The Auditor is not responsible for any error or omission of any kind, including but not limited to, the accuracy or completeness of the information provided, the appropriateness of the design, or the appropriateness of the materials or construction methods.

6.10m TOWNS CHERRY MODELS TH-31 TO TH-36

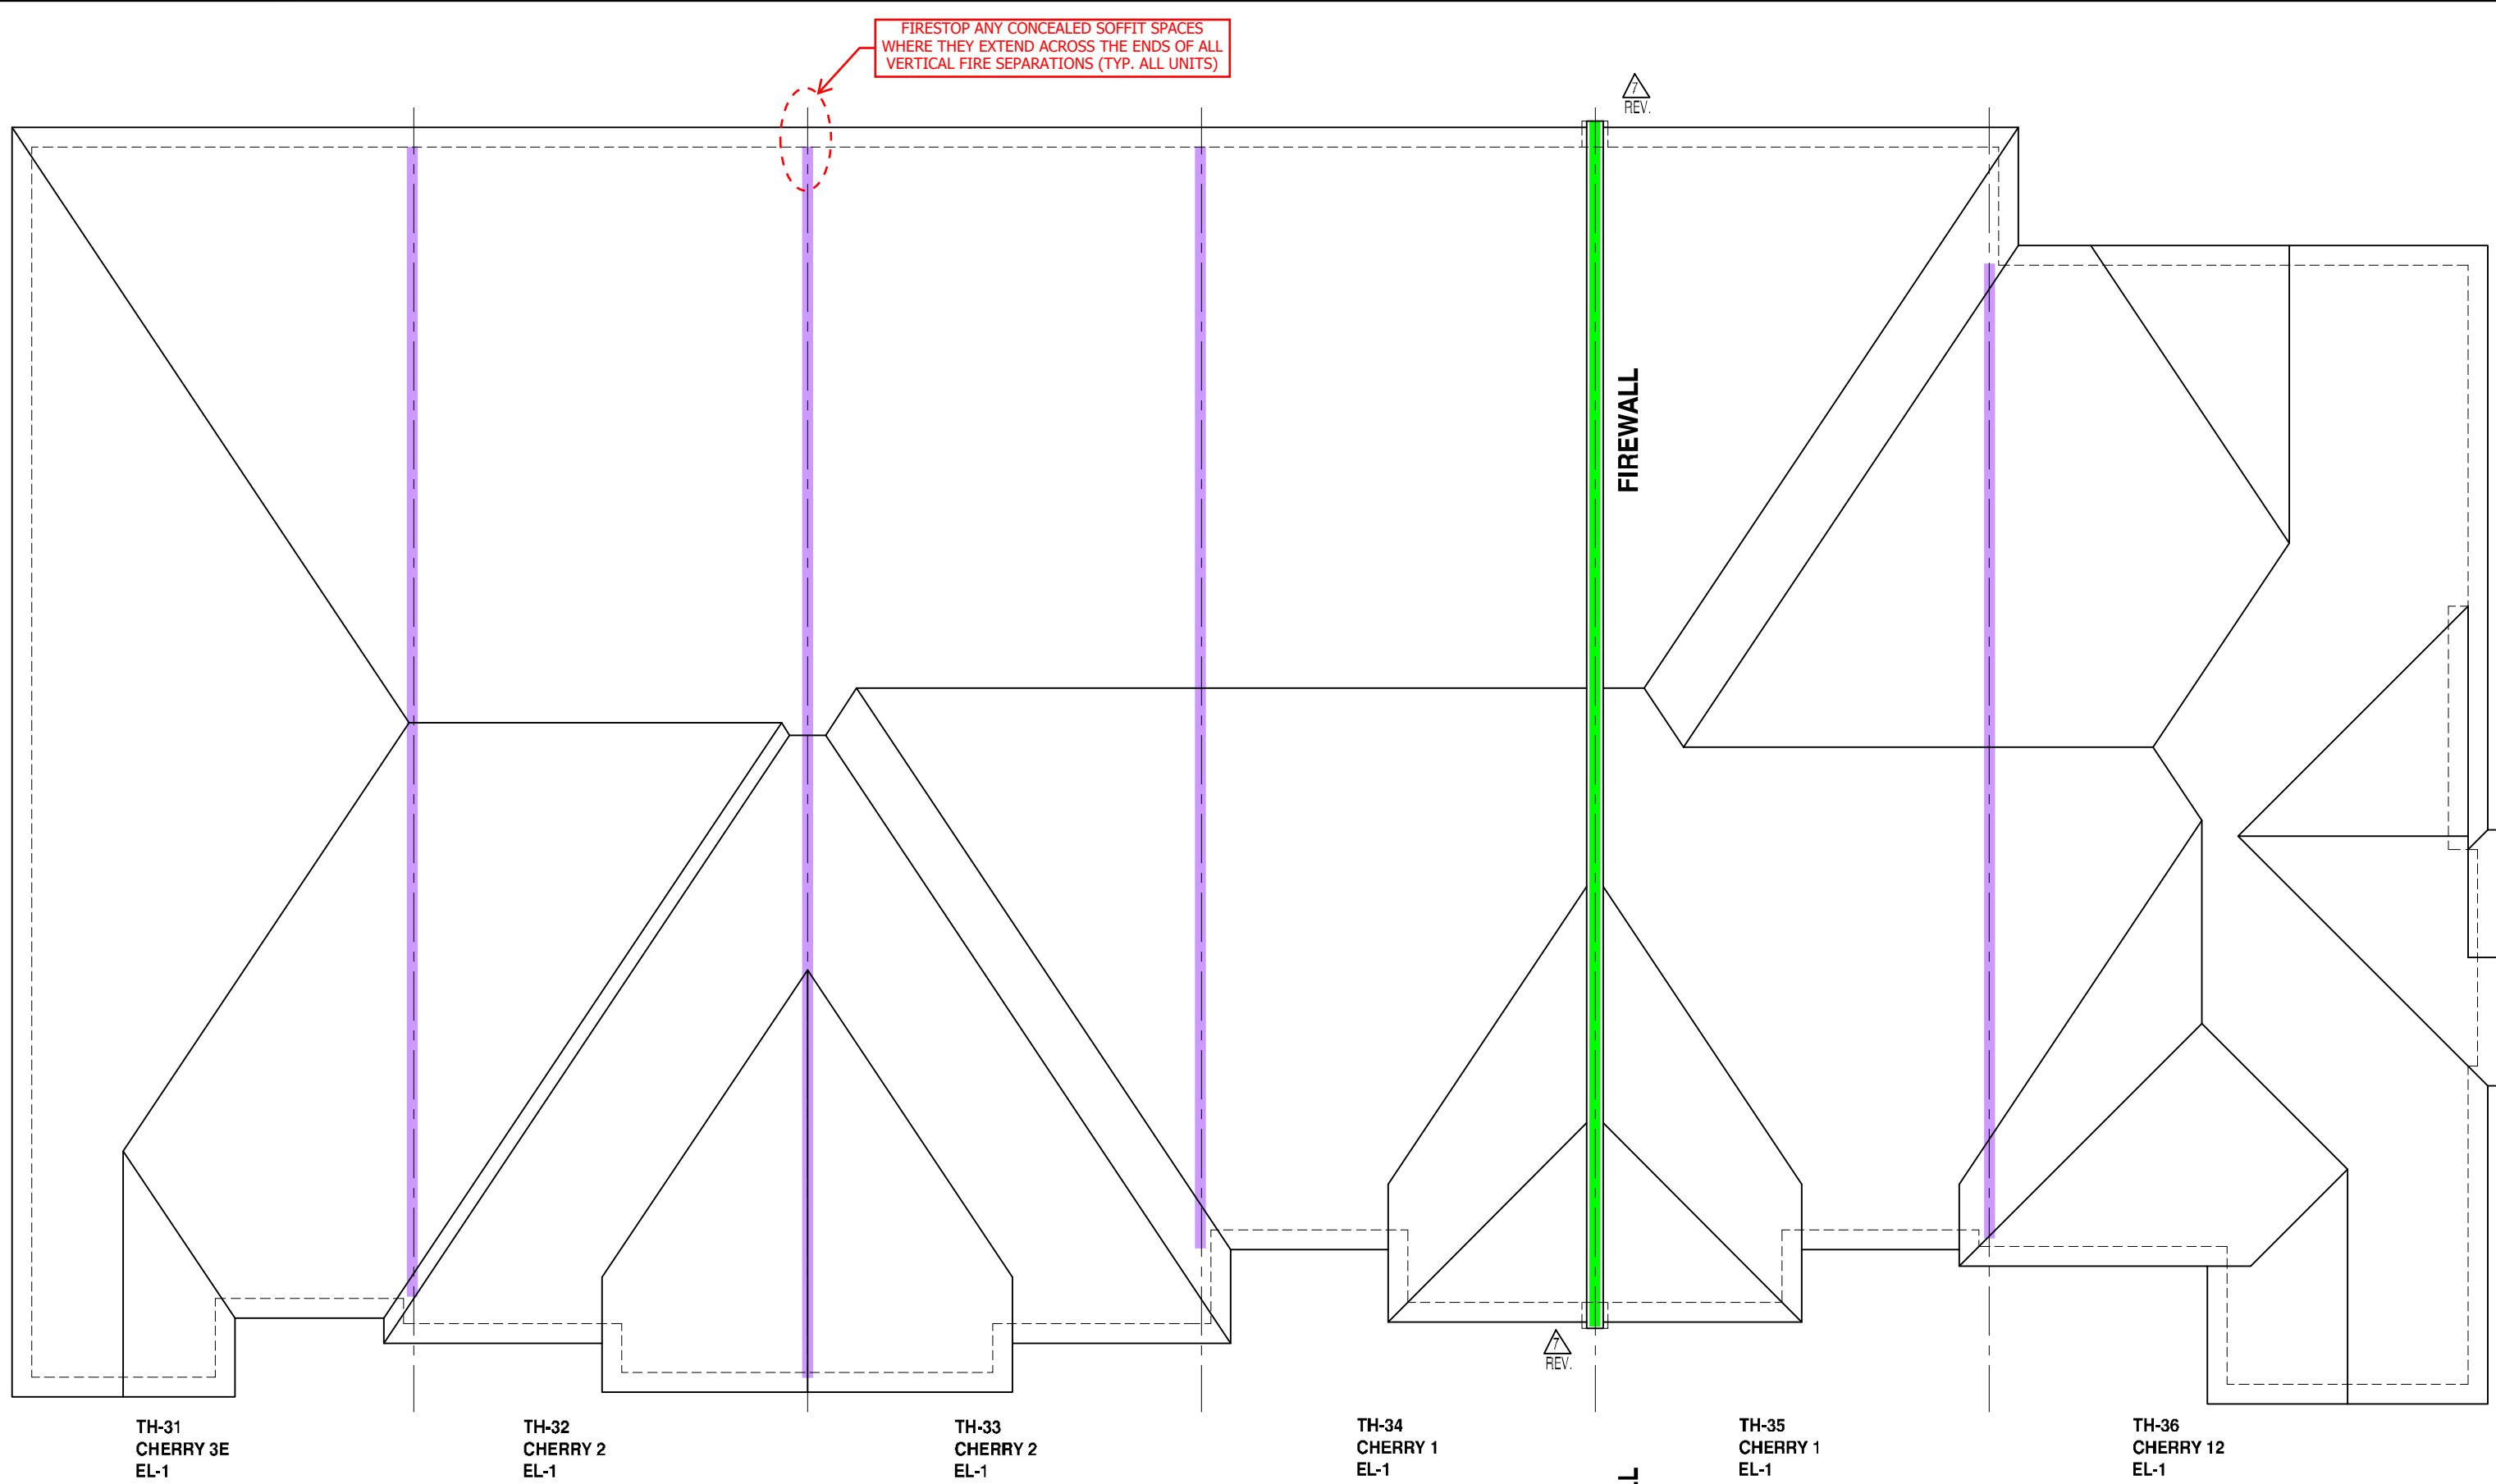

ROOF PLAN ELEVATION 1



BLOCK 119
FRONT ELEVATION 1

ENSURE P.ENG STAMPED RAILING DOCUMENTATION AND ATTACHMENT DETAILS ARE AVAILABLE FOR REVIEW BY THE INSPECTOR

EXTERIOR CONCRETE STAIRS w/ MORE THAN 2 RISERS TO MEET THE REQUIREMENTS OF 9.8.9.2.(1)

NOT THE GRANTING OF A PERMIT NOR REVIEWING OF SPECS & DRAWINGS NOR INSPECTIONS MADE DURING INSTALLATION BY THE OFFICIAL HAVING JURISDICTION SHALL RELIEVE THE OWNER FROM REQUIREMENTS OF THE ONTARIO BUILDING CODE AND ANY OTHER REFERENCED REQUIREMENTS.

10	
9	
8	
7	
6	
5	
4	
3	
2	
1	
0	

jardin
DESIGN GROUP INC
64 JARDIN DR. SUITE 3A
VAUGHAN, ONT. L4K 3P3
TEL: 905 660-3377 FAX: 905 660-3713
EMAIL: info@jardindesign.ca

The undersigned has reviewed and takes responsibility for this design and has the qualifications and meets the requirements set out in the Ontario Building Code to be a designer.

QUALIFICATION INFORMATION
Required unless design is exempt under Division C, Subsection 3.2.5 of the building code

Walter Botter
NAME
SIGNATURE
REGISTRATION INFORMATION
Required unless design is exempt under Division C, Subsection 3.2.4 of the building code

jardin design group inc.
FIRM NAME

FRONT & ROOF PLAN ELEV-1

BARLASSINA CONSTRUCTION
CAMBRIDGE, ONTARIO

SCALE	T	AREA	----
SCALE	1/8"=1'-0"		
PROJ. No.	21-35	DWG. No.	4


6.10m TOWNS
CHERRY
MODELS
TH-31 TO TH-36

It is the builder's complete responsibility to ensure that all plans submitted for approval fully comply with the Architectural Guidelines and all applicable regulations and requirements in the subdivision agreement. The Council and/or its staff are not responsible in any way for obtaining or approving any zoning permits or other approvals with respect to any proposed building or use of property that may be required for the proposed building or use of property.

This is to certify that these plans comply with the applicable Architectural Guidelines approved by the City of Cambridge.



BLOCK 119
REAR ELEVATION 1

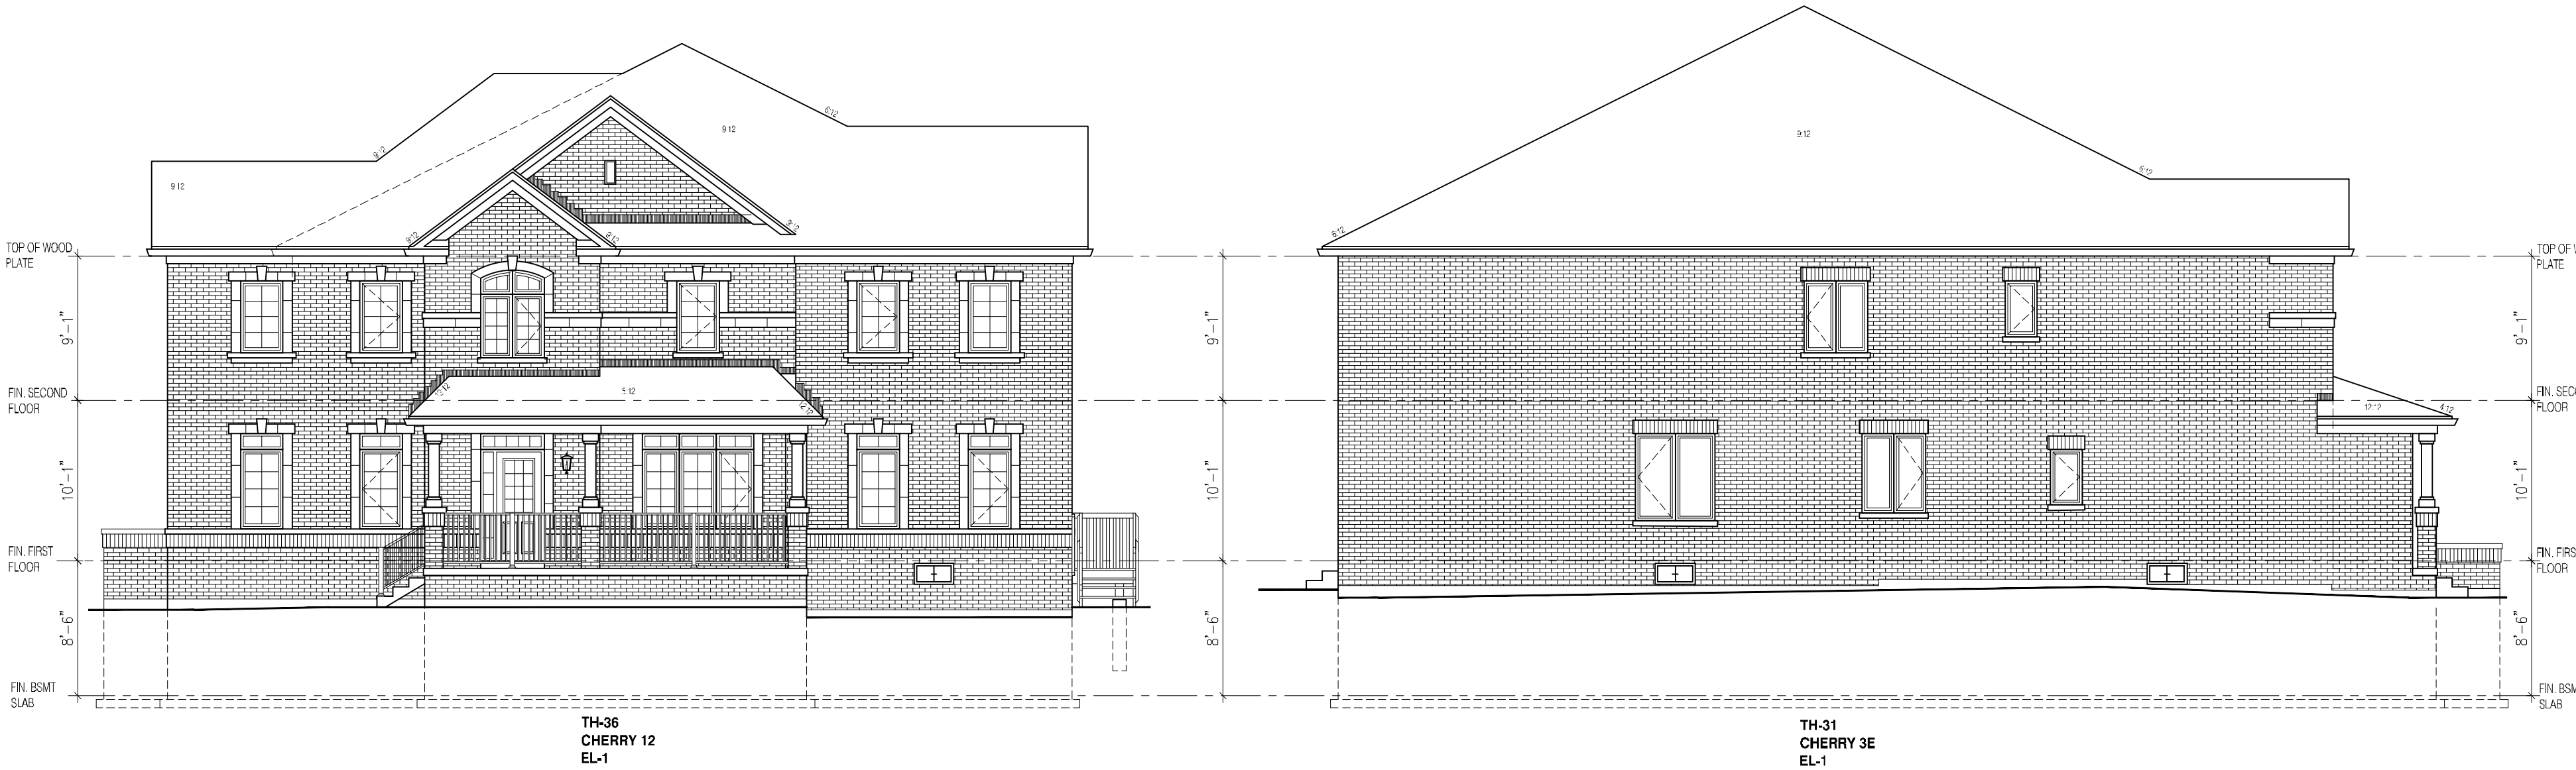

THIS DRAWING, OR ANY PART OF IT, IS NOT TO BE USED FOR ANY OTHER PROJECT WITHOUT THE WRITTEN PERMISSION OF JARDIN DESIGN GROUP INC. ANY DISCREPANCIES SHALL BE REPORTED TO JARDIN DESIGN GROUP INC. PRIOR TO COMMENCEMENT OF WORK.

JARDIN DESIGN GROUP INC. IS NOT RESPONSIBLE FOR THE ACCURACY OF SURVEY, STRUCTURAL OR ENGINEERING INFORMATION SHOWN ON THESE DRAWINGS OR FOR ANY INFORMATION OBTAINED PRIOR TO THE ISSUANCE OF A BUILDING PERMIT. REFER TO THE APPROPRIATE ENGINEERING DRAWINGS DETAILING PROCEEDING WITH WORK.

AS CONSTRUCTION IN PROGRESS MUST BE VERIFIED PRIOR TO FILING, REVISIONS.

JARDIN DESIGN GROUP INC. HAS NOT BEEN RETAINED TO CARRY OUT GENERAL REVIEW OF THE WORK AND ASSUMES NO RESPONSIBILITY FOR THE FAILURE OF THE CONTRACTOR OR SUB-CONTRACTOR TO CARRY OUT THE WORK IN ACCORDANCE WITH THE CONTRACT DOCUMENTS.

THIS DRAWING IS AN INSTRUMENT OF SERVICE, IS PROVIDED BY AND IS THE PROPERTY OF JARDIN DESIGN GROUP INC. THIS DRAWING IS NOT TO BE SCALED.

10		
9		
8		
7	FEB. 8, 2023	REV. FIREWALL CORRELATING TO FRONT & REAR ELEV. & ROOF PLAN, REISSUED FOR PERMIT.
6		
5	AUG. 31, 2022	ISSUED FOR BUILDING PERMIT
4	AUG. 29, 2022	COORDINATED FLOOR, ROOF AND ENGINEER COMMENTS
3	JUN. 20, 2022	PREPARED TO PRE-COORDINATION STAGE & ISSUED TO CLIENT
2	MAR. 28, 2022	ISSUED TO CLIENT FOR BROCHURE
1	MAR. 8, 2022	PREPARED AND ISSUED TO CLIENT FOR A.C. PRELIMINARY REVIEW

No. DATE: WORK DESCRIPTION:

jardin
DESIGN GROUP INC.
64 JARDIN DR. SUITE 3A
VAUGHAN ONT. L4K 3P3
TEL: 905 660-3377 FAX: 905 660-3713
EMAIL: info@jardindesign.ca

The undersigned has reviewed and takes responsibility for this design and has the qualifications and meets the requirements set out in the Ontario Building Code to be a designer.

QUALIFICATION INFORMATION
Required unless design is exempt under Division C, Subsection 3.2.3 of the building code.

Walter Botter 21031
NAME SIGNATURE BCIN

REGISTRATION INFORMATION
Required unless design is exempt under Division C, Subsection 3.2.4 of the building code.

Jardin design group inc. 27763
FIRM NAME BCIN

SIDES & REAR ELEV-1		
BARLASSINA CONSTRUCTION CAMBRIDGE, ONTARIO		
	TYPE	T
	AREA	----
	SCALE:	1/8" = 1'-0"
PROJ. No.	21-35	DWG. No.
		5

NOT THE GRANTING OF A PERMIT NOR REVIEWING OF SPECS & DRAWINGS NOR INSPECTIONS MADE DURING INSTALLATION BY THE OFFICIAL HAVING JURISDICTION SHALL RELIEVE THE OWNER FROM REQUIREMENTS OF THE ONTARIO BUILDING CODE AND ANY OTHER REFERENCED REQUIREMENTS.