

CONSTRUCTION SUMMARY

Hazel Glenn - Barlassina Construction Inc.

PURCHASERS: Amrinder SINGH and DEEPESH KUMAR

TEL: RES.: 905-783-4390

LOT / PHASE Block 119 TH31 / 1	REG. PLAN #	HOUSE TYPE Cherry 3E Elev 1		
-----------------------------------	-------------	--------------------------------	--	--

ELECTRICAL

1 - ELECTRIC VEHICLE ROUGH-IN PROVISION ONLY FOR FUTURE ELECTRIC CAR (CONDUIT FROM BASEMENT INTO JUNCTION BOX IN GARAGE WITH PULL STRING, NO WIRE) 15Mar23 Note:	
1 - PLUG - ELECTRICAL PLUG- IN LIVING ROOM - 5FT FROM FLOOR FOR FUTURE WALL MOUNTED TV- SEE SKETCH FOR LOCATION 15Mar23 Note:	
1 - LIGHT AND SWITCH - NO FIXTURE INCLUDED - LIVING ROOM 15Mar23 Note:	
1 - ABOVE KITCHEN ISLAND - ADD LIGHT AND SWITCH - NO FIXTURE INCLUDED 15Mar23 Note:	

PLUMBING

1 - TOE TESTER - ADD TOE TESTER TO SHOWER- MASTER ENSUITE 15Mar23 Note:	
--	--

PROMOTIONAL




1 - PARTIAL REDEMPTION OF PROMOTIONAL PACKAGE \$1,335 BALANCE FORWARD \$8,665 TO BE USED AT A LATER DATE. ORIGINAL PROMOTIONAL PACKAGE OF \$10,000 AS PER SCHEDULE PE 15Mar23 Note:	
--	--

This Document is Extremely Time Sensitive - Printed 15 Mar 23 at 13:33

BLK 119 TH31

Cherry 3E

ELEVATION 1 & 2 - 2,154 sq.ft.
Includes 14 sq.ft. of open area

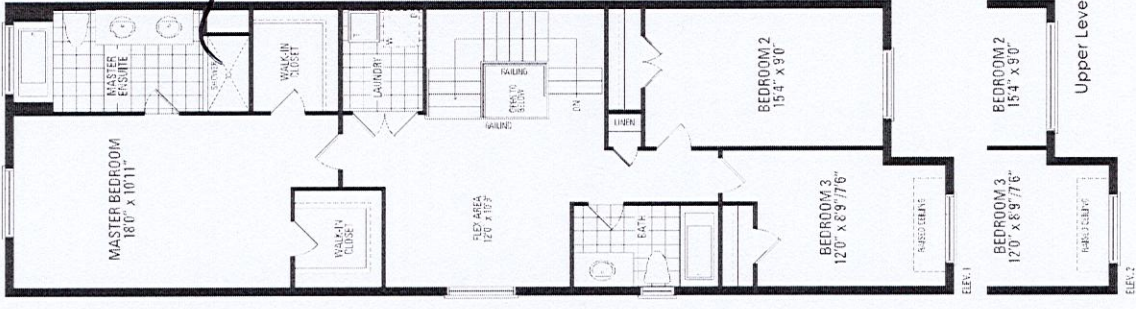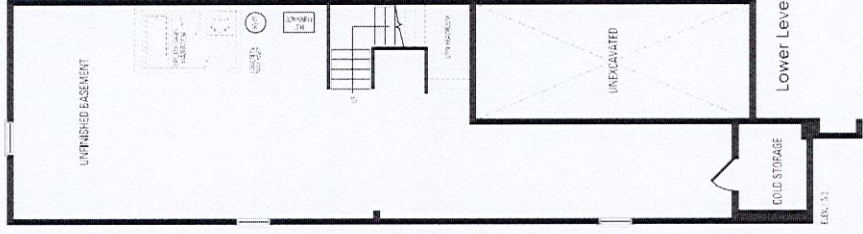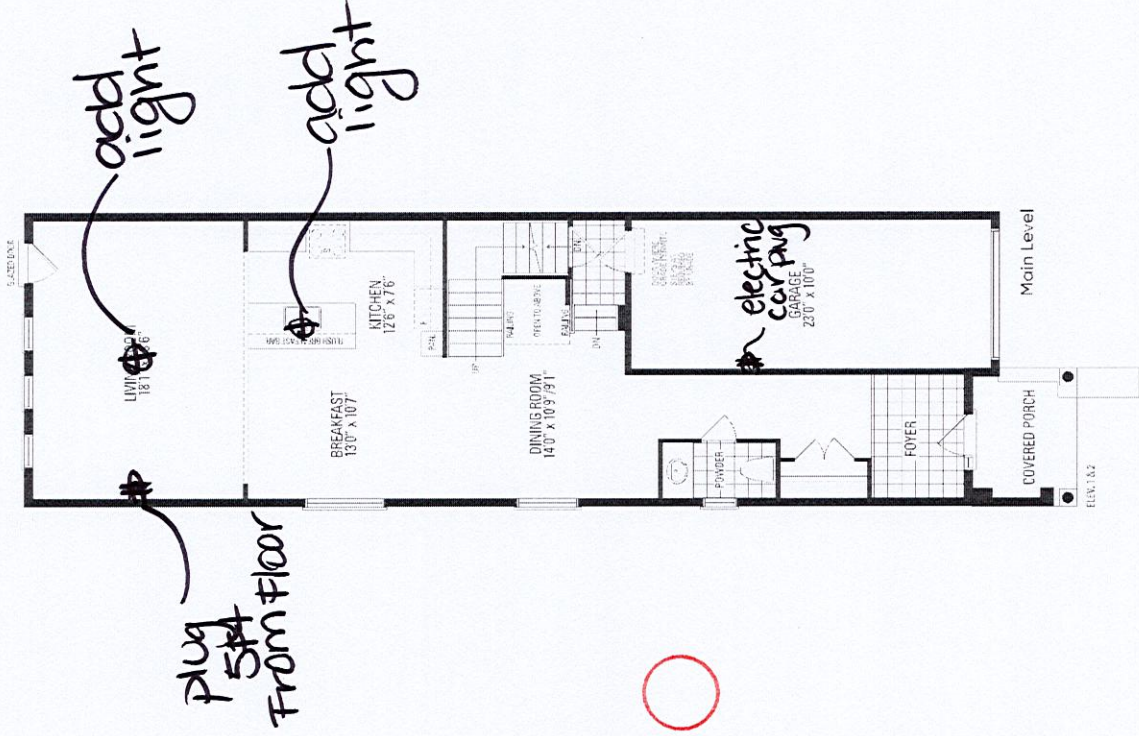

HAZEL
GLENN
APR

Orientation of home may be reversed and purchaser agrees to accept the same. Steps and porches may vary at any exterior entrance ways due to grading variance. Actual usable floor space may vary from the stated floor areas. All renderings are artist's concept. Dimensions, specifications and architectural detailing subject to modifications. Roofline and adjoining model types may vary due to siting. E. & O.E. October 2022