

CONSTRUCTION SUMMARY Hazel Glenn - Barlassina Construction Inc.				
PURCHASER: Shazadally ARFEEN			TEL: RES.: 519-504-5701	
LOT / PHASE Block 122 TH48 / 1	REG. PLAN #	HOUSE TYPE Willow 3E Elev 2		

CABINETRY

1 - CABINETRY PROVISION - PROVISION FOR PLUG ON ISLAND (PLUG EXTRA ORDERED SEPARATELY) 20Mar23 Note:	
---	--

ELECTRICAL

2 - FAN - BATHROOM EXHAUST FAN - ENERGY STAR 80 CFM - IN LIEU OF STANDARD FAN MASTER ENSUITE AND MAIN BATHROOM 20Mar23 Note:	
1 - STANDARD DINING ROOM LIGHT TO BE CENTERED BETWEEN LIVING AND DINING ROOM 20Mar23 Note:	
1 - PLUG - ELECTRICAL PLUG - ADD TO ISLAND 20Mar23 Note:	
2 - PLUG - ELECTRICAL PLUG - 5 FEET FROM FINISHED FLOOR FOR FUTURE WALL MOUNTED TV - SEE SKETCH LIVING ROOM AND MASTER BEDROOM 20Mar23 Note:	
1 - ABOVE KITCHEN ISLAND - ADD LIGHT AND SWITCH - NO FIXTURE INCLUDED 20Mar23 Note:	

PLUMBING

2 - TOE TESTER - ADD TOE TESTER TO SHOWER- MASTER ENSUITE AND MATH BATH SHOWERS 20Mar23 Note:	
1 - WASHROOM - 3 PIECE ROUGH-IN IN BASEMENT 20Mar23 Note:	
1 - TUB TO SHOWER CONVERSION - 5 FOOT SHOWER WITH SLIDING GLASS CHROME DOORS IN LIEU OF TUB INCLUDES SHOWER POT LIGHT 20Mar23 Note:	

PROMOTIONAL


1 - PARTIAL REDEMPTION OF PROMOTIONAL PACKAGE \$6,480 BALANCE FORWARD \$3,520 TO BE USED AT A LATER DATE. ORIGINAL PROMOTIONAL PACKAGE OF \$10,000 AS PER SCHEDULE PE 20Mar23 Note:	
---	--

This Document is Extremely Time Sensitive - Printed 20 Mar 23 at 10:06




BLK 122 TH48

Std light centered
Willow 3E

ELEVATION 1 - 1,775 sq.ft. • ELEVATION 2 & 3 - 1,765 sq.ft.

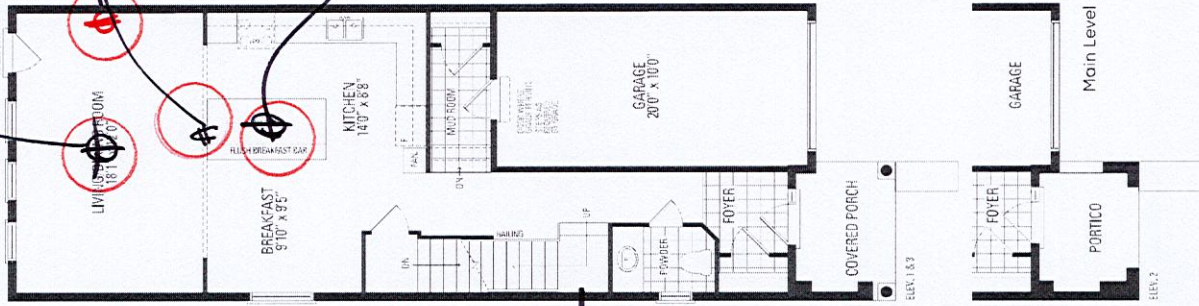

Signature: ★

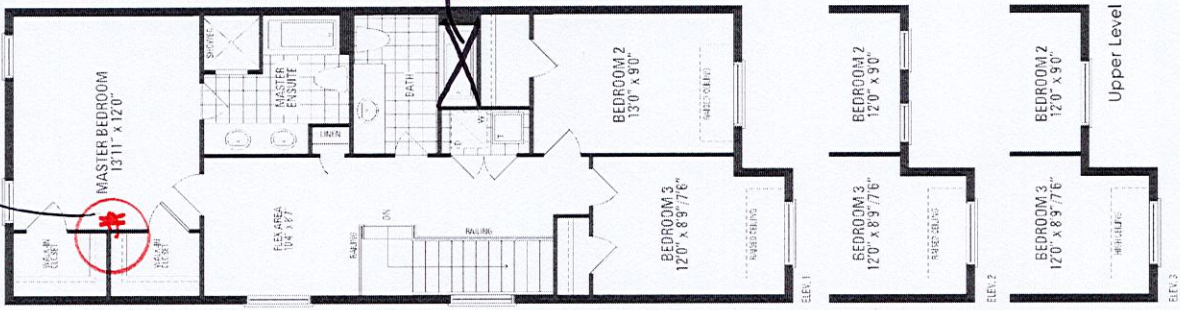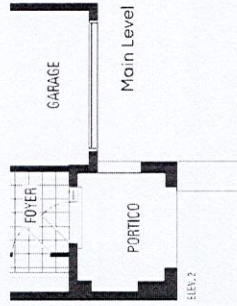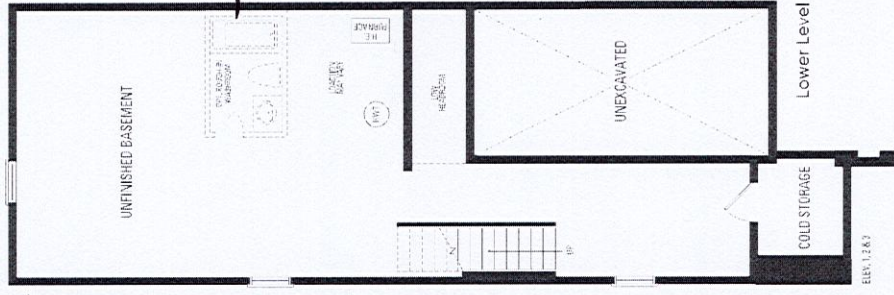

Orientation of home may be reversed and purchaser agrees to accept the same. Steps and porches may vary at any exterior entrance ways due to grading variance. Actual usable floor space may vary from the stated floor areas. All renderings are artist's concept. Dimensions, specifications and architectural detailing subject to modifications. Roofline and adjoining model types may vary due to siting. E. & O.E. October 2022