

CONSTRUCTION SUMMARY

Hazel Glenn - Barlassina Construction Inc.

PURCHASERS: Hira AZAM and Faiz KHAN

TEL: RES.: 647-823-1356

LOT / PHASE Block 120 TH18 / 1	REG. PLAN #	HOUSE TYPE Cherry 3E Elev 2		
-----------------------------------	-------------	--------------------------------	--	--

ELECTRICAL

1 - LIGHT AND SWITCH - NO FIXTURE INCLUDED - LIVING ROOM 22Mar23 Note:	
1 - PLUG - ELECTRICAL PLUG - 5 FEET FROM FINISHED FLOOR FOR FUTURE WALL MOUNTED TV - SEE SKETCH - LIVING ROOM 22Mar23 Note:	
1 - ABOVE KITCHEN ISLAND - ADD LIGHT AND SWITCH - NO FIXTURE INCLUDED 22Mar23 Note:	

PLUMBING

1 - WATER LINE FOR FRIDGE - ROUGH-IN ONLY 22Mar23 Note:	
1 - WASHROOM - 3 PIECE ROUGH-IN IN BASEMENT 22Mar23 Note:	

PROMOTIONAL

1 - PARTIAL REDEMPTION OF PROMOTIONAL PACKAGE \$2,035 BALANCE FORWARD \$7,965 TO BE USED AT A LATER DATE. ORIGINAL PROMOTIONAL PACKAGE OF \$10,000 AS PER SCHEDULE PE 22Mar23 Note:	
---	--

This Document is Extremely Time Sensitive - Printed 22 Mar 23 at 10:07

BLK120 TH18


GLENN
HAZEL
ART

add light
centered in living RM
add plug
5ft from
FLOOR

★ — add
R.I

add light
centered
above island

Signature: ★

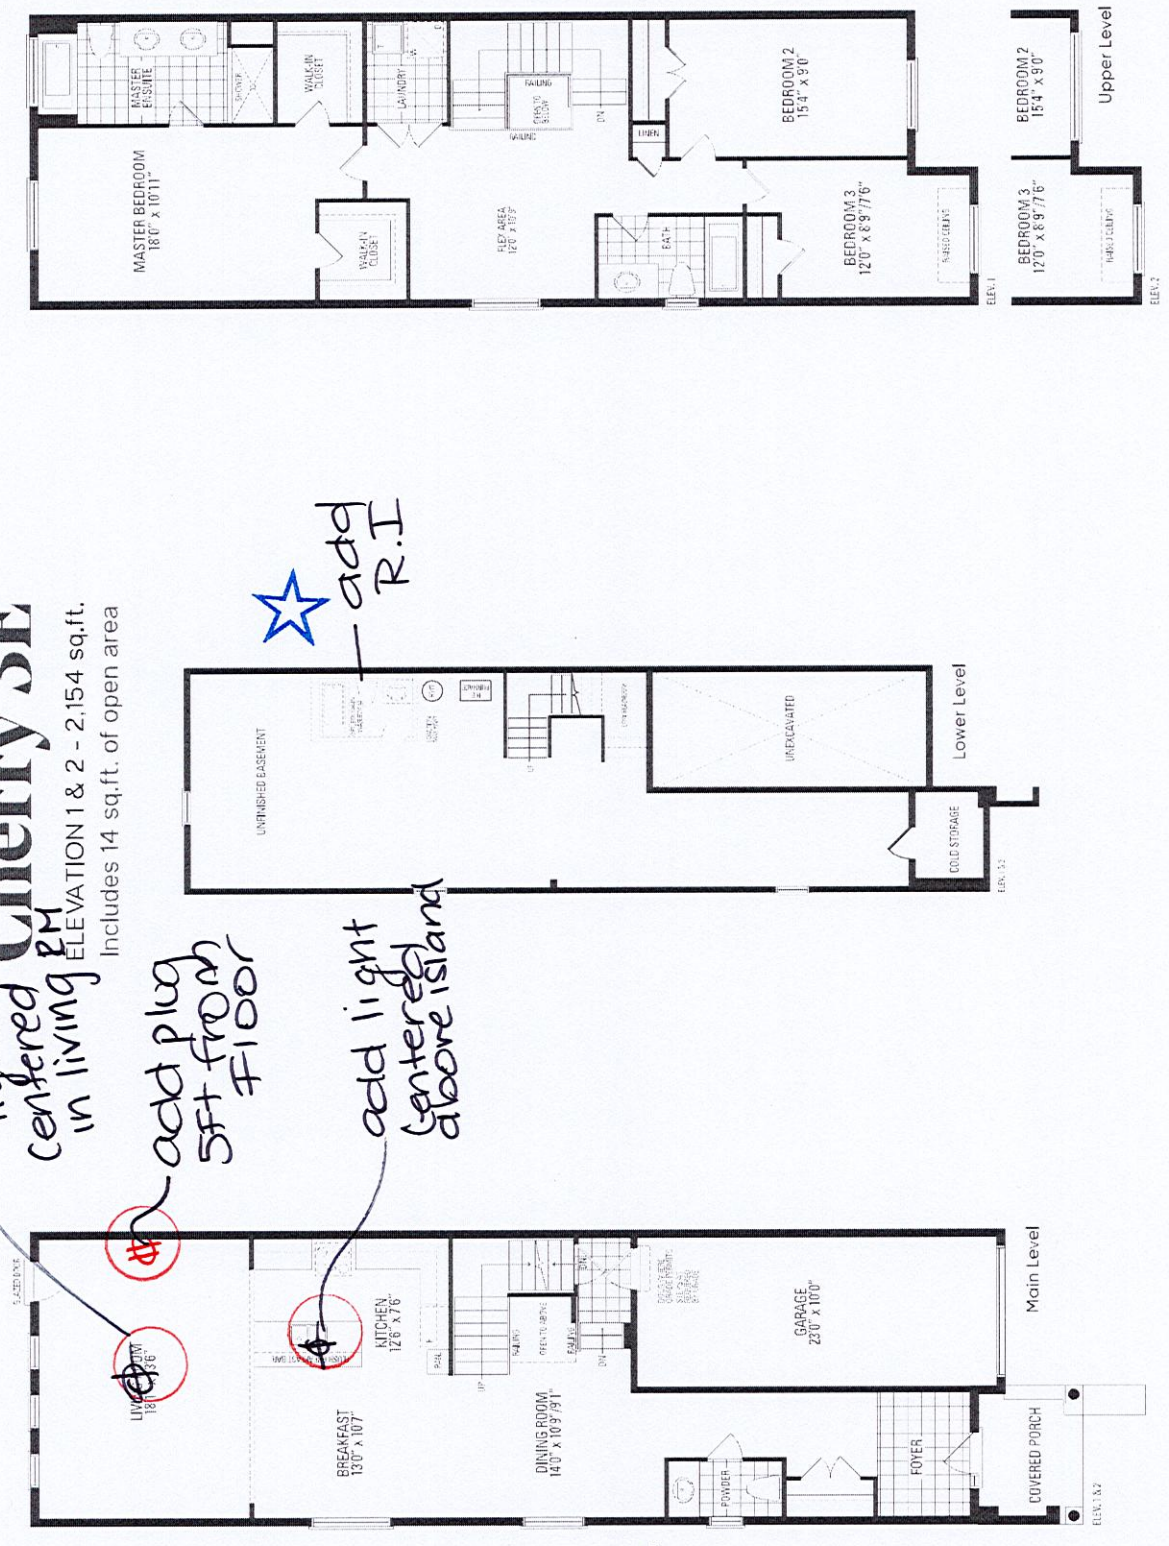

Orientation of home may be reversed and purchaser agrees to accept the same. Steps and porches may vary at any exterior entrance ways due to grading variance. Actual usable floor space may vary from the stated floor areas. All renderings are artist's concept. Dimensions, specifications and architectural detailing subject to modifications. Roofline and adjoining model types may vary due to siting. E. & O.E. October 2022