

CONSTRUCTION SUMMARY - PARTIAL ONLY

Mountainview Heights 3 (G) - Russell Gardens Building Ltd.

PURCHASERS: Wajid Abdul SYED and Erum WAJID SYED

TEL: RES.: 437-349-9009

LOT NUMBER	PHASE	HOUSE TYPE	REG. PLAN #		
599	4	Grandville Three Elev 3	62M-1266		
INV#	QTY	EXTRA / CHANGE			COMMENTS


Offer	Note:
-------	-------

ELECTRICAL

27,537 03 Aug 22	1 - KITCHEN - CYCLONE PRO SERIES 48" INSERT 900cfm Note: BXB60946-SS
25,980 14 Apr 22	1 - RELOCATE STANDARD KITCHEN LIGHT TO BE CENTERED OVER ISLAND Note:
25,980 14 Apr 22	1 - PLUG - ELECTRICAL PLUG - ADD TO ISLAND Note:
25,980 14 Apr 22	1 - PLUG - ELECTRICAL PLUG - TO BE INSTALLED OVER FIREPLACE Note:
25,980 14 Apr 22	1 - PLUG - ELECTRICAL PLUG - INSTALLED 5.5' FROM FLOOR FOR FUTURE TV - MASTER BEDROOM Note:
25,980 14 Apr 22	1 - PLUG - ELECTRICAL PLUG - INSTALLED 5.5' FROM FLOOR FOR FUTURE TV - FLEX ROOM Note:
25,980 14 Apr 22	1 - LIGHT AND SWITCH - NO FIXTURE INCLUDED - INSTALL LIGHT ON WALL ABOVE MIRROR ON SEPERATE SWITCH FROM STANDARD LIGHT - POWDER ROOM Note:
25,980 14 Apr 22	1 - LIGHT AND SWITCH - NO FIXTURE INCLUDED - INSTALLED ON CEILING ON SEPERATE SWITCH FROM STANDARD LIGHT - SEE SKETCH FOR LOCATIONS - ALL ENSUITE BATHROOMS Note:
25,980 14 Apr 22	1 - LIGHT - EXTERIOR - WIRED TO SAME INTERIOR SWITCH AS STANDARD LIGHT - FRONT PORCH Note:
25,980 14 Apr 22	1 - 200 AMP ELECTRICAL SERVICE Note:
28,312 23 Mar 23	2 - LIGHT - EXTERIOR WITH INTERIOR SWITCH Note: ADD 2 FESTIVE PLUGS IN BACK OF HOUSE SEE SKETCH
28,312 23 Mar 23	4 - POT LIGHT - LED - SECOND FLOOR INSTALLATION Note: ADD PUCK LIGHTS IN MASTER ENSUITE VANITY-DELETE STANDARD LIGHT SEE SKETCH
25,980 14 Apr 22	1 - BUILT IN OVEN AND COOKTOP PROVISION - PROVISION ONLY - ELECTRICAL ONLY Note:
25,980 14 Apr 22	1 - KITCHEN - RELOCATE FRIDGE Note:

599-Russell
Gardens
Ph-4
Master Ensuite Bath
Hutch.

20

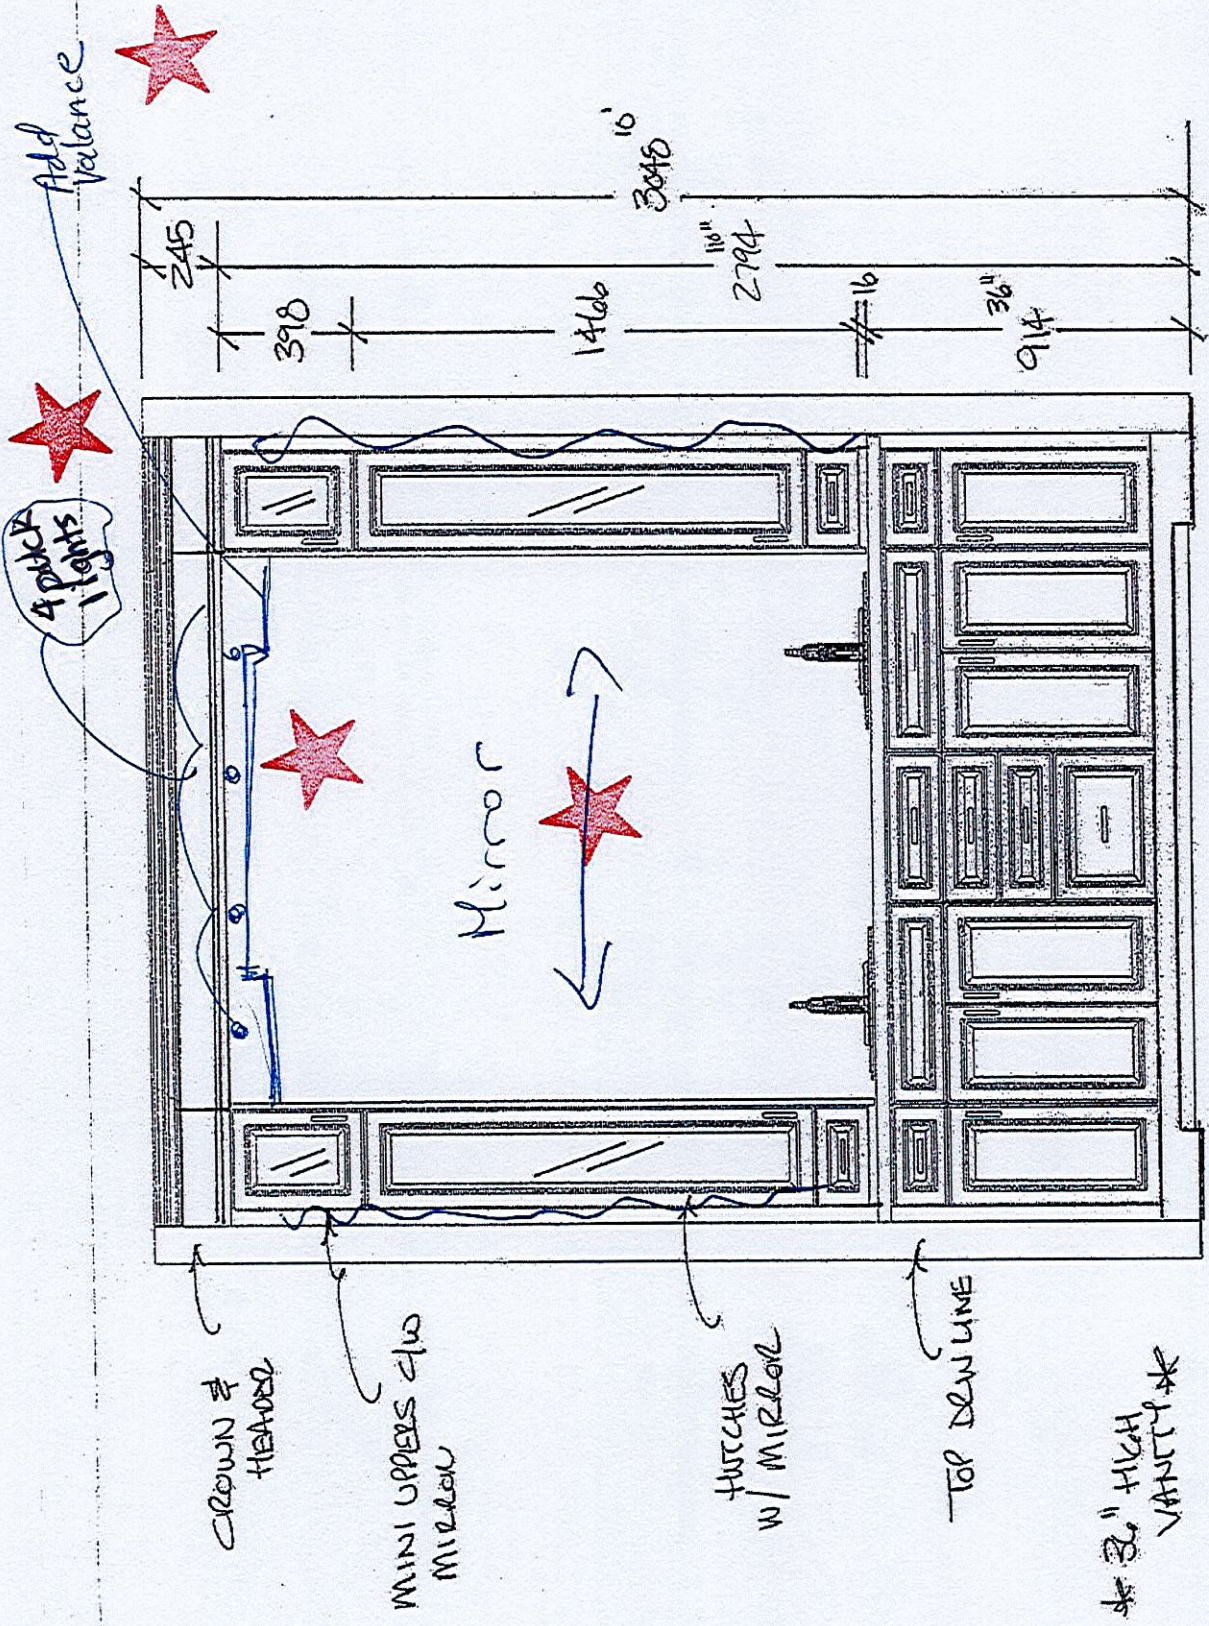

SCARLE DECUT T.V.

Designed: 5/4/2022 Printed: 5/16/2022	2020 TECHNOLOGIES	This drawing is the intellectual property of SELBA INDUSTRIES INC. and is an artistic interpretation of the general appearance of the design. It is not meant to be an exact rendition.
REV MAY 16/22		
LAYOUT	Drawing #:	1

RUSSELL GARDENS 599-APR 22 2022

