

CONSTRUCTION SUMMARY

Hazel Glenn - Barlassina Construction Inc.

PURCHASER: Oluwatosin Modupe AKINBOLA

TEL: RES.: 647-712-3365

LOT / PHASE Block 120 TH20 / 1	REG. PLAN #	HOUSE TYPE Cherry 2 Elev 1		
-----------------------------------	-------------	-------------------------------	--	--

CONSTRUCTION

1 - SMOOTH CEILINGS FIRST FLOOR ONLY 03Apr23 Note:	
---	--

ELECTRICAL

1 - STANDARD DINING ROOM LIGHT TO BE CENTERED BETWEEN LIVING AND DINING ROOM 03Apr23 Note:	
1 - PLUG - ELECTRICAL PLUG - 5 FEET FROM FINISHED FLOOR FOR FUTURE WALL MOUNTED TV - SEE SKETCH 03Apr23 Note:	
1 - ABOVE KITCHEN ISLAND - ADD LIGHT AND SWITCH - NO FIXTURE INCLUDED 03Apr23 Note:	

PLUMBING

1 - WASHROOM - 3 PIECE ROUGH-IN IN BASEMENT 03Apr23 Note:	
1 - TUB TO SHOWER CONVERSION - 5 FOOT SHOWER WITH SLIDING GLASS CHROME DOORS IN LIEU OF TUB INCLUDES SHOWER POT LIGHT MAIN BATHROOM 03Apr23 Note:	


PROMOTIONAL

1 - PARTIAL REDEMPTION OF PROMOTIONAL PACKAGE \$7,870 BALANCE FORWARD \$ 2,130 TO BE USED AT A LATER DATE. ORIGINAL PROMOTIONAL PACKAGE OF \$10,000 AS PER SCHEDULE PE 03Apr23 Note:	
--	--


This Document is Extremely Time Sensitive - Printed 3 Apr 23 at 10:28




Center  
std light  
**Cherry 2**  
ELEVATION 1 & 2 - 2,030 sq.ft.

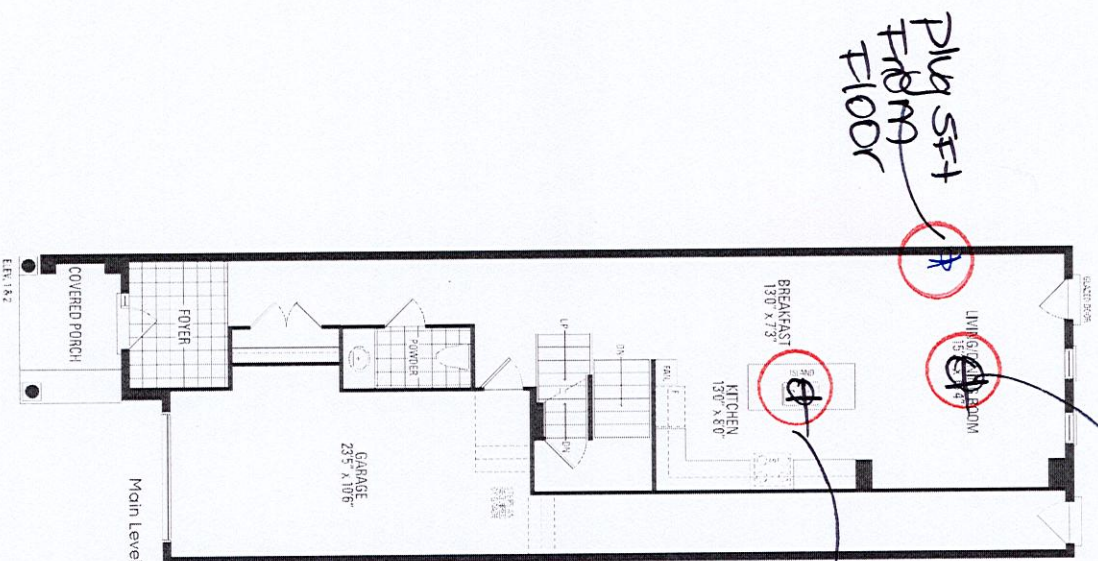

add  
light  
centered  
above  
island

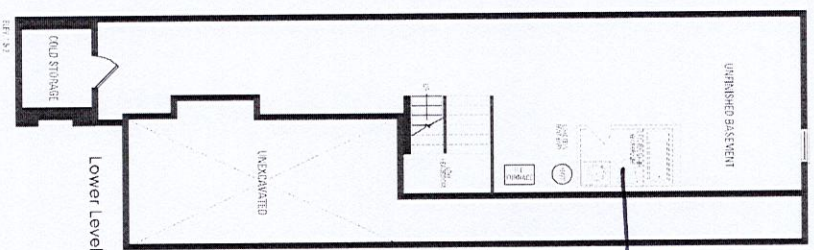

★  
add  
R.I.

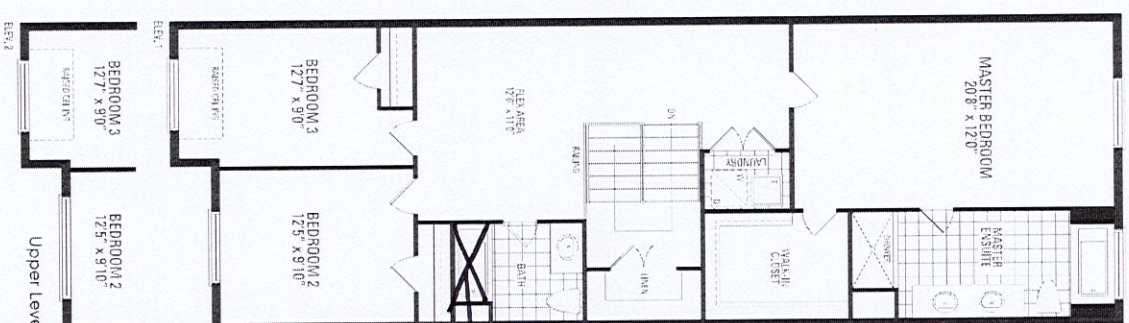

★  
add  
shower