Greenpark.

CONSTRUCTION SUMMARY
Hazel Glenn - Barlassina Construction Inc.


ADD 10, 2022

PURCHASERS: Gian Kaur SADHRA and Surinder Singh SADHRA

APR 10 2023 TEL: RES.: 647-836-0457

LOT / PHASE Block 122 TH45 / 1	REG. PLAN #	HOUSE TYPE Willow 2 Elev 2		
CONSTRUCTION				
1 - SMOOTH CEILINGS ON FIRST FLOOR ONLY				
05Apr23 Note:				
ELECTRICAL				
1 - RELOCATE STANDARD KITCHEN LIGHT TO BE CENTERED OVER ISLAND				
05Apr23 Note:	KITCHEN EIGHT TO	BE CENTERED OVER IGEAUD		
03/1pi 23				
1 - PLUG - ELECTRICAL PLUG - 5 FEET FROM FINISHED FLOOR FOR FUTURE WALL MOUNTED TV - SEE SKETCH				
05Apr23 Note:	oo silbiiikowiii	William I Edok Fok Fok Fok Wille Wille Wook File	JI COLL SILL TON	
LIVING/DINING ROOM				
1 - LIGHT AND SWITCH - NO FIXTURE INCLUDED - LIVING ROOM				
05Apr23 Note:				
1 - ELECTRIC VEHICLE ROUGH-IN PROVISION ONLY FOR FUTURE ELECTRIC CAR (CONDUIT FROM BASEMENT INTO				
JUNCTION BOX IN GARAGE WITH PULL STRING, NO WIRE)				
05Apr23 Note:				
PLUMBING				
1 - MASTER ENSUITE - TO	E TESTER - ADD TOE	TESTER TO SHOWER		
05Apr23 Note:				
PROMOTIONAL				
		ACKAGE \$4,065.00 BALANCE FORWARD \$5,935. F \$10,000.00 AS PER SCHEDULE PE.	.00 TO BE USED AT A LA	TER
05Apr23 Note:	HONAL PACKAGE OF	TIO,000.00 AS FER SCHEDULE FE.		
'				

This Document is Extremely Time Sensitive - Printed <u>5 Apr 23</u> at <u>14:17</u>

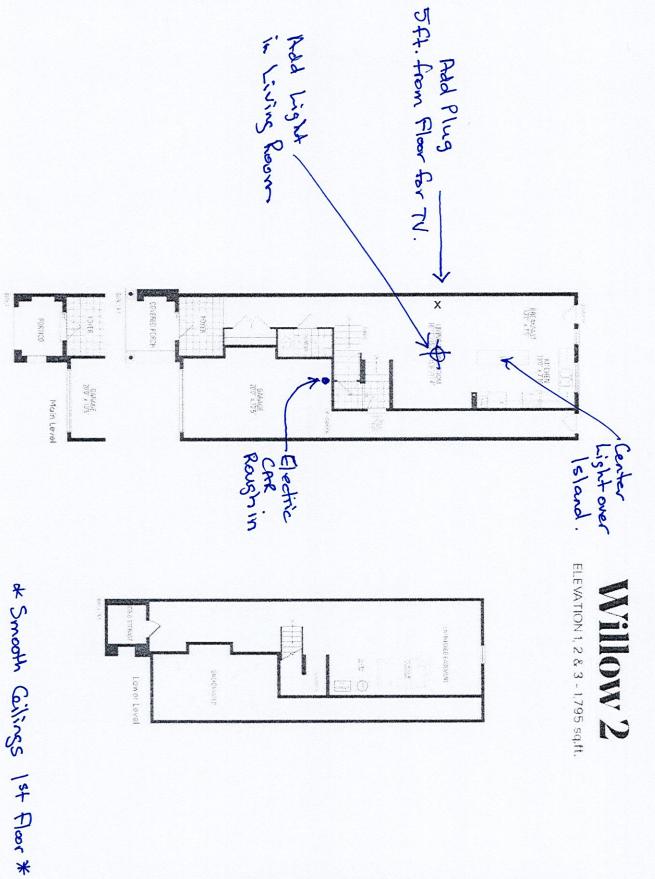

MASTER REGIONA

MASTER REGIONA

150 ME

floor areas. All renderings are artist's concept. Dimensions, specifications and architectural detailing subject to modifications. Roofline and adjoining model types may vary due to siting. E. & O.E. October 2022 Orientation of home may be reversed and purchaser agrees to accept the same. Steps and purchas may vary at any exterior entrance ways due to grading variance. Actual usable floor space may vary from the stated