

Preliminary

CONSTRUCTION SUMMARY		RECEIVED
Hazel Glenn - Barlassina Construction Inc.		APR 10 2023
PURCHASER: Raveesh MITTAL		TEL: RES.: 647-971-2626

LOT / PHASE Block 121 TH3 / 1	REG. PLAN #	HOUSE TYPE Cherry 1 Elev 2		
----------------------------------	-------------	-------------------------------	--	--

CONSTRUCTION

1 - SMOOTH CEILINGS FIRST FLOOR ONLY 10Apr23 Note:	
---	--

ELECTRICAL

1 - STANDARD DINING ROOM LIGHT TO BE CENTERED BETWEEN LIVING AND DINING ROOM 10Apr23 Note:	
1 - RELOCATE STANDARD KITCHEN LIGHT TO BE CENTERED OVER ISLAND 10Apr23 Note:	

PLUMBING

1 - WASHROOM - 3 PIECE ROUGH-IN IN BASEMENT 10Apr23 Note:	
--	--

PROMOTIONAL




1 - PARTIAL REDEMPTION OF PROMOTIONAL PACKAGE \$3,860 BALANCE FORWARD \$6,140 TO BE USED AT A LATER DATE. ORIGINAL PROMOTIONAL PACKAGE OF \$10,000 AS PER SCHEDULE PE. 10Apr23 Note:	
---	--

This Document is Extremely Time Sensitive - Printed 10 Apr 23 at 15:13

Cherry 1

ELEVATION 1 - 1,951 sq.ft. • ELEVATION 2 - 1,960 sq.ft.

Includes 14 sq.ft. of open area

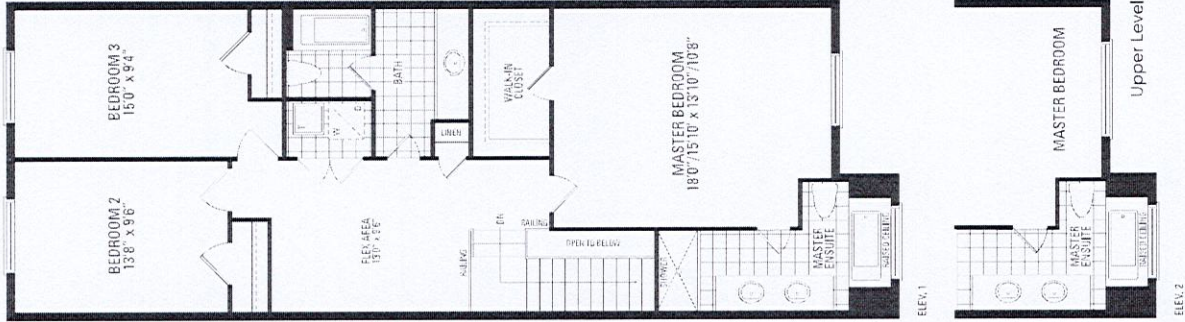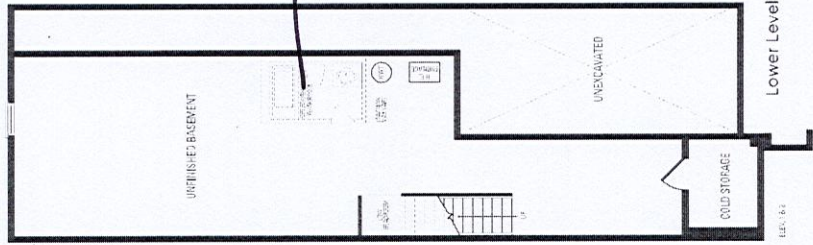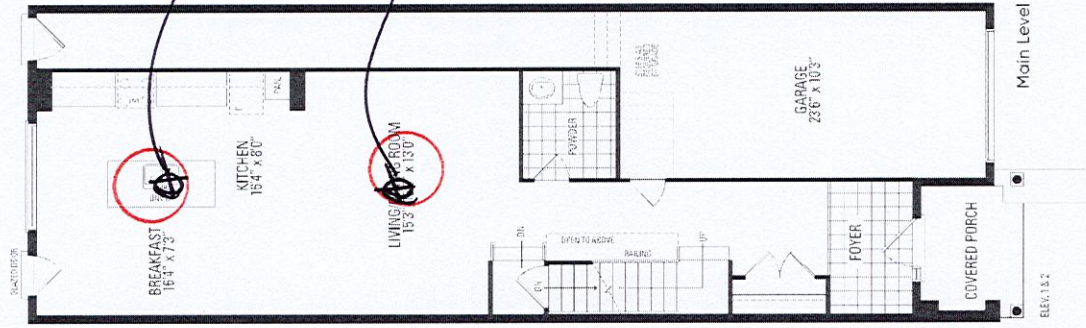

Orientation of home may be reversed and purchaser agrees to accept the same. Steps and porches may vary at any exterior entrance ways due to grading variance. Actual usable floor space may vary from the stated floor areas. All renderings are artist's concept. Dimensions, specifications and architectural detailing subject to modifications. Roofline and adjoining model types may vary due to siting. E. & O.E. October 2022